


FED. ROAD DIST. NO.	STATE	FED. AID PROJ. NO.	FISCAL YEAR	SHEET NO.	TOTAL SHEETS
HAWAII	HAW.	STP-036-1(8)	1997	18	30

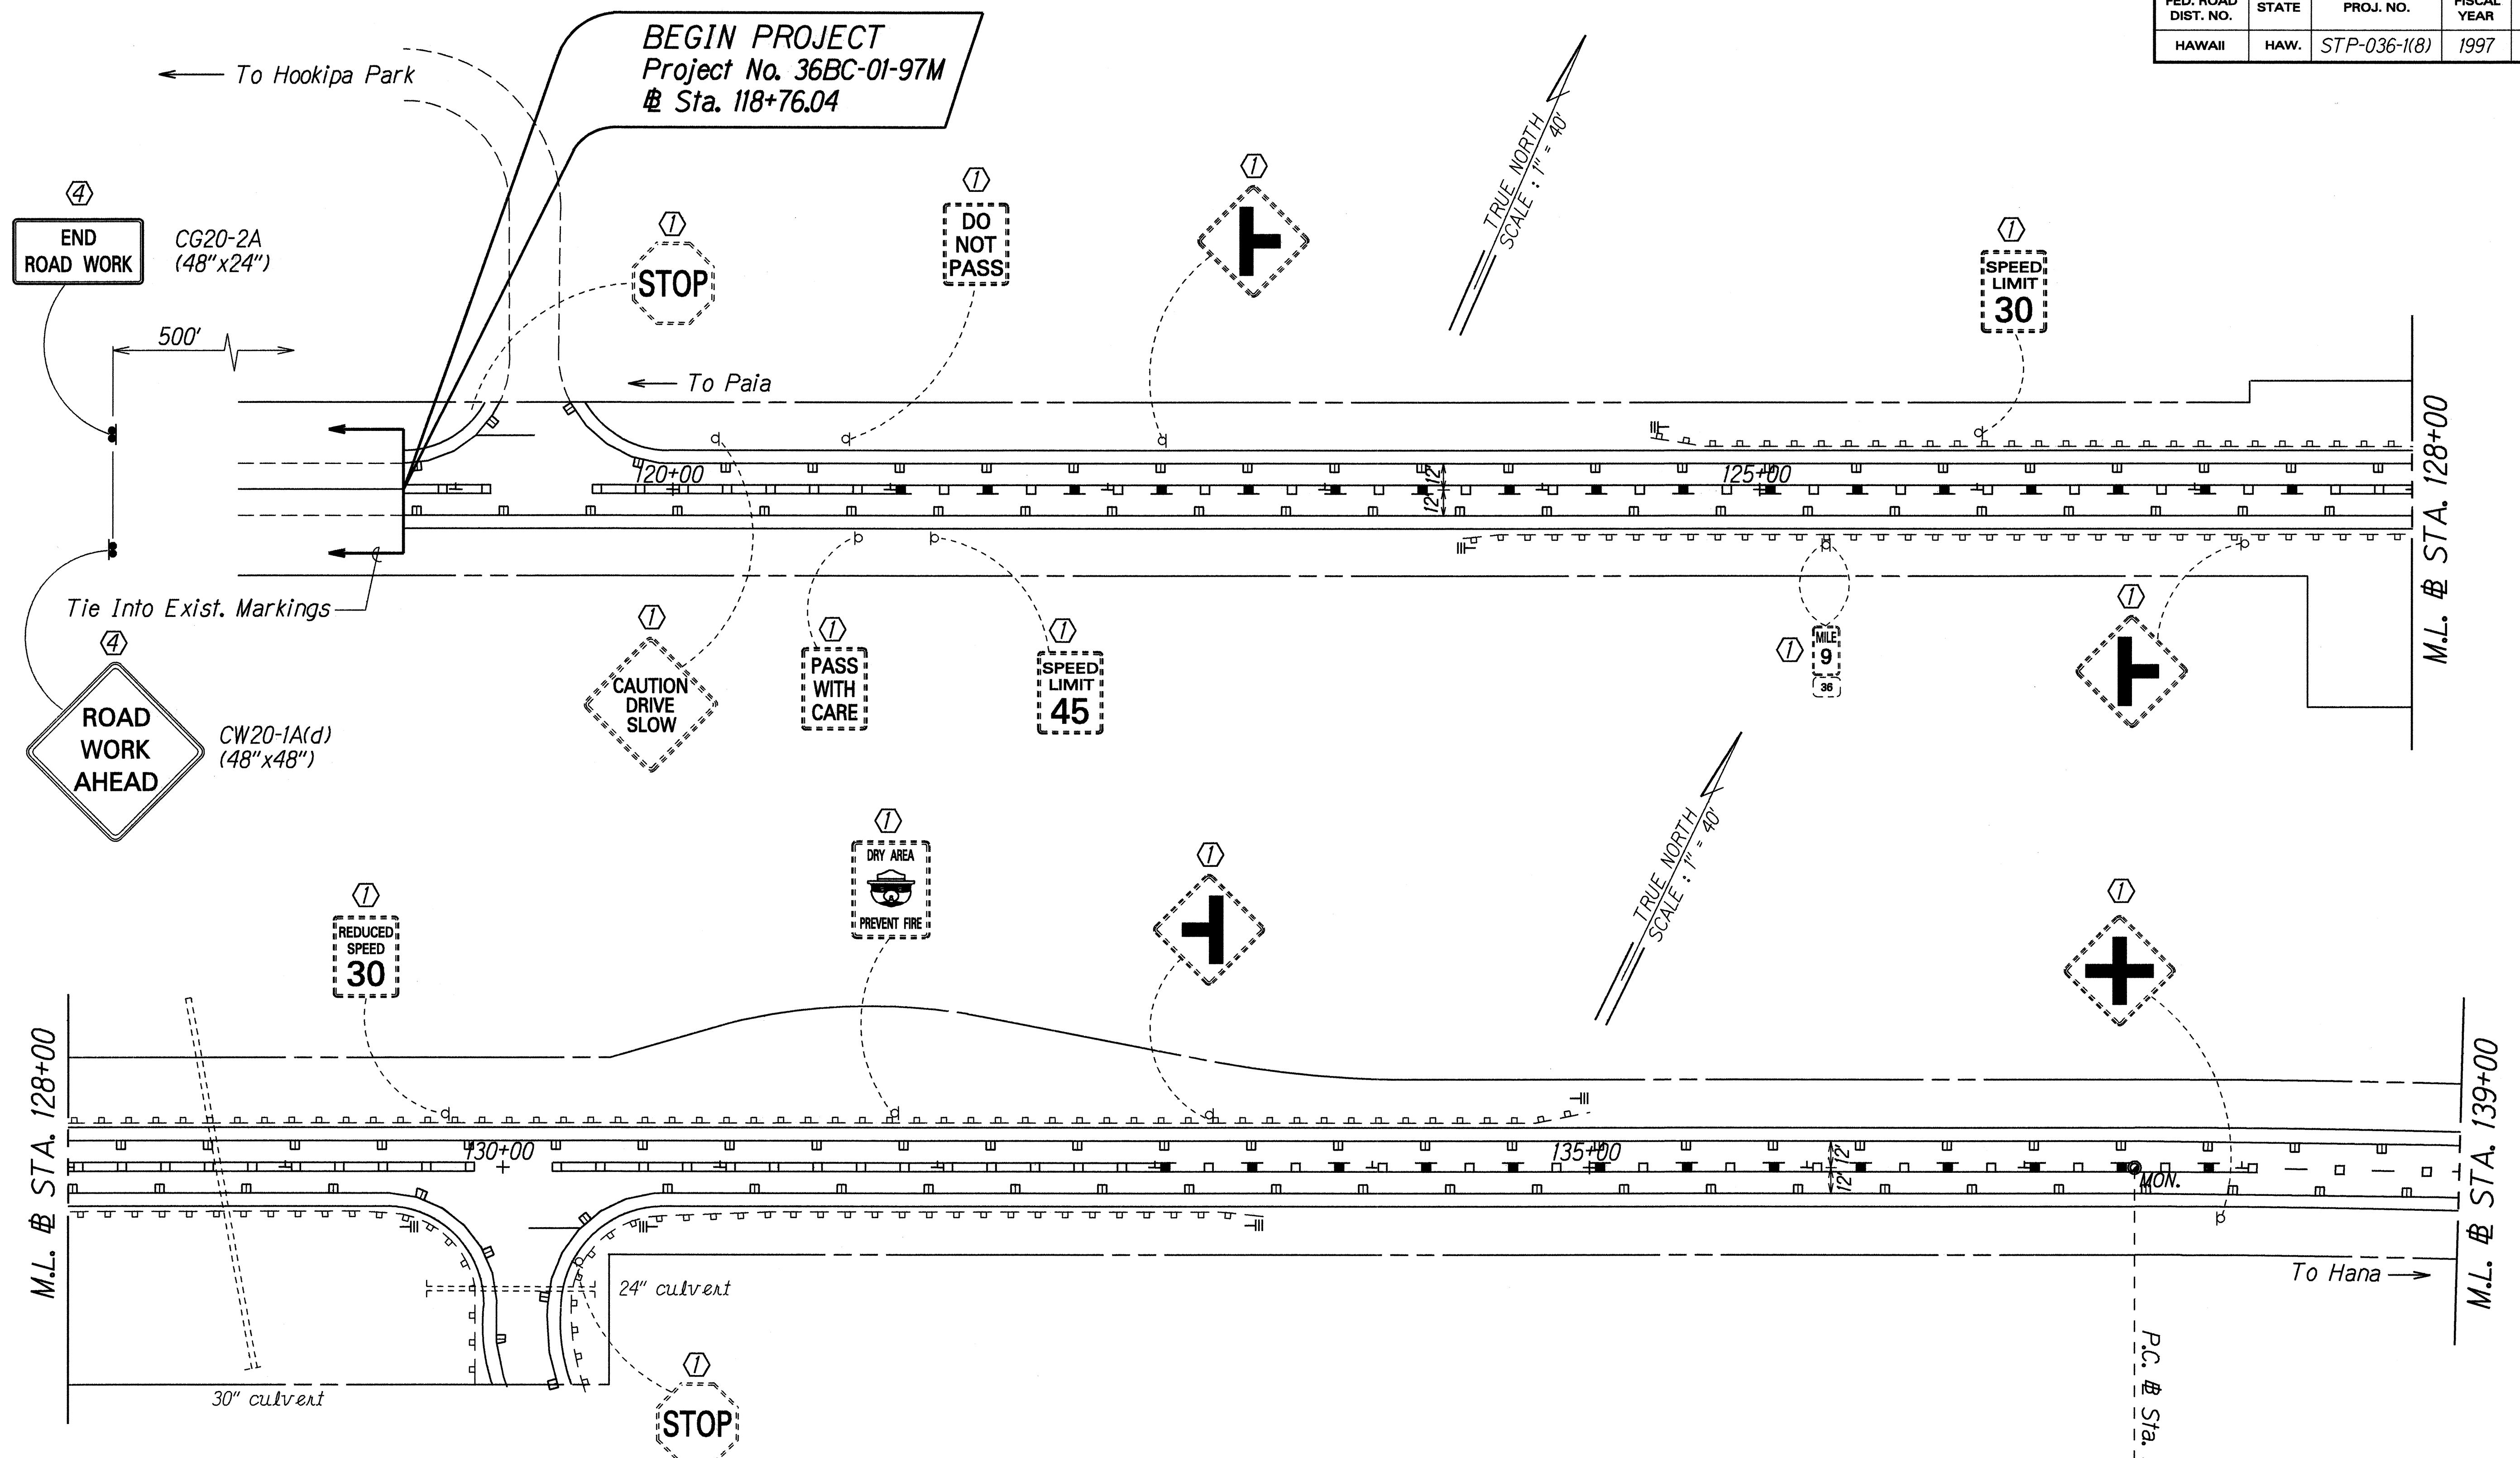

ORIGINAL PLAN	SURVEY PLOTTED BY	DATE
	DRAWN BY	April, 1996
	DESIGNED BY	
	QUANTITIES BY	
	CHECKED BY	

- KEY:**
- ① Exist. Sign(s) & Post(s) to Remain
 - ② Remove Exist. Sign(s) & Post(s)
 - ③ Remove Exist. & Install New Sign(s) & Post(s)
 - ④ Install New Sign(s) & Post(s)


STATE OF HAWAII
DEPARTMENT OF TRANSPORTATION
HIGHWAYS DIVISION

**SIGNING & PAVEMENT
MARKING PLAN**

HANA HIGHWAY RESURFACING
Hookipa Park to Valley Isle Memorial Cemetery
Fed. Aid Project No. STP-036-1(8)
Scale: 1" = 40' Date: July, 1996

SHEET No. 1 OF 11 SHEETS

FED. ROAD DIST. NO.	STATE	FED. AID PROJ. NO.	FISCAL YEAR	SHEET NO.	TOTAL SHEETS
HAWAII	HAW.	STP-036-1(8)	1997	19	30

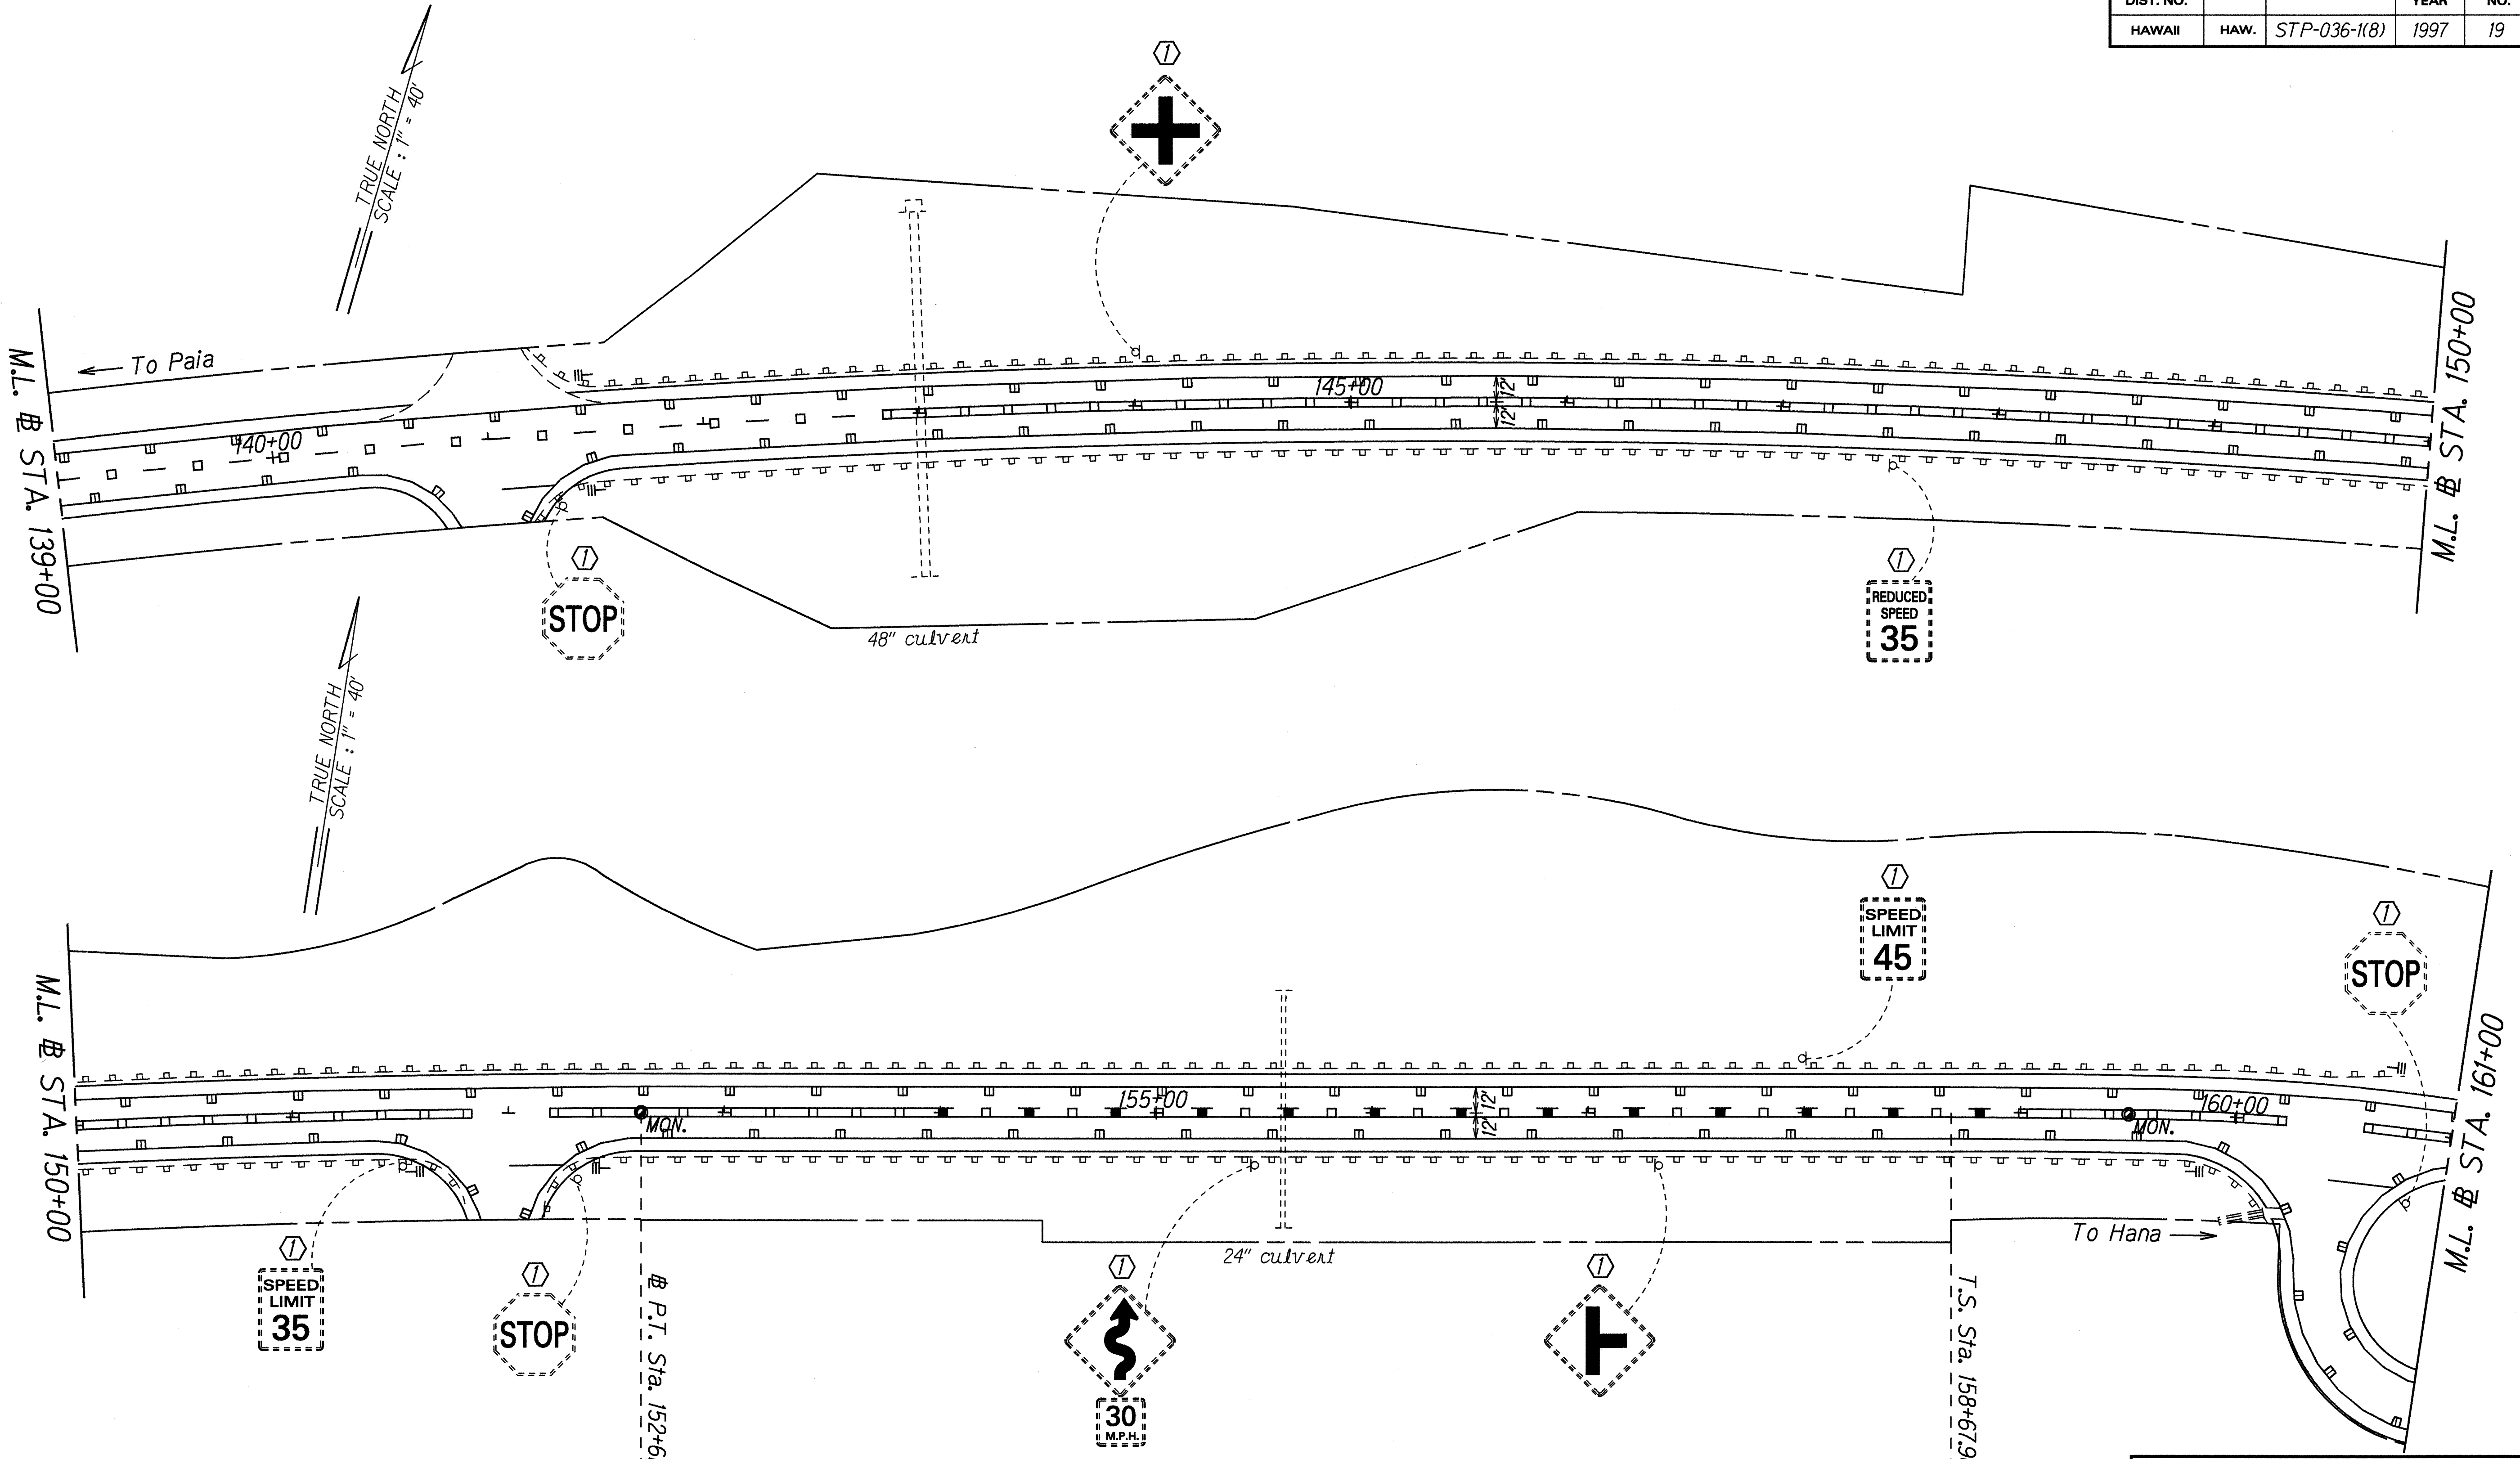

DATE	APR 11 1996
SURVEY PLANNED BY	JL
ORIGINAL PLAN	
DRAWN BY	GR
DESIGNED BY	GR
QUANTITIES BY	
CHECKED BY	


- KEY:**
- ① Exist. Sign(s) & Post(s) to Remain
 - ② Remove Exist. Sign(s) & Post(s)
 - ③ Remove Exist. & Install New Sign(s) & Post(s)
 - ④ Install New Sign(s) & Post(s)

STATE OF HAWAII
DEPARTMENT OF TRANSPORTATION
HIGHWAYS DIVISION

**SIGNING & PAVEMENT
MARKING PLAN**

HANA HIGHWAY RESURFACING
Hookipa Park to Valley Isle Memorial Cemetery
Fed. Aid Project No. STP-036-1(8)
Scale: 1" = 40' Date: July, 1996

FED. ROAD DIST. NO.	STATE	FED. AID PROJ. NO.	FISCAL YEAR	SHEET NO.	TOTAL SHEETS
HAWAII	HAW.	STP-036-1(8)	1997	20	30

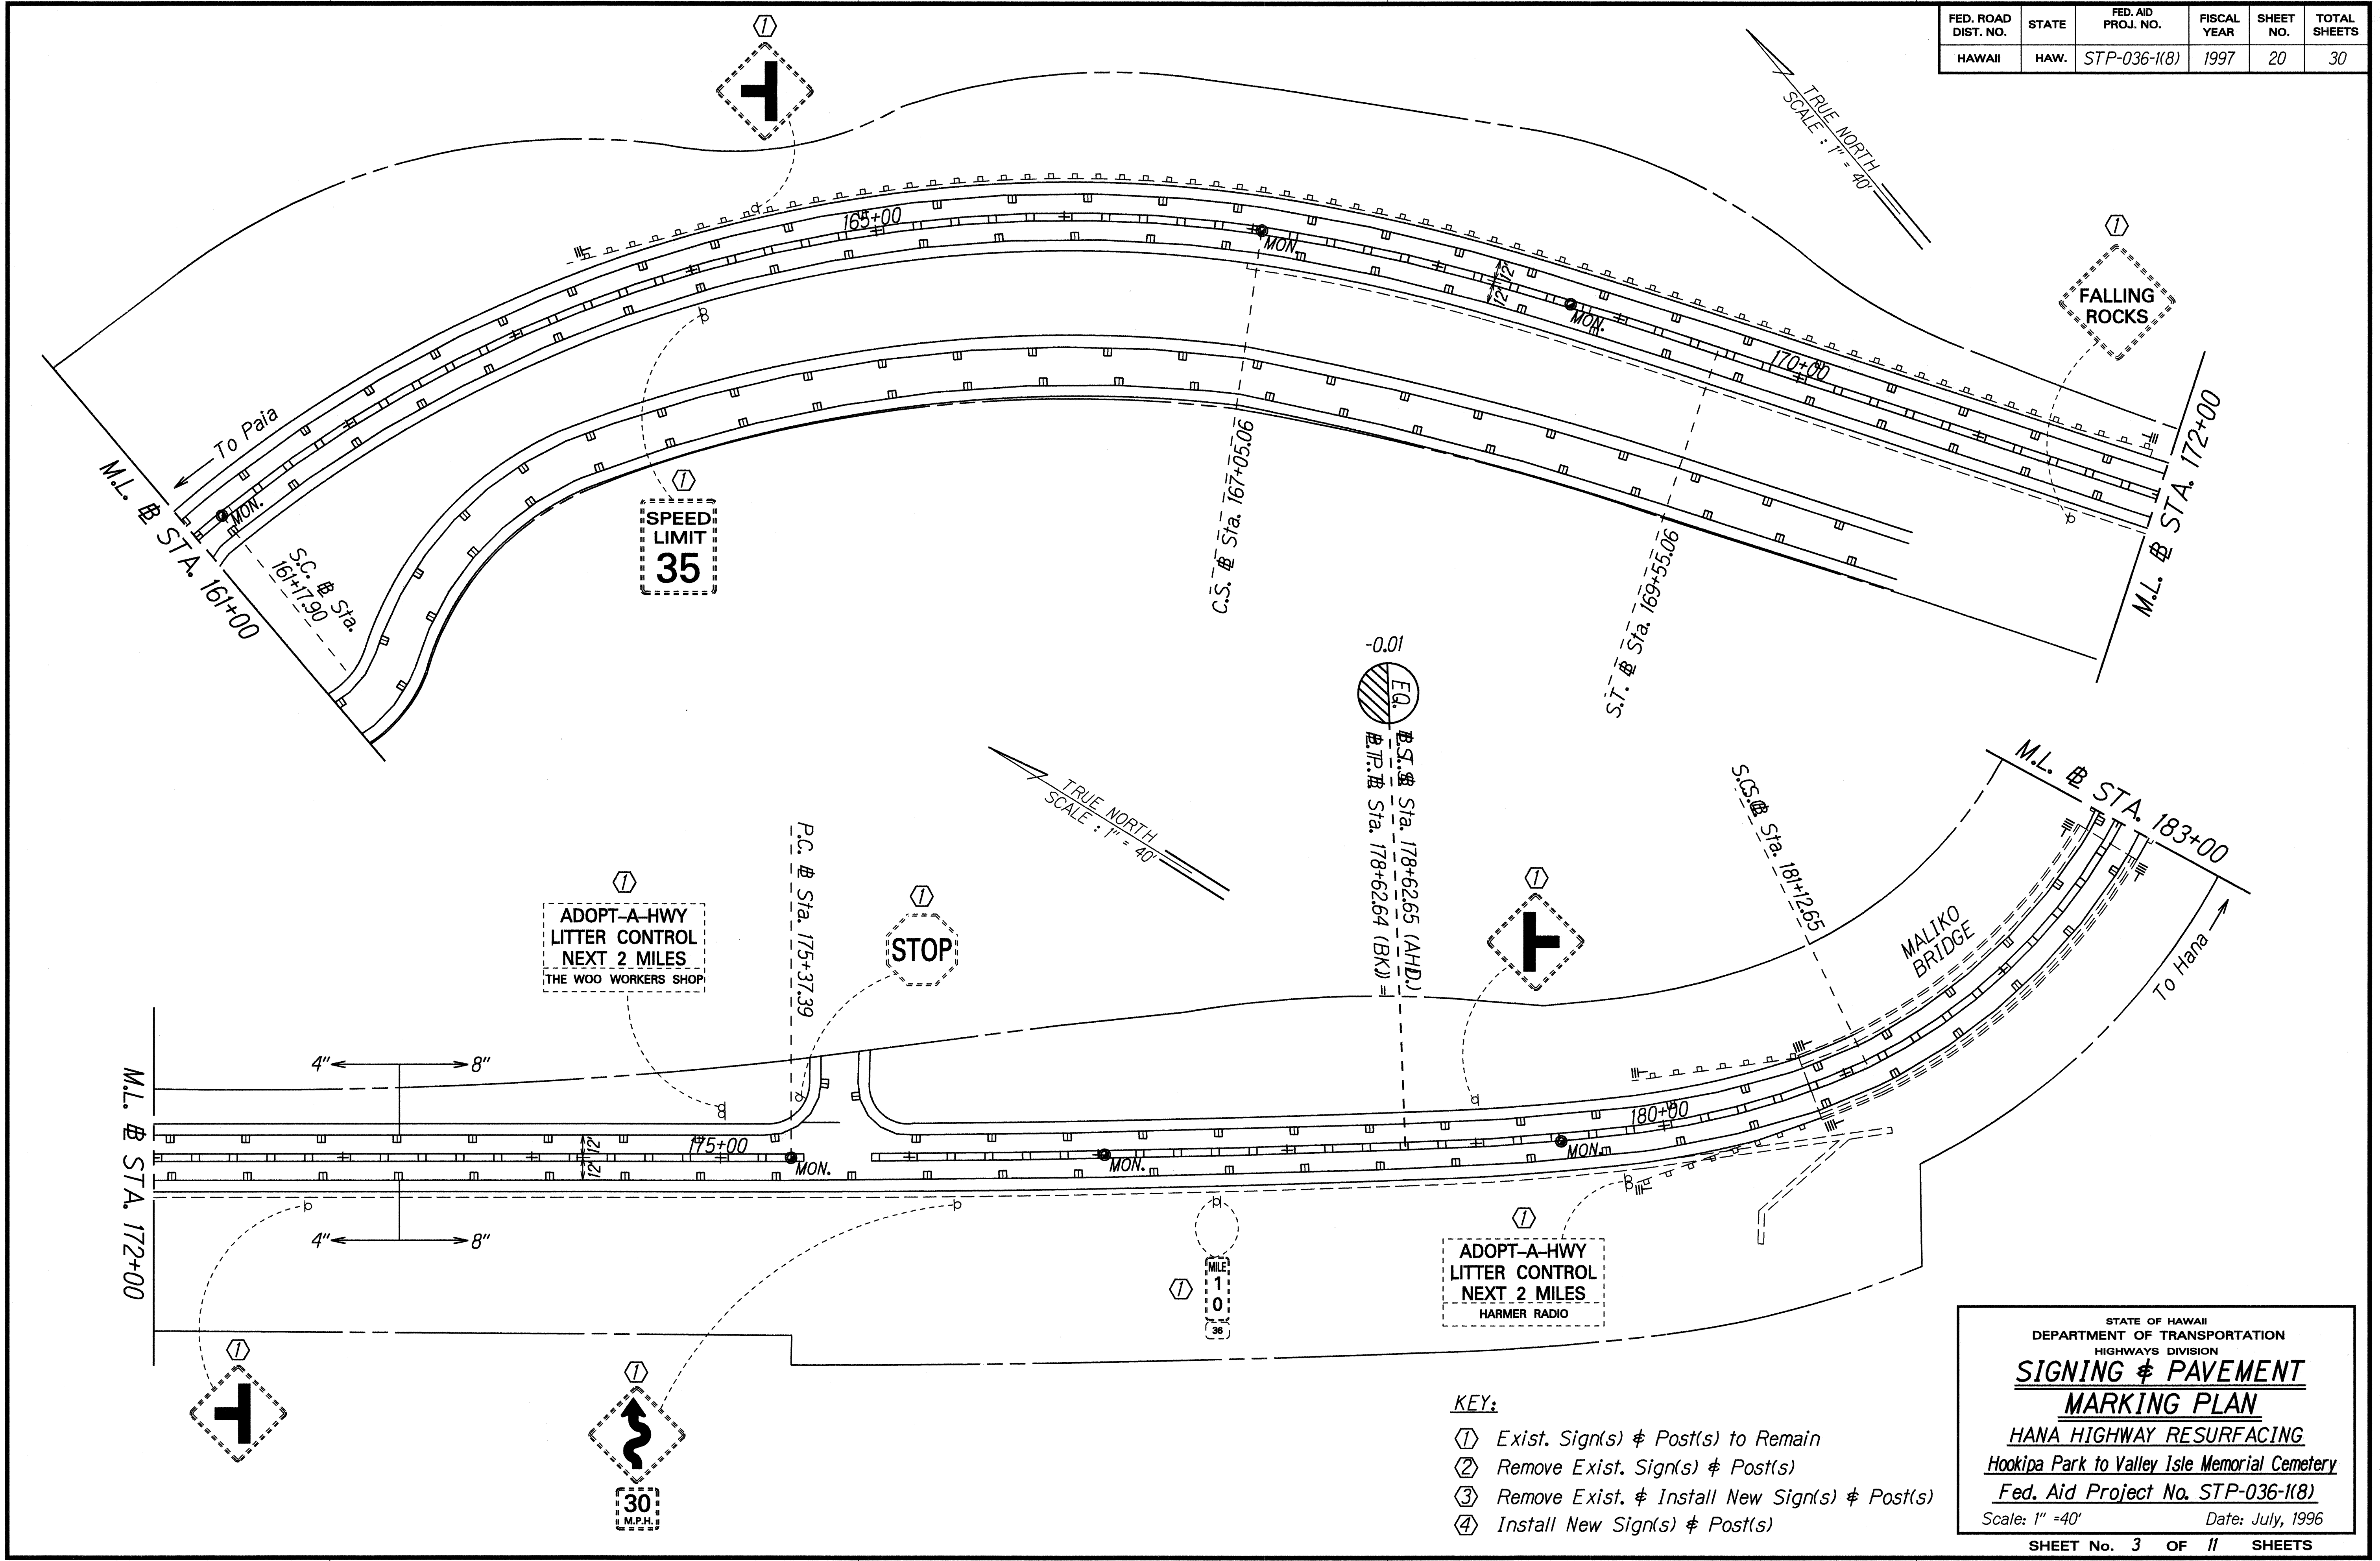

DATE	April, 1996
DESIGNED BY	...
CHECKED BY	...
...	...

- KEY:**
- ① Exist. Sign(s) & Post(s) to Remain
 - ② Remove Exist. Sign(s) & Post(s)
 - ③ Remove Exist. & Install New Sign(s) & Post(s)
 - ④ Install New Sign(s) & Post(s)


STATE OF HAWAII
DEPARTMENT OF TRANSPORTATION
HIGHWAYS DIVISION

SIGNING & PAVEMENT MARKING PLAN

HANA HIGHWAY RESURFACING
Hookipa Park to Valley Isle Memorial Cemetery
Fed. Aid Project No. STP-036-1(8)
Scale: 1" = 40' Date: July, 1996

SHEET No. 3 OF 11 SHEETS

FED. ROAD DIST. NO.	STATE	FED. AID PROJ. NO.	FISCAL YEAR	SHEET NO.	TOTAL SHEETS
HAWAII	HAW.	STP-036-1(8)	1997	21	30

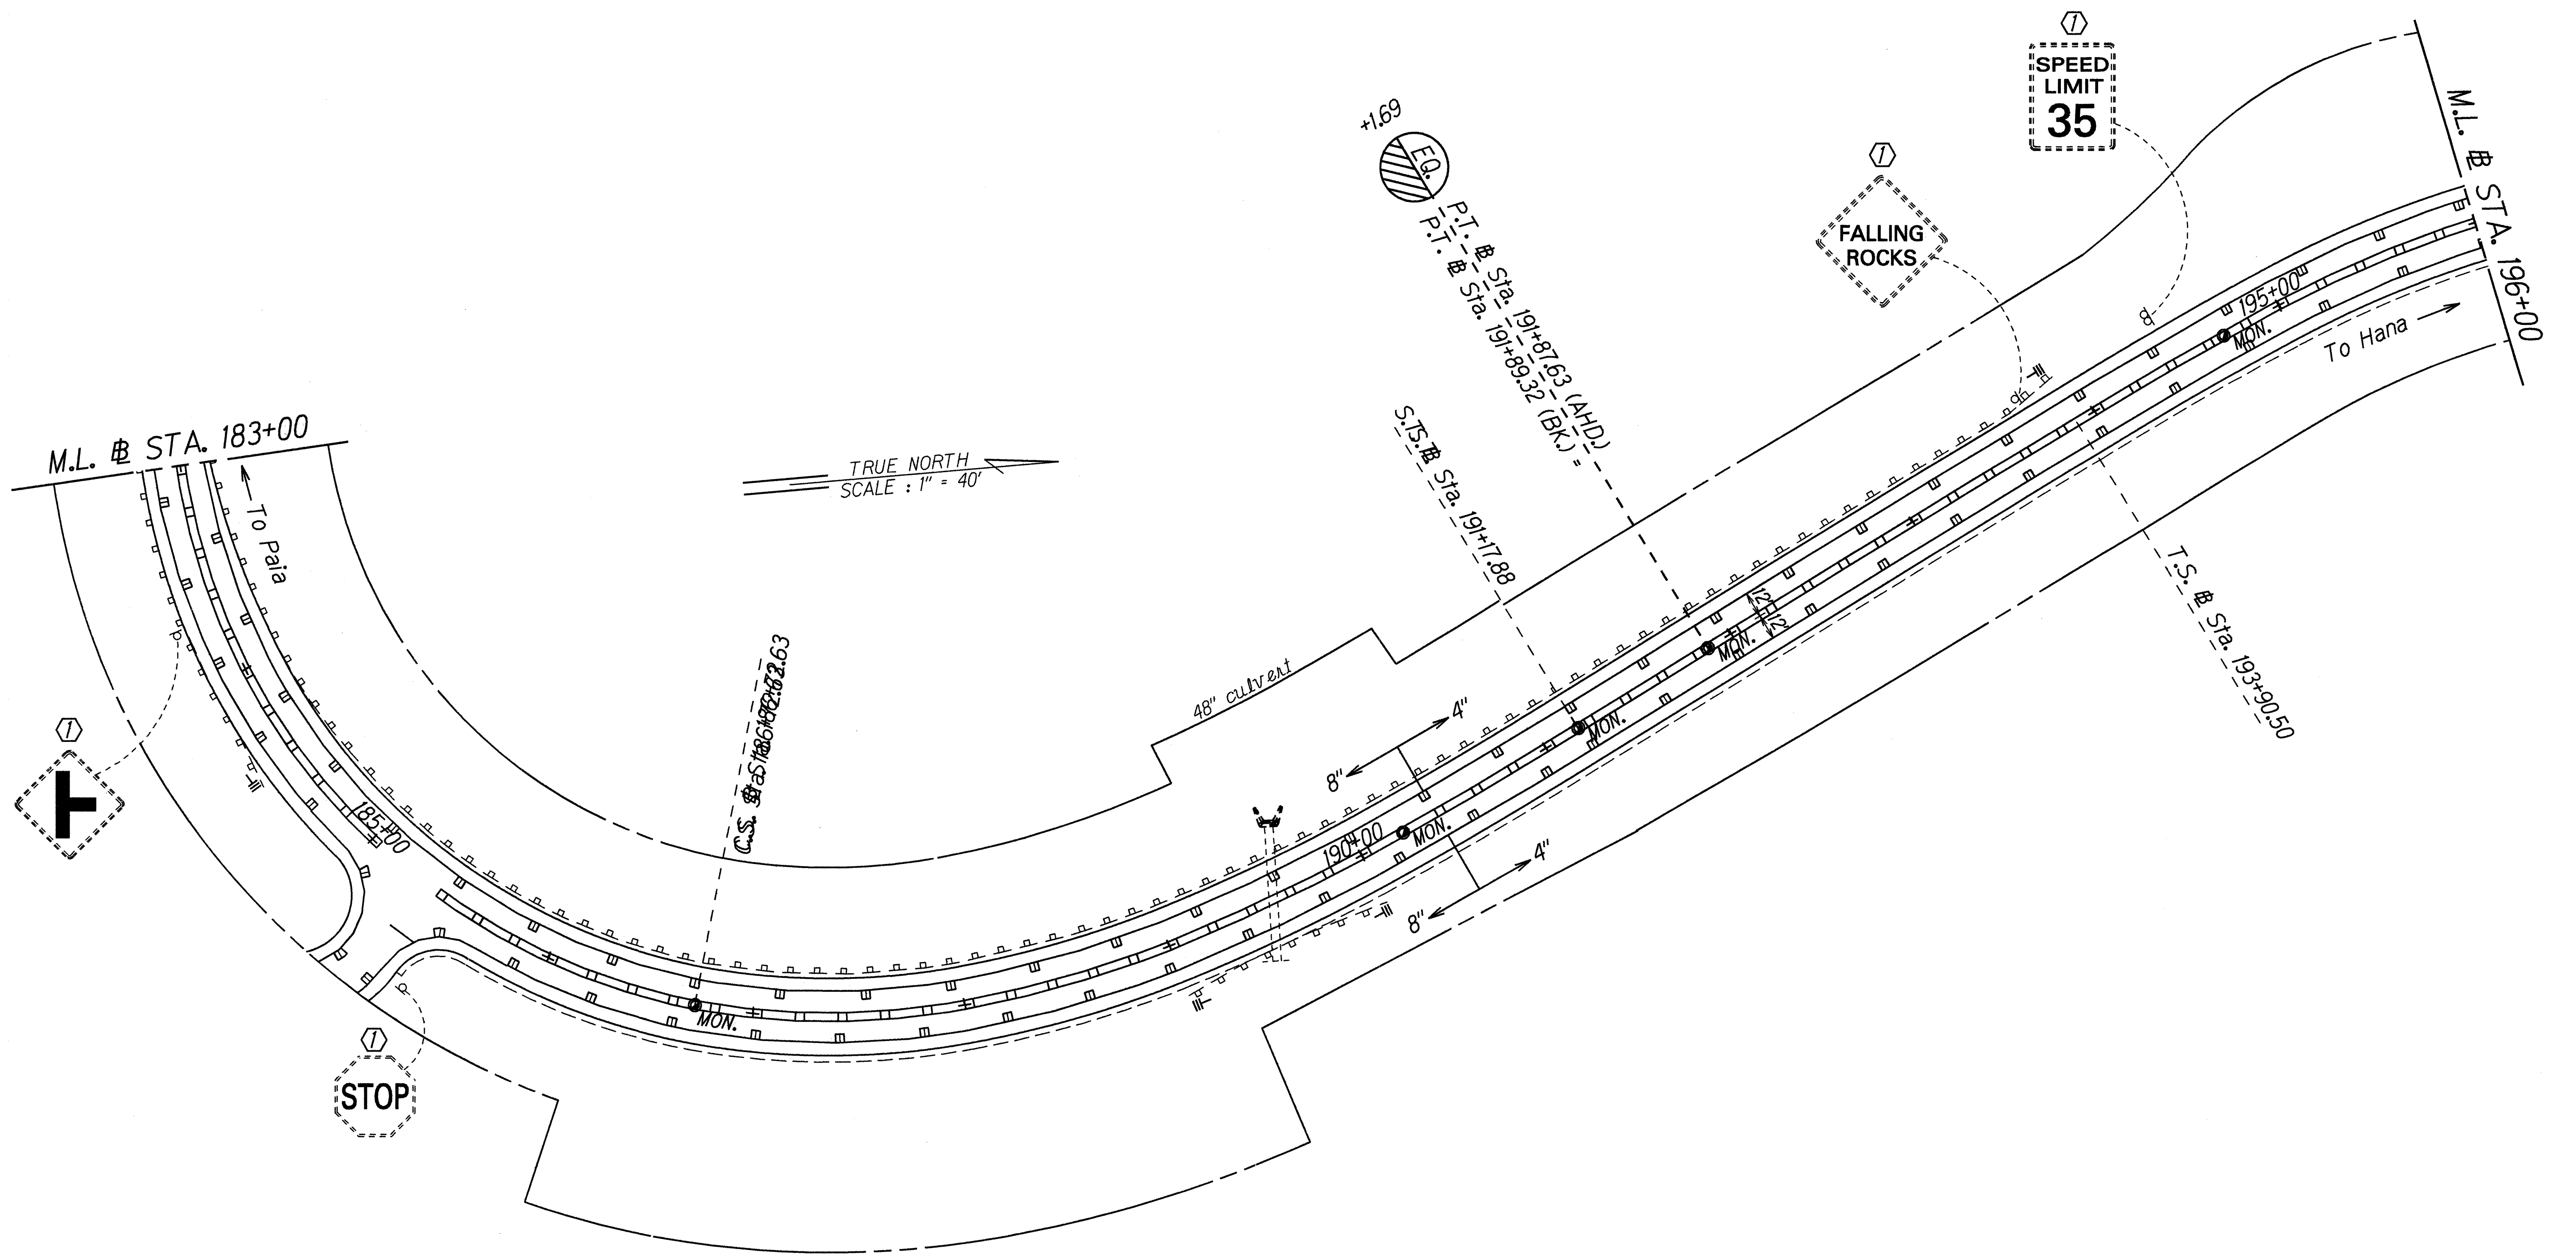

ORIGINAL PLAN	DATE
SURVEY PLOTTED BY	April 1996
DRAWN BY	
TRACED BY	
DESIGNED BY	
CHECKED BY	
QUANTITIES BY	
CHANGED BY	

- KEY:**
- ① Exist. Sign(s) & Post(s) to Remain
 - ② Remove Exist. Sign(s) & Post(s)
 - ③ Remove Exist. & Install New Sign(s) & Post(s)
 - ④ Install New Sign(s) & Post(s)


STATE OF HAWAII
DEPARTMENT OF TRANSPORTATION
HIGHWAYS DIVISION

**SIGNING & PAVEMENT
MARKING PLAN**

HANA HIGHWAY RESURFACING
Hookipa Park to Valley Isle Memorial Cemetery
Fed. Aid Project No. STP-036-1(8)
Scale: 1" = 40' Date: July, 1996

SHEET No. 4 OF 11 SHEETS

FED. ROAD DIST. NO.	STATE	FED. AID PROJ. NO.	FISCAL YEAR	SHEET NO.	TOTAL SHEETS
HAWAII	HAW.	STP-036-1(8)	1997	22	30

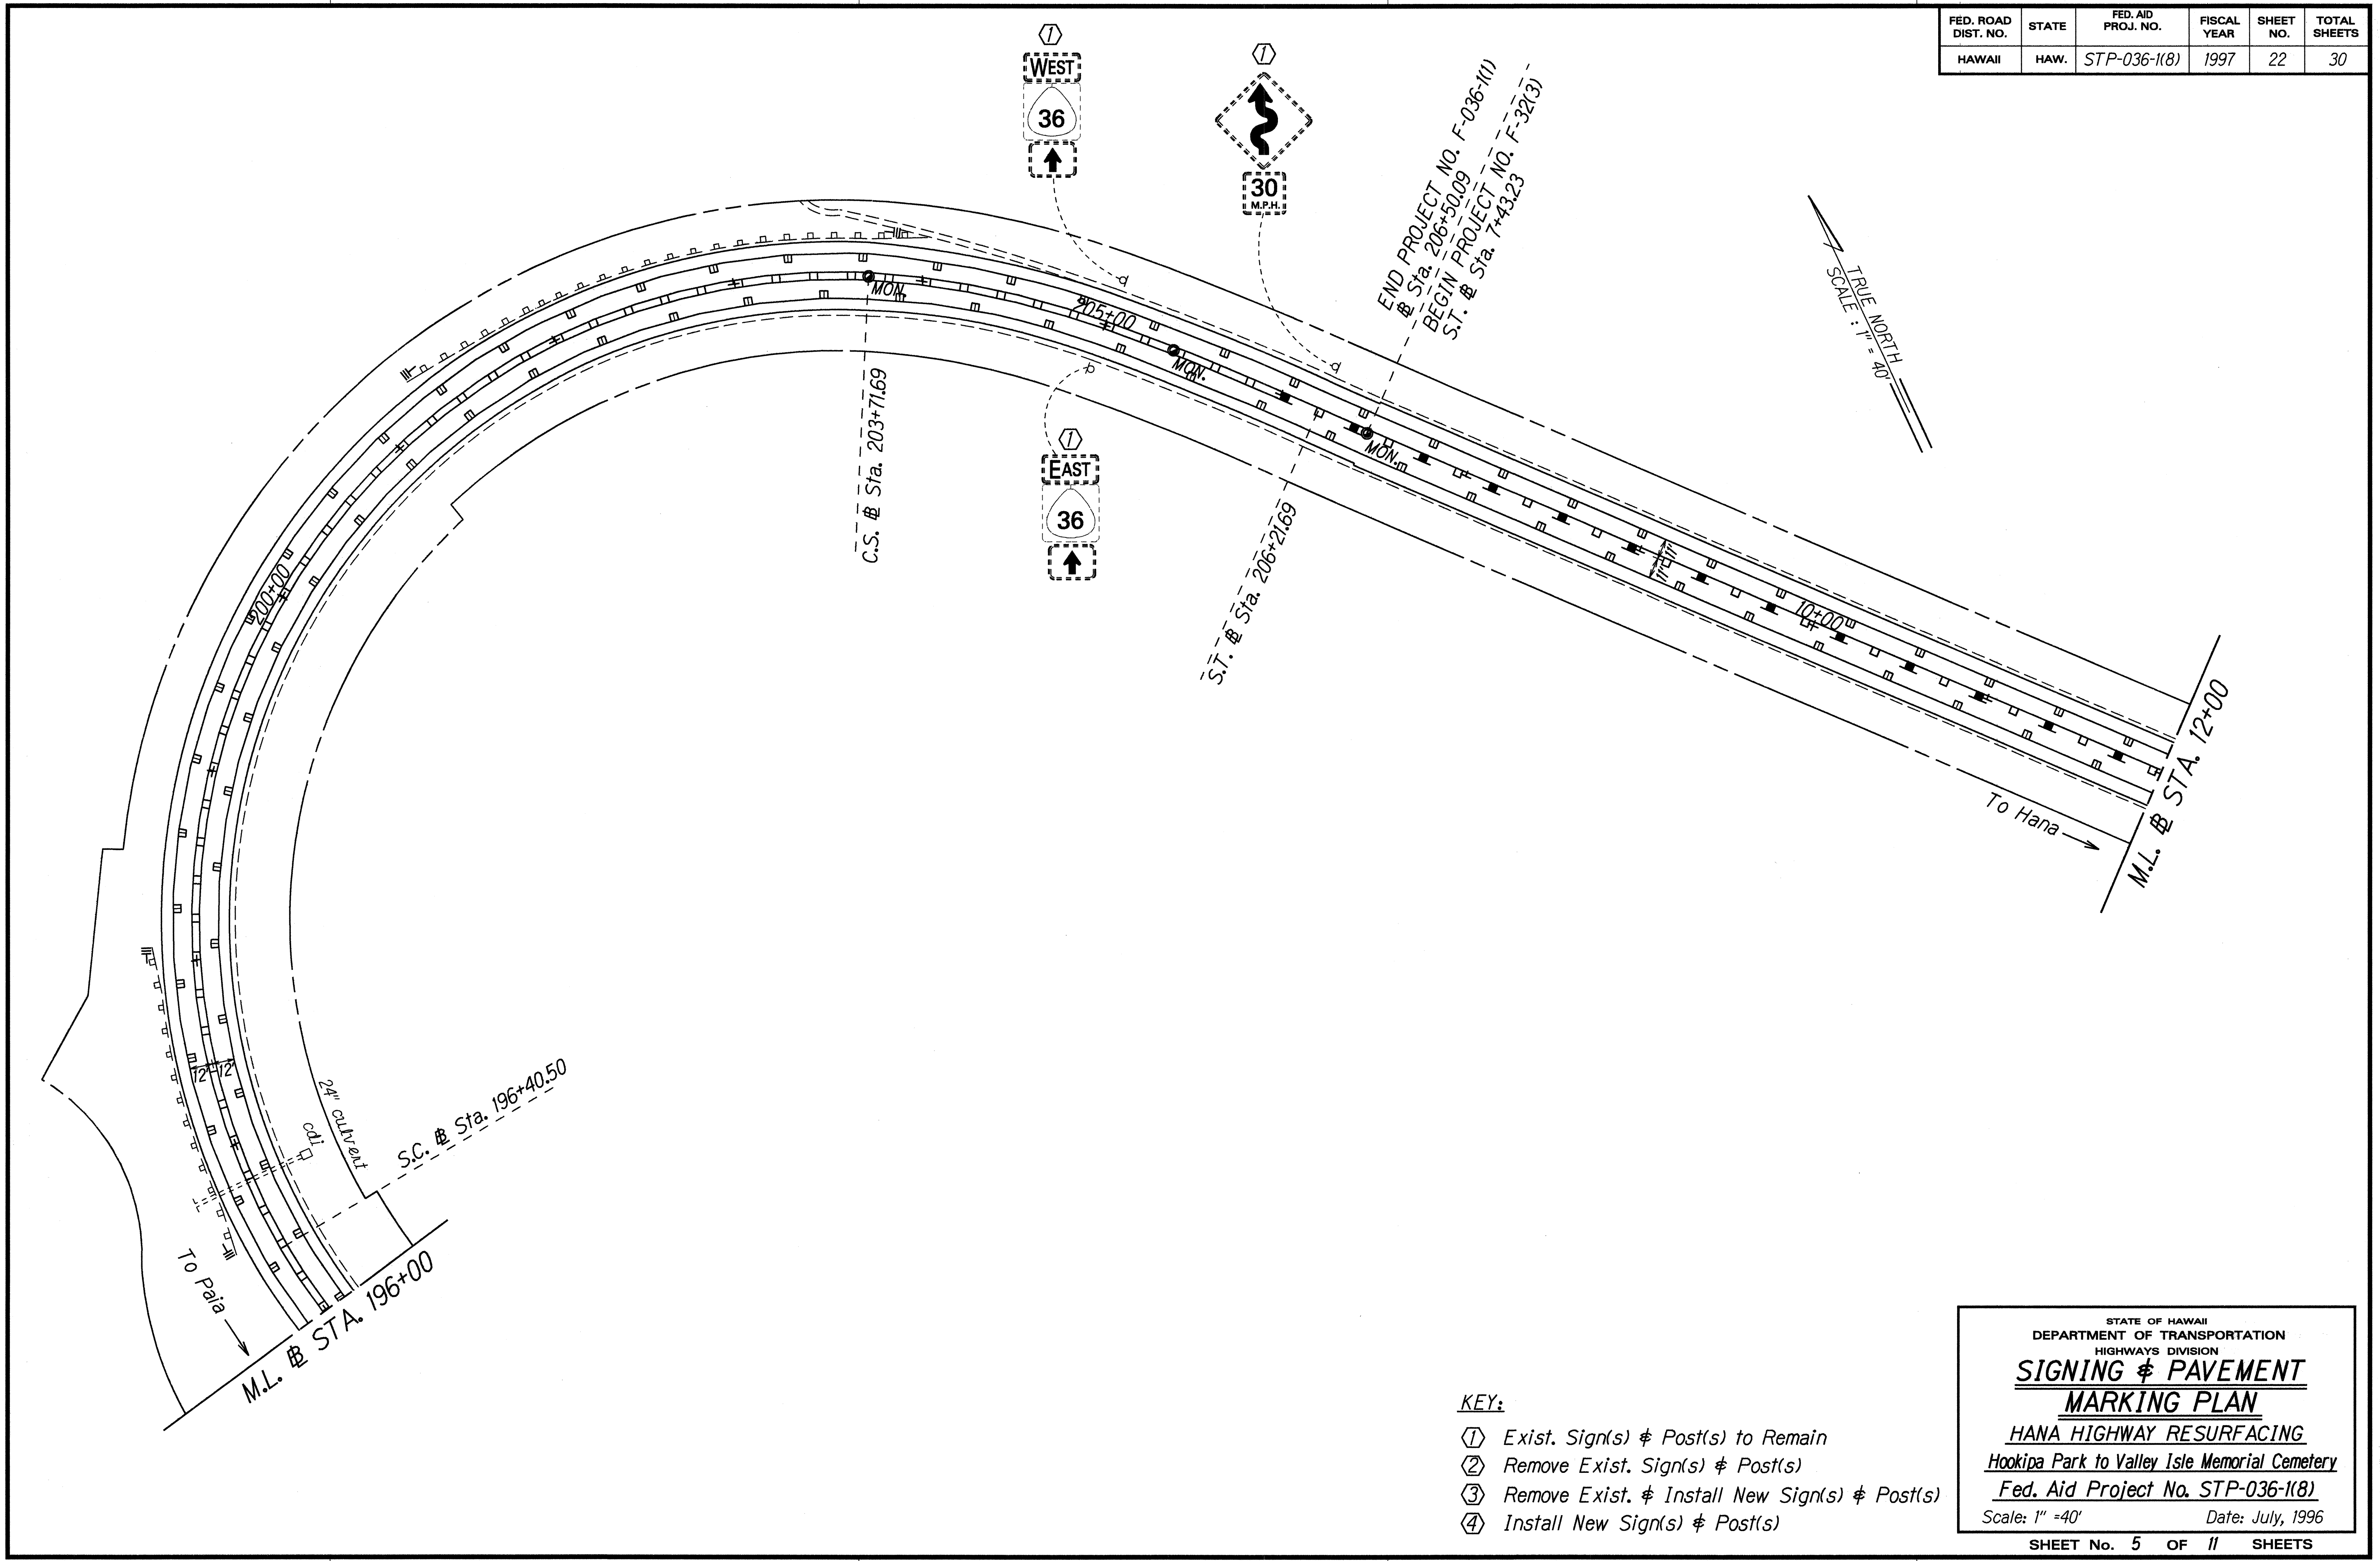

ORIGINAL PLAN	SURVEY DATED BY	DATE
NOV 1995	DRAWN BY	April 1996
DESIGNED BY	TRACED BY	
QUANTITIES BY	CHECKED BY	

- KEY:**
- ① Exist. Sign(s) & Post(s) to Remain
 - ② Remove Exist. Sign(s) & Post(s)
 - ③ Remove Exist. & Install New Sign(s) & Post(s)
 - ④ Install New Sign(s) & Post(s)


STATE OF HAWAII
DEPARTMENT OF TRANSPORTATION
HIGHWAYS DIVISION

**SIGNING & PAVEMENT
MARKING PLAN**

HANA HIGHWAY RESURFACING
Hookipa Park to Valley Isle Memorial Cemetery
Fed. Aid Project No. STP-036-1(8)
Scale: 1" = 40' Date: July, 1996

SHEET No. 5 OF 11 SHEETS

FED. ROAD DIST. NO.	STATE	FED. AID PROJ. NO.	FISCAL YEAR	SHEET NO.	TOTAL SHEETS
HAWAII	HAW.	STP-036-1(8)	1997	23	30

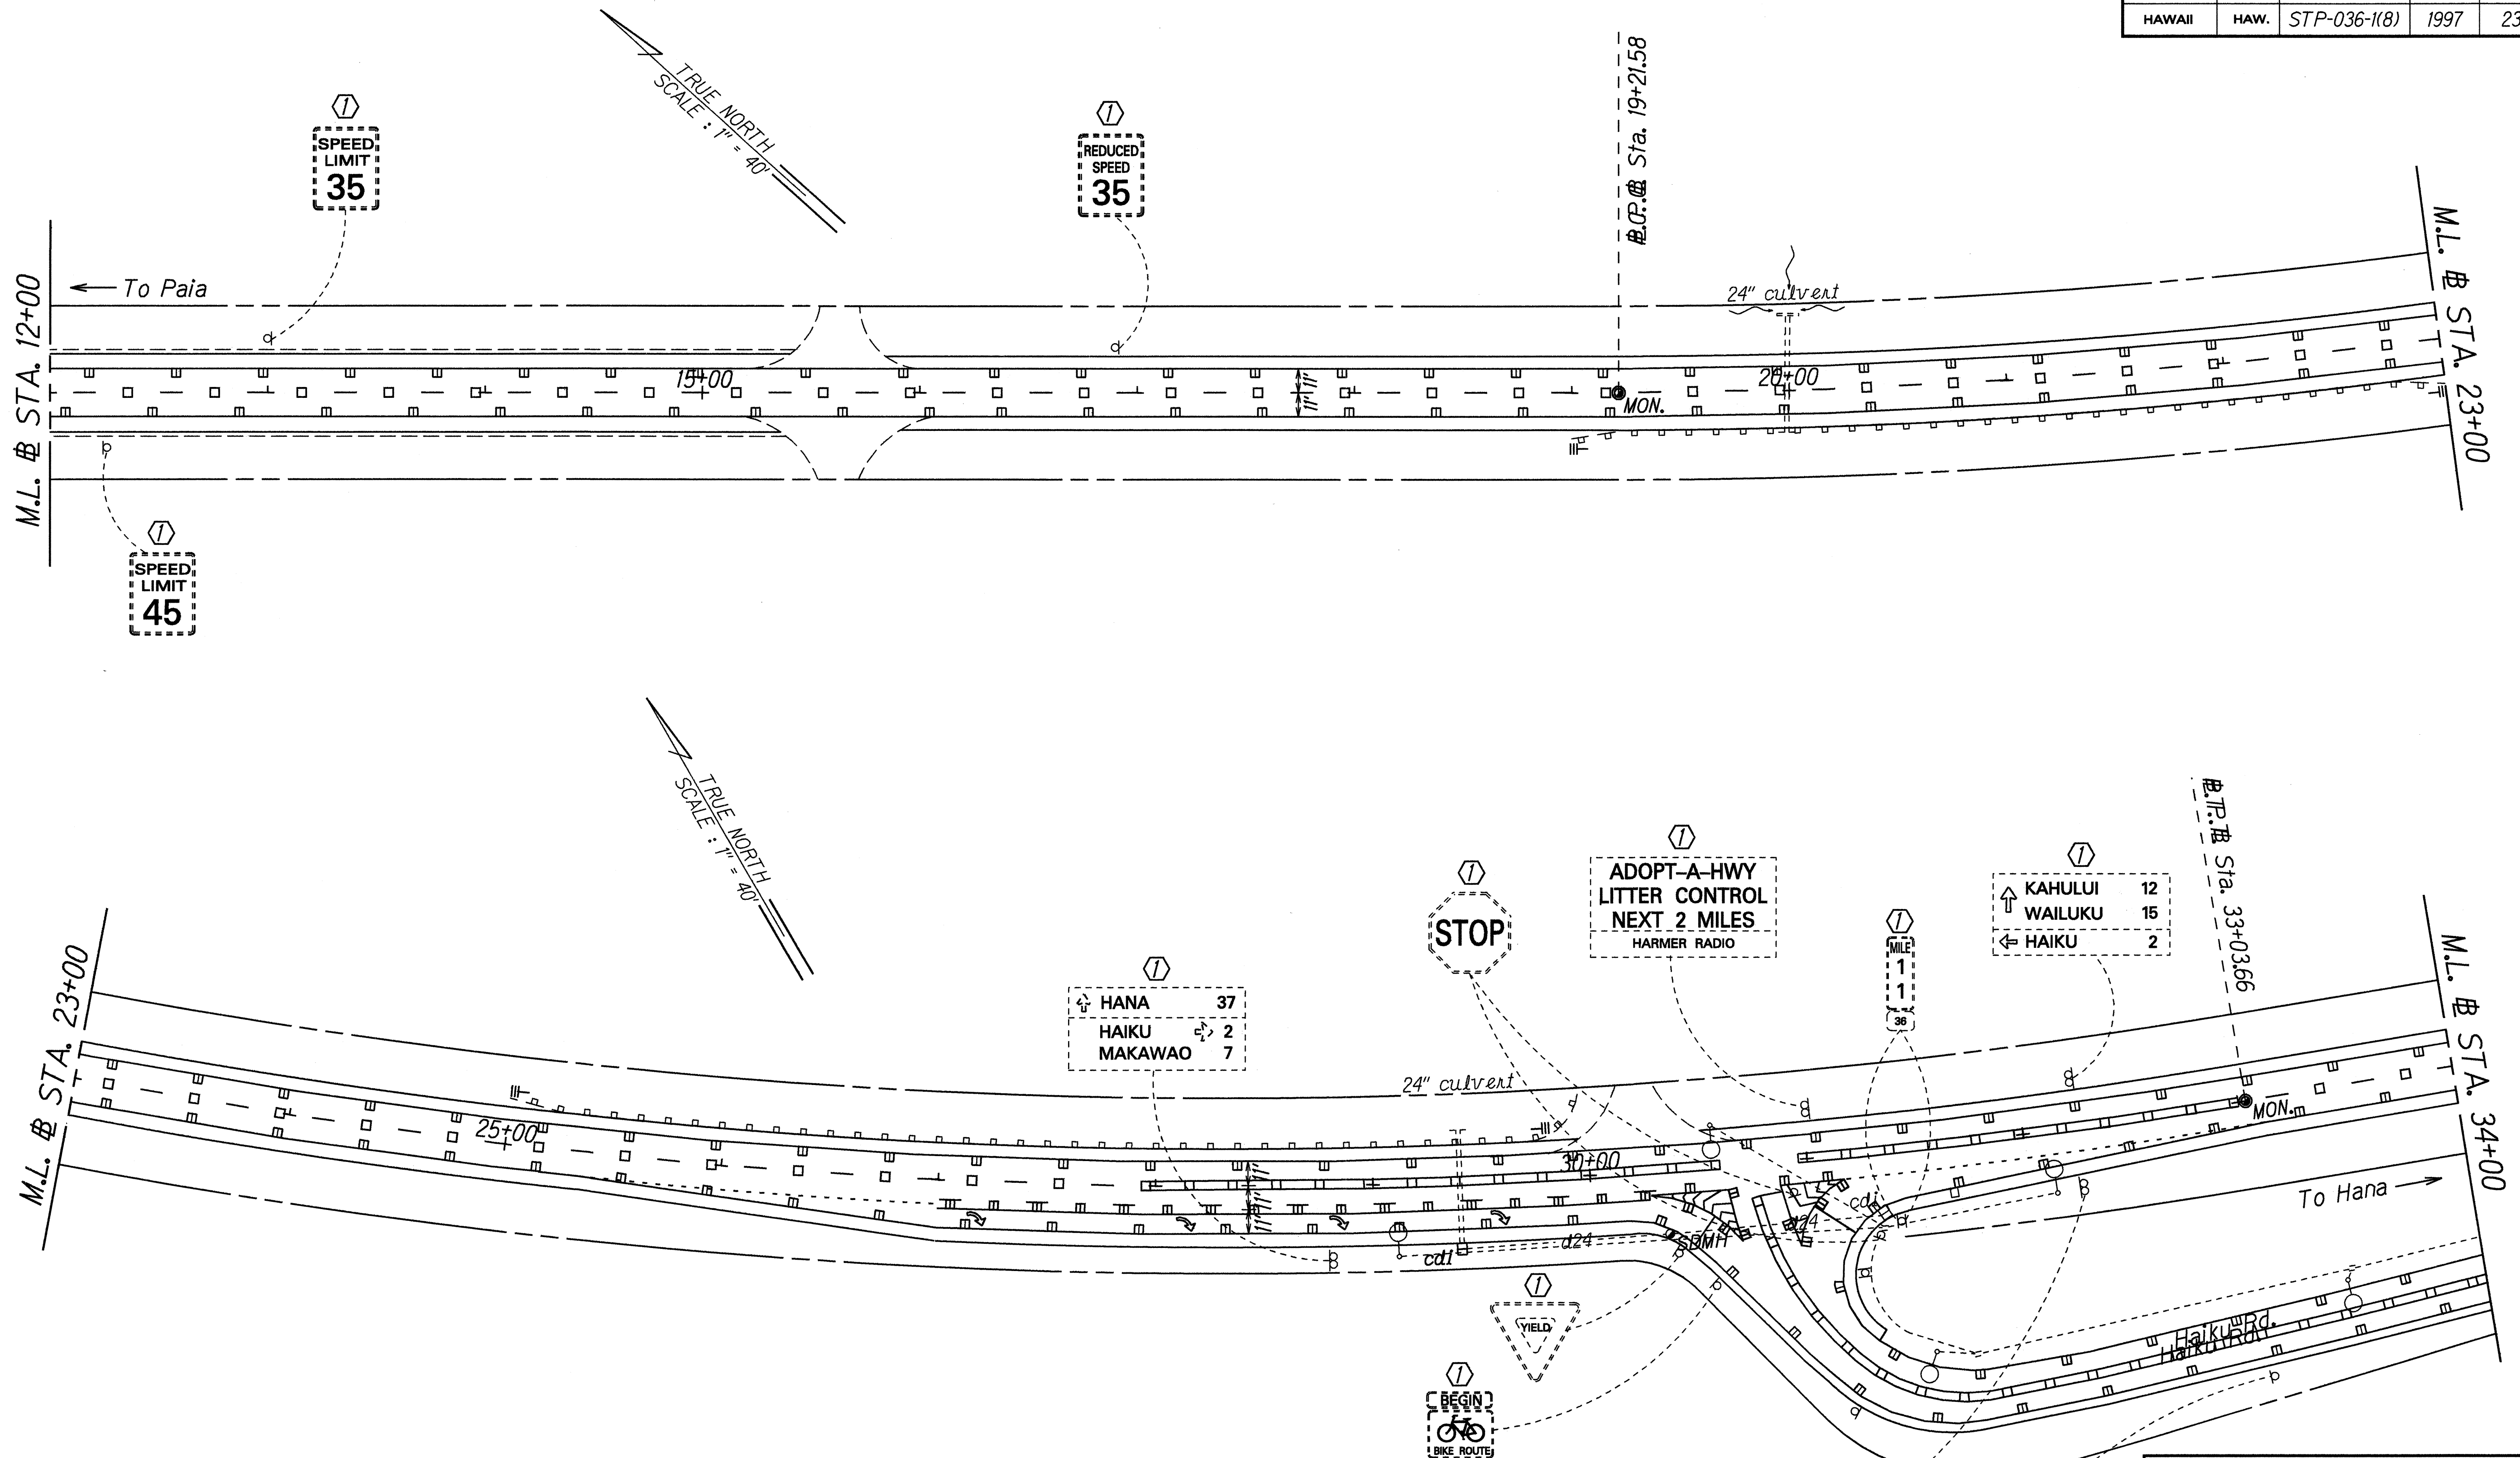


ORIGINAL PLAN	DATE
SURVEY PLACED BY	ADRIEL 1996
DRAWN BY	
TRACED BY	
DESIGNED BY	
QUANTITIES BY	
CHECKED BY	

- KEY:**
- ① Exist. Sign(s) & Post(s) to Remain
 - ② Remove Exist. Sign(s) & Post(s)
 - ③ Remove Exist. & Install New Sign(s) & Post(s)
 - ④ Install New Sign(s) & Post(s)

STATE OF HAWAII
 DEPARTMENT OF TRANSPORTATION
 HIGHWAYS DIVISION
SIGNING & PAVEMENT MARKING PLAN
HANA HIGHWAY RESURFACING
 Hookipa Park to Valley Isle Memorial Cemetery
 Fed. Aid Project No. STP-036-1(8)
 Scale: 1" = 40' Date: July, 1996
 SHEET No. 6 OF 11 SHEETS

FED. ROAD DIST. NO.	STATE	FED. AID PROJ. NO.	FISCAL YEAR	SHEET NO.	TOTAL SHEETS
HAWAII	HAW.	STP-036-1(8)	1997	24	30

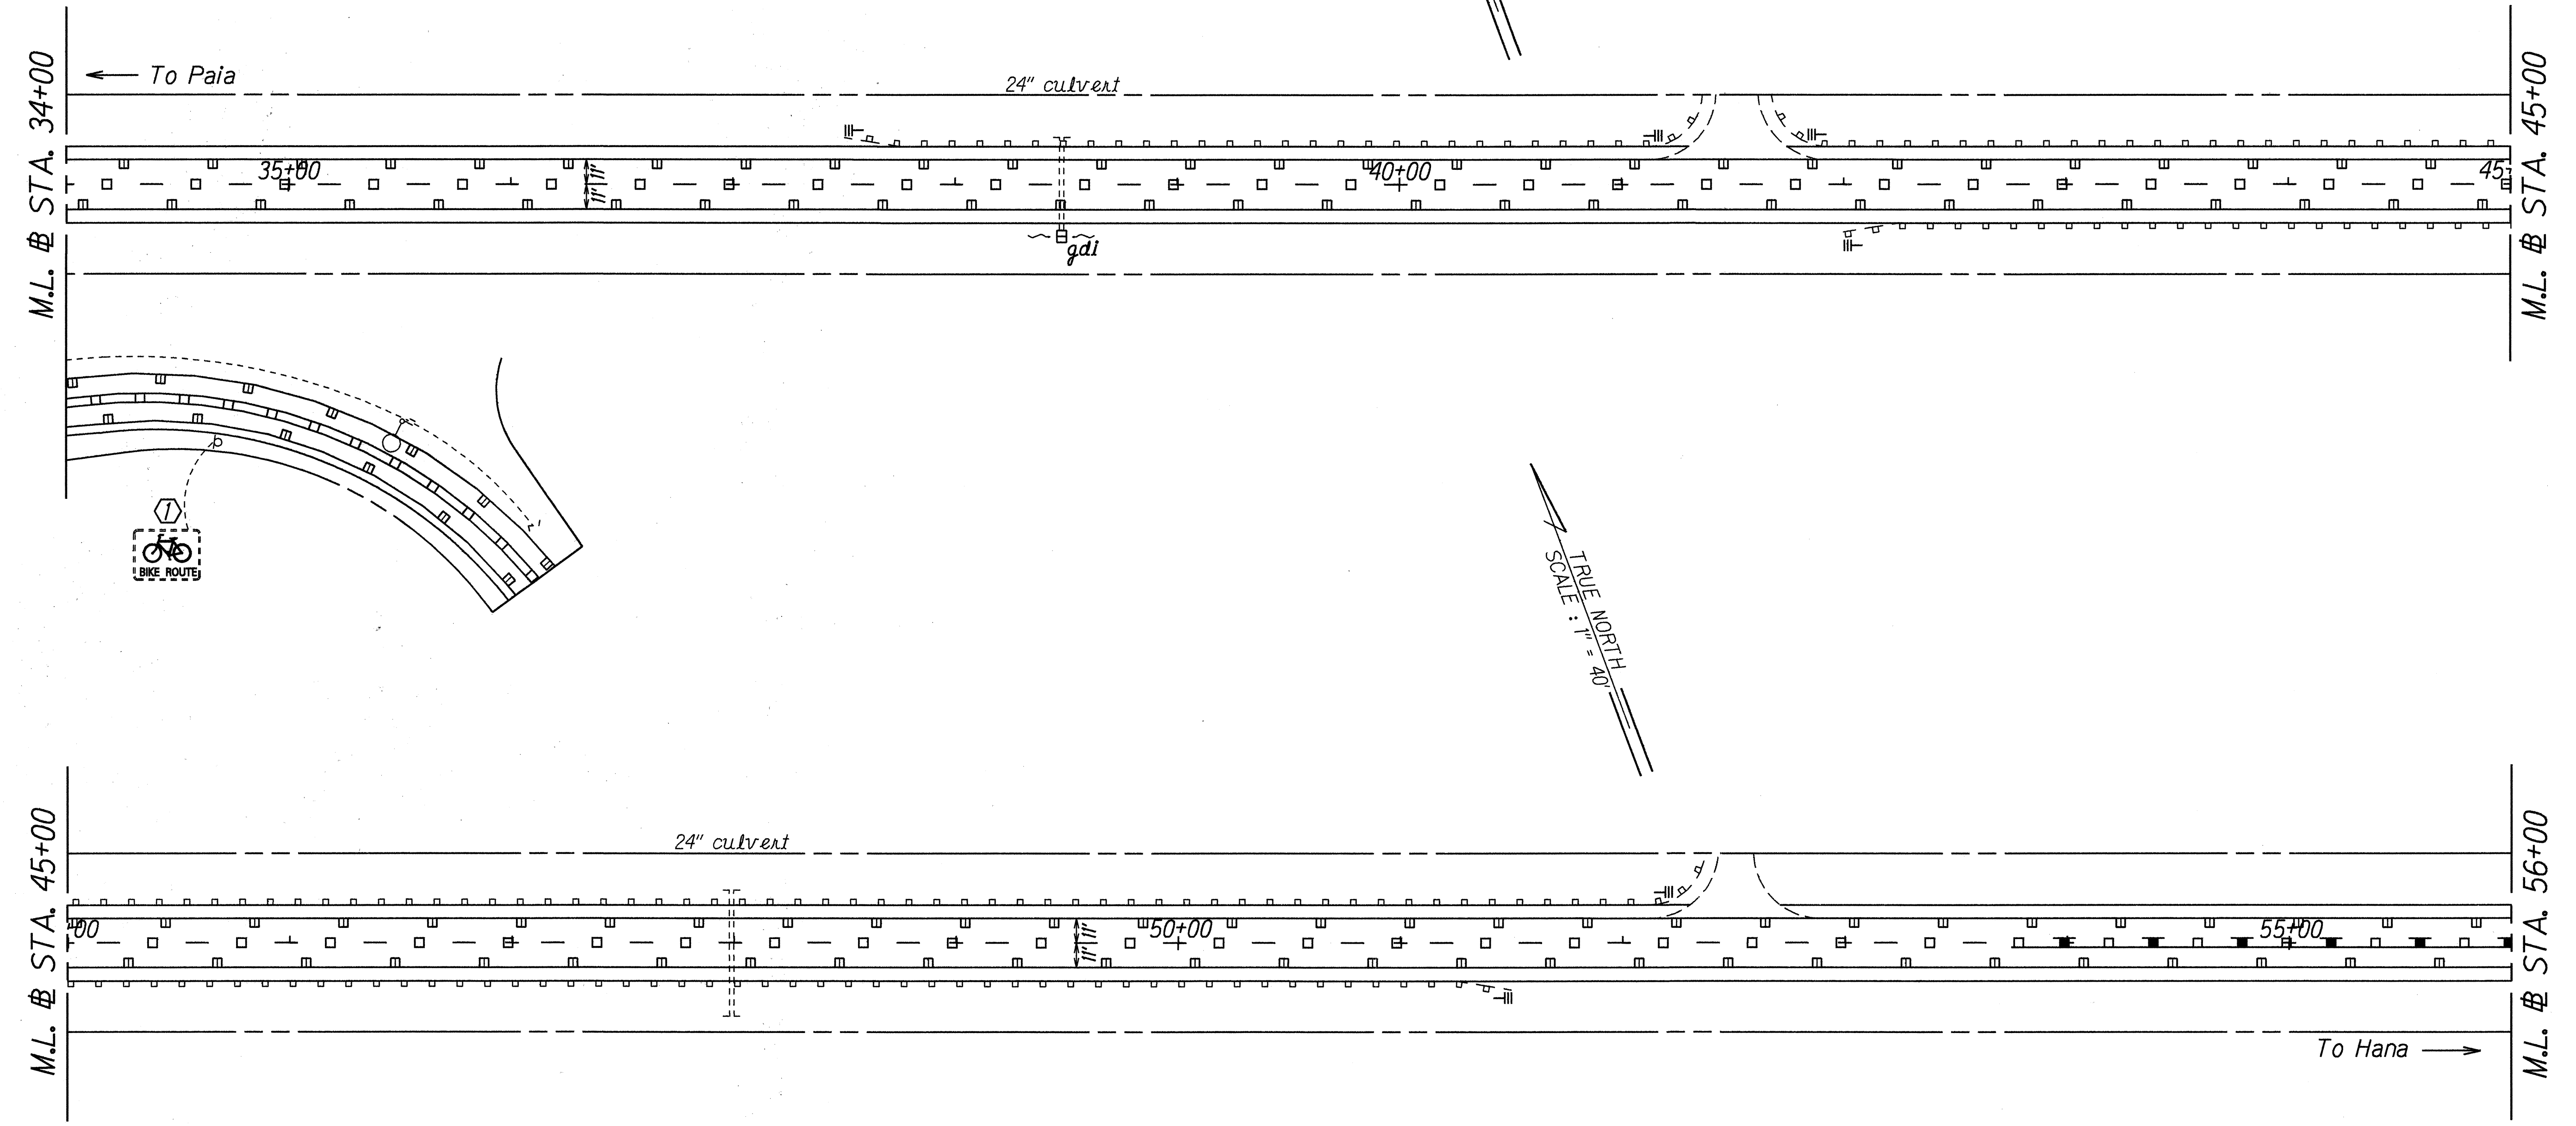

ORIGINAL PLAN	SURVEY PLACED BY	DATE
TRACED BY	DRAWN BY	ADJL 1996
DESIGNED BY	DESIGNED BY	
QUANTITIES BY	QUANTITIES BY	
CHECKED BY	CHECKED BY	

- KEY:**
- ① Exist. Sign(s) & Post(s) to Remain
 - ② Remove Exist. Sign(s) & Post(s)
 - ③ Remove Exist. & Install New Sign(s) & Post(s)
 - ④ Install New Sign(s) & Post(s)


STATE OF HAWAII
DEPARTMENT OF TRANSPORTATION
HIGHWAYS DIVISION

**SIGNING & PAVEMENT
MARKING PLAN**

HANA HIGHWAY RESURFACING
Hookipa Park to Valley Isle Memorial Cemetery
Fed. Aid Project No. STP-036-1(8)
Scale: 1" = 40' Date: July, 1996

SHEET No. 7 OF 11 SHEETS

FED. ROAD DIST. NO.	STATE	FED. AID PROJ. NO.	FISCAL YEAR	SHEET NO.	TOTAL SHEETS
HAWAII	HAW.	STP-036-1(8)	1997	25	30

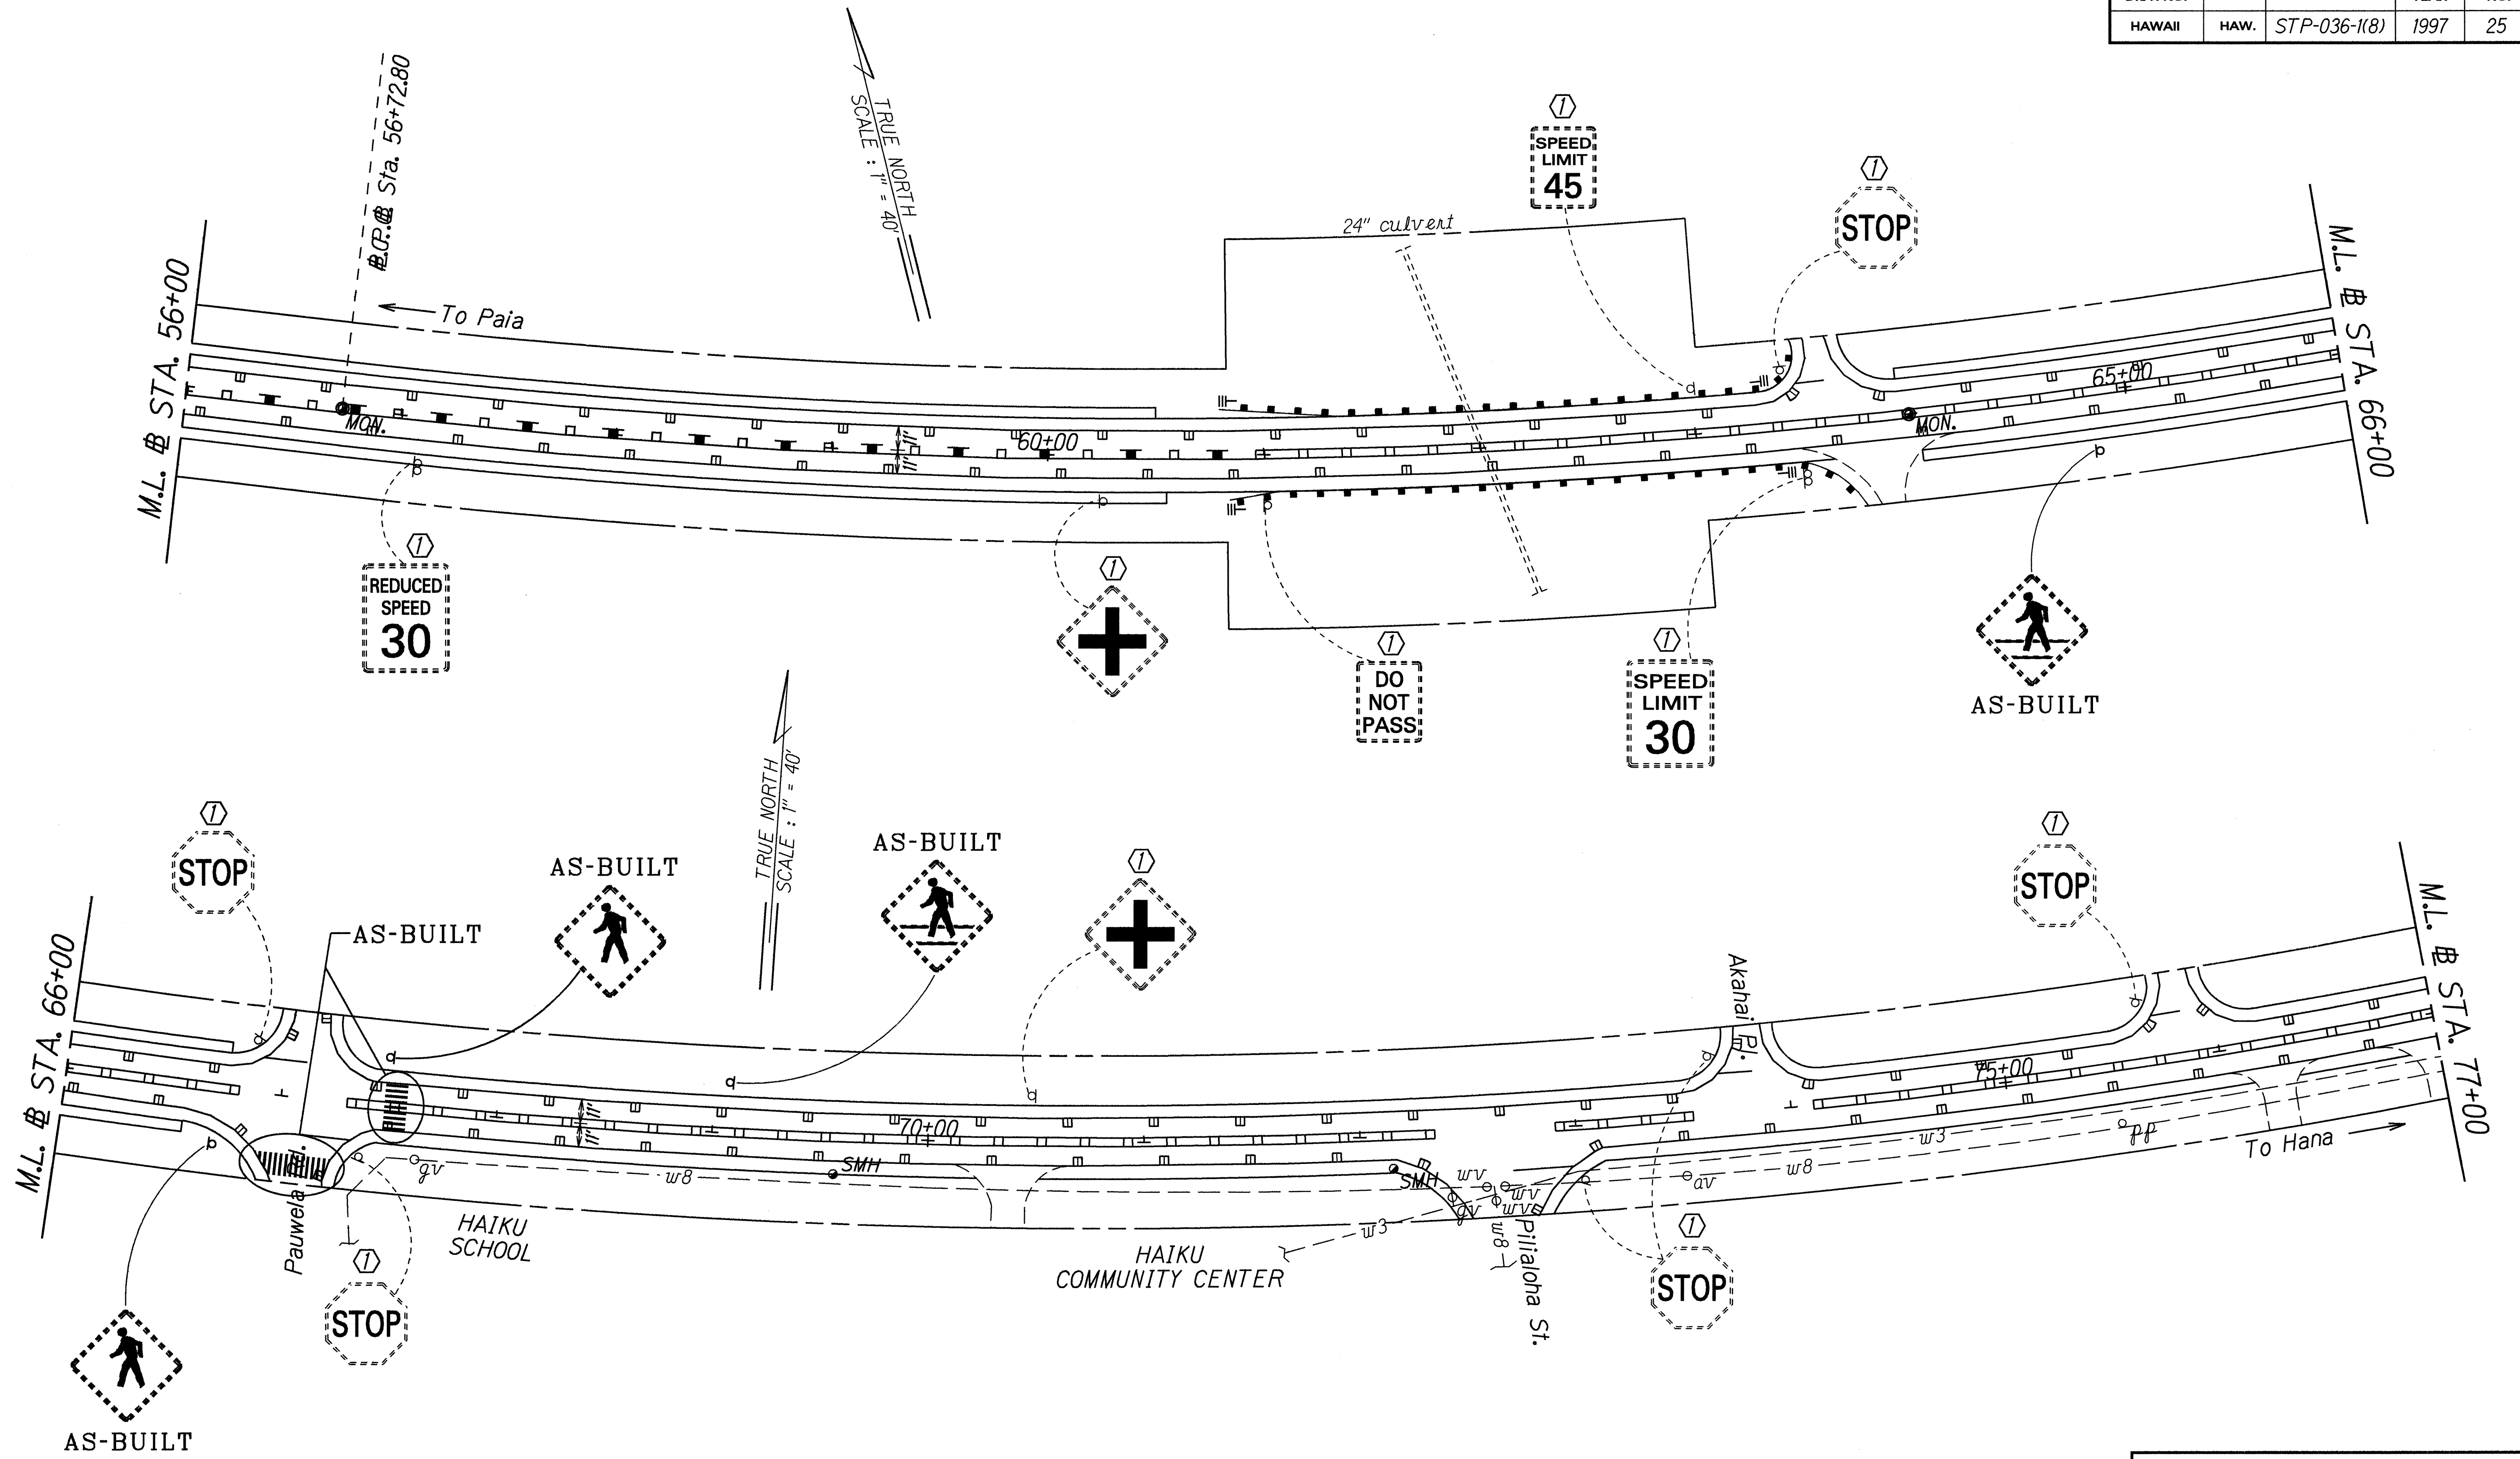

ORIGINAL PLAN	DATE
DESIGNED BY	APRIL 1996
DRAWN BY	ABZ-4-96
CHECKED BY	
QUANTITIES BY	
NOTED BY	

LEGEND FOR AS-BUILT POSTINGS

	Squiggly line for as-built deletion
	Double line for as-built deletion
Roadway	Text for as-built posting

- KEY:**
- ① Exist. Sign(s) & Post(s) to Remain
 - ② Remove Exist. Sign(s) & Post(s)
 - ③ Remove Exist. & Install New Sign(s) & Post(s)
 - ④ Install New Sign(s) & Post(s)

STATE OF HAWAII
DEPARTMENT OF TRANSPORTATION
HIGHWAYS DIVISION


SIGNING & PAVEMENT MARKING PLAN

HANA HIGHWAY RESURFACING
Hookipa Park to Valley Isle Memorial Cemetery
Fed. Aid Project No. STP-036-1(8)
Scale: 1" = 40' Date: July, 1996

SHEET No. 8 OF 11 SHEETS

"AS-BUILT"

FED. ROAD DIST. NO.	STATE	FED. AID PROJ. NO.	FISCAL YEAR	SHEET NO.	TOTAL SHEETS
HAWAII	HAW.	STP-036-1(8)	1997	26	30

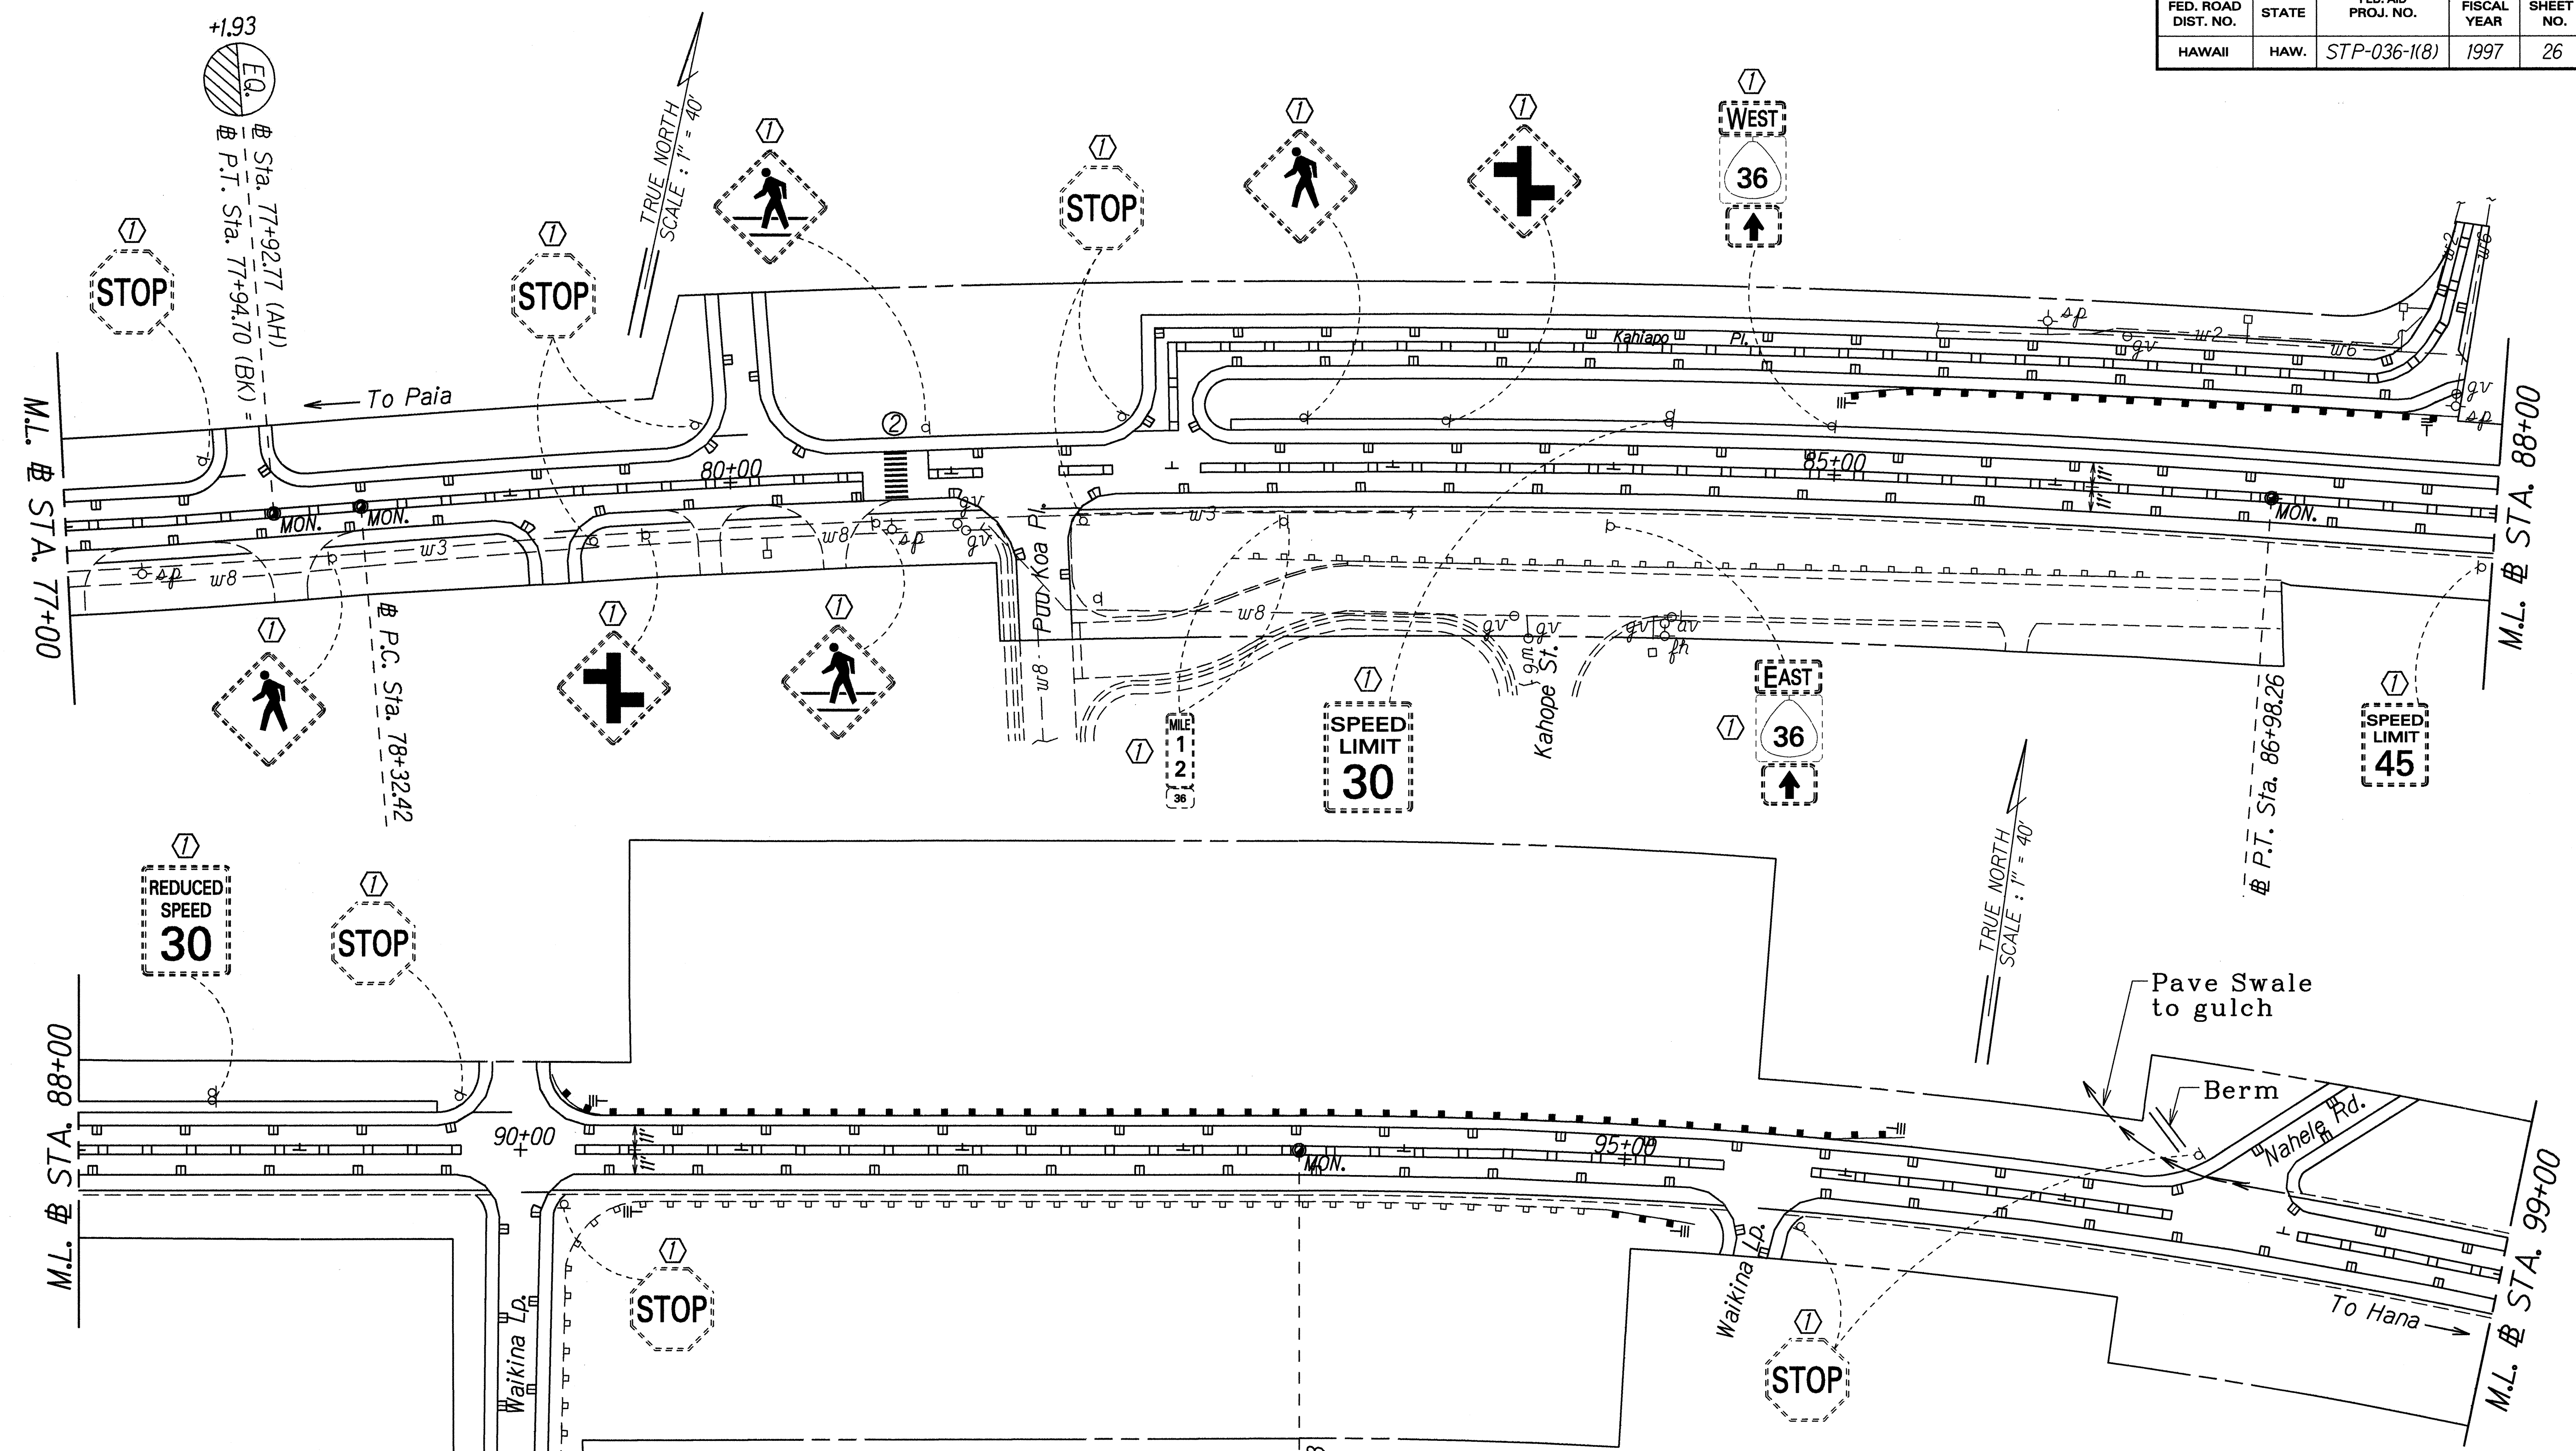

ORIGINAL PLAN	DATE
DESIGNED BY	APRIL 1996
DESIGNED BY	ABZ-5-99
QUANTITIES BY	
CHECKED BY	

LEGEND FOR AS-BUILT POSTINGS

	Squiggly line for as-built deletion
	Double line for as-built deletion
Roadway	Text for as-built posting

- KEY:**
- ① Exist. Sign(s) & Post(s) to Remain
 - ② Remove Exist. Sign(s) & Post(s)
 - ③ Remove Exist. & Install New Sign(s) & Post(s)
 - ④ Install New Sign(s) & Post(s)

STATE OF HAWAII
DEPARTMENT OF TRANSPORTATION
HIGHWAYS DIVISION


**SIGNING & PAVEMENT
MARKING PLAN**

HANA HIGHWAY RESURFACING
Hookipa Park to Valley Isle Memorial Cemetery
Fed. Aid Project No. STP-036-1(8)
Scale: 1" = 40' Date: July, 1996

SHEET No. 9 OF 11 SHEETS

"AS-BUILT"

FED. ROAD DIST. NO.	STATE	FED. AID PROJ. NO.	FISCAL YEAR	SHEET NO.	TOTAL SHEETS
HAWAII	HAW.	STP-036-1(8)	1997	27	30

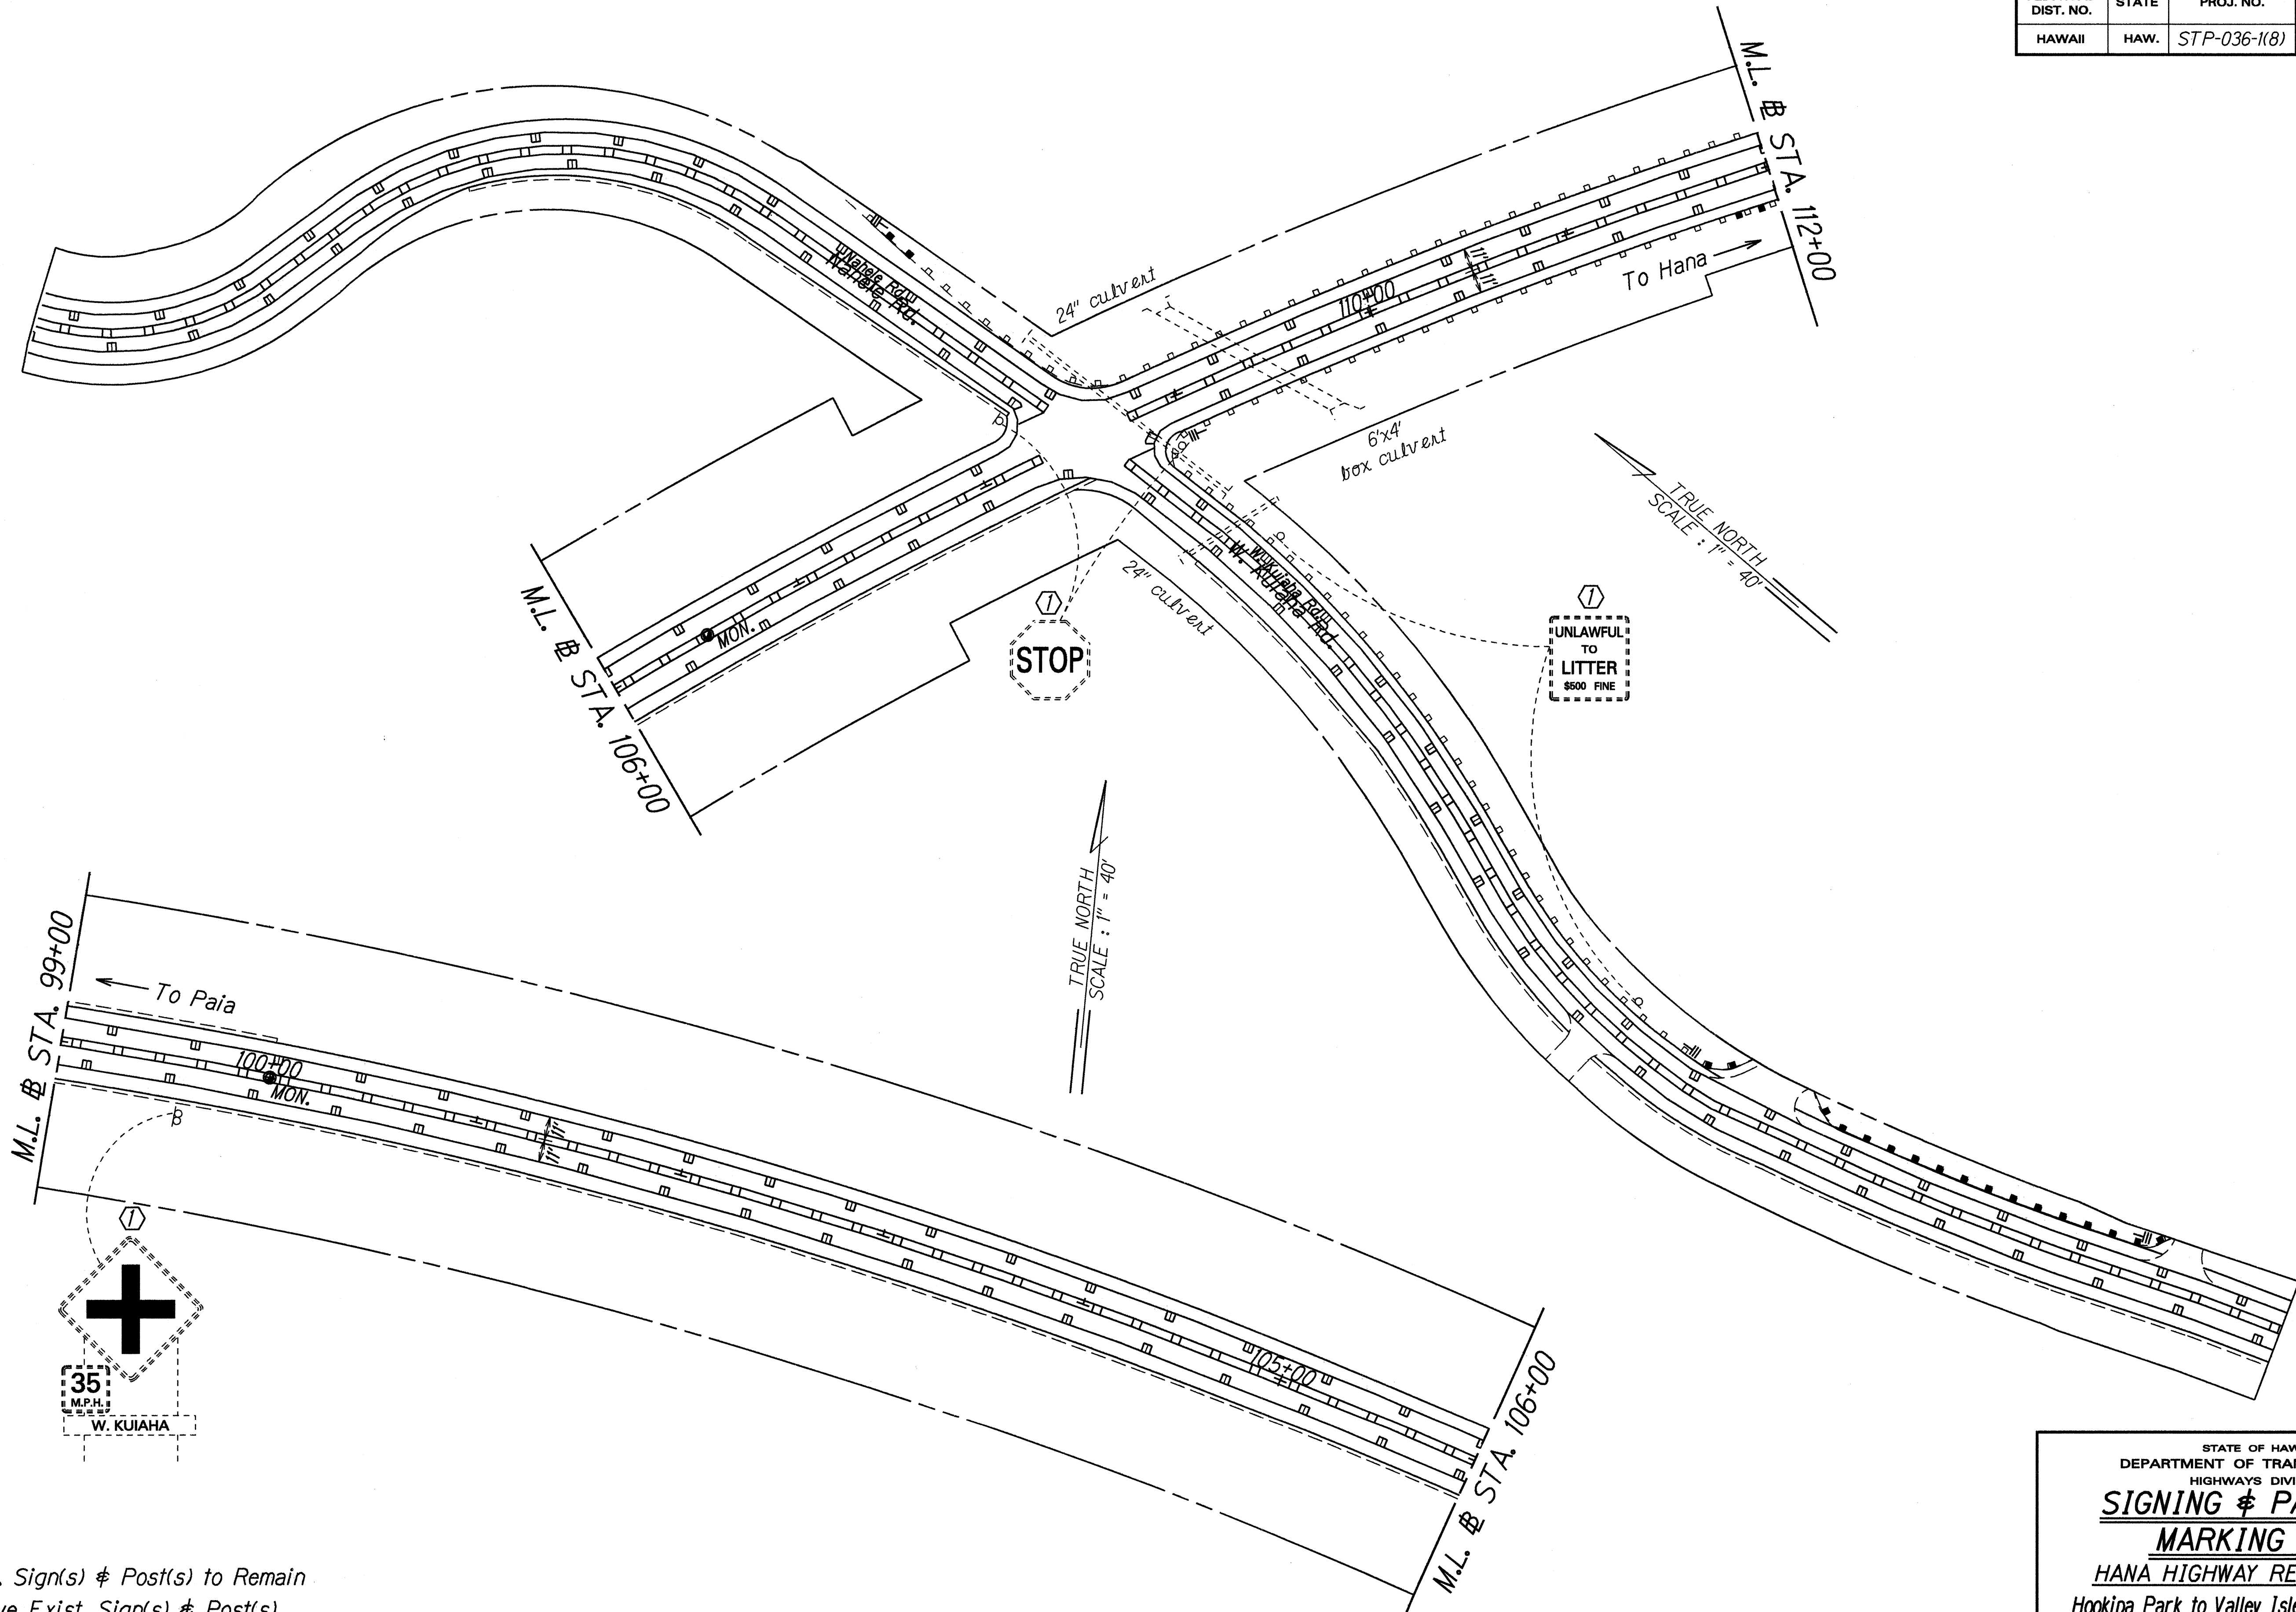

ORIGINAL PLAN	SURVEY PLOTTED BY	DATE
NO. 100-10-10	W. KUIAHA	APRIL 1996
DESIGNED BY	TRACED BY	
QUANTITIES BY	CHECKED BY	

- KEY:**
- ① Exist. Sign(s) & Post(s) to Remain
 - ② Remove Exist. Sign(s) & Post(s)
 - ③ Remove Exist. & Install New Sign(s) & Post(s)
 - ④ Install New Sign(s) & Post(s)

STATE OF HAWAII
DEPARTMENT OF TRANSPORTATION
HIGHWAYS DIVISION



**SIGNING & PAVEMENT
MARKING PLAN**

HANA HIGHWAY RESURFACING
Hookipa Park to Valley Isle Memorial Cemetery
Fed. Aid Project No. STP-036-1(8)

Scale: 1" = 40' Date: July, 1996

SHEET No. 10 OF 11 SHEETS

FED. ROAD DIST. NO.	STATE	FED. AID PROJ. NO.	FISCAL YEAR	SHEET NO.	TOTAL SHEETS
HAWAII	HAW.	STP-036-1(8)	1997	28	30

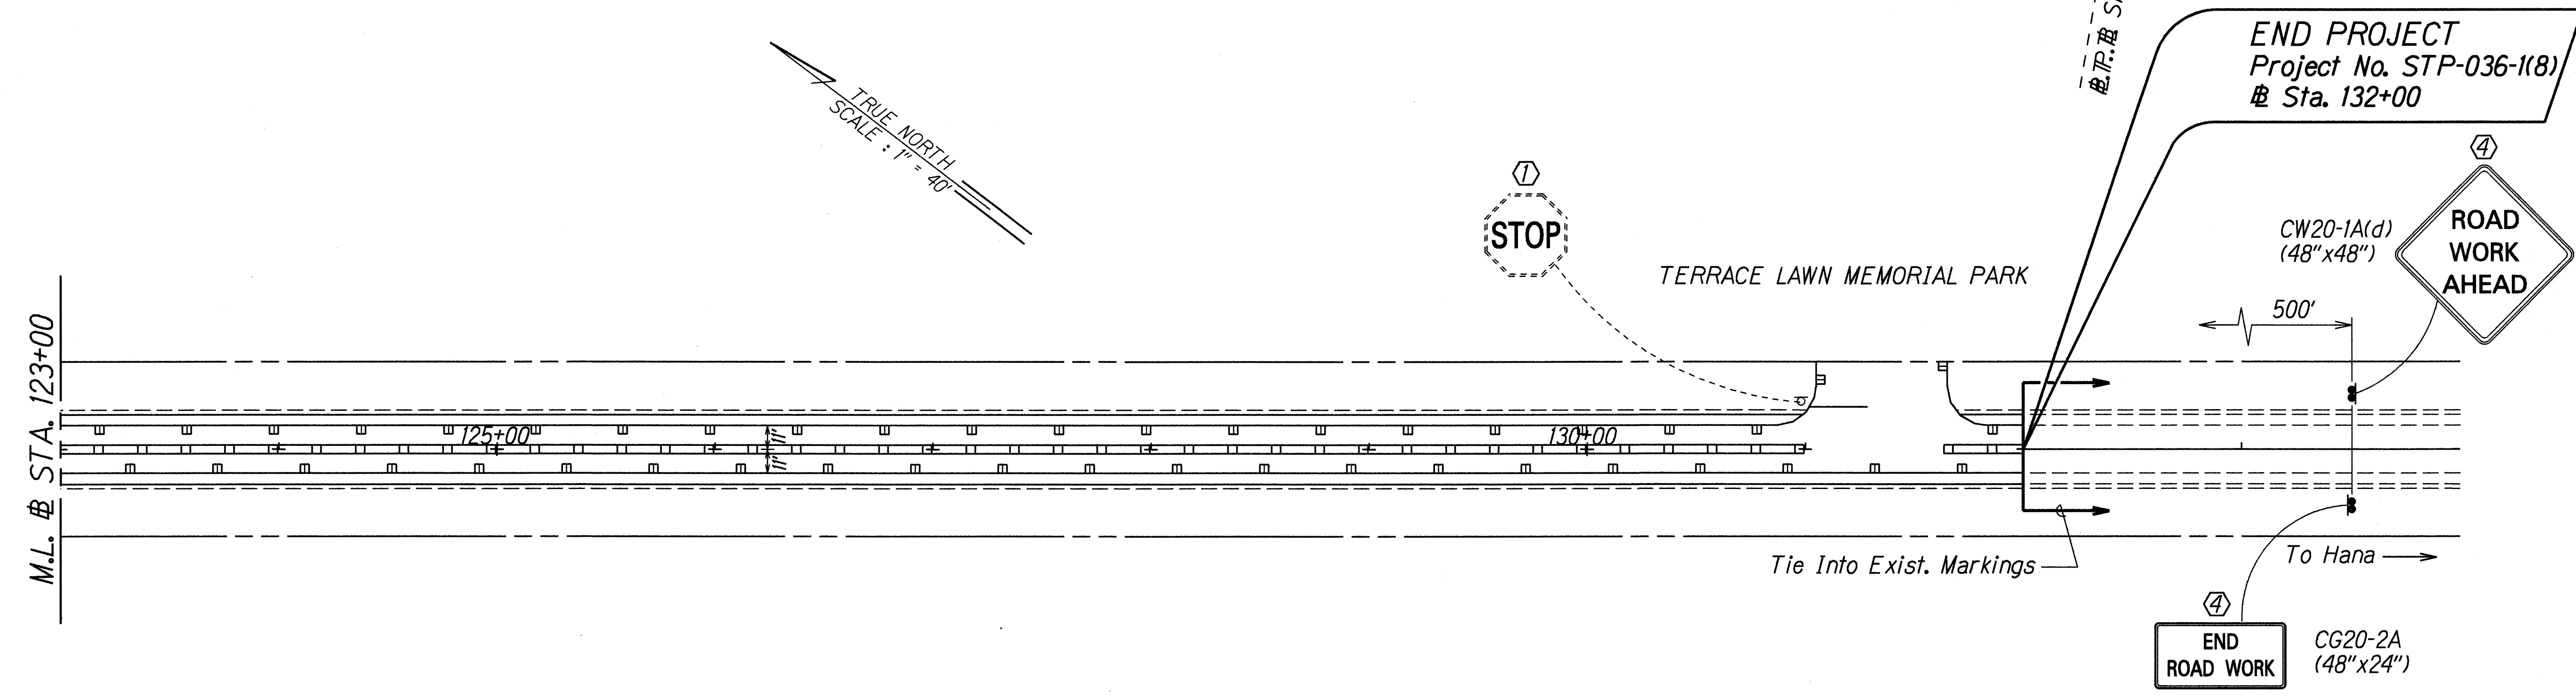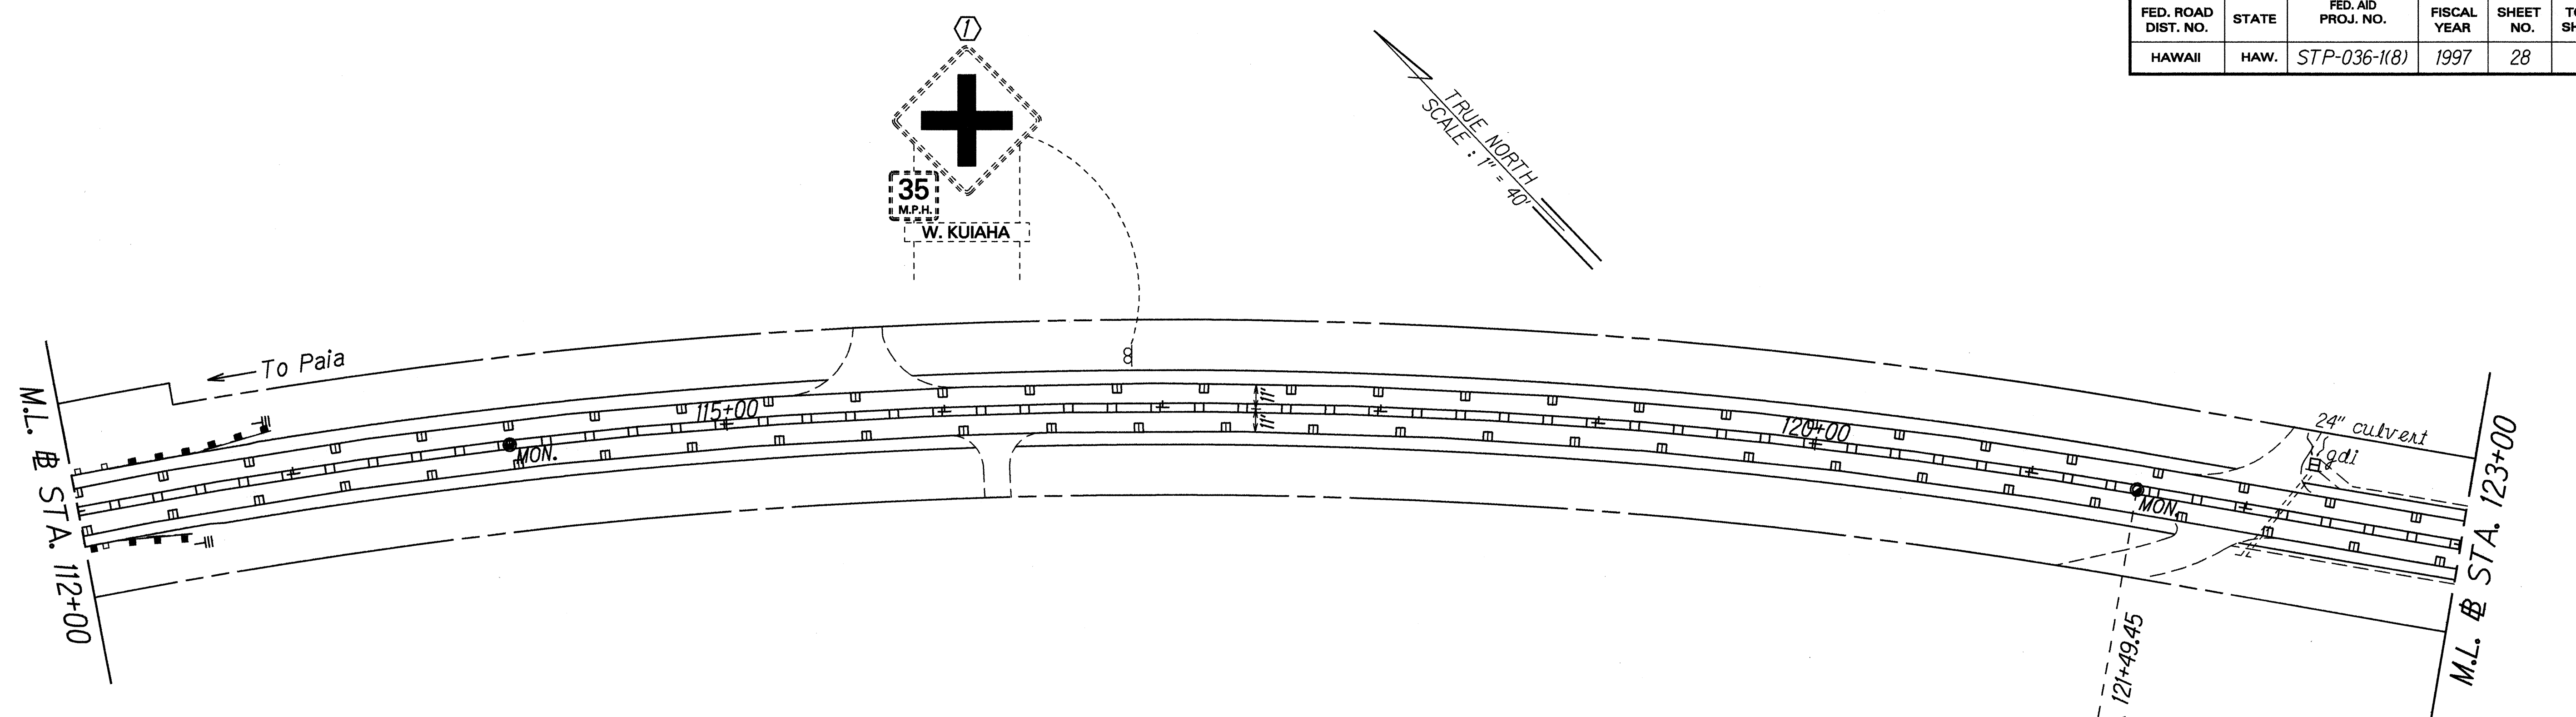

END PROJECT
Project No. STP-036-1(8)
Sta. 132+00

CW20-1A(d)
(48" x 48")

END ROAD WORK CG20-2A
(48" x 24")

DESIGNED BY	DATE
DRAWN BY	APRIL 1996
CHECKED BY	
IN CHARGE	
APPROVED BY	

- KEY:**
- ① Exist. Sign(s) & Post(s) to Remain
 - ② Remove Exist. Sign(s) & Post(s)
 - ③ Remove Exist. & Install New Sign(s) & Post(s)
 - ④ Install New Sign(s) & Post(s)

STATE OF HAWAII
DEPARTMENT OF TRANSPORTATION
HIGHWAYS DIVISION
SIGNING & PAVEMENT MARKING PLAN
HANA HIGHWAY RESURFACING
Hookipa Park to Valley Isle Memorial Cemetery
Fed. Aid Project No. STP-036-1(8)
Scale: 1" = 40' Date: July, 1996