



FED. ROAD DIST. NO.	STATE	FED. AID PROJ. NO.	FISCAL YEAR	SHEET NO.	TOTAL SHEETS
HAWAII	HAW.	STP-036-1(8)	1997	4	30

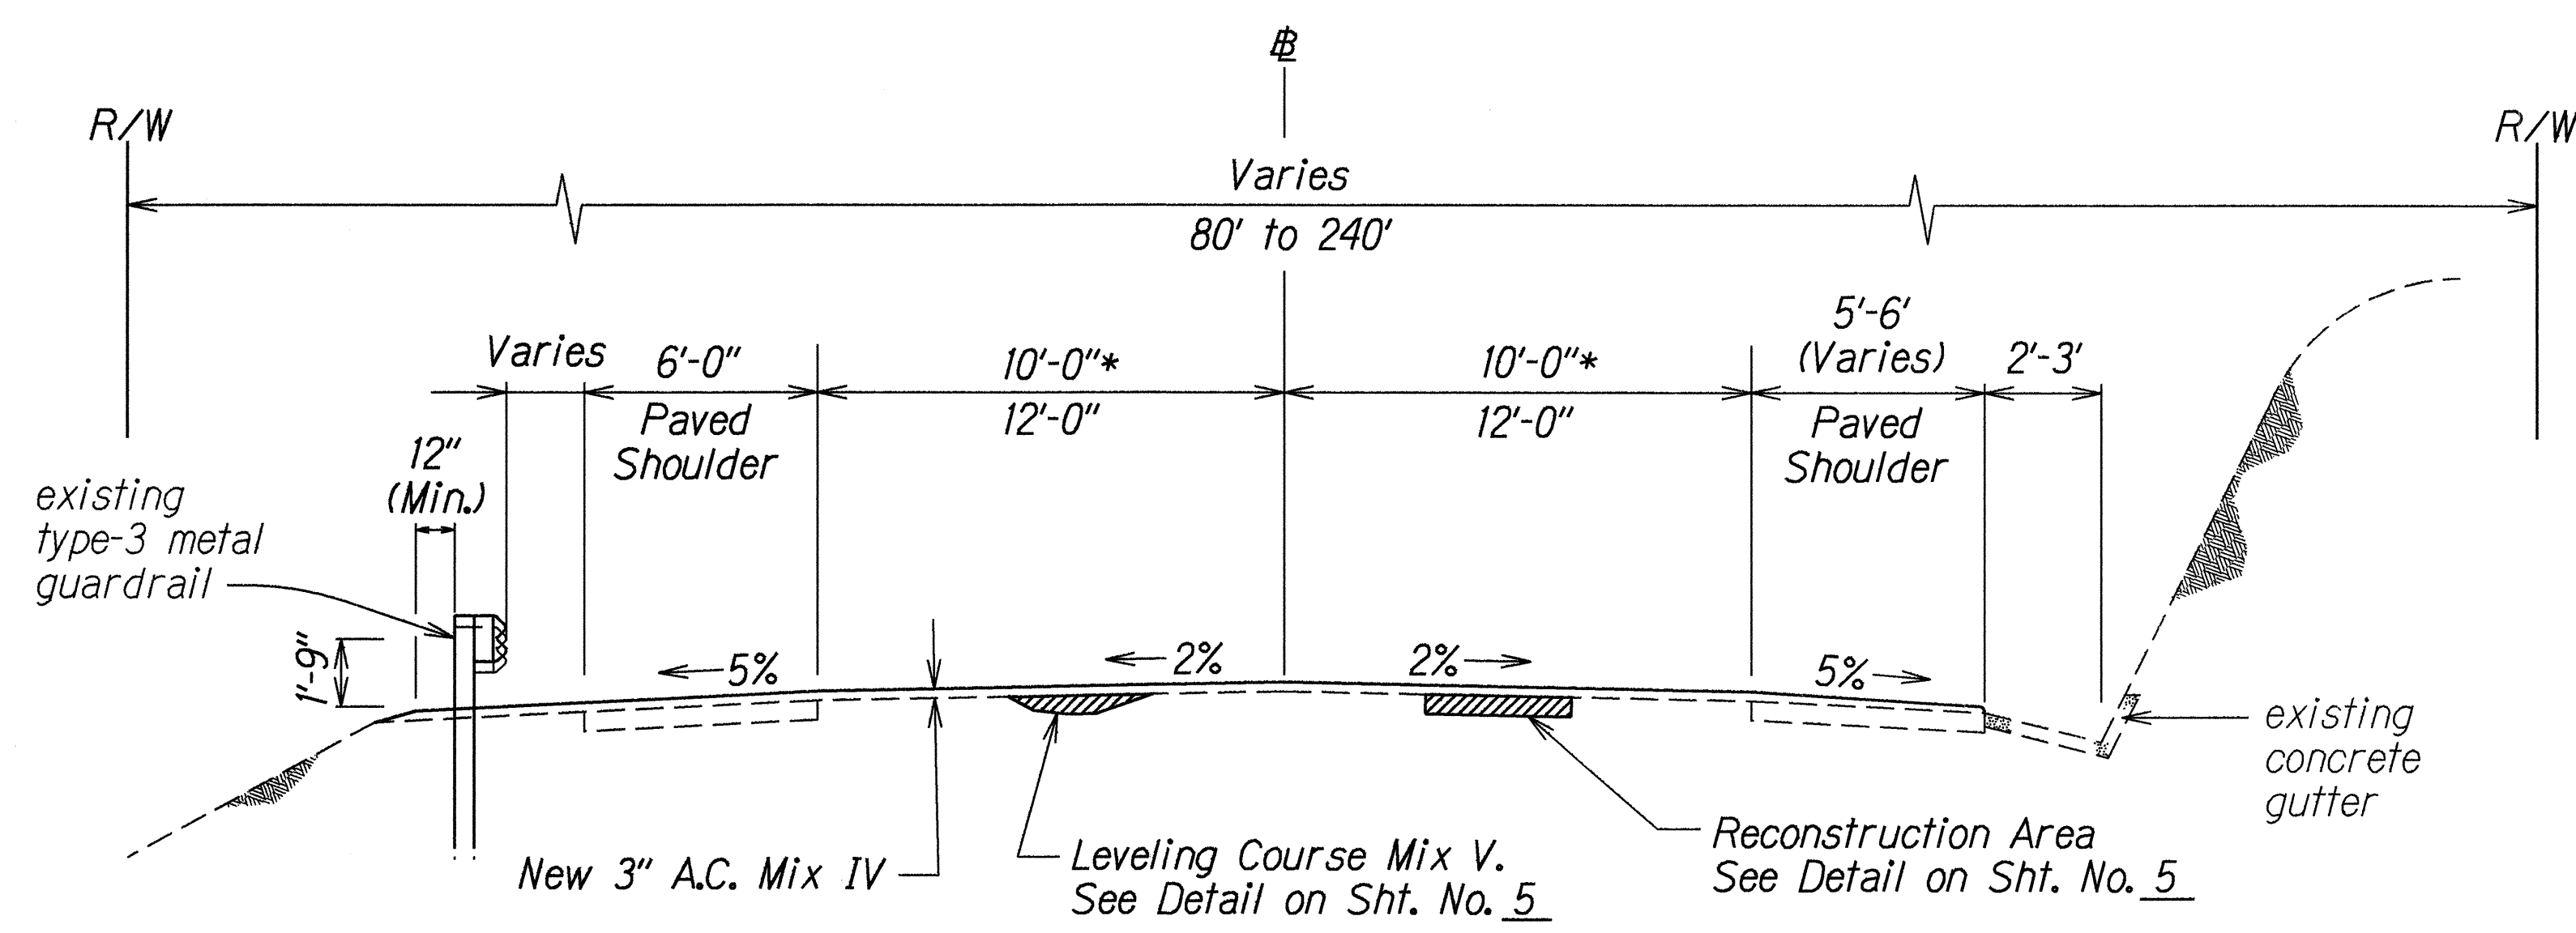


TYPICAL SECTION ON TANGENT
 *# STA. 7+43.23 to # STA. 132+00
 Scale: 1/4" = 1'-0"

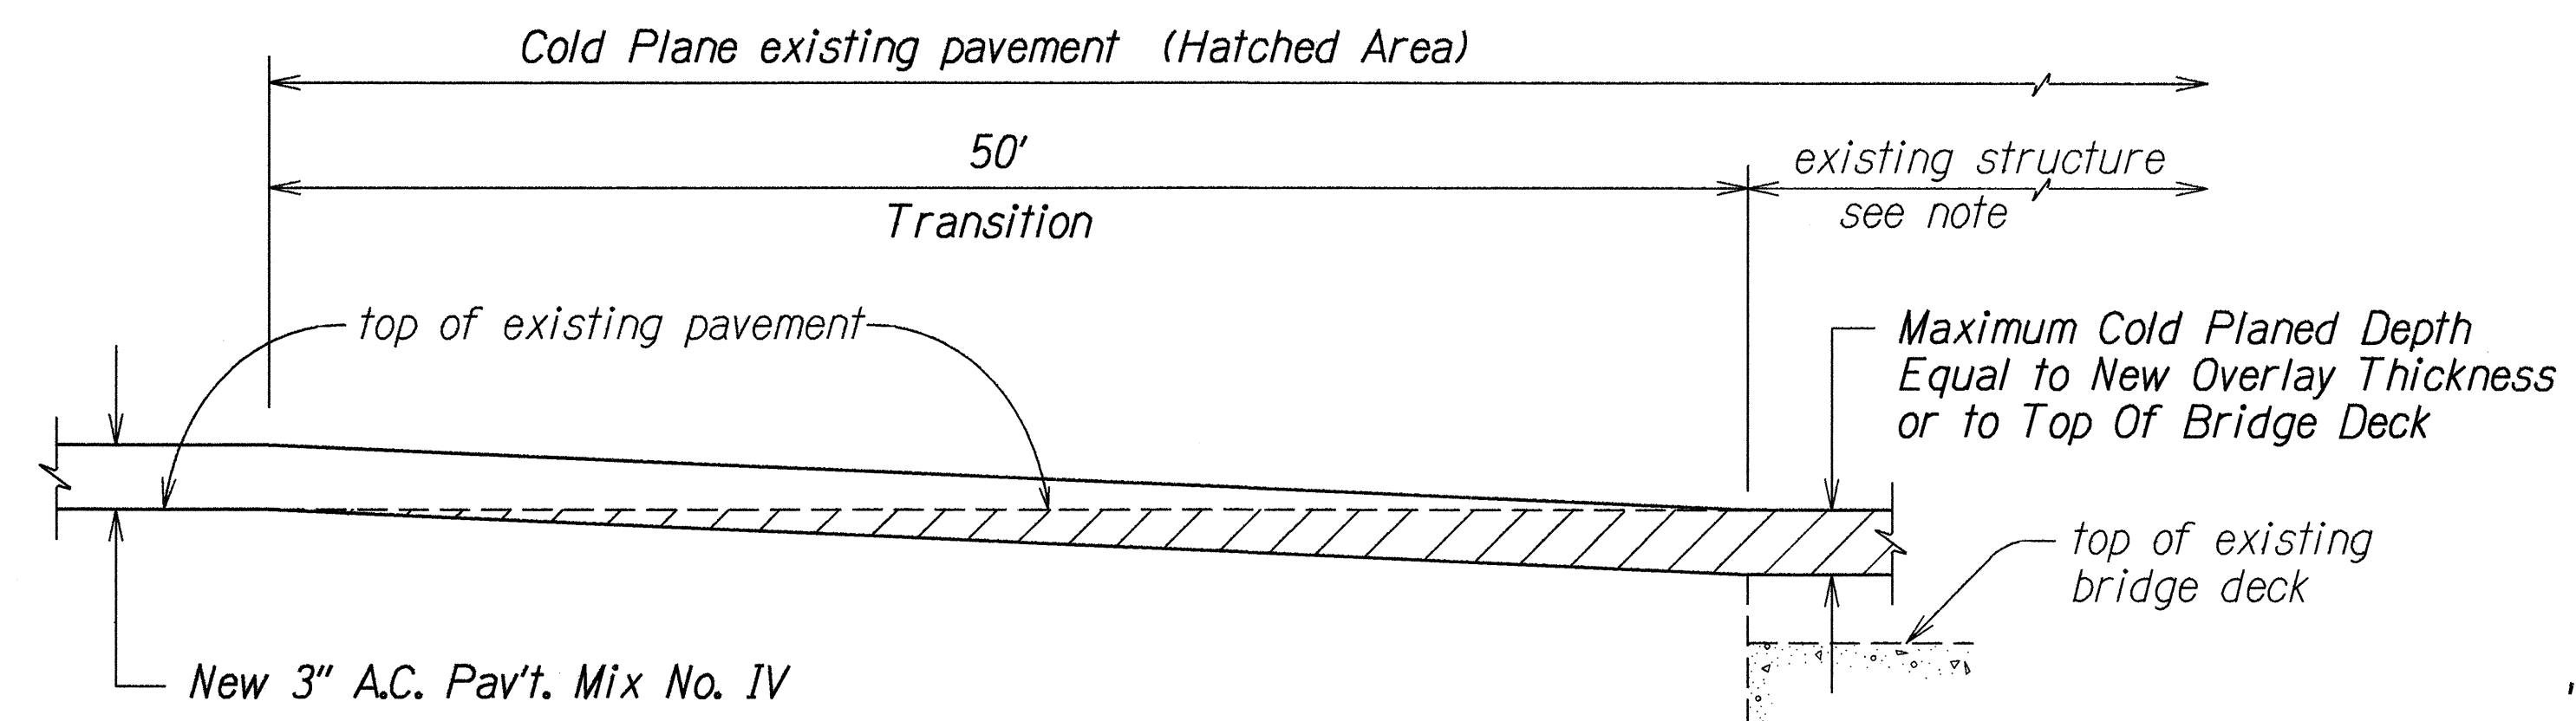


Note: In cold planing the pavement over the structure, the Contractor shall exercise care not to damage any portion of the structure, especially the slab, joints, drainage pipes or reinforcement. Any damage to the structure during the cold planing operations shall be repaired by the Contractor at his expense. Repair work shall be directed by the Engineer. The Contractor shall verify the thickness of the pavement by taking several measurements throughout the structure.


COLD PLANED TRANSITION AND RESURFACING
 OVER EXISTING STRUCTURE
 Not to Scale

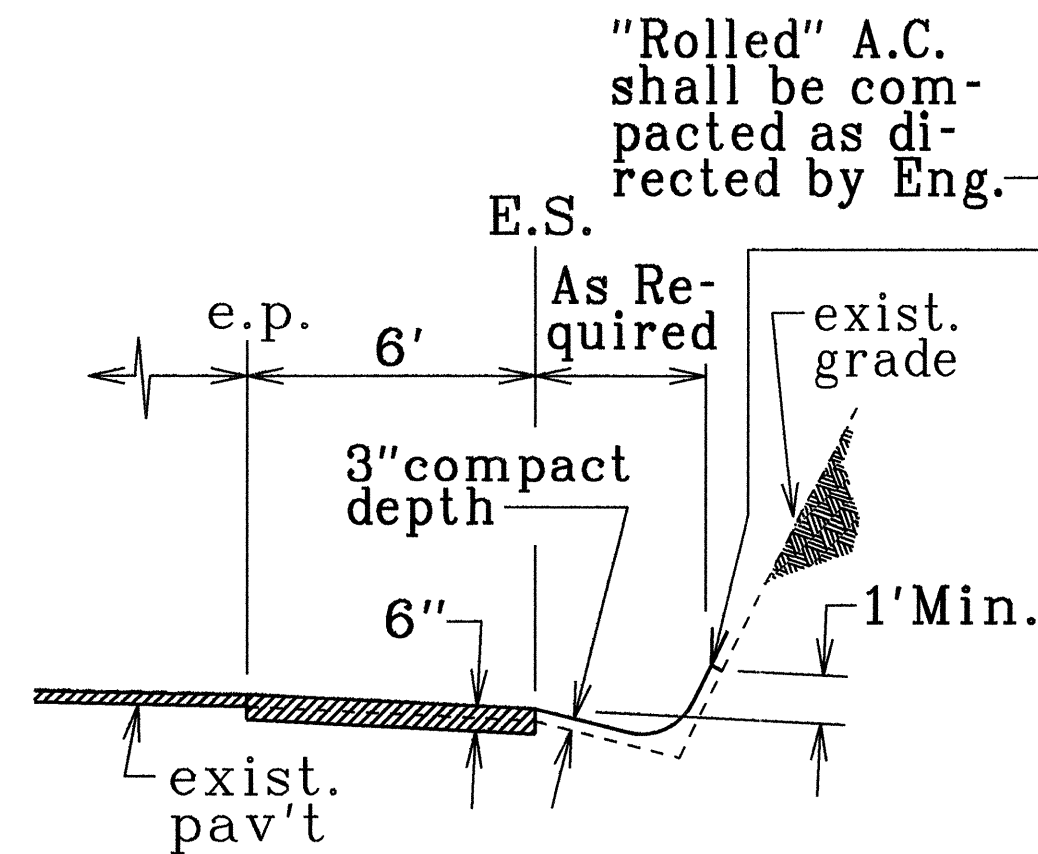

SHOULDER EROSION PROTECTION
 (See Plans for Locations)
 Not to Scale

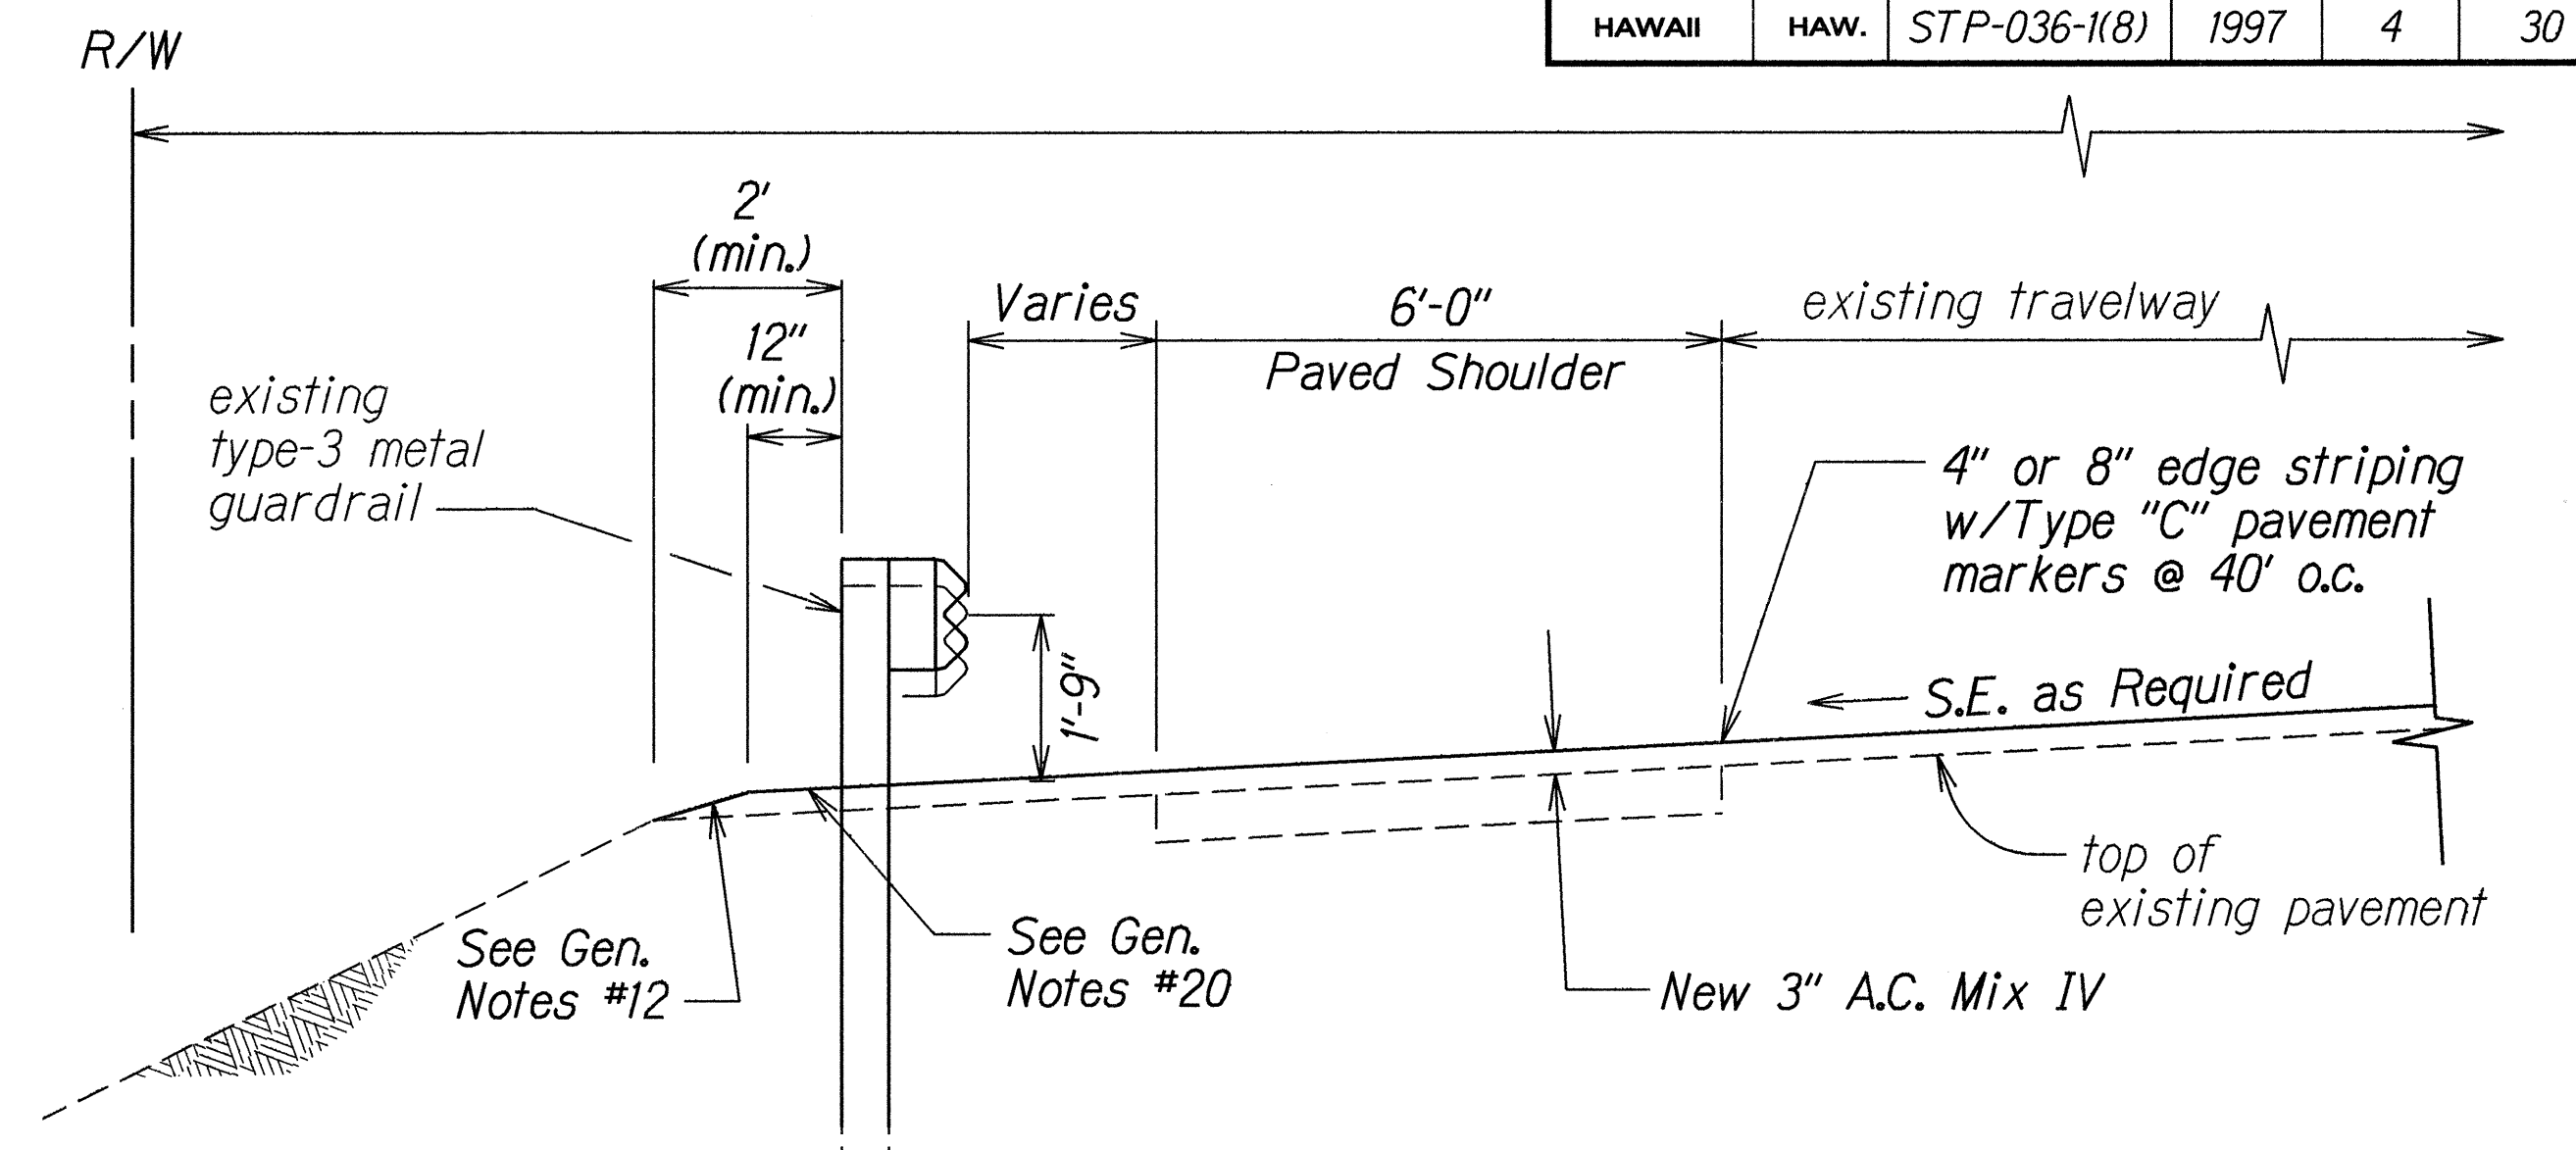


TYPICAL HALF SECTION ON CURVES
 Scale: 1/2" = 1'-0"

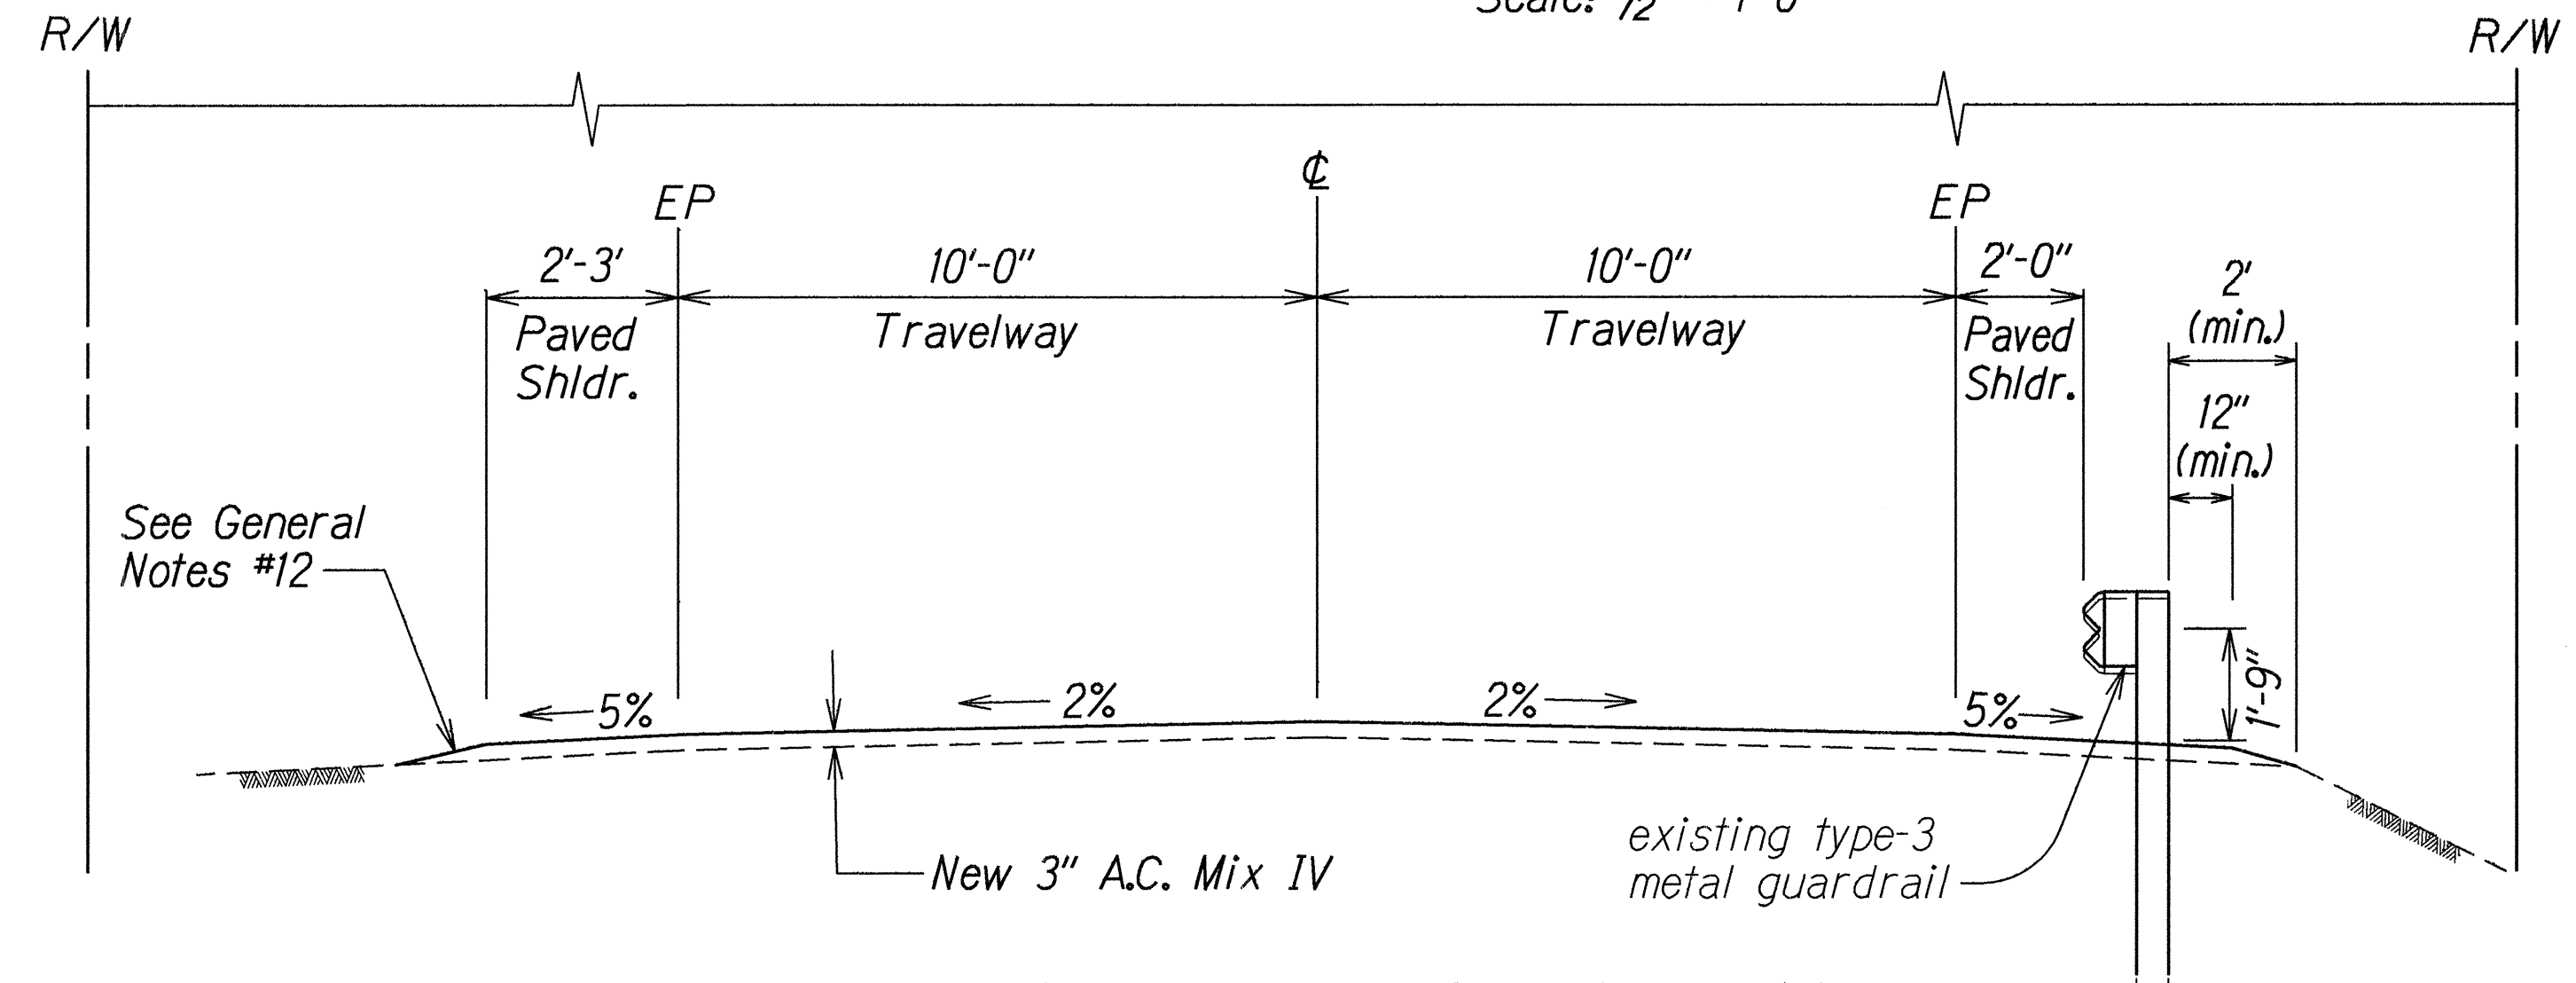

TYPICAL SECTION ON SIDE ROADS
 @ KAHIAPO PL., WAIKANA LP., NAHELE RD., & W. KUIAHA RD.
 Scale: 3/8" = 1'-0"

LEGEND FOR AS-BUILT POSTINGS

	Squiggly line for as-built deletion
	Double line for as-built deletion
Roadway	Text for as-built posting

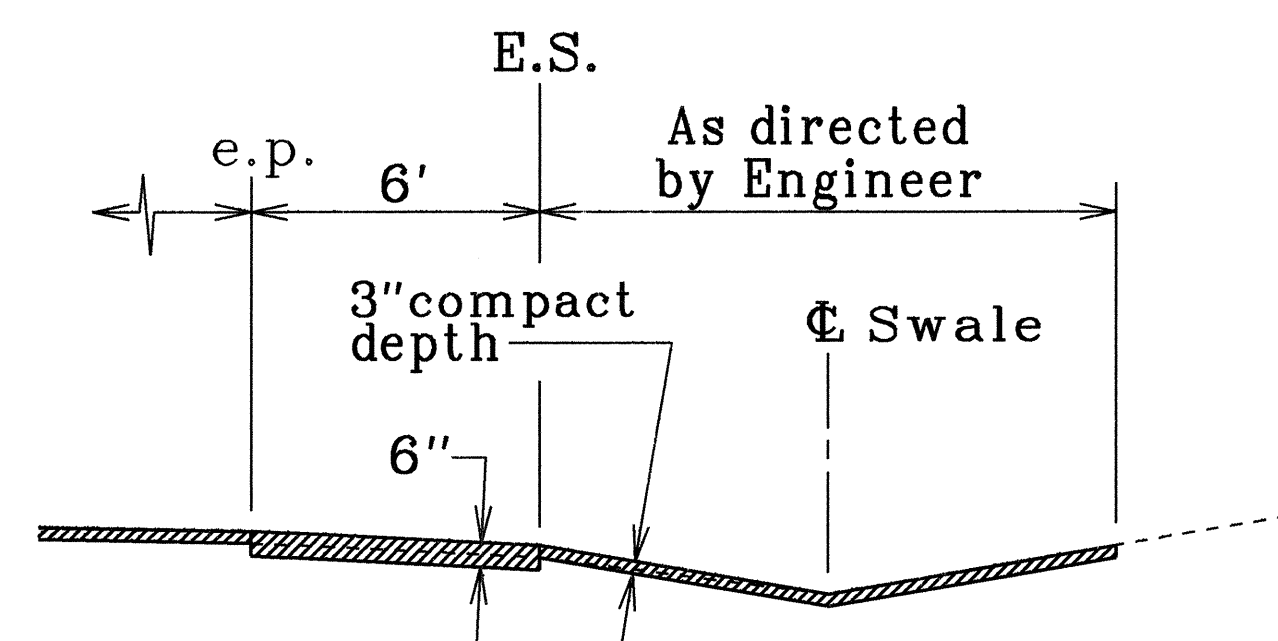

SHOULDER EROSION PROTECTION
 # Sta. 115+25± to 121+70± Rt.
 Not to Scale

DESIGNED BY	DATE
DRAWN BY	July 1996
CHECKED BY	AB2-1-96
NOTED BY	
QUANTITIES BY	
TRANSMISSION	

STATE OF HAWAII
 DEPARTMENT OF TRANSPORTATION
 HIGHWAYS DIVISION


TYPICAL SECTIONS & DETAILS

HANA HIGHWAY RESURFACING
 Hookipa Park to Valley Isle Memorial Cemetery
 Fed. Aid Project No. STP-036-1(8)


Scale: As Shown Date: July, 1996

SHEET No. 1 OF 2 SHEETS


FED. ROAD DIST. NO.	STATE	FED. AID PROJ. NO.	FISCAL YEAR	SHEET NO.	TOTAL SHEETS
HAWAII	HAW.	STP-036-1(8)	1997	5	30

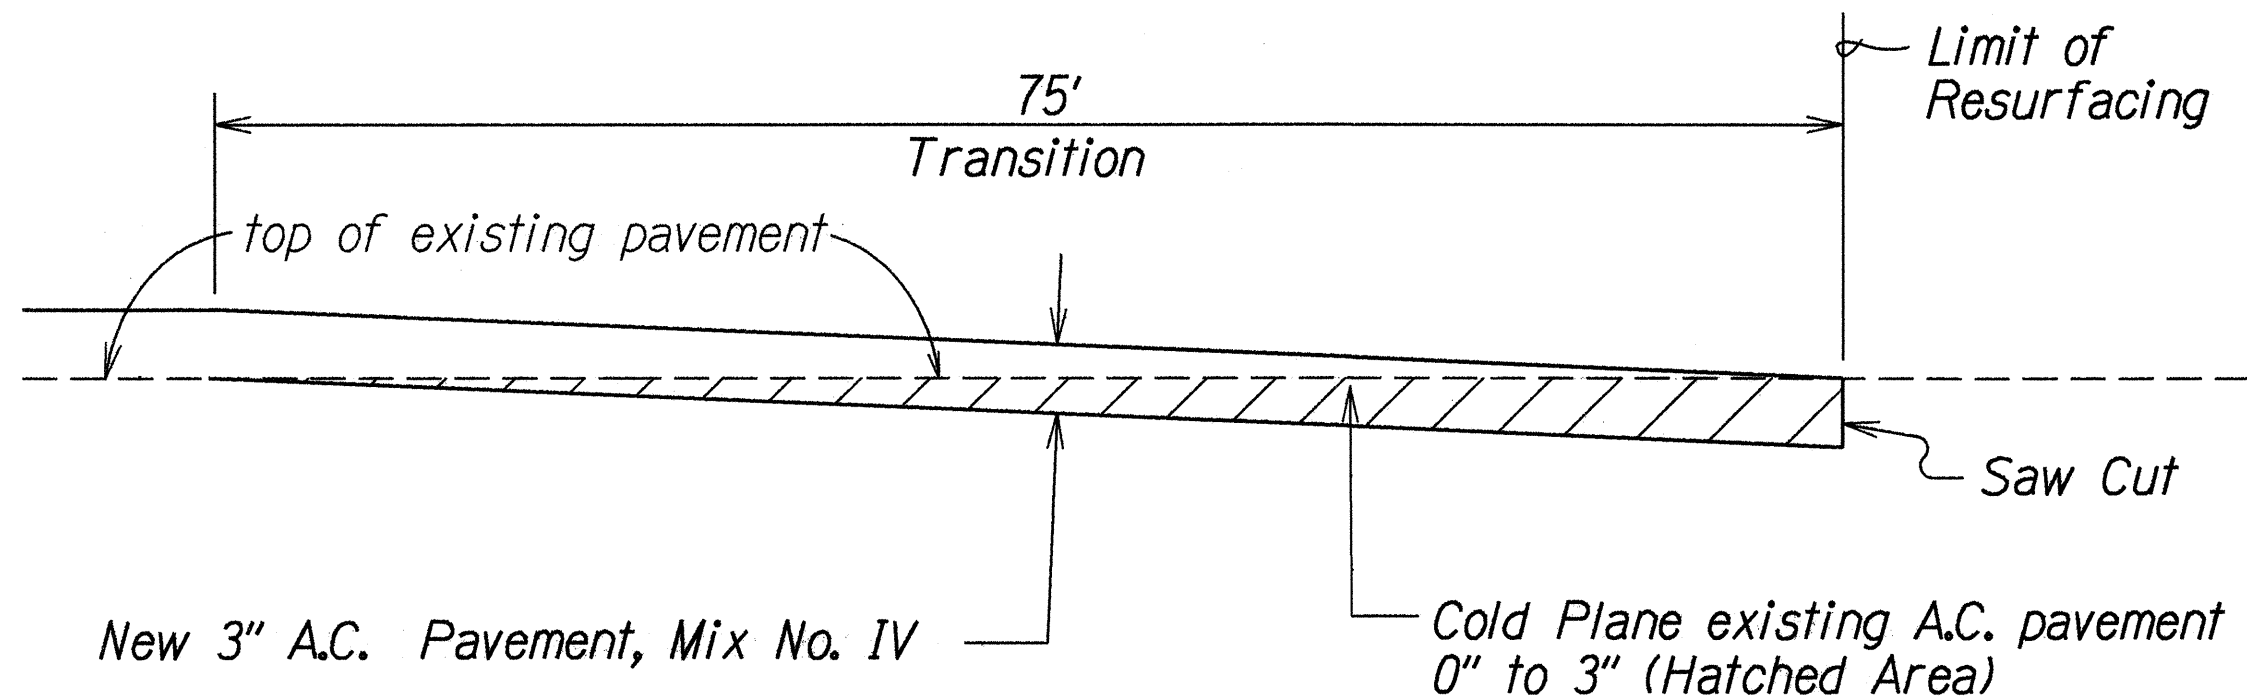


**COLD PLANED TRANSITION
TO EXISTING A.C. PAVEMENT**
Not To Scale

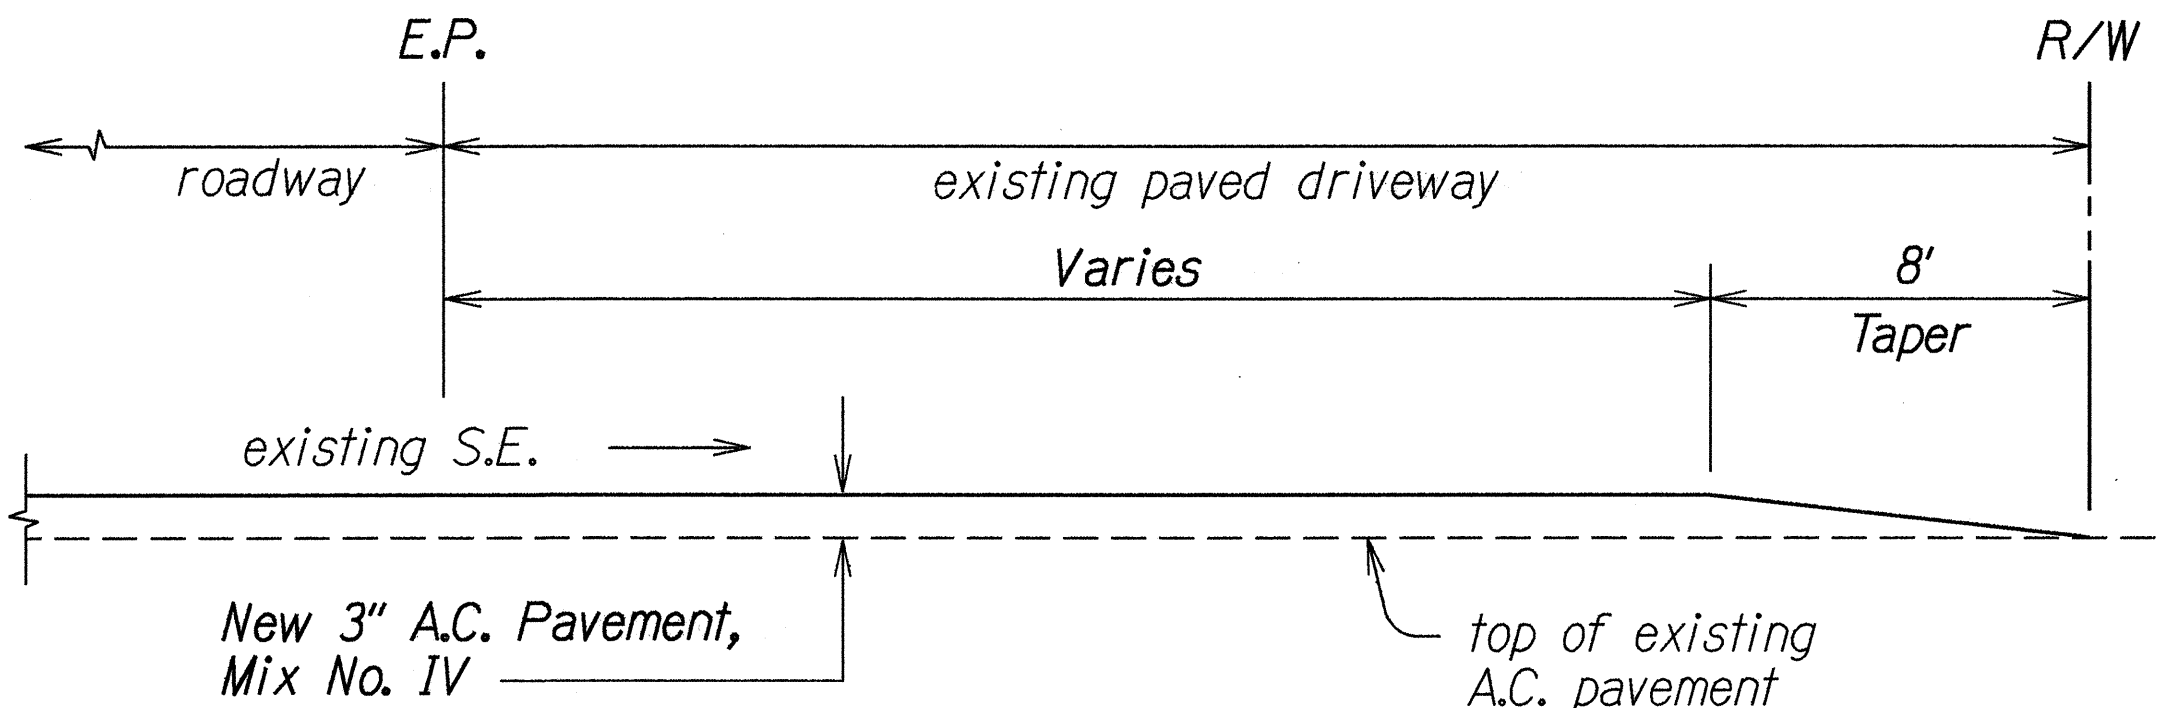


PAVED DRIVEWAY DETAIL
Not To Scale

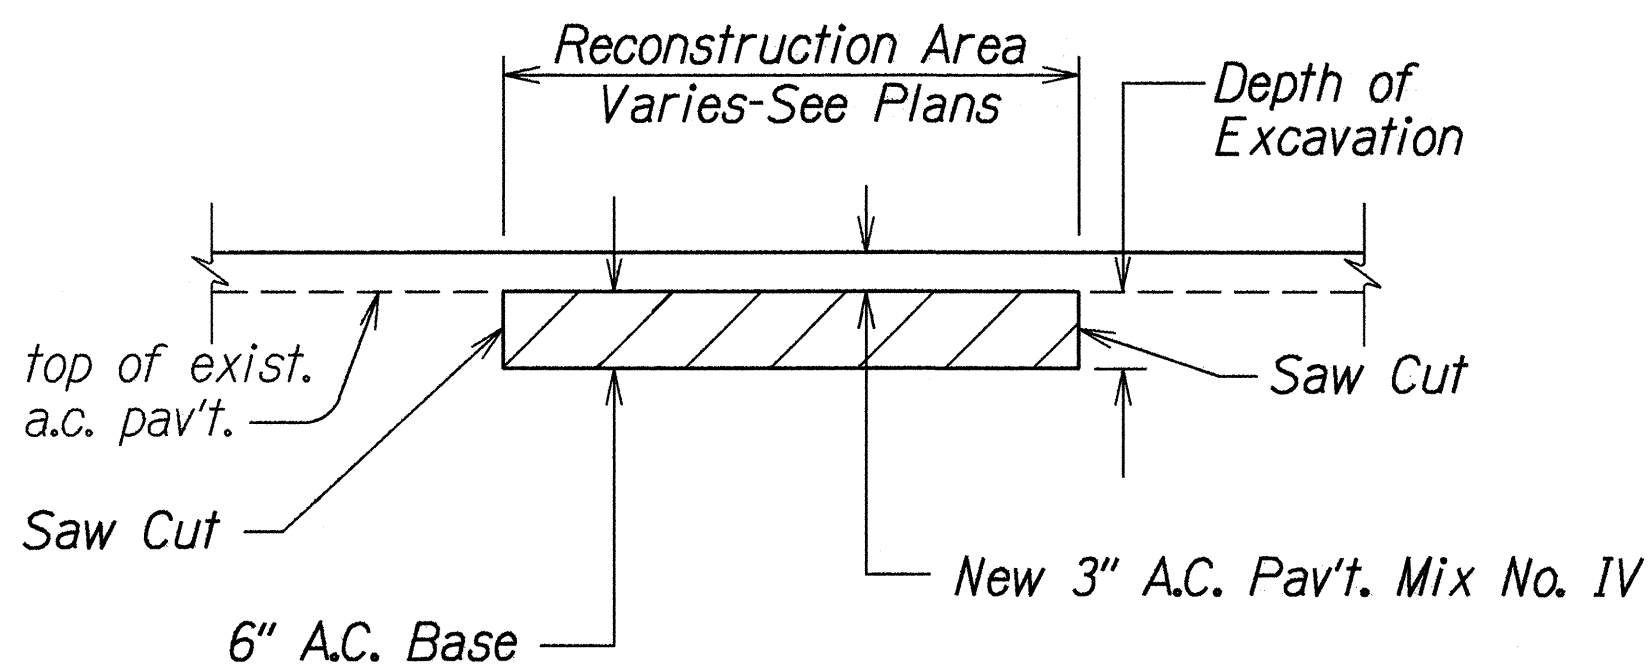


A.C. PAVEMENT RECONSTRUCTION DETAIL
Not To Scale

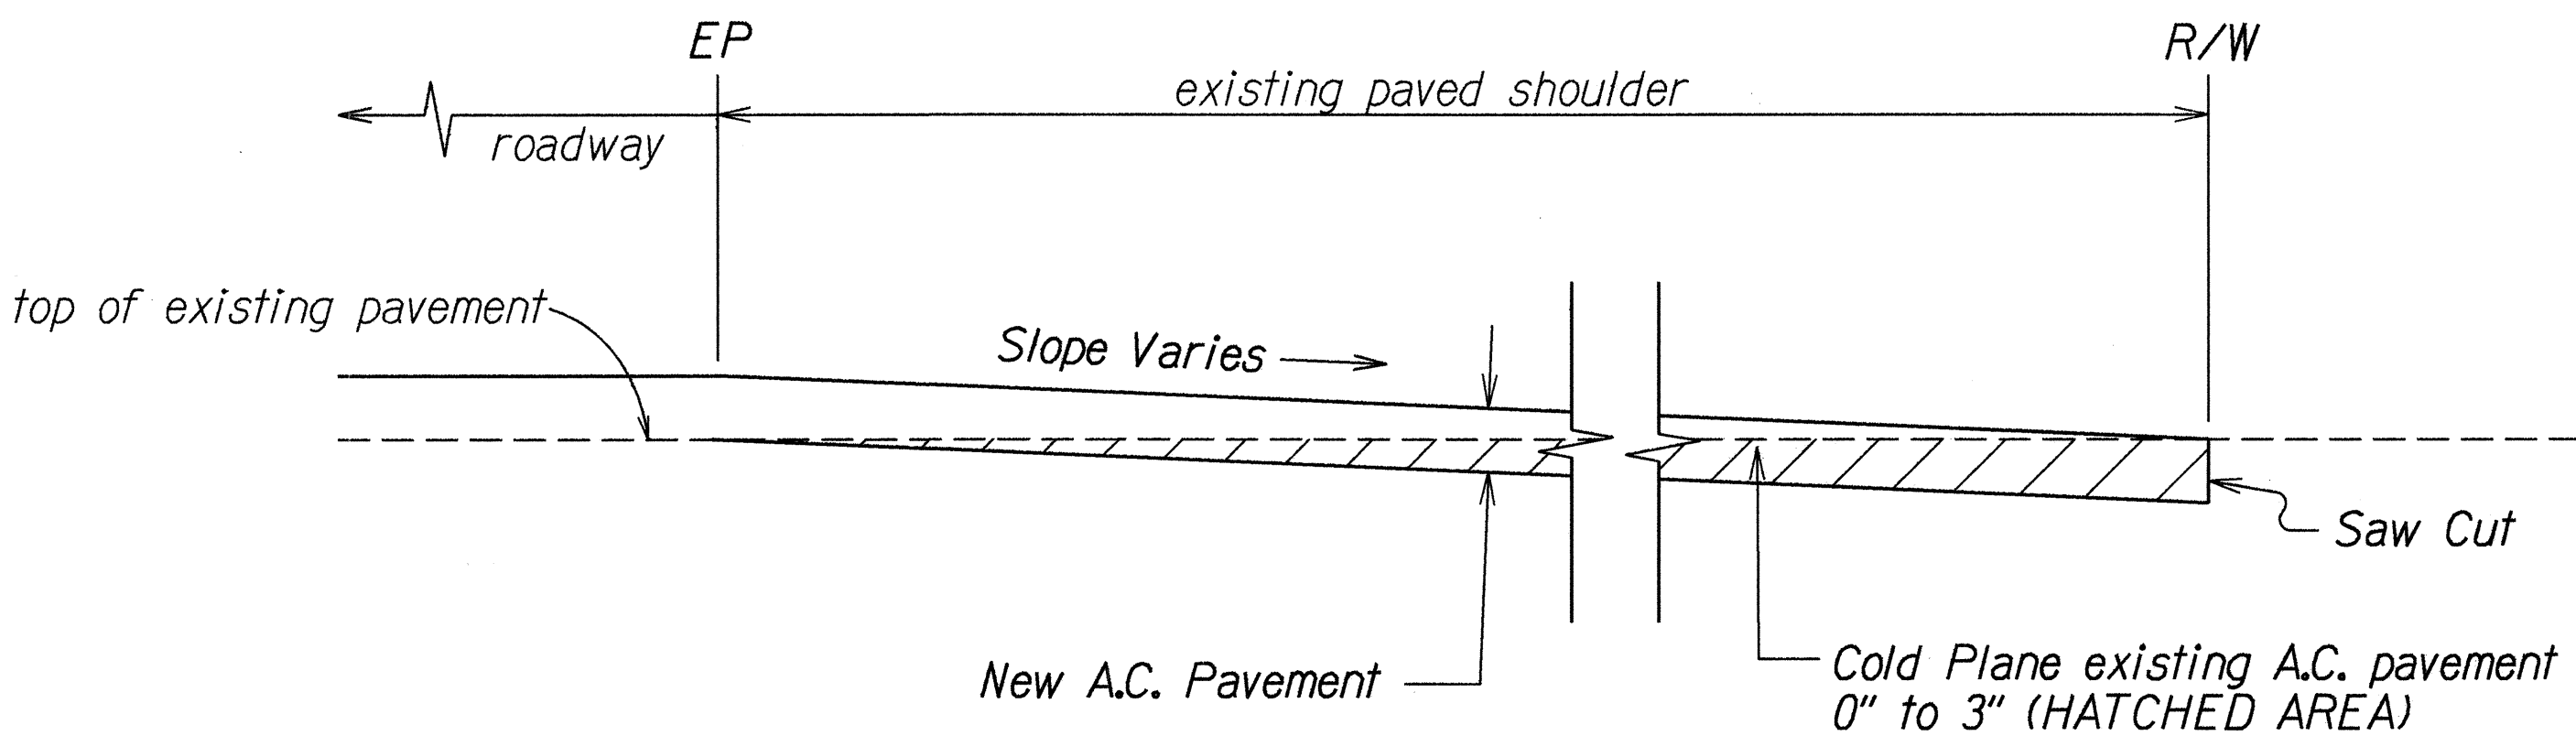

PAVED SIDE ROAD DETAIL
Not To Scale

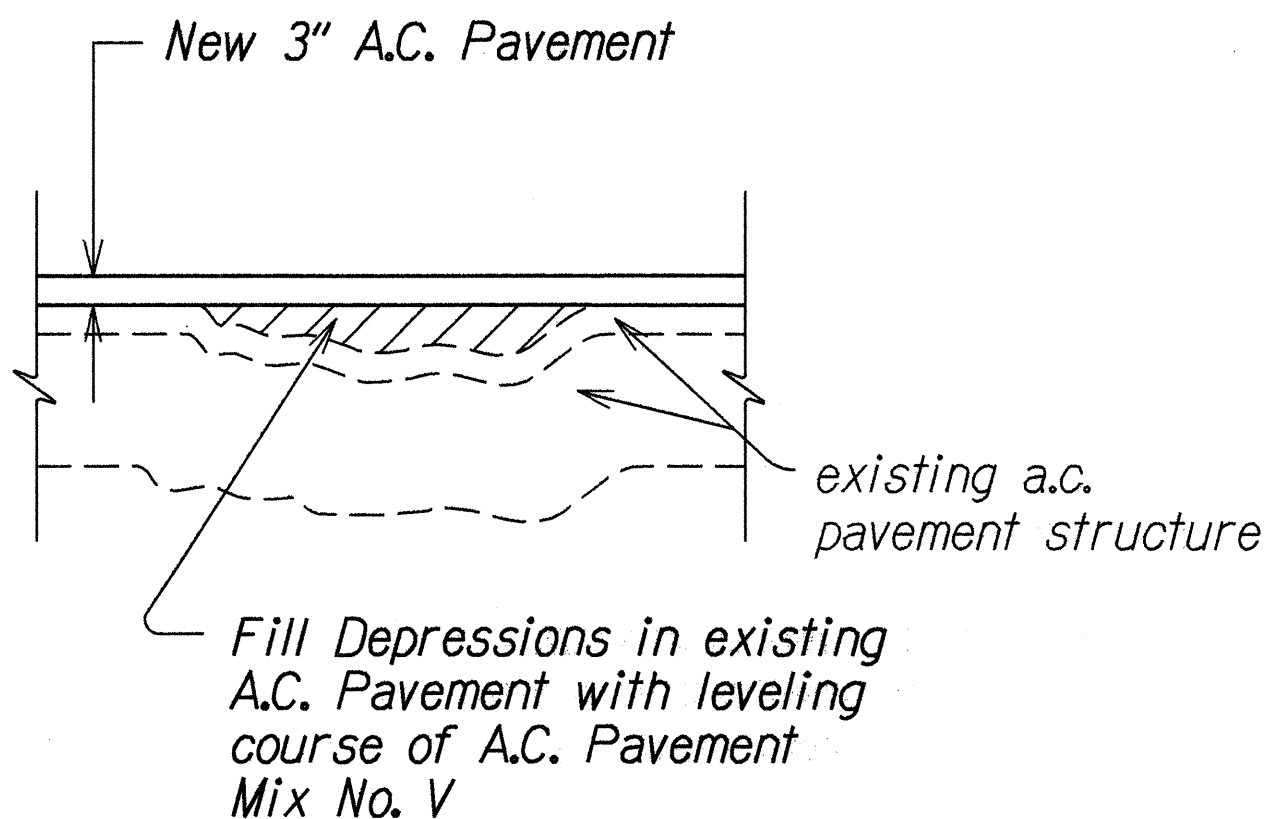

LEVELING COURSE DETAIL
Not To Scale

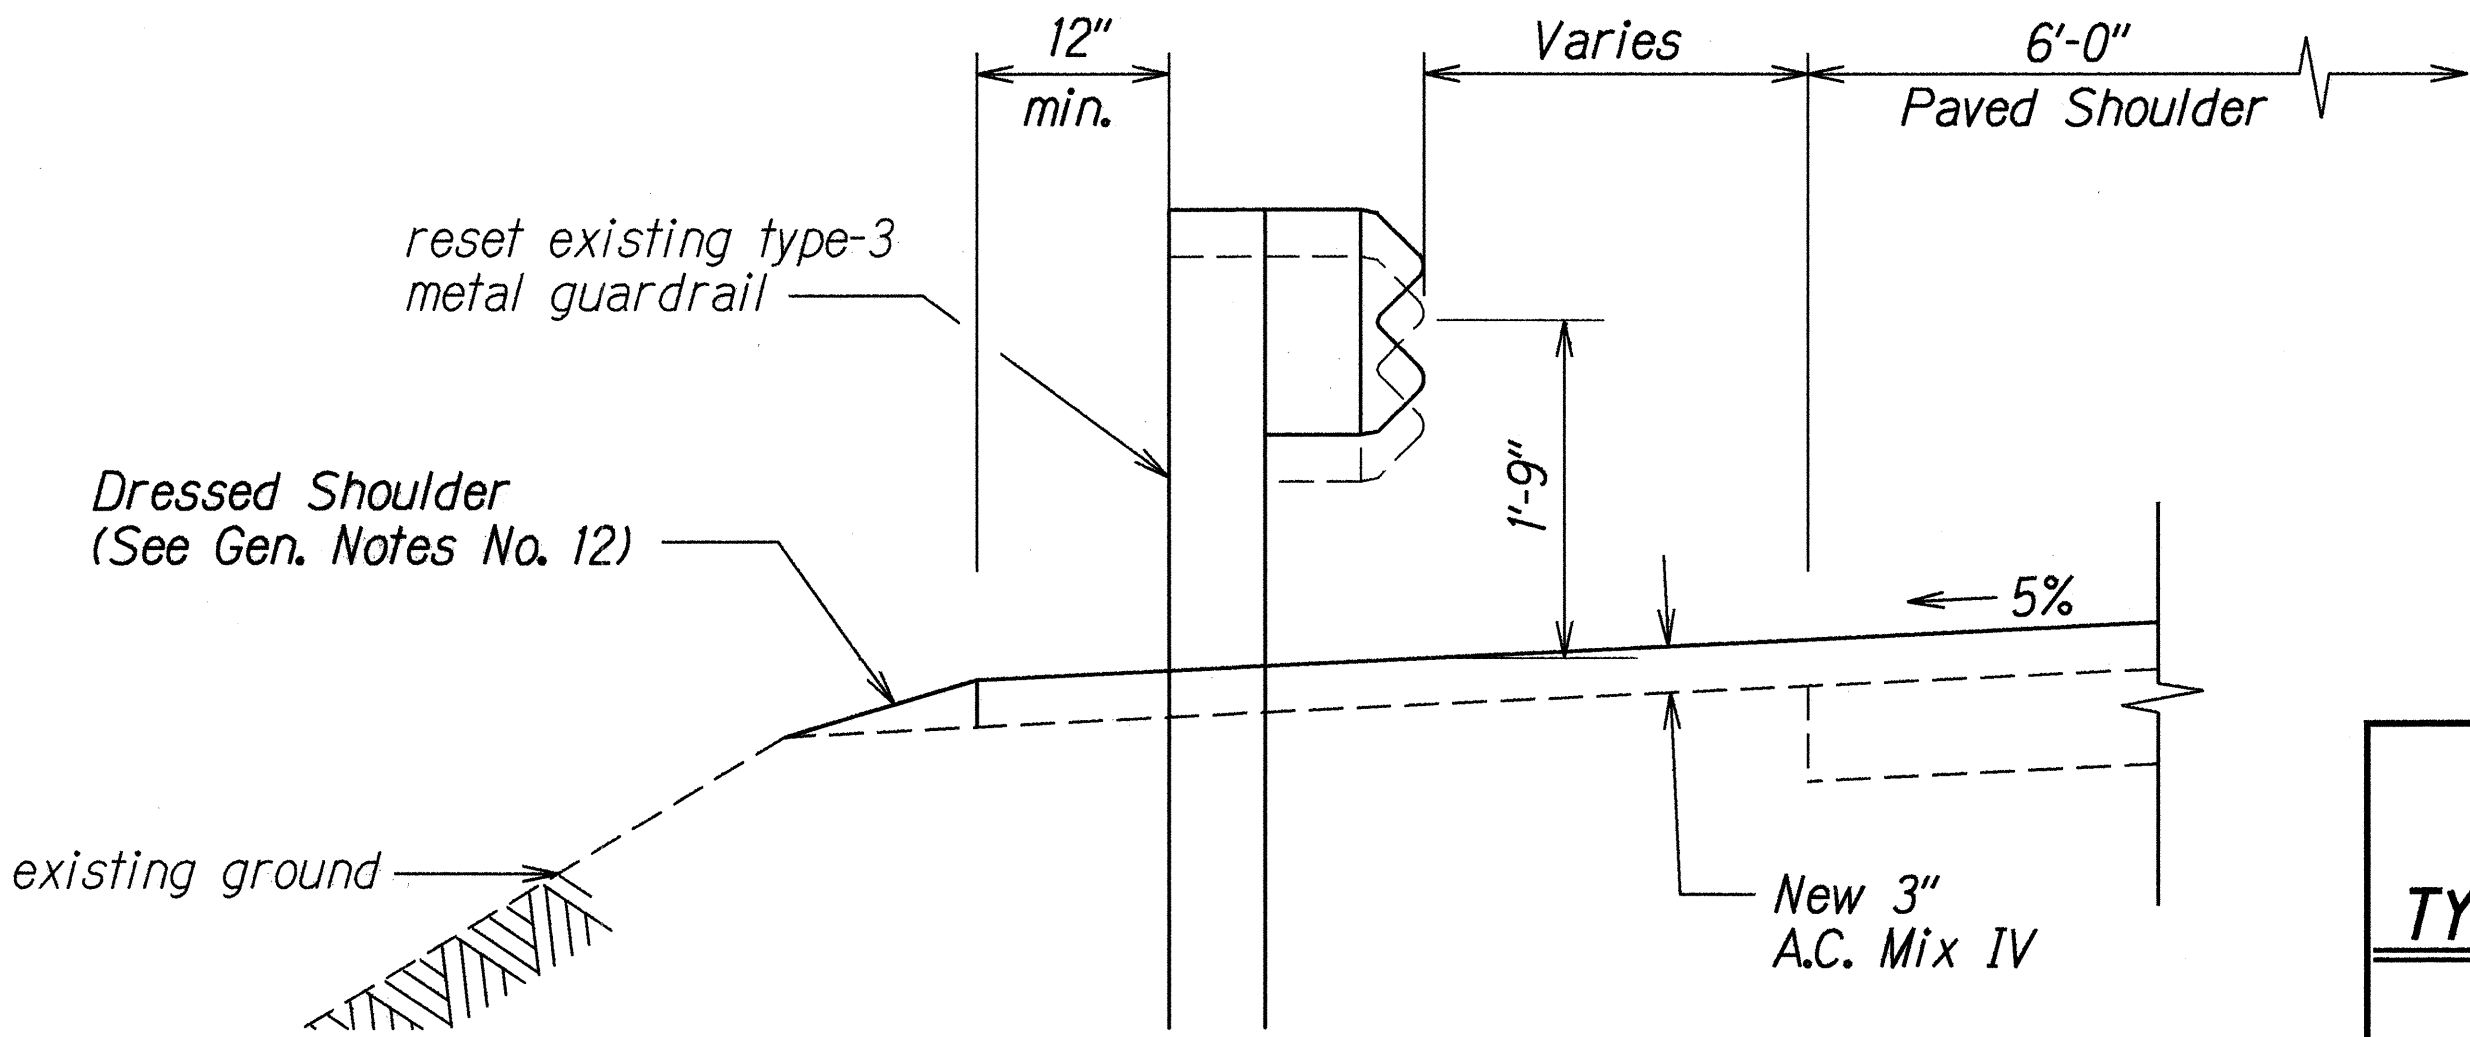

PAVED SHOULDER DETAIL
Scale: 1" = 1'-0"

DESIGNED BY	DATE
DRAWN BY	
CHECKED BY	
IN CHARGE	
NOTED BY	
QUANTITIES BY	
APPROVED BY	

STATE OF HAWAII
DEPARTMENT OF TRANSPORTATION
HIGHWAYS DIVISION

TYPICAL SECTIONS & DETAILS
HANA HIGHWAY RESURFACING
Hookipa Park to Valley Isle Memorial Cemetery
Fed. Aid Project No. STP-036-1(8)
Scale: As Shown Date: July, 1996

SHEET No. 2 OF 2 SHEETS