


FED. ROAD DIST. NO.	STATE	FED. AID PROJ. NO.	FISCAL YEAR	SHEET NO.	TOTAL SHEETS
HAWAII	HI.	STP-036-1 (9)	1997	1	6

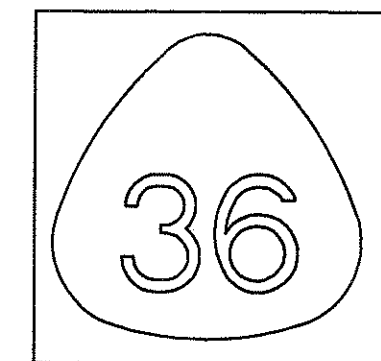

INDEX TO DRAWINGS	
SHT. NO.	DESCRIPTION
1	TITLE SHEET
2	IRRIGATION PLAN
3	IRRIGATION PLAN & DETAIL
4	IRRIGATION PLAN
5	IRRIGATION PLAN & DETAILS
6	IRRIGATION PLAN - LEGEND, NOTES AND DETAILS

COUNTY OF MAUI
DEPARTMENT OF PUBLIC WORKS
AND WASTE MANAGEMENT
WAILUKU, MAUI, HAWAII



"AS-BUILT"

PLANS FOR
HANA HIGHWAY LANDSCAPING
(PULEHU ROAD TO HALEAKALA HIGHWAY)
FEDERAL AID PROJECT NO. STP-036-1 (9)
KAHULUI, MAUI, HAWAII

MILE POST 1.00 TO MILE POST 2.80

DESIGN DESIGNATION

ADT (1997)	39,400
ADT (2007)	49,900
DHV	4,060
D	60/40
T24	5%
V	60 MPH

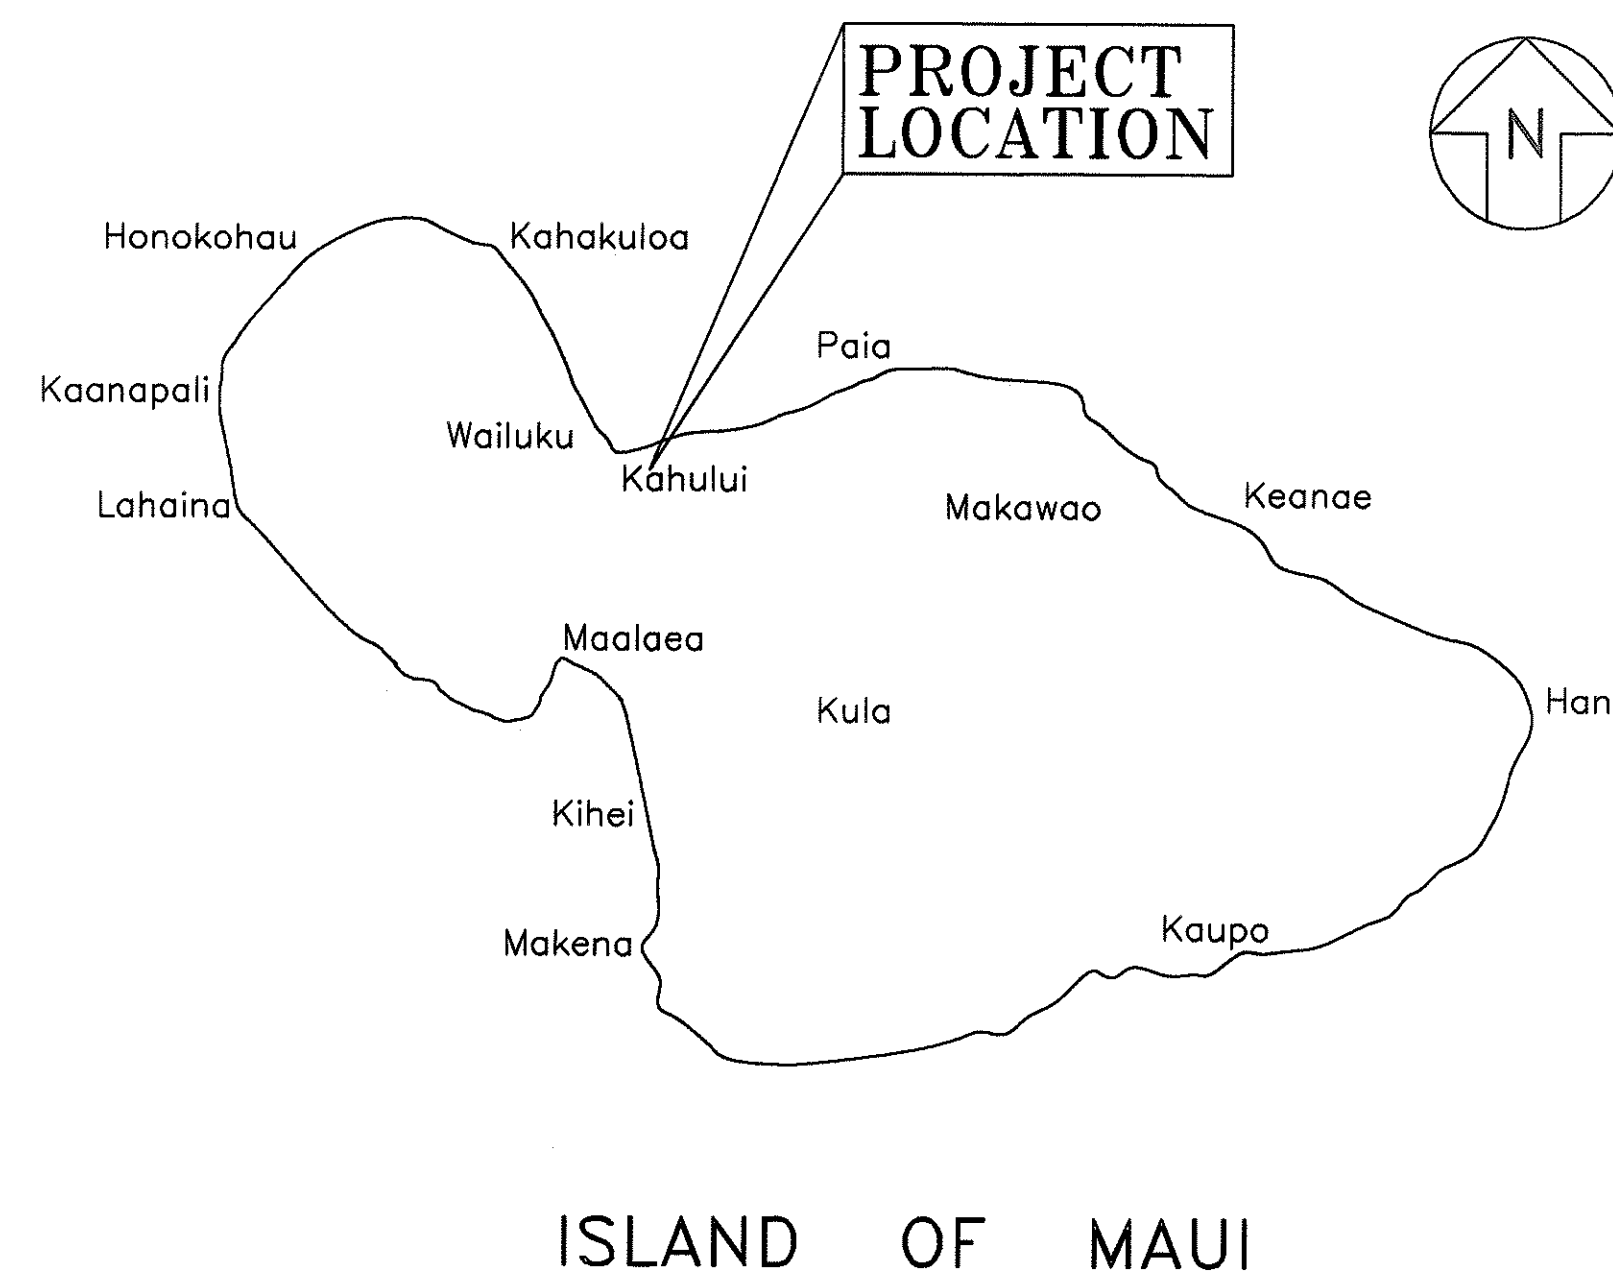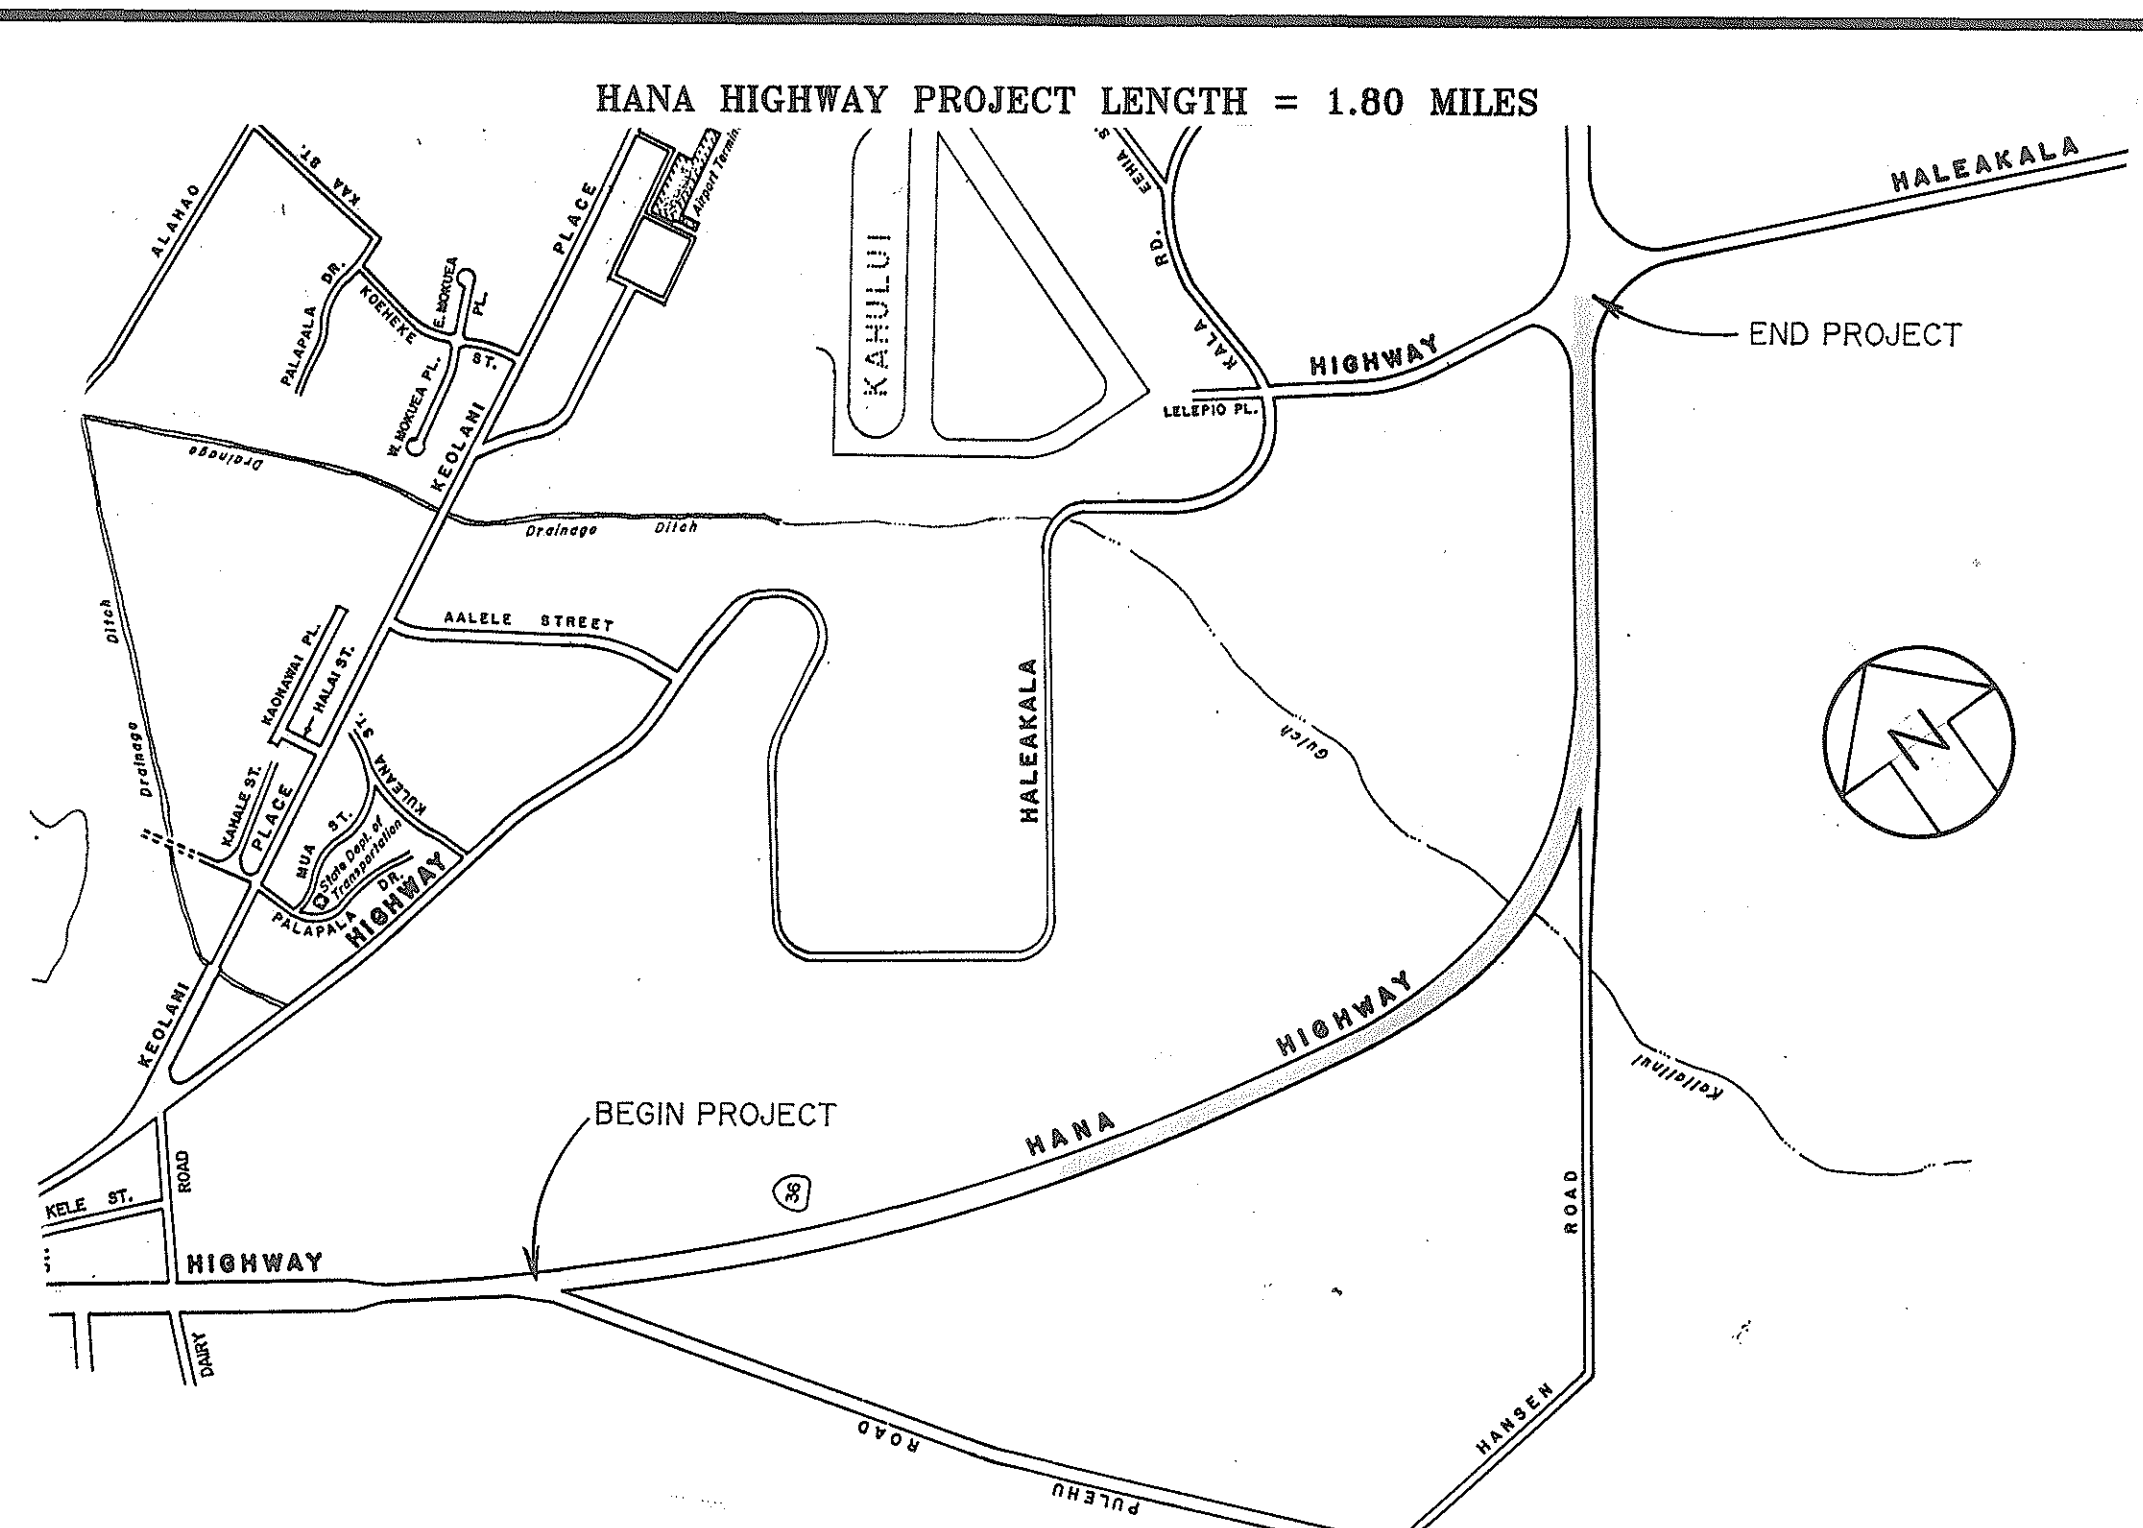

CHANGES MADE DURING CONSTRUCTION HAVE BEEN INCORPORATED ON THESE PLANS EXCEPT CHANGES IN THE ORIGINAL THEORETICAL QUANTITIES. FOR ACTUAL QUANTITIES, REFER TO PROJECT LEDGER AND/OR CONSTRUCTION BOOK.

9/22/04

DEPARTMENT OF PUBLIC WORKS COUNTY OF MAUI	
APPROVED:	DATE
<i>[Signature]</i>	7-6-99
for DIRECTOR OF PUBLIC WORKS	

DEPARTMENT OF WATER SUPPLY COUNTY OF MAUI	
APPROVED:	DATE
<i>[Signature]</i>	3/30/99
for DIRECTOR OF WATER SUPPLY	