


FED. ROAD DIST. NO.	STATE	PROJ. NO.	FISCAL YEAR	SHEET NO.	TOTAL SHEETS
HAWAII	HAW.	STP-036-1(13)	1999	6	16

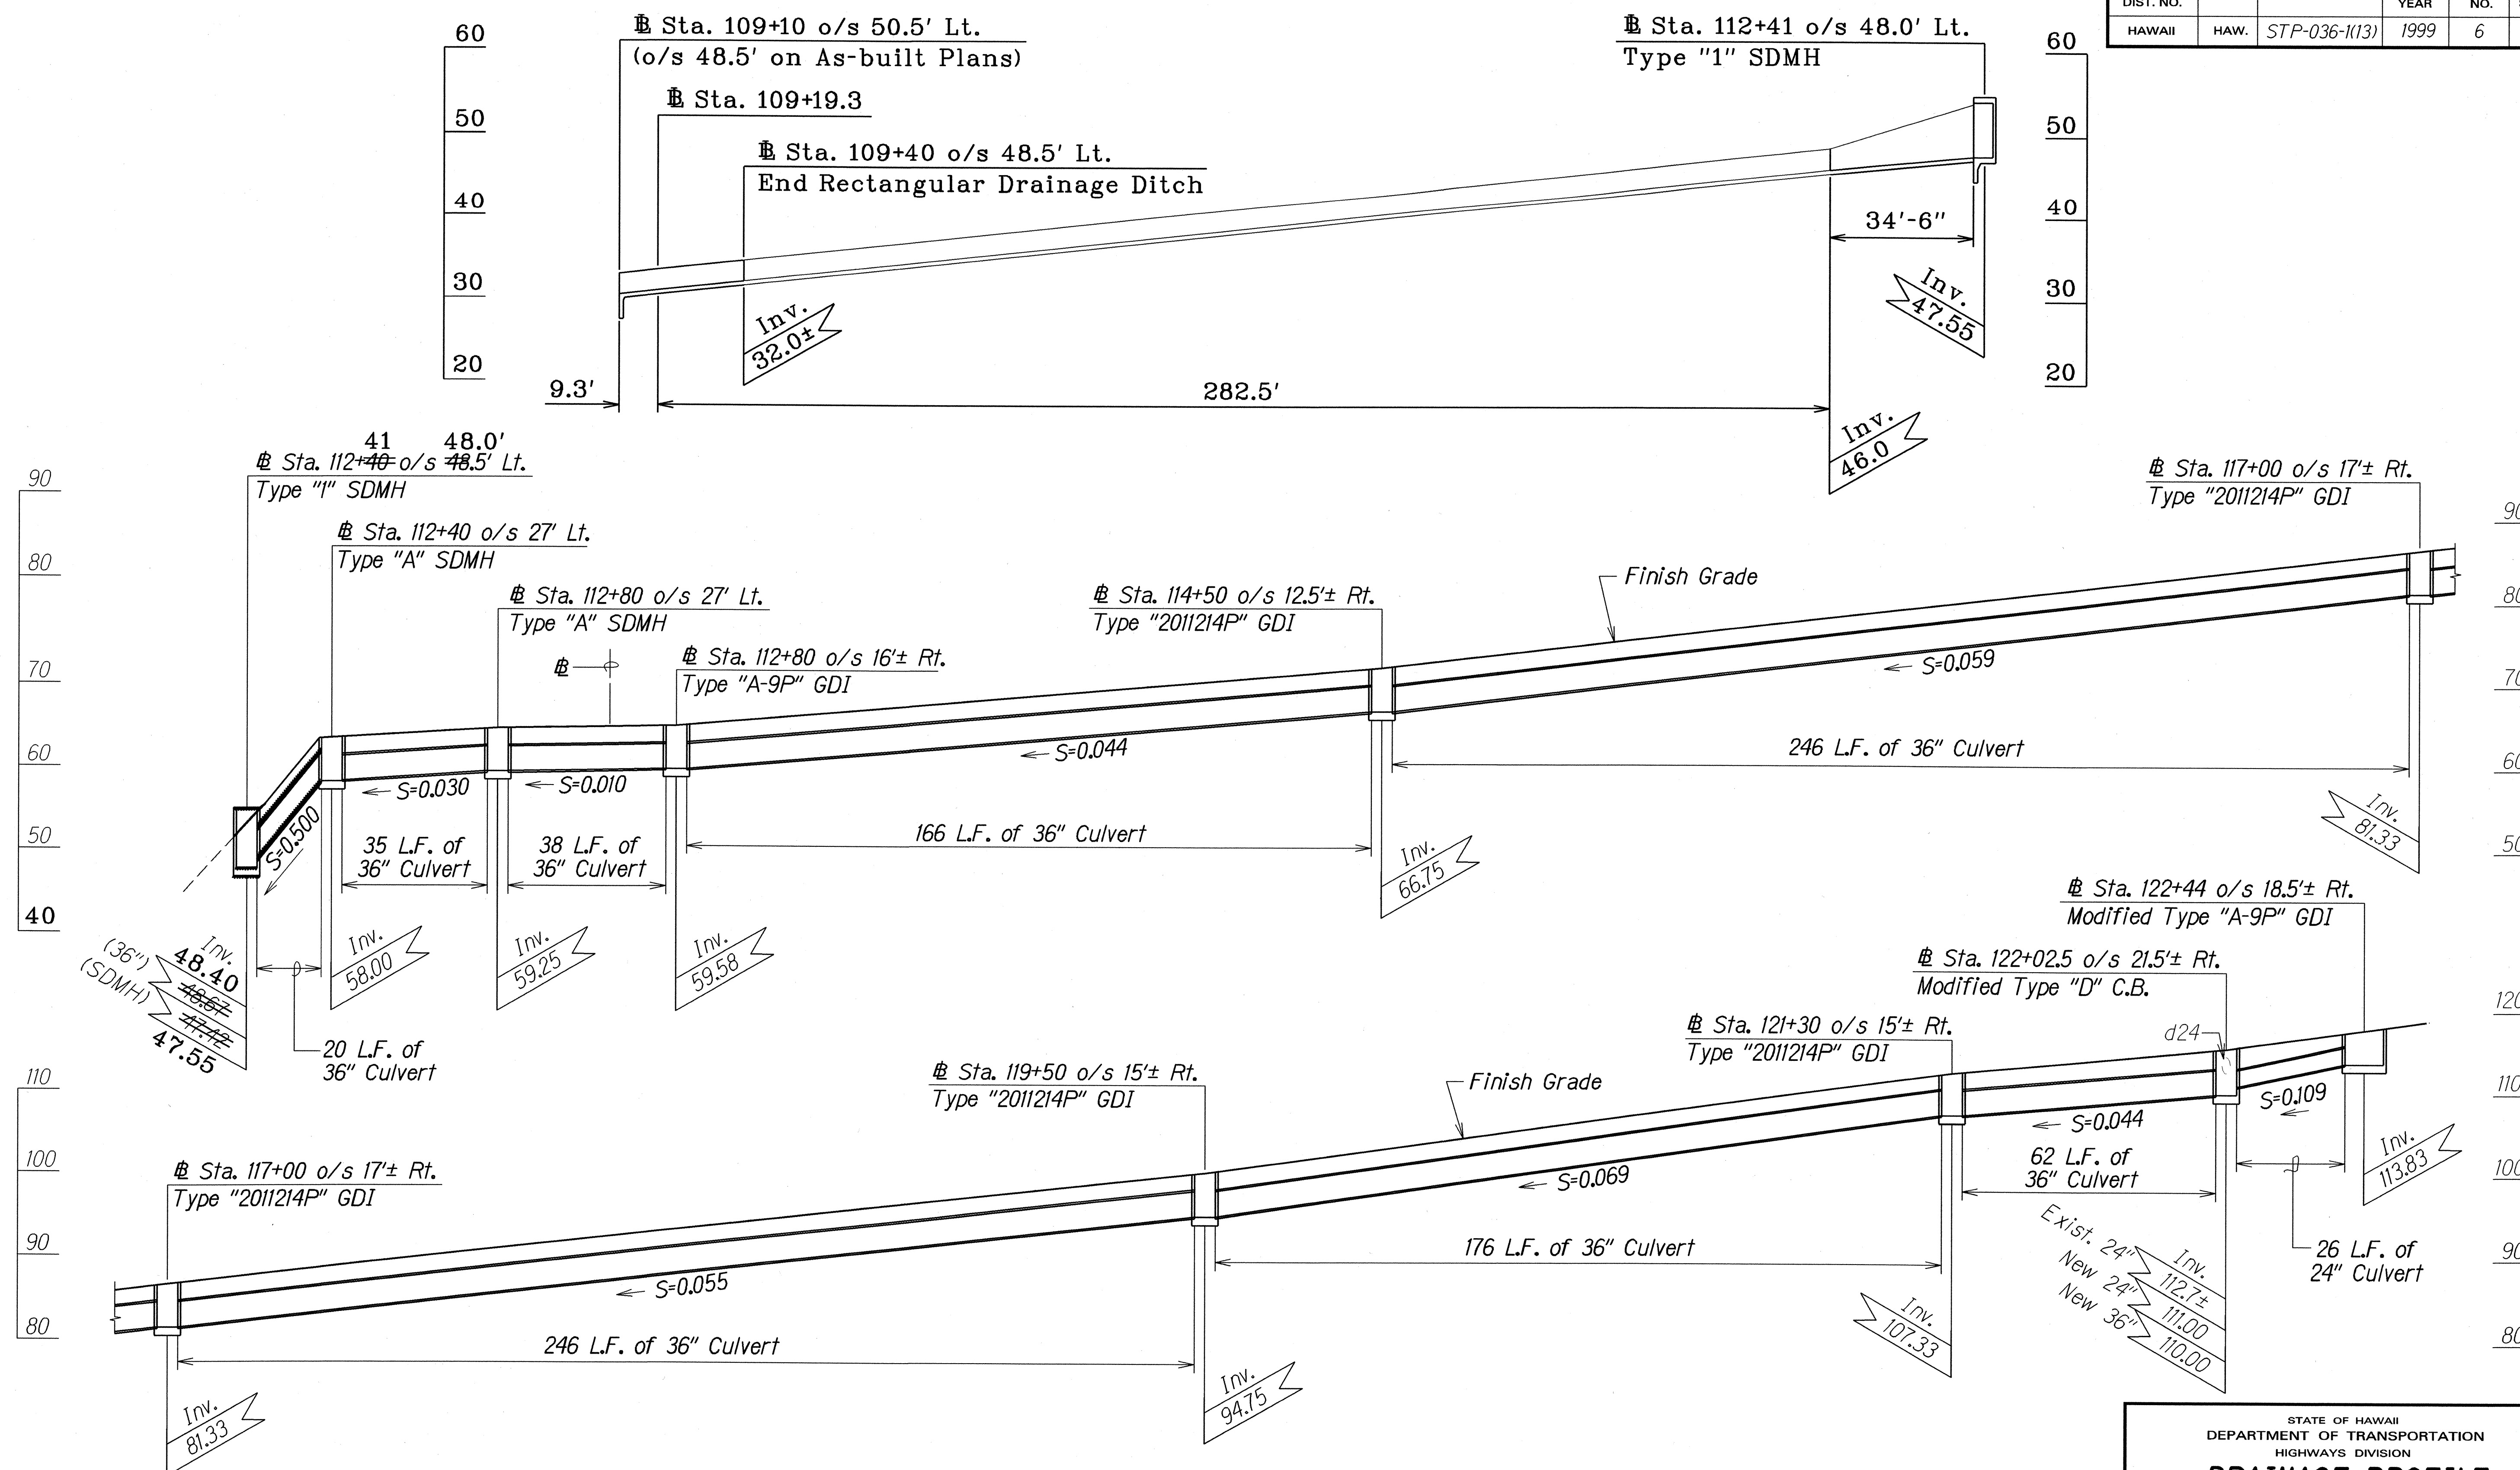

PROFILE-HANA HIGHWAY @ STA. 112+40 o/s 48.5' LT. TO
@ STA. 122+44 o/s 18.5± RT.
 Scale: Horiz. 1"=20'
 Vert. 1"=10'

LEGEND FOR AS-BUILT POSTINGS	
	Squiggly line for as-built deletion
	Double line for as-built deletion
Roadway	Text for as-built posting

STATE OF HAWAII
 DEPARTMENT OF TRANSPORTATION
 HIGHWAYS DIVISION

DRAINAGE PROFILE

HANA HIGHWAY
 DRAINAGE IMPROVEMENTS
 WEST KUIAHA ROAD TO VALLEY ISLE MEMORIAL PARK
 Federal Aid Project No. STP-036-1(13)
 Scale: As Shown Date: AUGUST, 1998

SHEET No. H3 OF 12 SHEETS

SURVEY PLOTTED BY	DATE
DRAWN BY	
NOTE BOOK	
DESIGNED BY	
QUANTITIES BY	
CHECKED BY	