

FED. ROAD DIST. NO.	STATE	FED. AID PROJ. NO.	FISCAL YEAR	SHEET NO.	TOTAL SHEETS
HAWAII	HAW.	BR-036-1(14)	2000	C.O.4	70

NEW RIGHT-OF-WAY CURVE DATA				
CURVE NUMBER	Δ	RADIUS	TANGENT	LENGTH
1	6°07'51"	994.12	53.24	106.37
2	26°20'09"	1019.12	238.43	468.44

NEW BASELINE CURVE DATA					
CURVE NUMBER	Δ	RADIUS	TANGENT	LENGTH	SUPER-ELEVATION
3	32°28'00"	850.00	247.48	481.65	6.6%
4	5°40'31"	2020.00	100.12	200.08	3.7%
5	9°01'25"	1272.00	100.37	200.33	5.1%

True North
Scale: 1"=60'

SURVEY PLOTTED BY	DATE
DRAWN BY	
DESIGNED BY	
QUANTITIES BY	
CHECKED BY	

ORIGINAL PLAN	No.
NOTE BOOK	



Job: 97-34 File: CO-GENERAL.DWG Disk: UAOA (ESH-1) Plot: 1=60 Date: 01/08/01 PV

CONSTRUCTION ACCESS ROAD(S)

THE ENGINEER WILL NOT MEASURE WORK FOR CONSTRUCTION ACCESS ROAD(S). COST FOR CONSTRUCTION ACCESS ROAD(S) SHALL BE CONSIDERED INCIDENTAL TO THE VARIOUS CONTRACT ITEMS.

CONSTRUCTION OF ANY ACCESS ROAD SHALL BE DONE AT THE OPTION OF THE CONTRACTOR. ANY ACCESS ROAD SHALL BE CONSTRUCTED WITHIN THE RIGHT-OF-WAY OF THE STATE OF HAWAII AND THE CONSTRUCTION PARCELS NOTED ON THE DRAWINGS.

GENERAL PLAN-HANA HIGHWAY
SCALE: 1"=60'

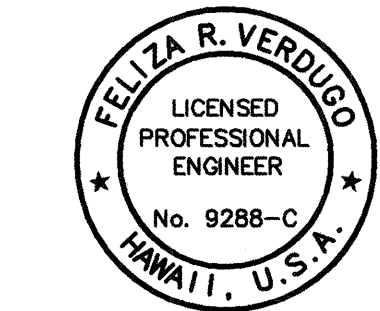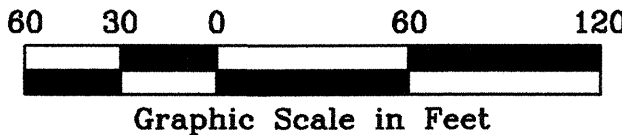

THIS WORK WAS PREPARED BY ME OR UNDER MY SUPERVISION.
Feliza R. Verdugo
ENGINEERS-SURVEYORS HAWAII, INC.

01/19/01	THIS SHT. REPLACED ORIGINAL SHT.
DATE	REVISION
STATE OF HAWAII DEPARTMENT OF TRANSPORTATION HIGHWAYS DIVISION GENERAL PLAN-HANA HIGHWAY HANA HIGHWAY REPLACEMENT OF UAOA BRIDGE AND APPROACHES DISTRICT OF MAKAWAO Federal-Aid Project No. BR-036-1(14) Scale: As Noted Date: May, 1999 SHEET No. C-2 OF 42 SHEETS	