
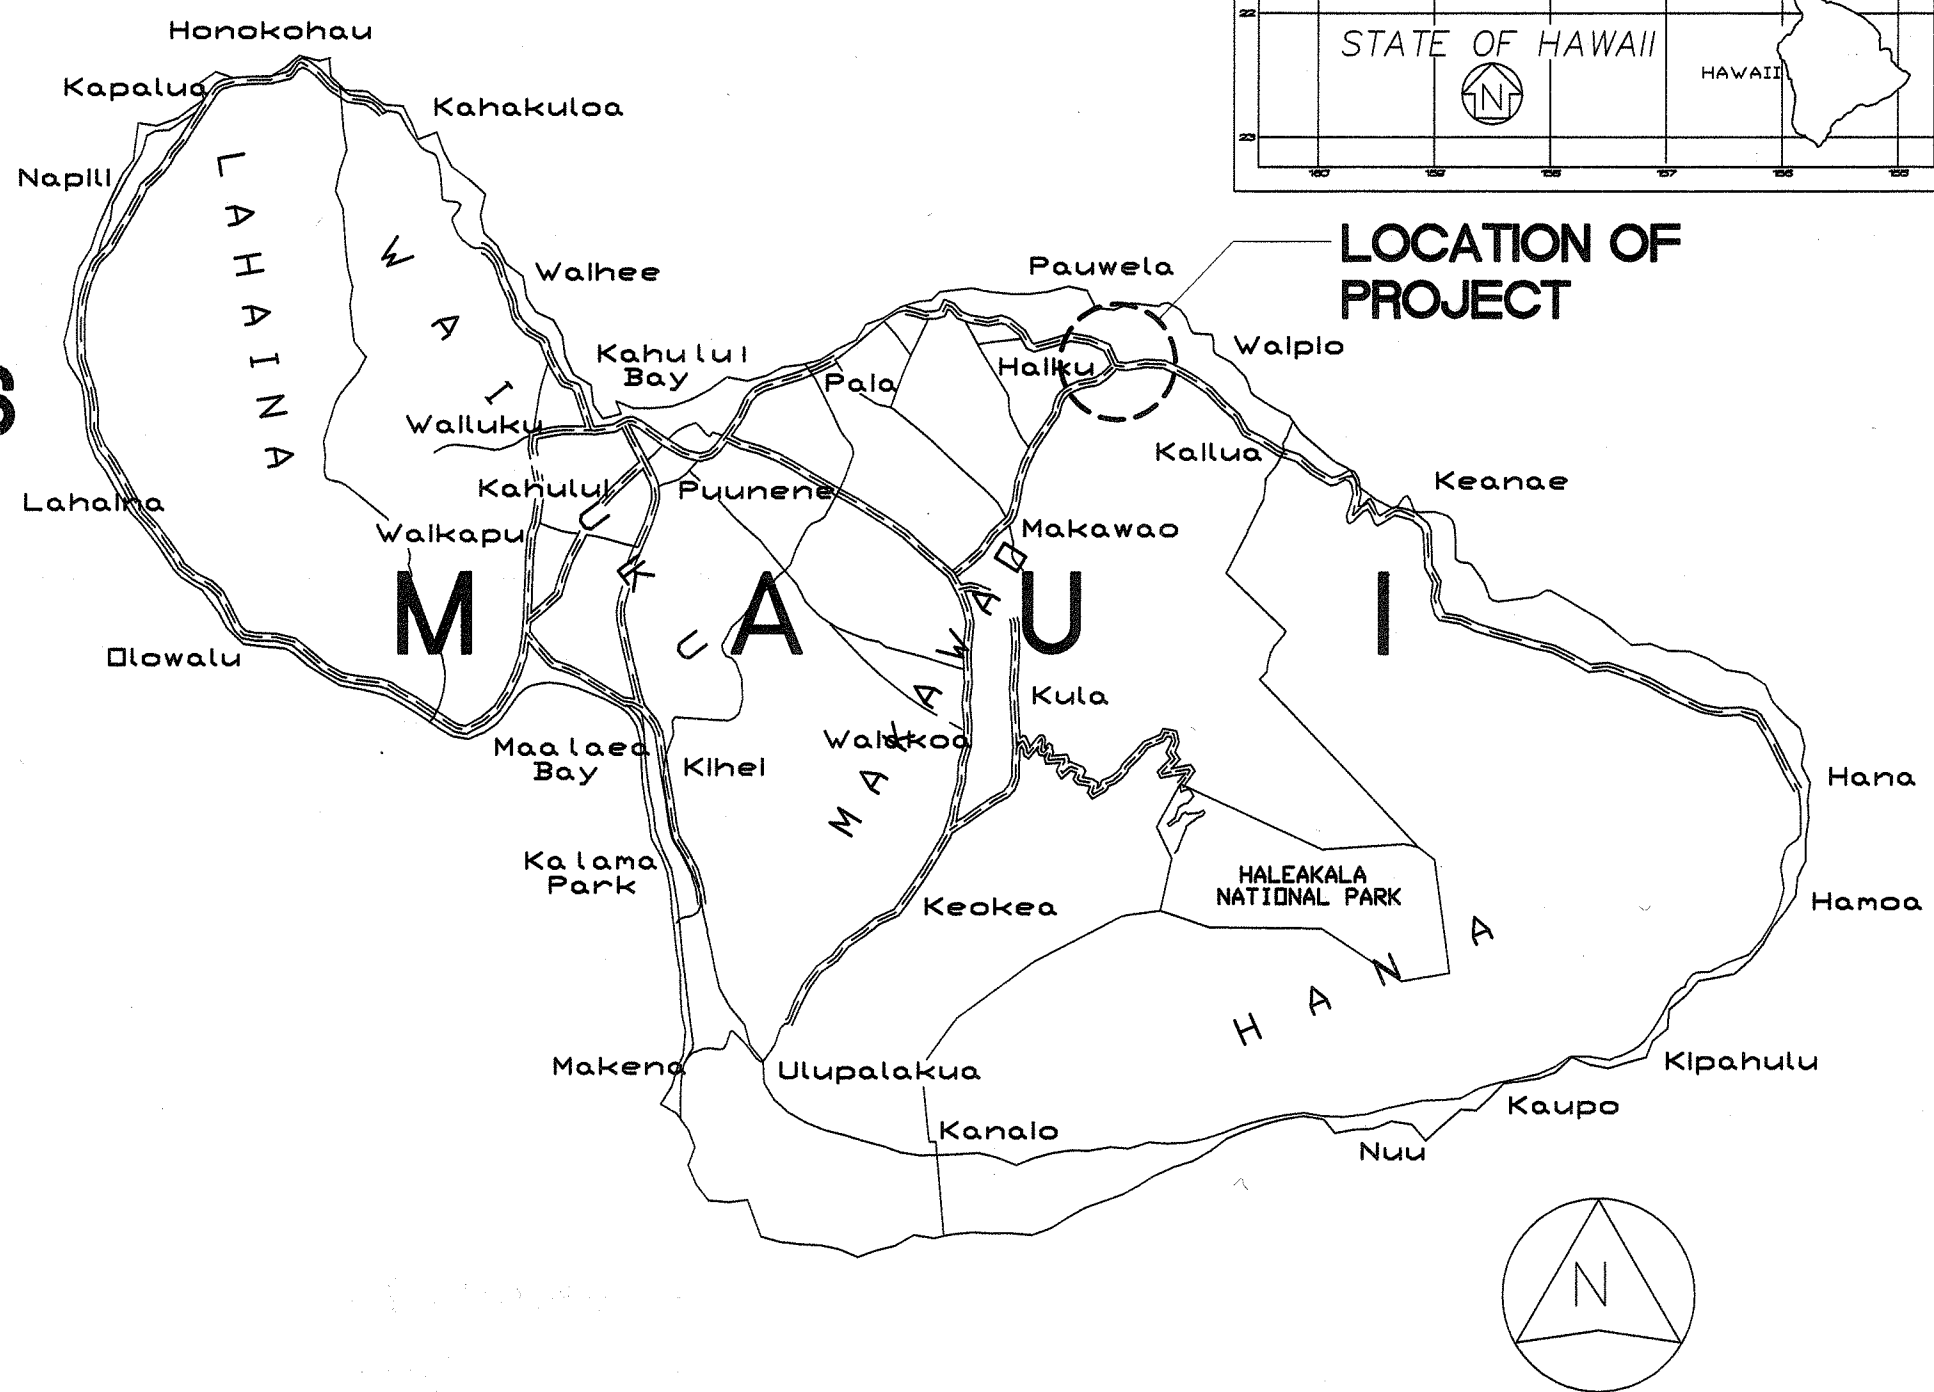
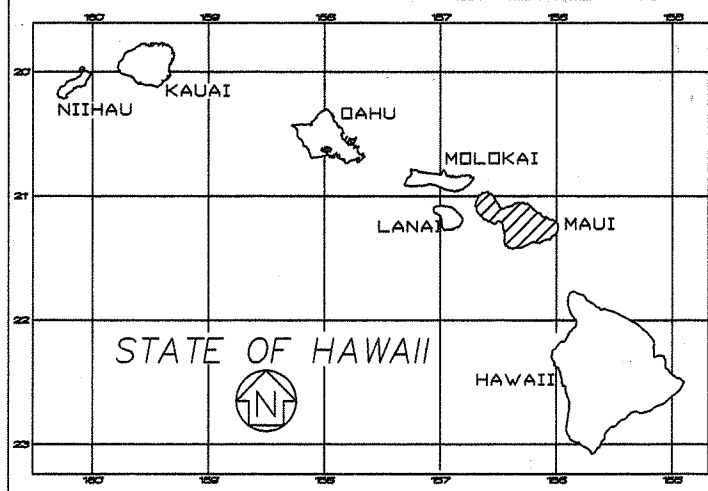


INDEX TO DRAWINGS	
SHEET NO.	DESCRIPTION
1	TITLE SHEET
2	STANDARD PLANS SUMMARY
3	NOTES
4	GENERAL PLAN-HANA HIGHWAY
5-10	BORING LOGS
11	TYPICAL SECTIONS
12-14	PROFILE-HANA HIGHWAY
15-17	GRADING PLAN
18-23	CROSS SECTIONS-HANA HIGHWAY
24	SIGNING AND STRIPING-HANA HIGHWAY
25	GUARDRAIL DETAILS AND NOTES
26-27	STRONG POST W-BEAM GUARDRAIL
28	STRONG POST MODIFIED THRIE-BEAM GUARDRAIL
29-31	TYPE "A" FLARE
32	ET-2000 - OPTION "A"
33	GENERAL PLAN - DETOUR ROAD PHASE 1
34	GENERAL PLAN - DETOUR ROAD PHASE 2
35	PROFILE-DETOUR ROAD PHASE 1
36	PROFILE-DETOUR ROAD PHASE 2
37	CROSS SECTIONS DETOUR ROAD PHASE 1-A
38-39	CROSS SECTIONS DETOUR ROAD PHASE 1-B
40-41	CROSS SECTIONS DETOUR ROAD PHASE 2-A
42	CROSS SECTIONS DETOUR ROAD PHASE 2-B
43	TRAFFIC CONTROL PLAN DETOUR ROAD PHASE 1
44	TRAFFIC CONTROL PLAN DETOUR ROAD PHASE 2
45-70	STRUCTURAL DRAWINGS

STATE OF HAWAII
DEPARTMENT OF TRANSPORTATION
HIGHWAYS DIVISION
HONOLULU, HAWAII
PLANS FOR
HANA HIGHWAY
REPLACEMENT OF UAOA BRIDGE AND APPROACHES
FEDERAL AID PROJECT NO. BR-036-1 (14)
DISTRICT OF MAKAWAO
ISLAND OF MAUI

FED. ROAD DIST. NO.	STATE	FED. AID PROJ. NO.	FISCAL YEAR	SHEET NO.	TOTAL SHEETS
HAWAII	HAW.	BR-036-1(14)	2000	1	70

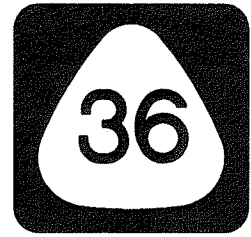

CHANGES MADE DURING CONSTRUCTION HAVE BEEN INCORPORATED ON THESE PLANS EXCEPT CHANGES IN THE ORIGINAL THEORETICAL QUANTITIES. FOR ACTUAL QUANTITIES, REFER TO PROJECT LEDGER AND/OR COMPUTER BOOK.

Michael J. King 2-27-2008
RESIDENT ENGINEER DATE

MILE POST 15.34 TO MILE POST 15.59

SCALE IN MILES



LOCATION PLAN

NOT TO SCALE

Length Of Project = 0.256 Miles

DESIGN DESIGNATION

DESIGN ADT (2017)	7,280
DHV	660
D	70/30
T	1.5%
T ₂₄	1.5%
V	40 MPH

DEPARTMENT OF TRANSPORTATION
STATE OF HAWAII

APPROVED:

Kayoko Kato
DIR. OF TRANSPORTATION

11/9/99

DATE

11/4/99
DATE

692-7546
PHONE

EMILIO BARROGA, JR.
P. S. & E. BY

NISHIMURA, KATAYAMA,
OKI & SANTO INC.
DESIGNED BY