



FED. ROAD DIST. NO.	STATE	FED. AID PROJ. NO.	FISCAL YEAR	SHEET NO.	TOTAL SHEETS
HAWAII	HAW.	BR-036-1(14)	2000	C.O.43	70

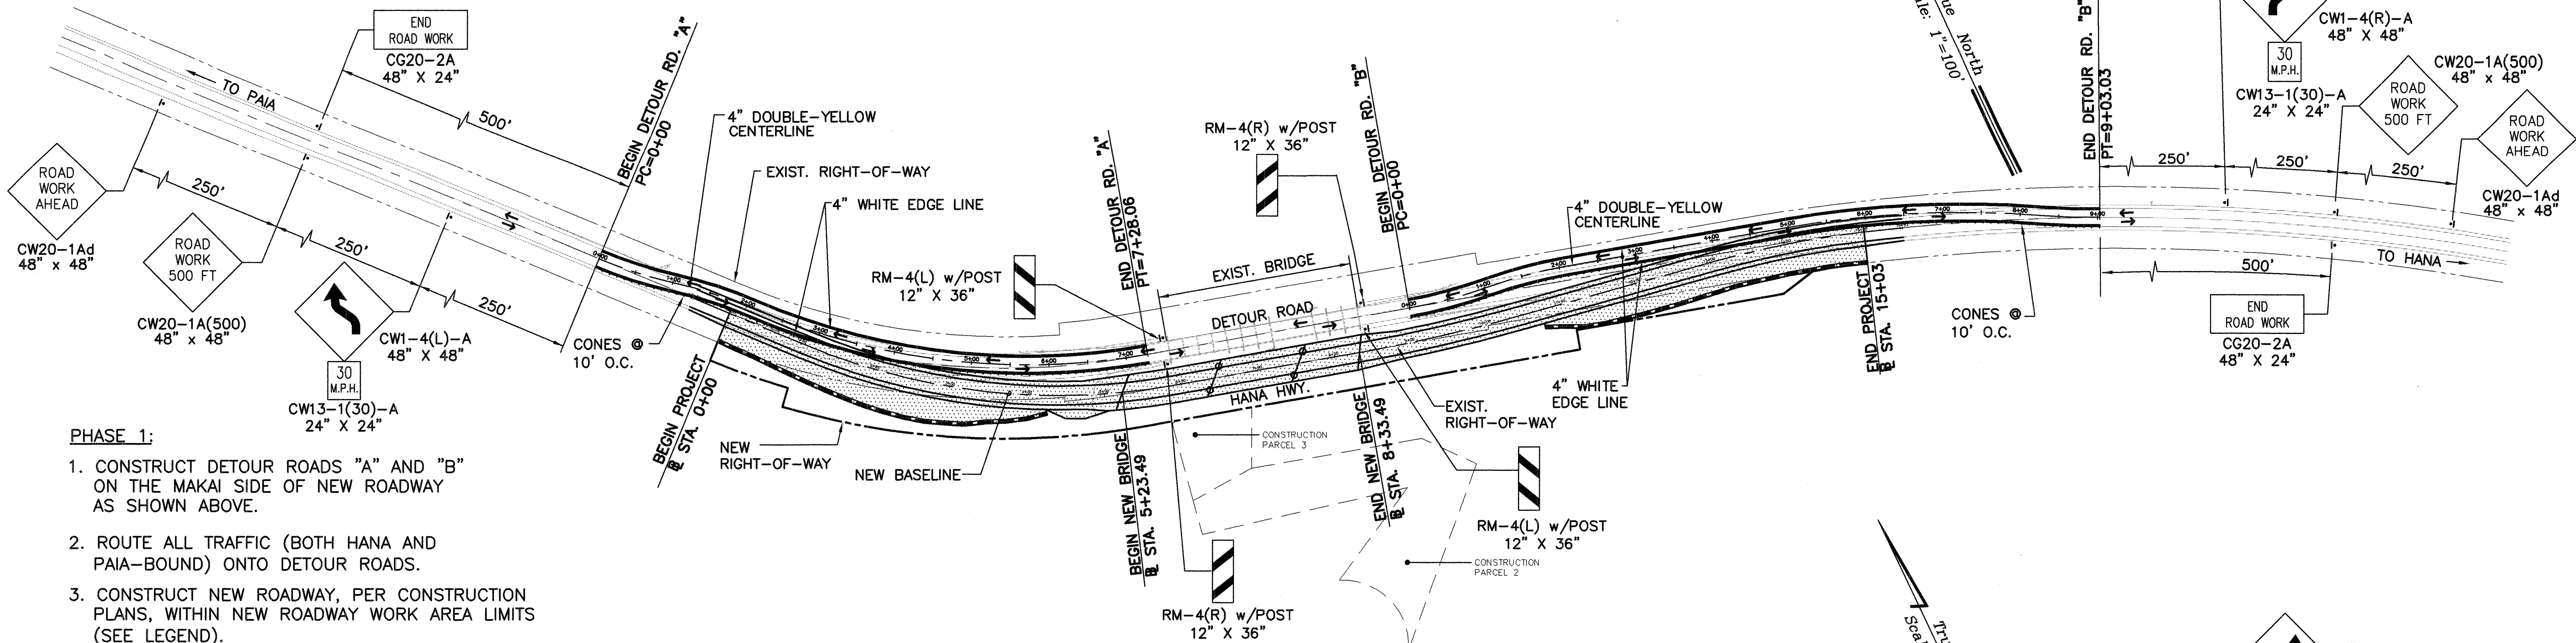

PHASE 1:

1. CONSTRUCT DETOUR ROADS "A" AND "B" ON THE MAKAI SIDE OF NEW ROADWAY AS SHOWN ABOVE.
2. ROUTE ALL TRAFFIC (BOTH HANA AND PAIA-BOUND) ONTO DETOUR ROADS.
3. CONSTRUCT NEW ROADWAY, PER CONSTRUCTION PLANS, WITHIN NEW ROADWAY WORK AREA LIMITS (SEE LEGEND).

TRAFFIC CONTROL PLAN-DETOUR ROAD PHASE 1
SCALE: 1" = 100'

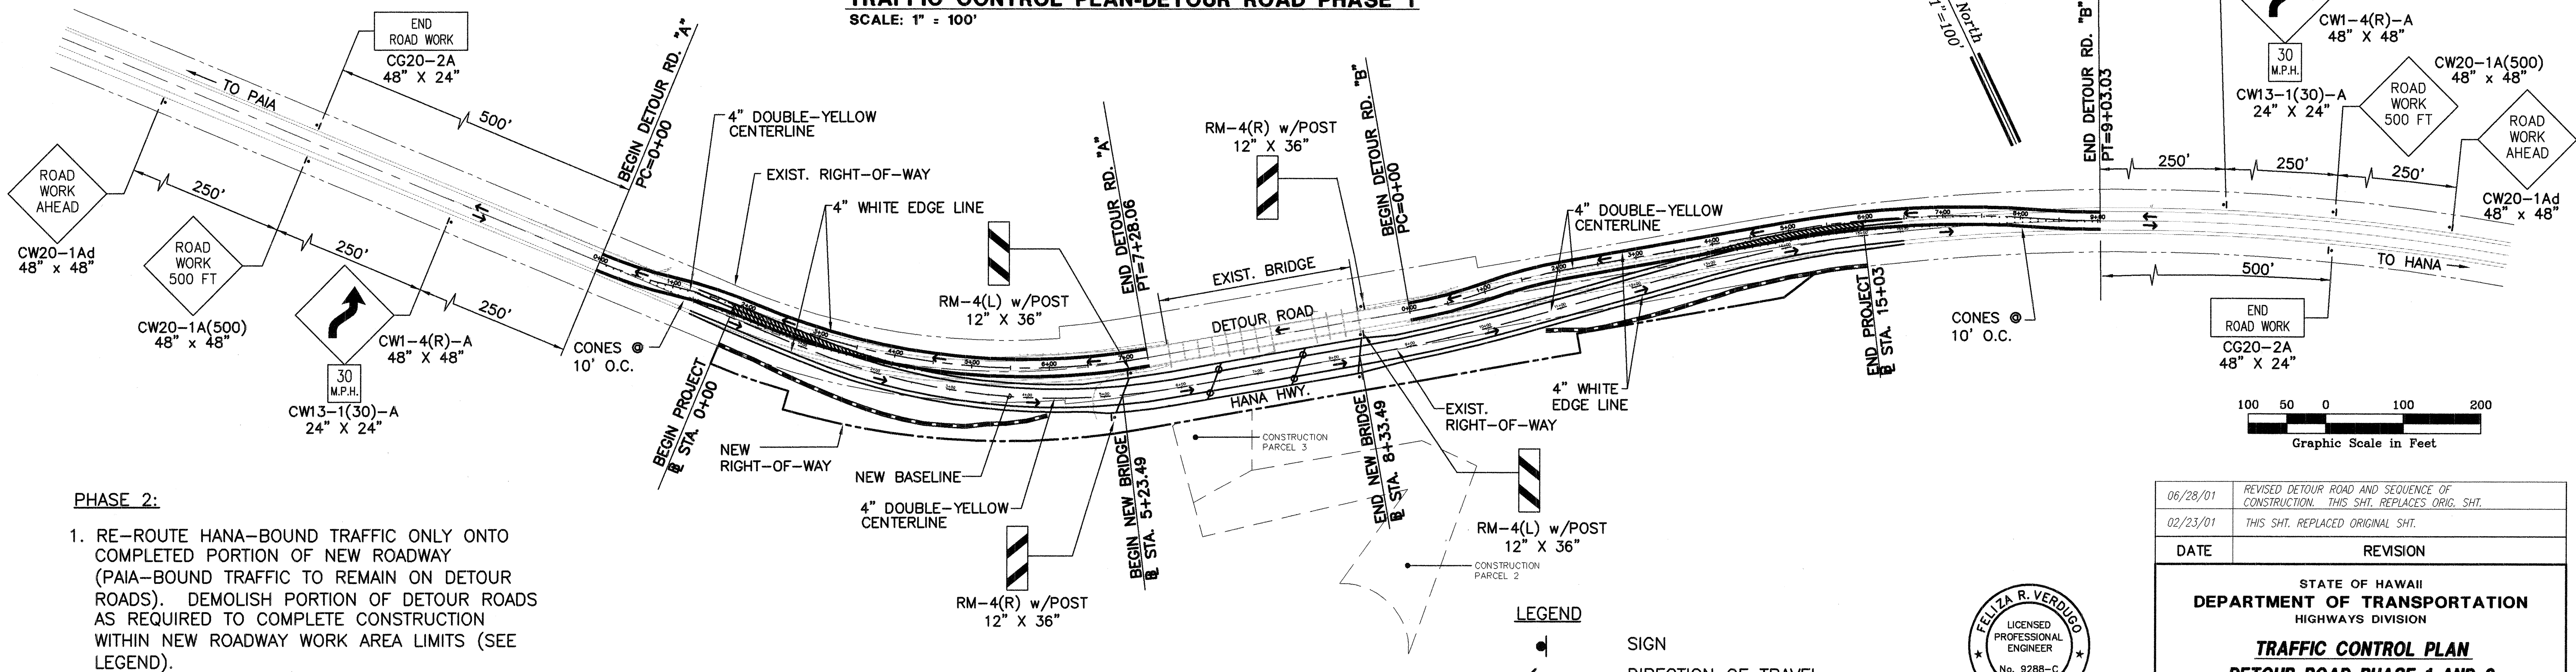


PHASE 2:

1. RE-ROUTE HANA-BOUND TRAFFIC ONLY ONTO COMPLETED PORTION OF NEW ROADWAY (PAIA-BOUND TRAFFIC TO REMAIN ON DETOUR ROADS). DEMOLISH PORTION OF DETOUR ROADS AS REQUIRED TO COMPLETE CONSTRUCTION WITHIN NEW ROADWAY WORK AREA LIMITS (SEE LEGEND).


TRAFFIC CONTROL PLAN-DETOUR ROAD PHASE 2
SCALE: 1" = 100'

LEGEND

- SIGN
- DIRECTION OF TRAVEL
- NEW ROADWAY WORK AREA TO BE COMPLETED IN PHASE 1
- NEW ROADWAY WORK AREA TO BE COMPLETED IN PHASE 2
- CONE OR DELINEATOR

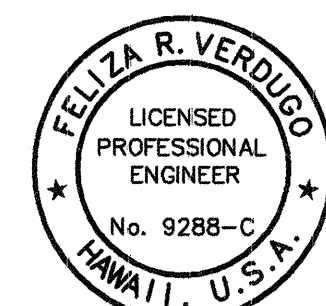

THIS WORK WAS PREPARED BY ME OR UNDER MY SUPERVISION.
ENGINEER SURVEYORS HAWAII, INC.
1-9-01

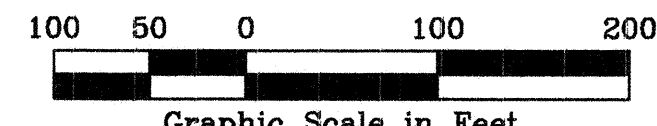

DATE	REVISION
06/28/01	REVISED DETOUR ROAD AND SEQUENCE OF CONSTRUCTION. THIS SHT. REPLACES ORIG. SHT.
02/23/01	THIS SHT. REPLACES ORIGINAL SHT.

STATE OF HAWAII
DEPARTMENT OF TRANSPORTATION
HIGHWAYS DIVISION
TRAFFIC CONTROL PLAN
DETOUR ROAD PHASE 1 AND 2
HANA HIGHWAY
REPLACEMENT OF UAOA BRIDGE AND APPROACHES
DISTRICT OF MAKAWAO
Federal-Aid Project No. BR-036-1(14)

Scale: As Noted Date: May, 1999
SHEET No. C-41 OF 42 SHEETS

FED. ROAD DIST. NO.	STATE	FED. AID PROJ. NO.	FISCAL YEAR	SHEET NO.	TOTAL SHEETS
HAWAII	HAW.	BR-036-1(14)	2000	C.O.44	70

True North
Scale: 1" = 100'



PHASE 3:

1. ROUTE ALL TRAFFIC (BOTH HANA AND PAIA-BOUND) ONTO COMPLETED PORTION OF NEW ROADWAY. DEMOLISH PORTION OF DETOUR ROADS AS REQUIRED TO COMPLETE ANY REMAINING GRADING OPERATIONS, SHOULDER CONSTRUCTION, INSTALLATION OF GUARDRAILS, ETC. (PER CONSTRUCTION PLANS) WITHIN NEW ROADWAY WORK AREA LIMITS (SEE LEGEND).

LEGEND

- SIGN
- DIRECTION OF TRAVEL
- NEW ROADWAY WORK AREA TO BE COMPLETED IN PHASE 3
- CONE OR DELINEATOR

TRAFFIC CONTROL PLAN-DETOUR ROAD PHASE 3
SCALE: 1" = 100'

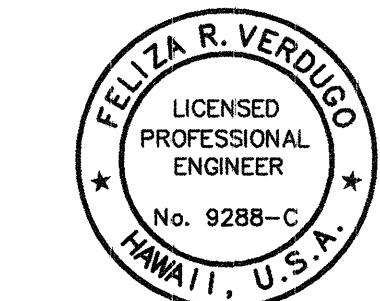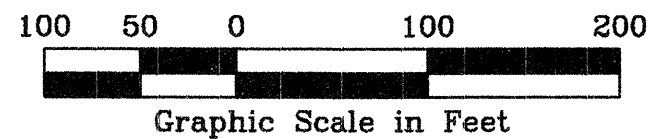

THIS WORK WAS PREPARED BY ME OR UNDER MY SUPERVISION.
Felipe R. Verdugo
ENGINEER SURVEYORS HAWAII, INC.

DATE	REVISION
06/28/01	REVISED DETOUR ROAD AND SEQUENCE OF CONSTRUCTION. THIS SHT. REPLACES ORIG. SHT.
02/23/01	THIS SHT. REPLACES ORIGINAL SHT.
STATE OF HAWAII DEPARTMENT OF TRANSPORTATION HIGHWAYS DIVISION TRAFFIC CONTROL PLAN DETOUR ROAD PHASE 3 HANA HIGHWAY REPLACEMENT OF UAOA BRIDGE AND APPROACHES DISTRICT OF MAKAWAO Federal-Aid Project No. BR-036-1(14)	
Scale: As Noted Date: May, 1999	
SHEET No. C-42 OF 42 SHEETS	

C.O. 44

SURVEY PLOTTED BY	DATE
DRAWN BY	
TRACED BY	
CHECKED BY	
ORIGINAL PLAN	
NOTE BOOK	
No.	

Job: 97-34 File: C02-TCP2.DWG Disk: UAOA(ESH-1) Plot: 1=100 Date: 07/05/01 EV