INDEX TO DRAWINGS	
SHEET NO.	DESCRIPTION
1	TITLE SHEET
2	STANDARD PLANS SUMMARY
3 – 4	GENERAL NOTES AND LEGEND
5 – 6	DRAINAGE PLAN AND PROFILE -
	KAAHUMANU AVENUE
7	INTERSECTION PLANS -
	KAAHUMANU AVENUE
8	GENERAL PLAN - HANA HIGHWAY
9 – 12	DRAINAGE PLANS - HANA HIGHWAY
13 – 15	MISCELLANEOUS DETAILS

STATE OF HAWAII

DEPARTMENT OF TRANSPORTATION

HIGHWAYS DIVISION
HONOLULU, HAWAII

AS-BUILT


PLANS FOR

KAAHUMANU AVENUE DRAINAGE IMPROVEMENTS S. WAKEA AVENUE TO KAHULUI BEACH ROAD AND

HANA HIGHWAY DRAINAGE IMPROVEMENTS
HOBRON AVENUE TO DAIRY ROAD

DISTRICT OF WAILUKU
ISLAND OF MAUI

FEDERAL AID PROJECT NO. NH-STP-0900(54)

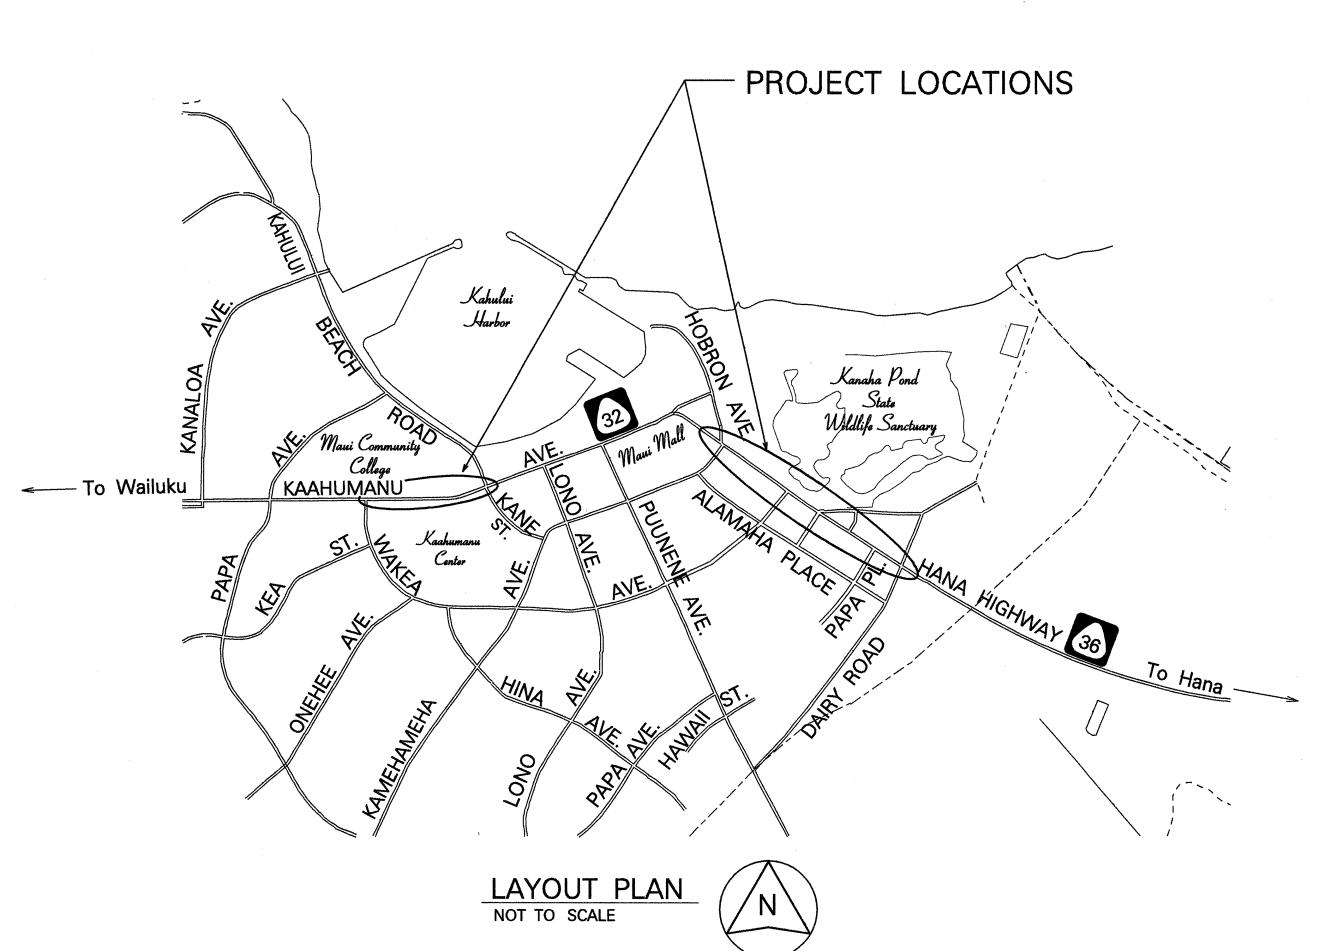

Honokolasu

Kapalua

Katakuloa

K

FEDERAL AID PROJ. NO.

NH-STP-0900(54) 2000

CHANGES MADE DURING CONSTRUCTION HAVE BEEN INCORPORATED ON THESE PLANS EXCEPT CHANGES IN THE ORIGINAL THEORETICAL QUANTITIES. FOR ACTUAL QUANTITIES, REFER TO PROJECT LEDGER AND/OR COMPUTATION BOOK.

Rector Toroncle 3/18/02

DEPARTMENT OF TRANSPORTATION STATE OF HAWAII APPROVED:

DIR. OF TRANSPORTATION

1

9/5/00

DATE