

INDEX TO DRAWINGS	
SHEET NO.	DESCRIPTION
1	TITLE SHEET
2	STANDARD PLANS SUMMARY
3	GENERAL NOTES & LEGEND
4 – 5	WATER POLLUTION & EROSION CONTROL NOTES
6	GUARDRAIL DETAILS & NOTES
7	ET-2000 PLUS
8 – 10	TYPE A FLARE
11 – 12	TYPICAL SECTIONS & DETAILS
13	CURB RAMP & SIDEWALK NOTES
14	CURB RAMP DETAILS
15	DRAINAGE PLAN
16 – 17	DRAINAGE DETAILS
18	GENERAL NOTES & TYPICAL INSTALLATION DETAILS
19	MISCELLANEOUS DETAILS
20 – 34	ROADWAY PLANS
35	WORK ZONE SIGNING PLAN, NOTES & DETAILS
36	PAVEMENT MARKING LEGEND, DETAILS & NOTES
37 – 51	SIGNING & PAVEMENT MARKING PLANS
52	RAISED PAVEMENT MARKERS AND STRIPING SUMMARY
53 – 54	MISCELLANEOUS SUMMARIES

STATE OF HAWAII

DEPARTMENT OF TRANSPORTATION

HIGHWAYS DIVISION

HONOLULU, HAWAII

"AS-BUILT"

PLANS FOR



HANA HIGHWAY RESURFACING

HALEAKALA HIGHWAY TO HOOKIPA PARK


PROJECT NO. 36AB-01-04M

DISTRICTS OF MAKAWAO AND WAILUKU
ISLAND OF MAUI

FED. ROAD DIST. NO.	STATE	PROJ. NO.	FISCAL YEAR	SHEET NO.	TOTAL SHEETS
HAWAII	HAW.	36AB-01-04M	2004	1	54

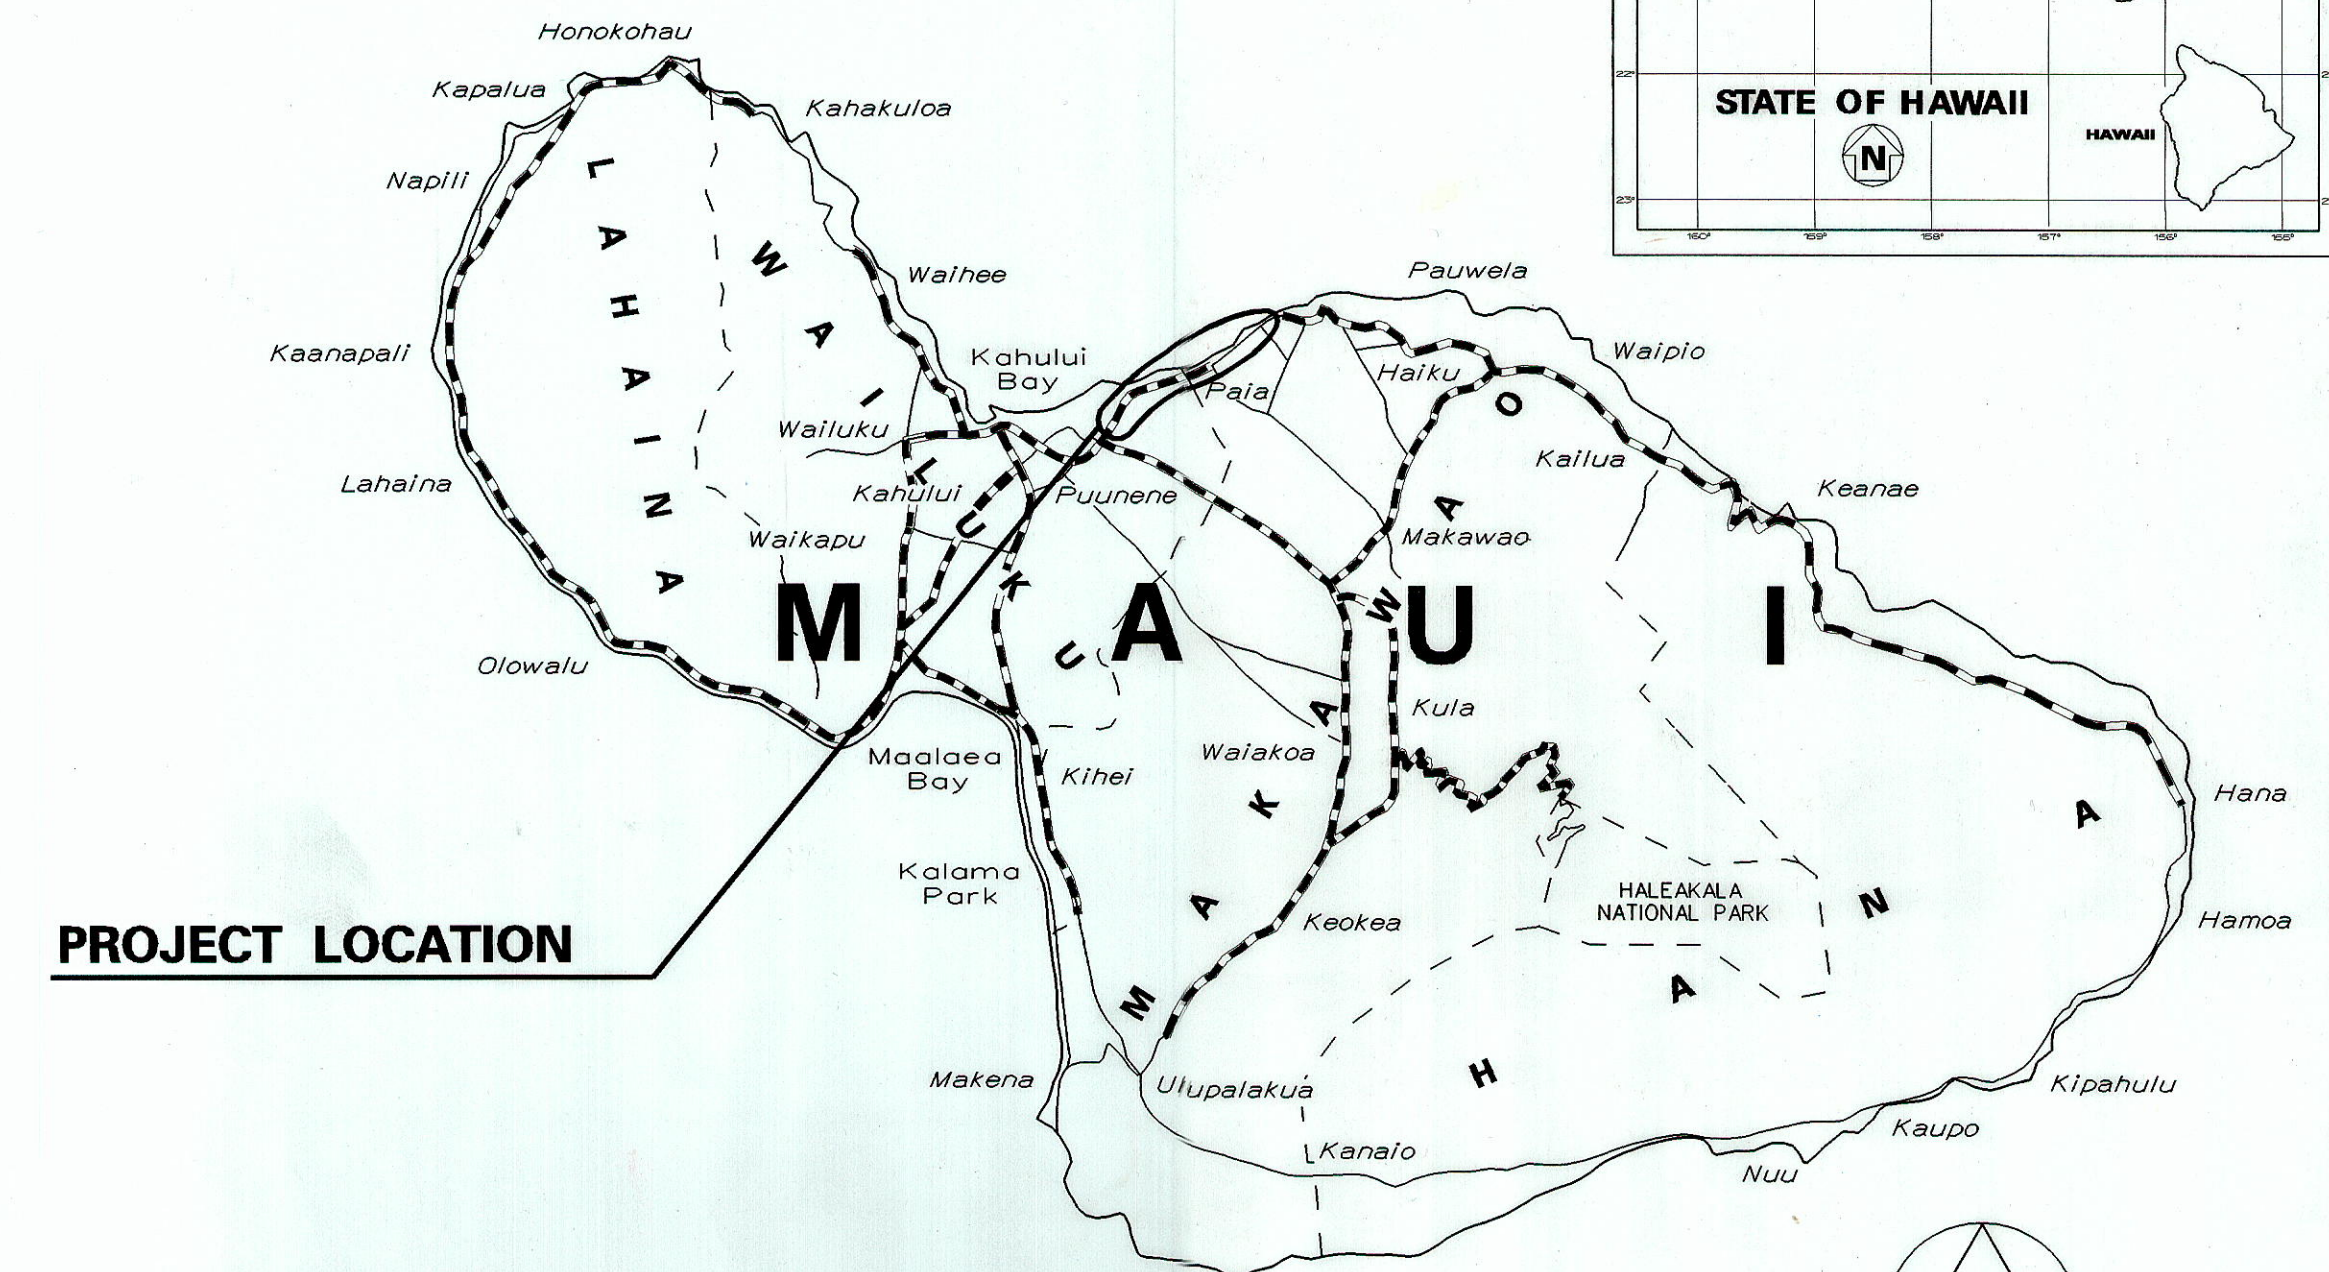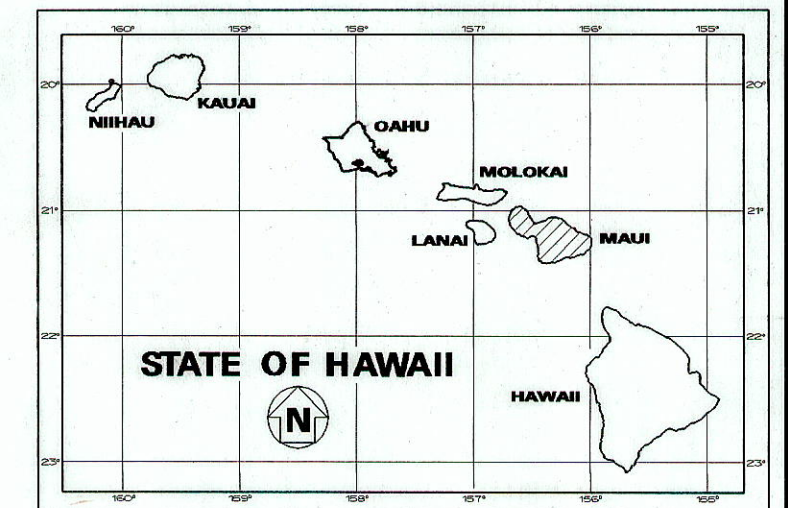

PROJECT LOCATION

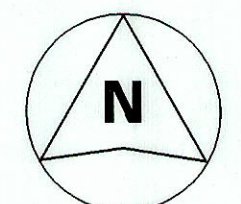


5 0 5 10

SCALE IN MILES

FEDERAL AID PROJECTS PREVIOUSLY CONSTRUCTED OR UNDER CONSTRUCTION

MILE POST 3.21 TO MILE POST 8.92

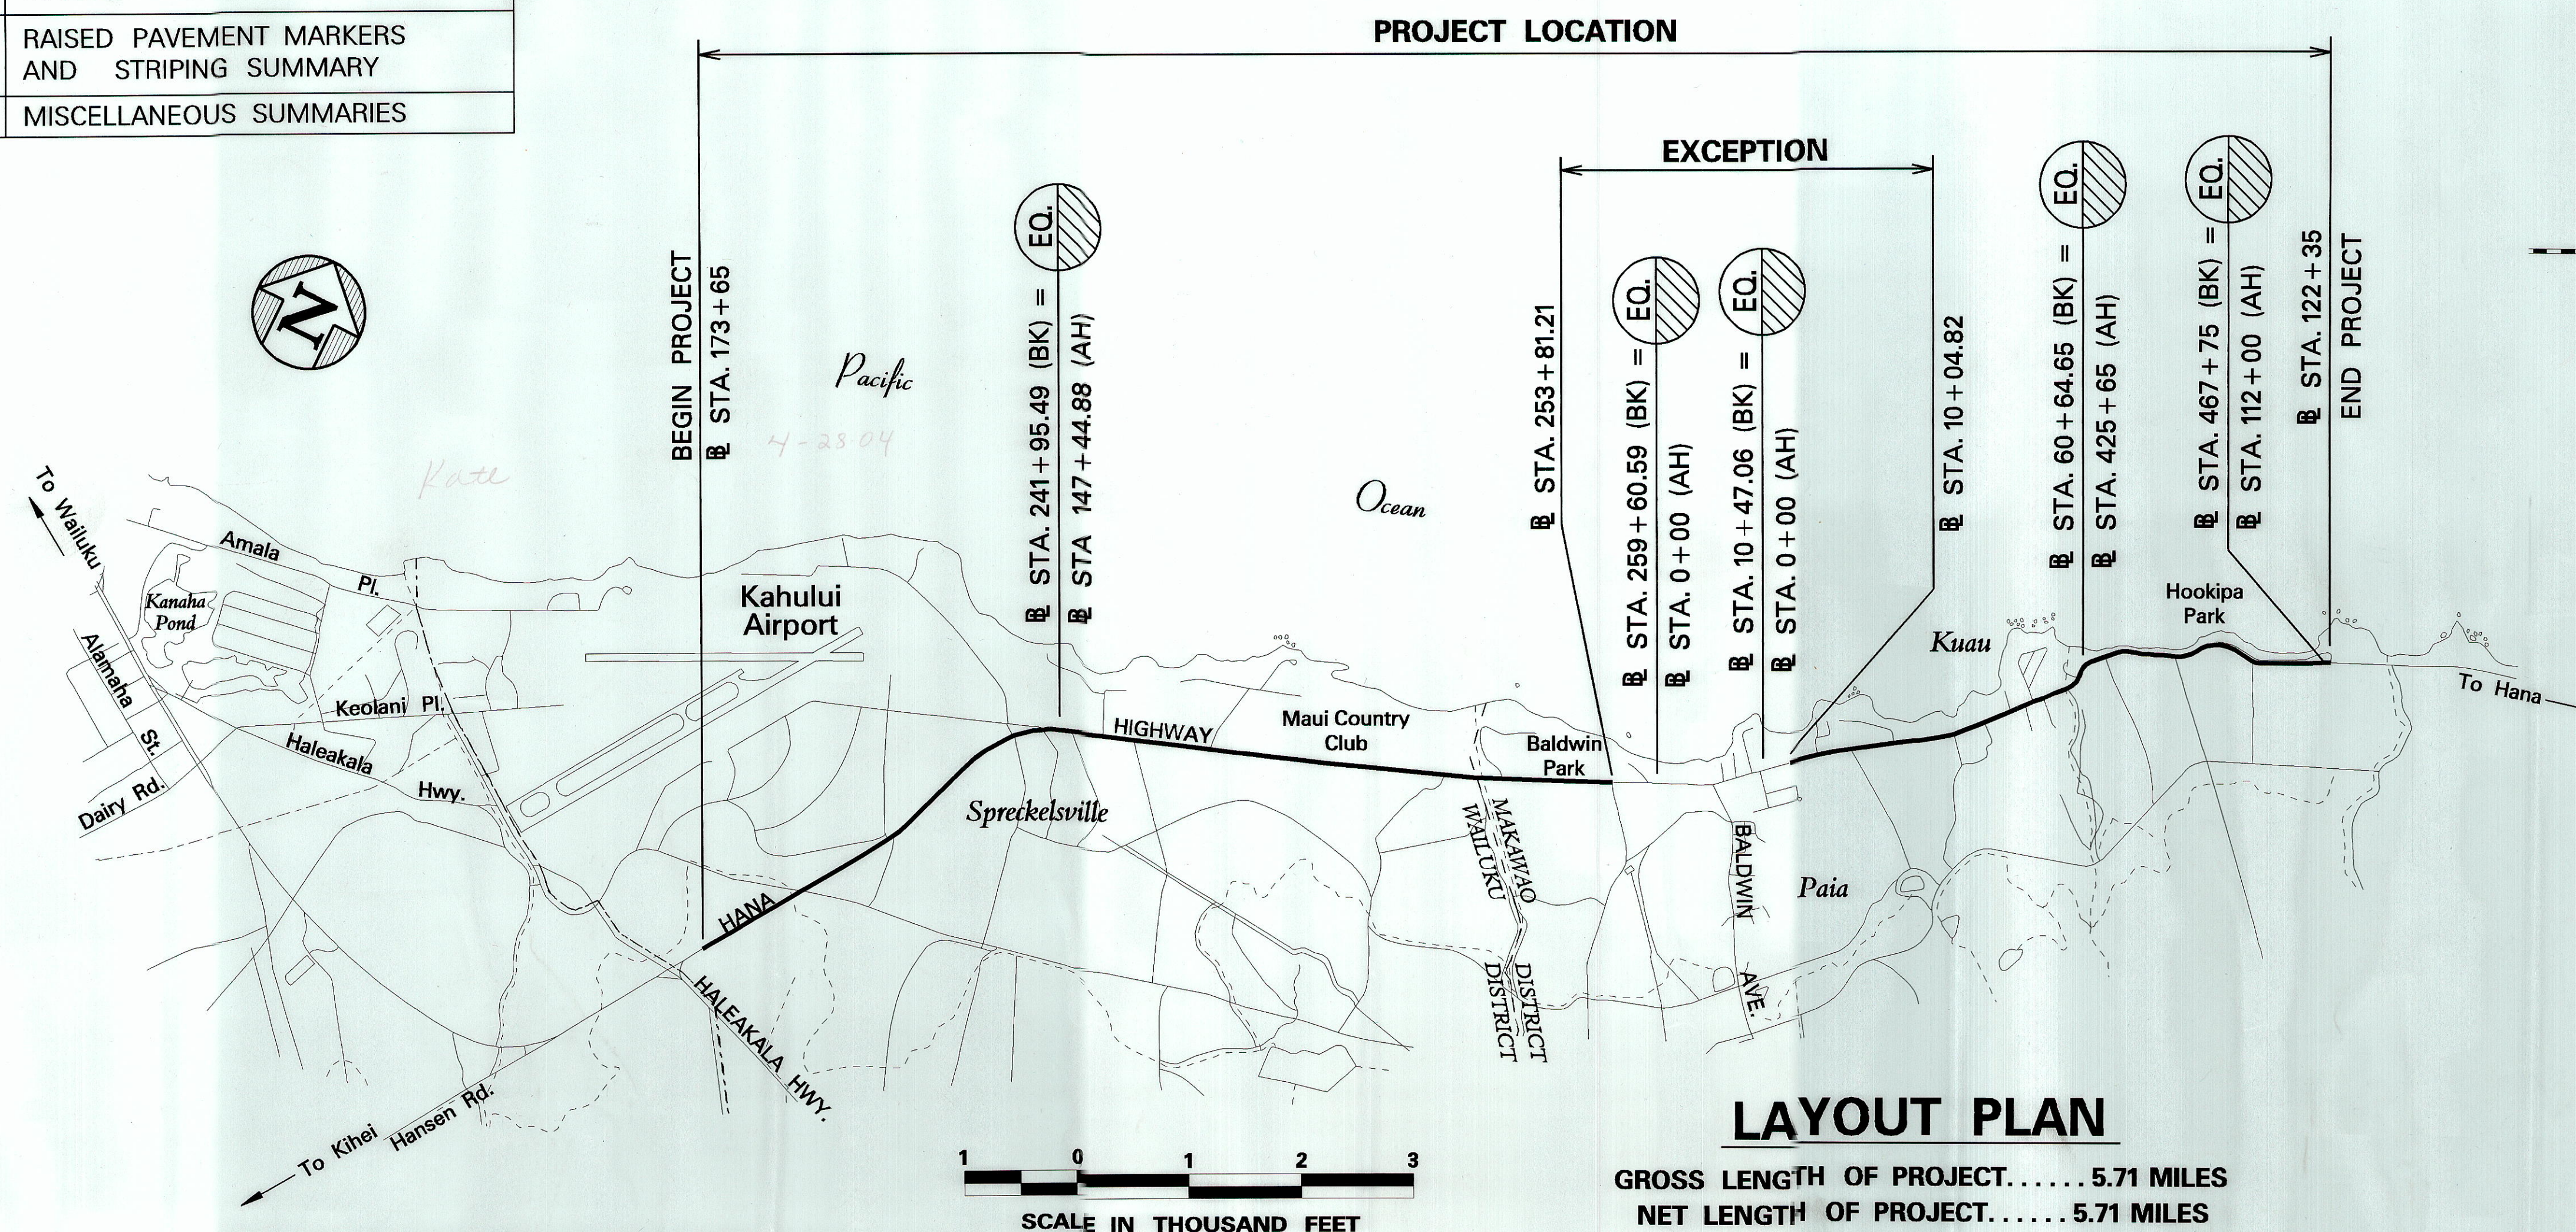

LAYOUT PLAN

GROSS LENGTH OF PROJECT.....5.71 MILES
NET LENGTH OF PROJECT.....5.71 MILES

CHANGES MADE DURING CONSTRUCTION HAVE BEEN INCORPORATED ON THESE PLANS EXCEPT CHANGES IN THE ORIGINAL THEORETICAL QUANTITIES. FOR ACTUAL QUANTITIES, REFER TO PROJECT LEDGER AND/OR COMPUTATION BOOK.

AND/OR COMPUTATION BOOK.

Alan M. M. M. 7/19/16
RESIDENT ENGINEER DATE

DEPARTMENT OF TRANSPORTATION
STATE OF HAWAII

APPROVED: _____
James M. Gossin \$-26.04
 for DIR. OF TRANSPORTATION DATE

HWY-M	HWY-ME	873-3535	FEB., 2004
DESIGNED BY	MANAGED BY	PHONE	DATE