

INDEX TO DRAWINGS	
SHEET NO.	DESCRIPTION
1	TITLE SHEET
2	LAYOUT PLANS
3	STANDARD PLANS SUMMARY
4	TYPICAL ACCELERATION AND DECELERATION LANE MARKINGS
5	PAVEMENT MARKING LEGEND, DETAILS AND GENERAL NOTES
6 - 19	SIGNING AND PAVEMENT MARKING PLANS - WORK AREA NO.1
20 - 34	SIGNING AND PAVEMENT MARKING PLANS - WORK AREA NO.3
35 - 36	RAISED PAVEMENT MARKERS AND STRIPING SUMMARY

STATE OF HAWAII

DEPARTMENT OF TRANSPORTATION

HIGHWAYS DIVISION

HONOLULU, HAWAII

"AS-BUILT"

PLANS FOR

HALEAKALA HIGHWAY,  
HANA HIGHWAY AND MOKULELE HIGHWAY



PAVEMENT MARKING AND STRIPING

PROJECT NO. HWY-M-04-99M

DISTRICTS OF MAKAWAO AND WAILUKU

ISLAND OF MAUI

FED. ROAD DIST. NO.	STATE	PROJ. NO.	FISCAL YEAR	SHEET NO.	TOTAL SHEETS
HAWAII	HAW.	HWY-M-04-99M	1999	1	36

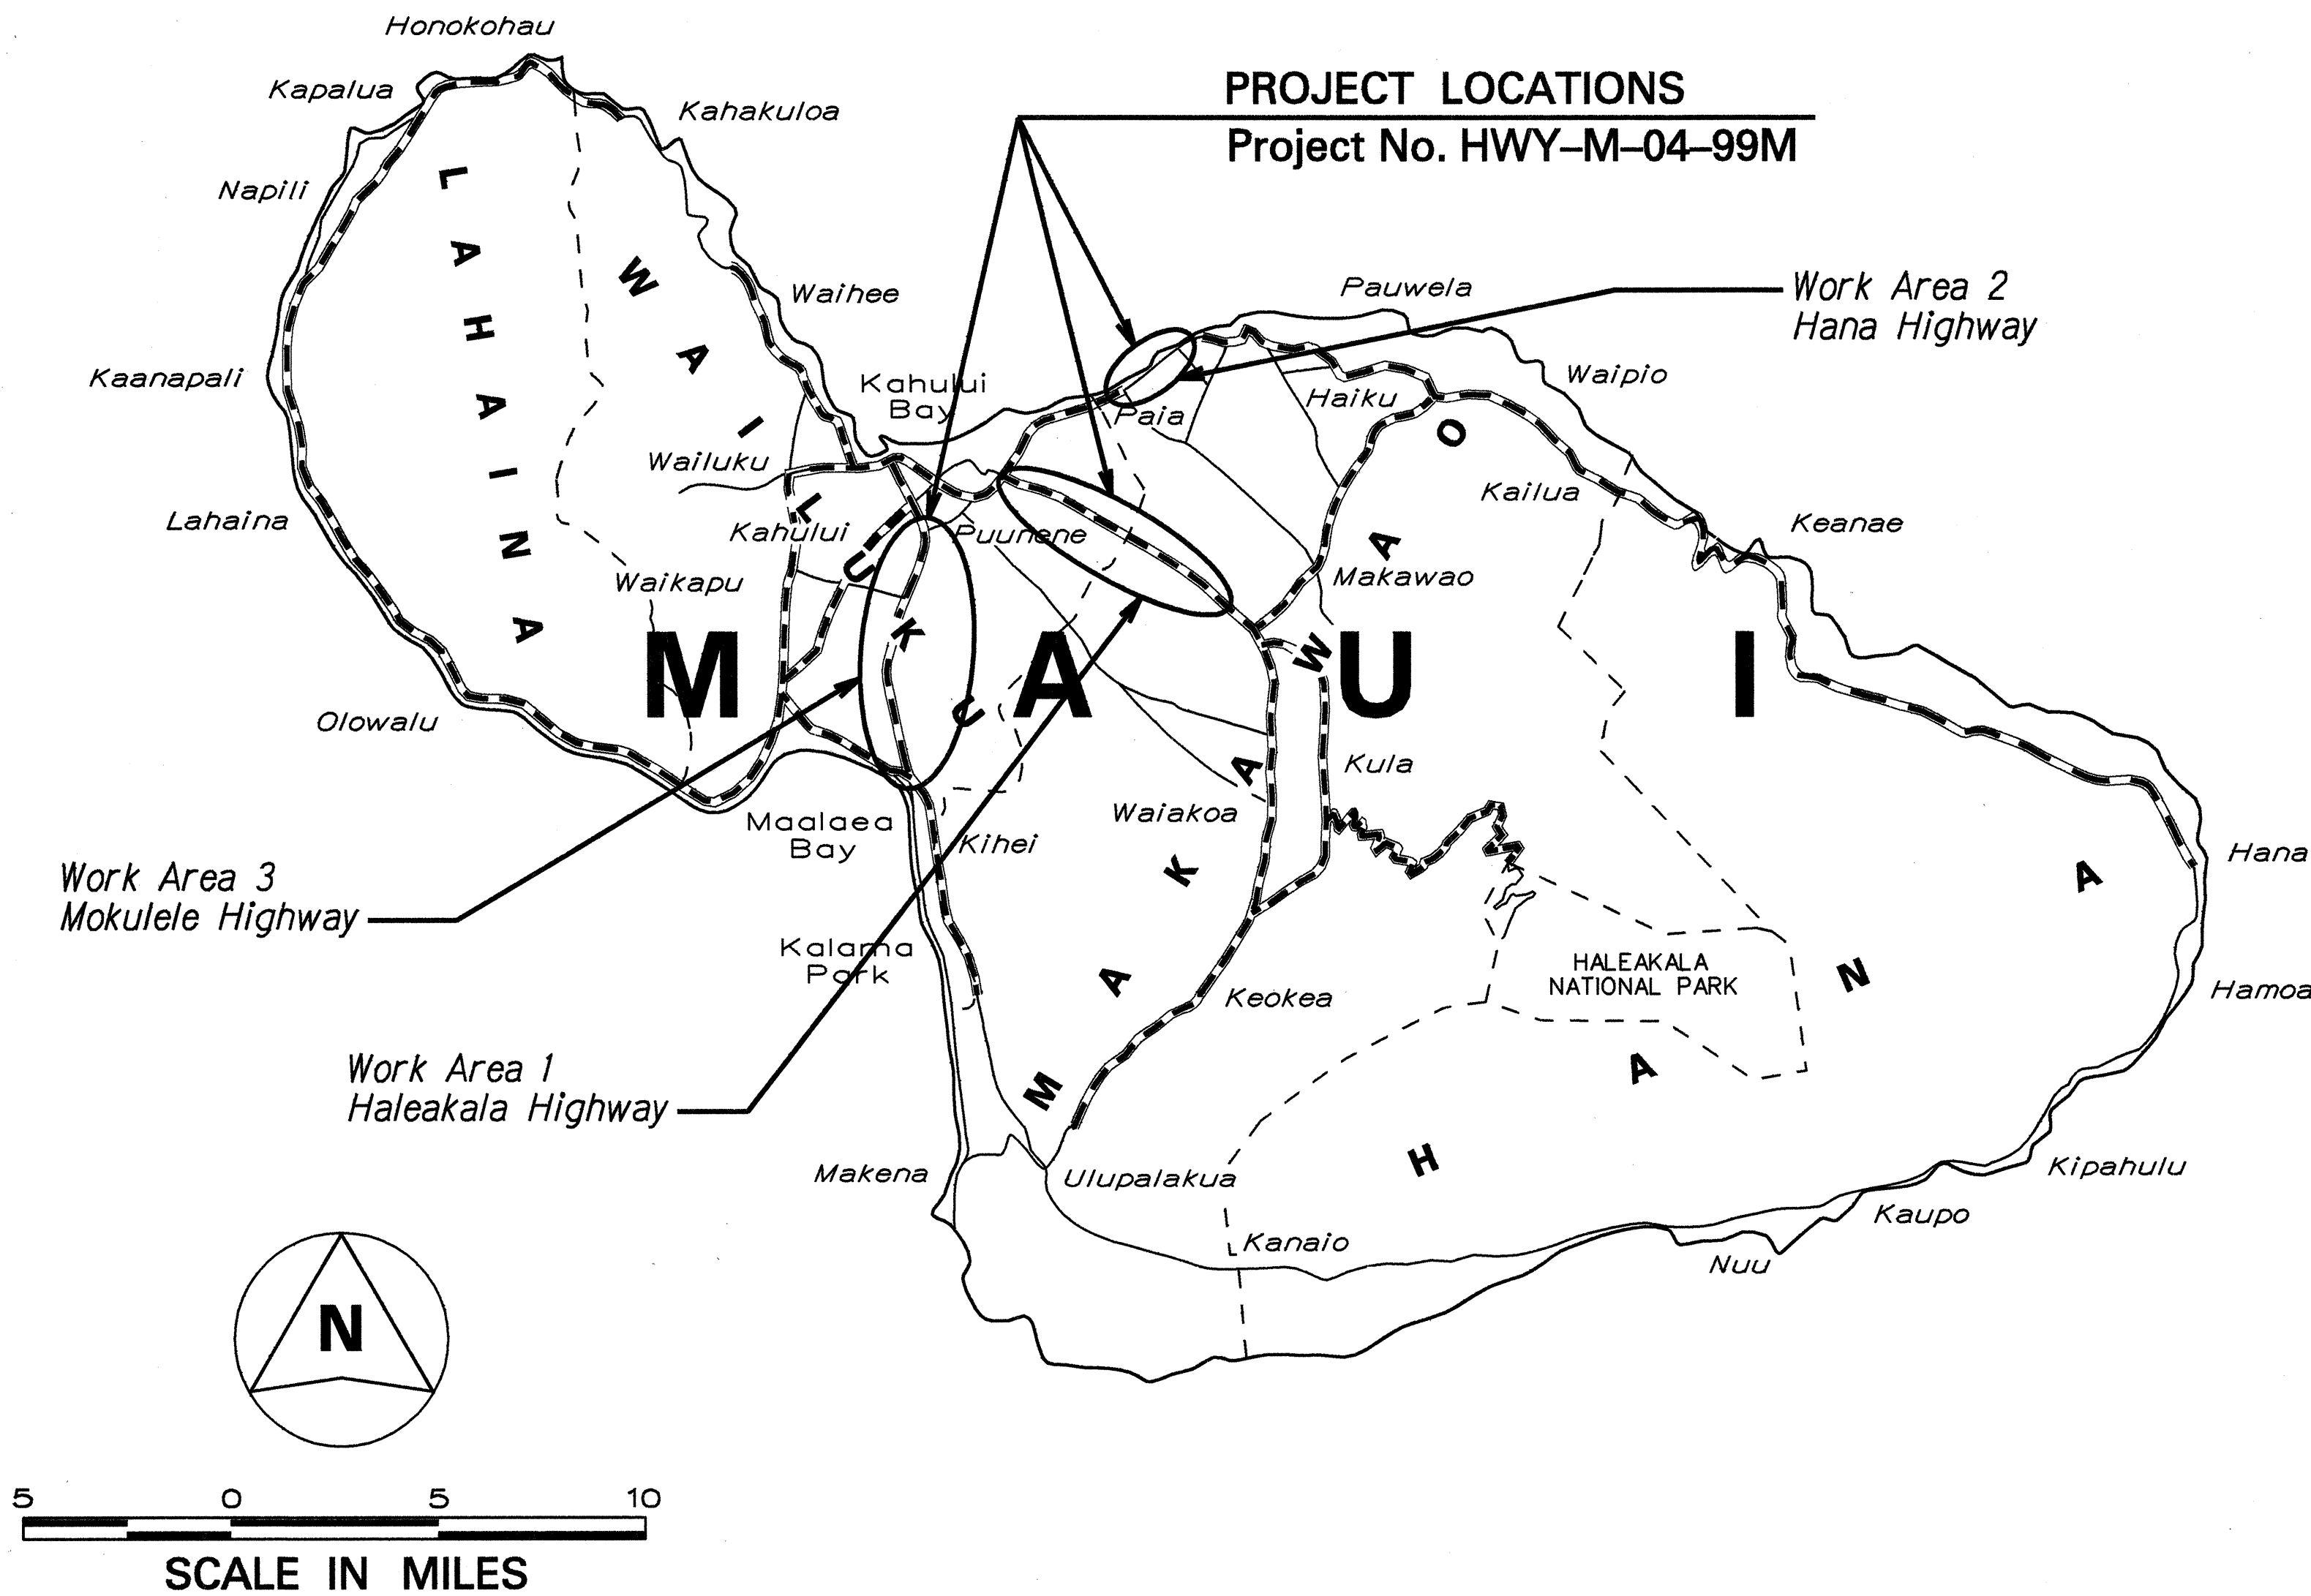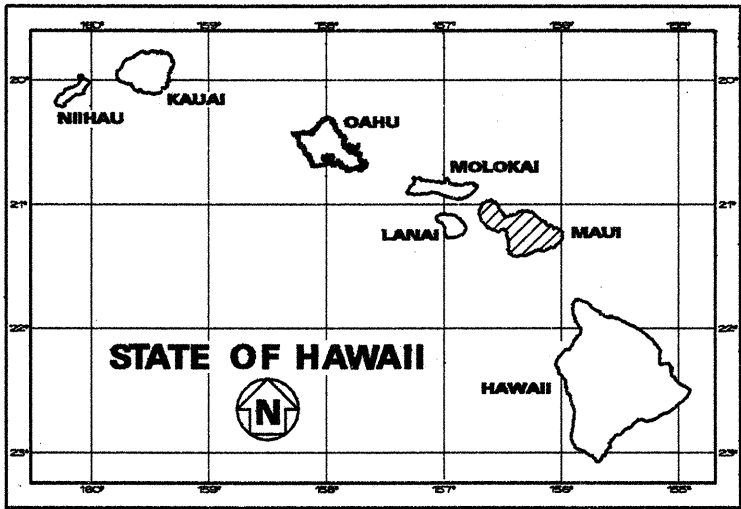

----- FEDERAL AID PROJECTS PREVIOUSLY CONSTRUCTED OR UNDER CONSTRUCTION

HALEAKALA HIGHWAY MILE POST 0.00 TO MILE POST 5.60  
HANA HIGHWAY MILE POST 6.58 TO MILE POST 8.82  
MOKULELE HIGHWAY MILE POST 0.67 TO MILE POST 6.50

CHANGES MADE DURING CONSTRUCTION HAVE BEEN INCORPORATED ON THESE PLANS EXCEPT CHANGES IN THE ORIGINAL THEORETICAL QUANTITIES. FOR ACTUAL QUANTITIES, REFER TO PROJECT LEDGER AND/OR COMPUTATION BOOK.

*Michael K. Brown* 8-29-2000  
RESIDENT ENGINEER DATE

DEPARTMENT OF TRANSPORTATION STATE OF HAWAII	
APPROVED:	
<i>Kay K. Kamehaha</i>	4/13/99
DIR. OF TRANSPORTATION	DATE

HWY-M DESIGNED BY JULIUS B. FRONDA 692-7572 JAN., 1999  
P.S. & E. BY PHONE DATE