
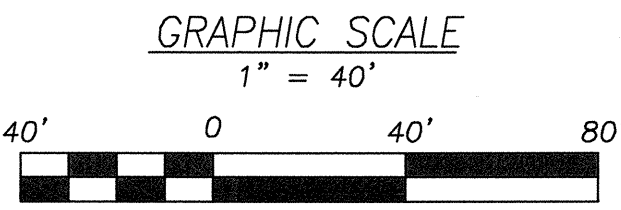
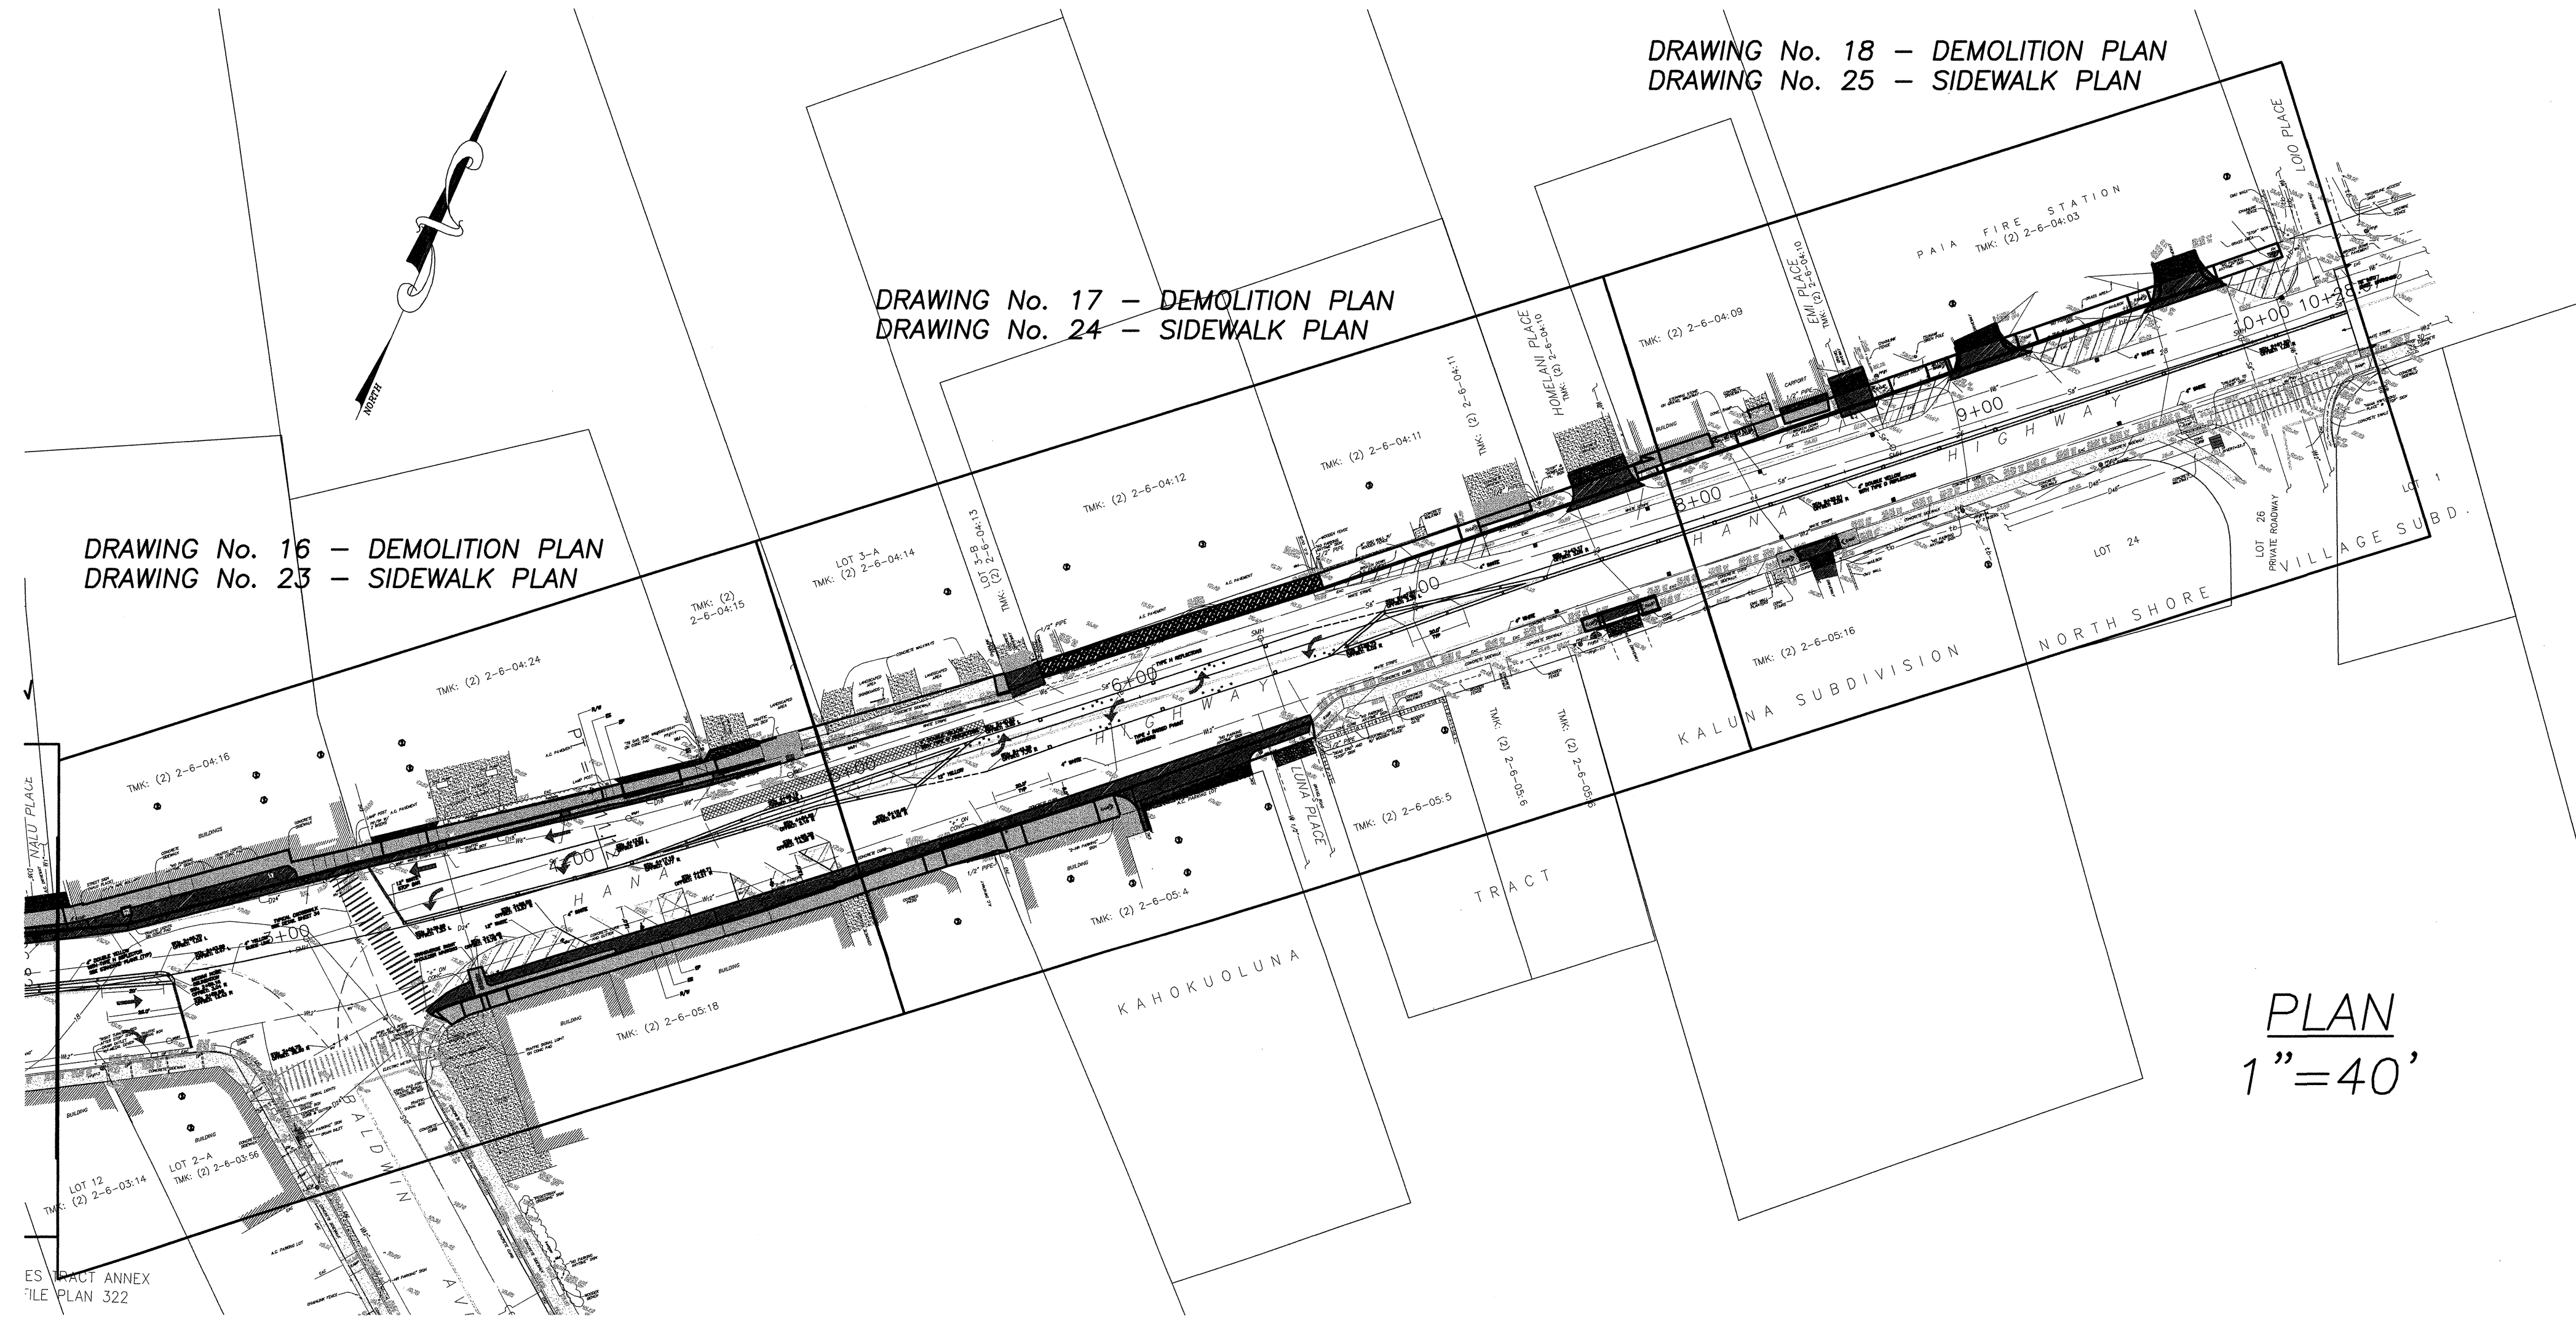


FED. ROAD DIST. NO.	STATE	PROJ. NO.	FISCAL YEAR	SHEET NO.	TOTAL SHEETS
HAWAII	HAW.	36AB-02-04M	2005	11	48

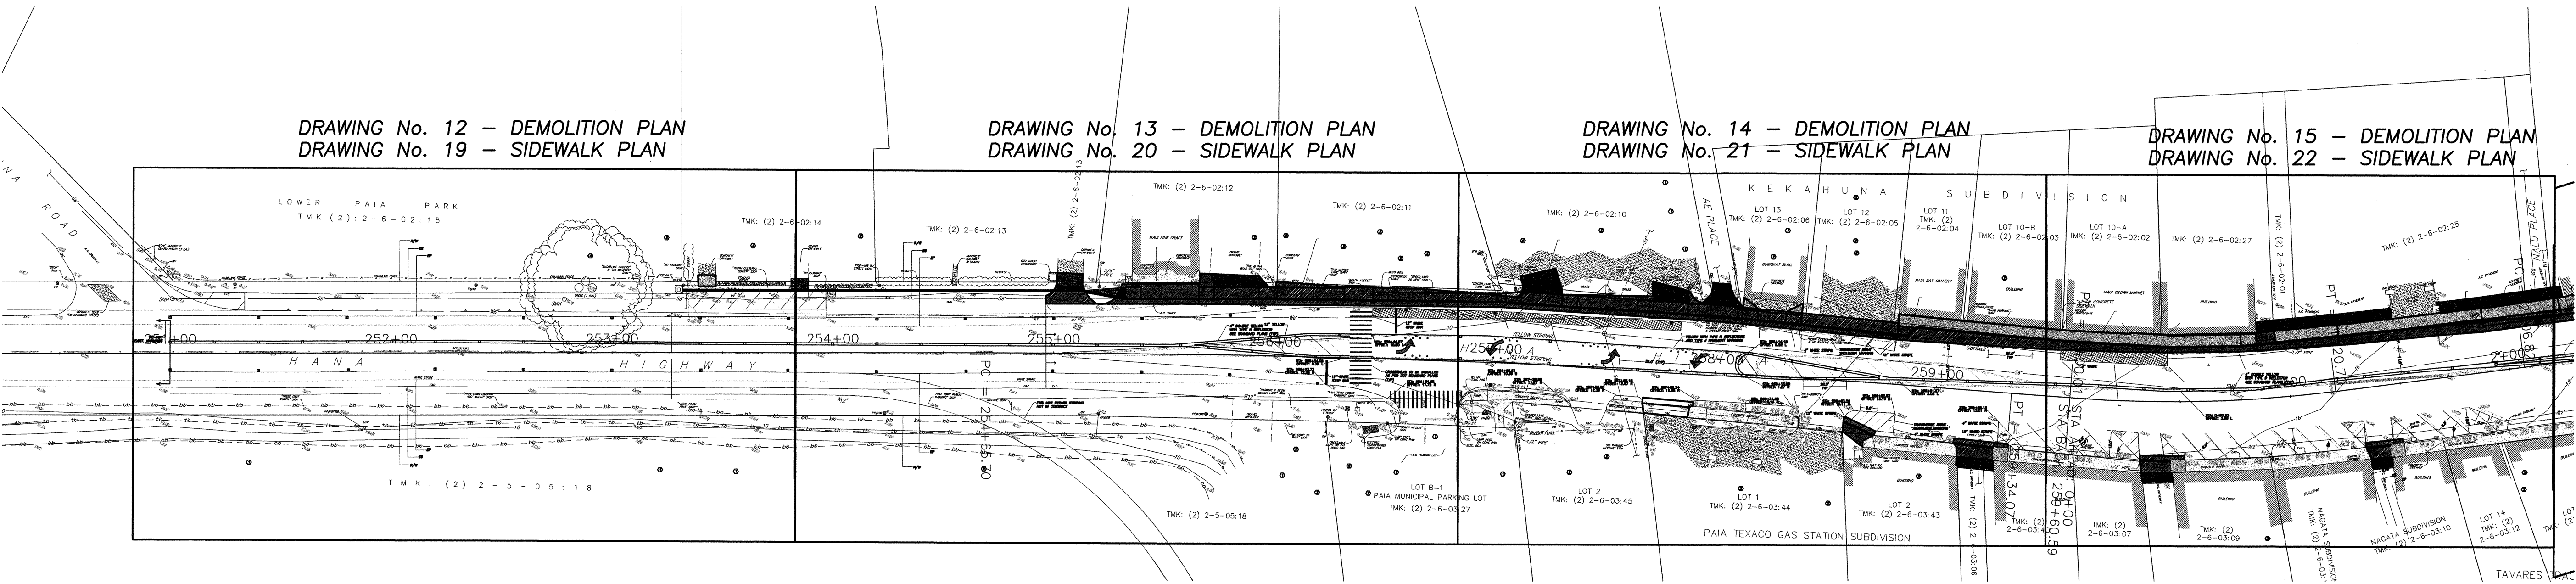

NEAL S. FUKUMOTO
LICENSED PROFESSIONAL ENGINEER
No. 6186-C
HAWAII U.S.A.

STATE OF HAWAII
DEPARTMENT OF TRANSPORTATION
HIGHWAYS DIVISION

OVERALL SITE PLAN

ROUTE 36, HANA HIGHWAY RESURFACING
HALEAKALA HWY TO HOOKIPA PARK
PAIA TOWN SECTION

Project No. 36AB-02-04M
Scale: As Shown Date: MAY 2005

SHEET No. 1 OF 1 SHEETS

ORIGINAL PLAN	SURVEY PLOTTED BY	DATE
NO. _____	_____	_____
	DRAWN BY	_____
	CHECKED BY	_____
	QUANTITIES BY	_____
	CHECKED BY	_____