



FED. ROAD DIST. NO.	STATE	PROJ. NO.	FISCAL YEAR	SHEET NO.	TOTAL SHEETS
HAWAII	HAW.	36AB-02-04M	2005	27	48

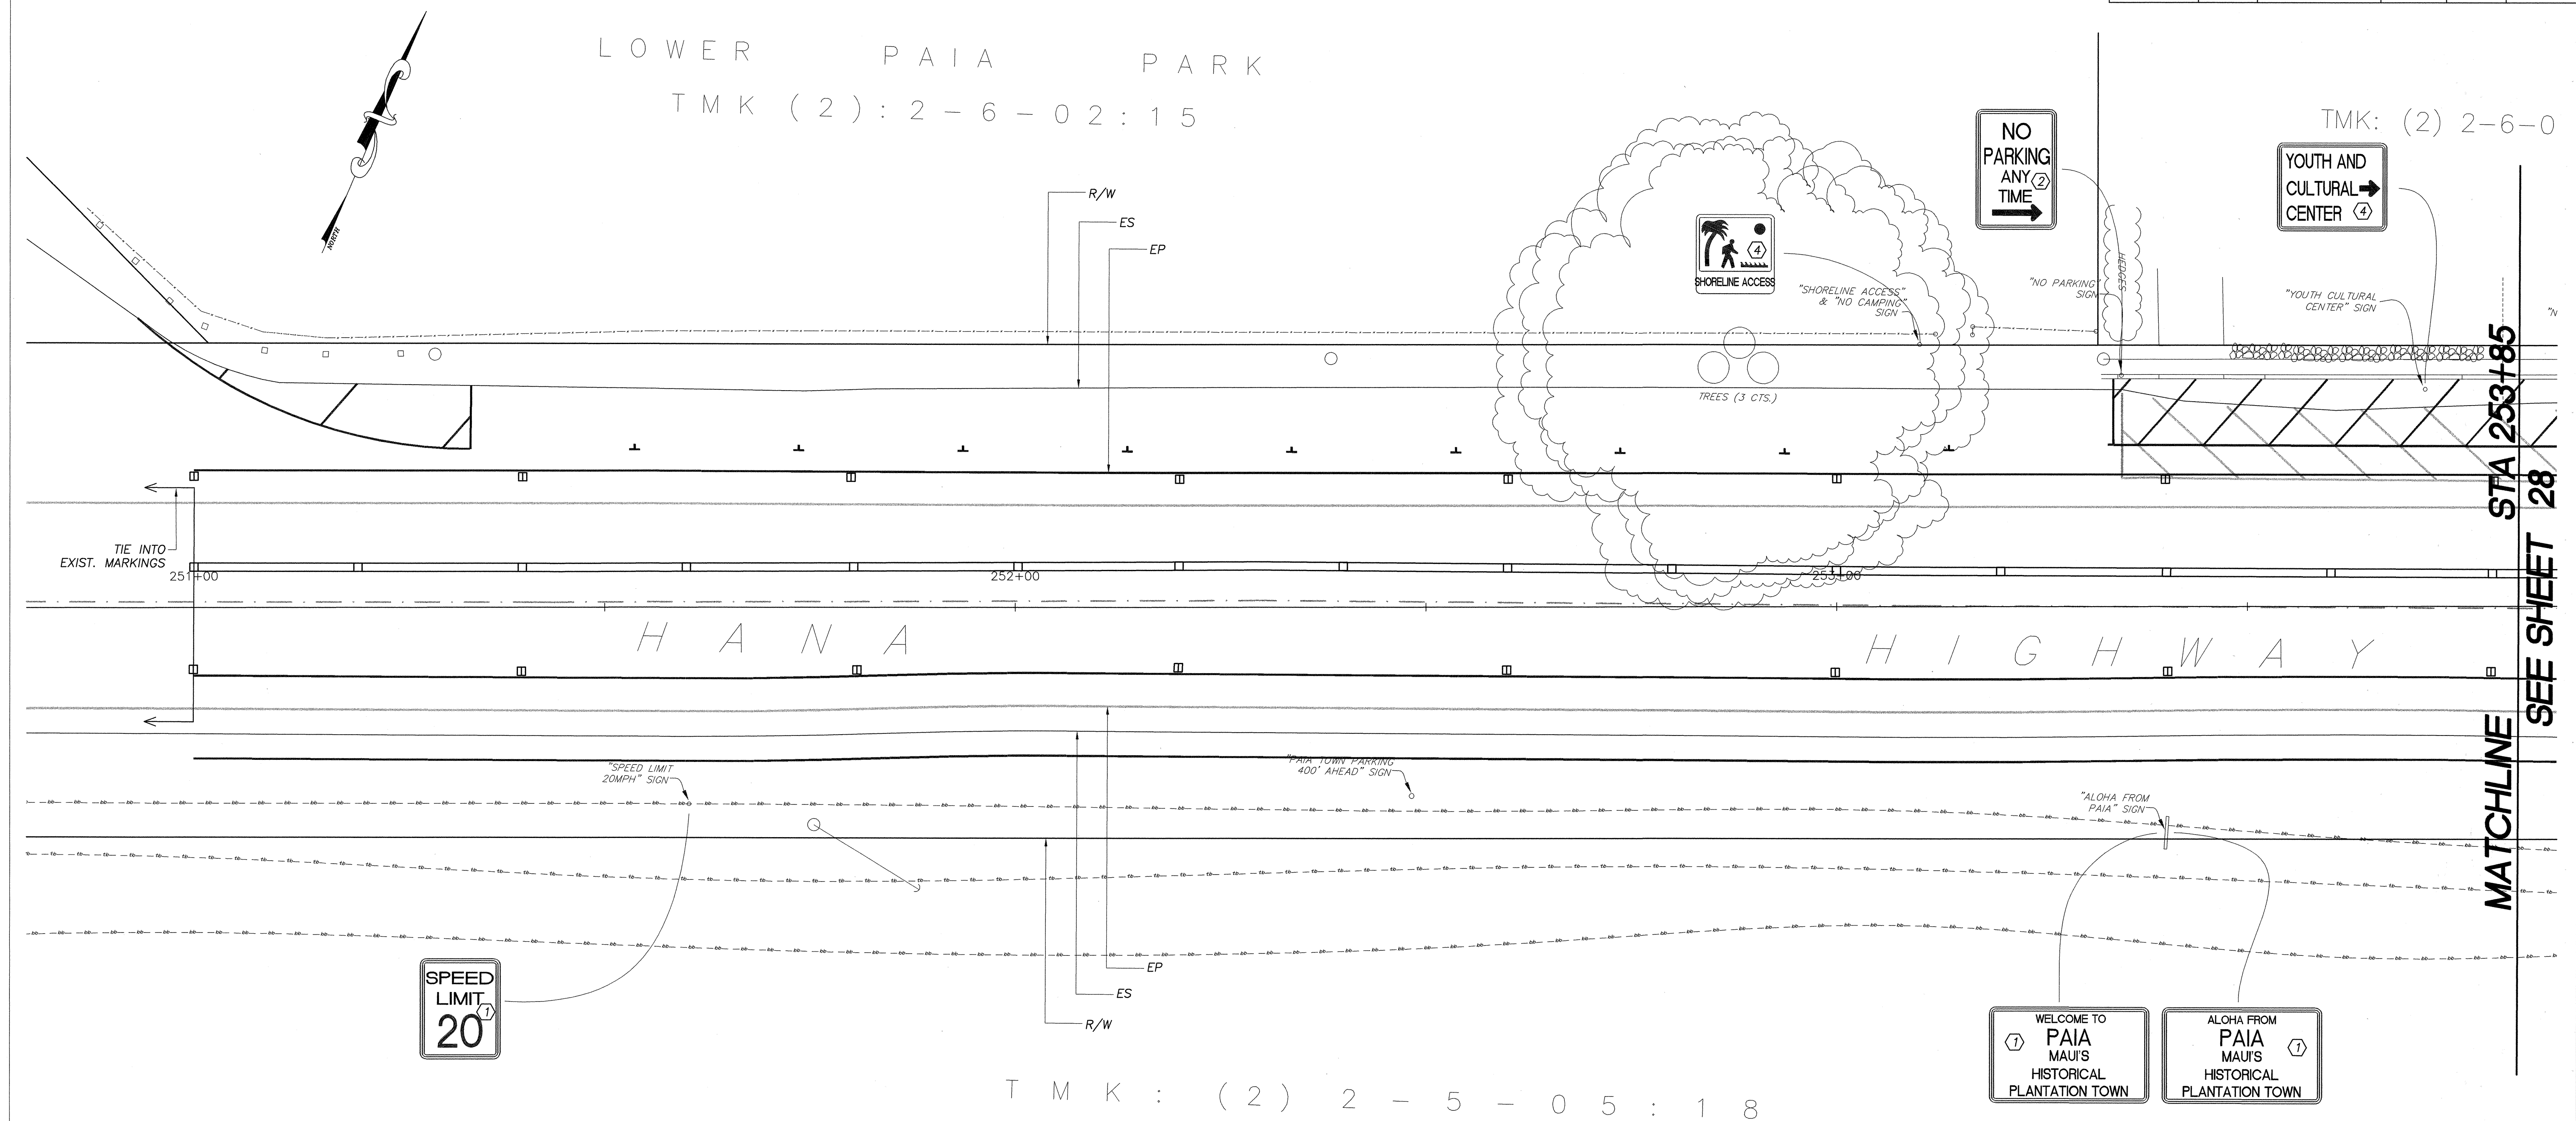

PLAN
1" = 10'

SIGN KEY

- 1 Existing Sign and Post(s) to Remain
- 2 Remove Existing Sign and Post and Replace with New
- 3 Install New Sign(s) w/Post(s) and RM-3(s) (If Required)
- 4 Relocate Existing Sign and Post

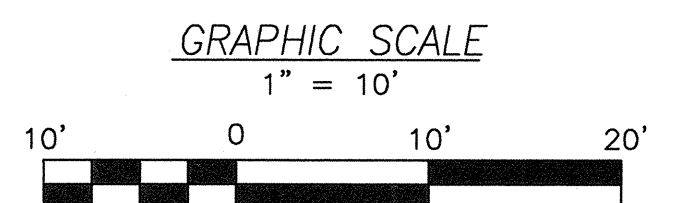


NEAL S. FUKUNOTO
LICENSED PROFESSIONAL ENGINEER
No. 6186-C
HAWAII U.S.A.

THIS WORK WAS PREPARED BY ME OR UNDER MY SUPERVISION
April 30, 2006
EXPIRATION DATE OF THE LICENSE

STATE OF HAWAII
DEPARTMENT OF TRANSPORTATION
HIGHWAYS DIVISION
STRIPING PLAN
START TO STA 256+83
ROUTE 36, HANA HIGHWAY RESURFACING
HALEAKALA HWY TO HOOKIPA PARK
PAIA TOWN SECTION
Project No. 36AB-02-04M
Scale: As Shown Date: MAY 2005
SHEET No. 1 OF 7 SHEETS

SURVEY PLOTTED BY	DATE
DRAWN BY	
DESIGNED BY	
NOTED BY	
CHECKED BY	
ORIGINAL PLAN	
NOTE BOOK	
No.	


FED. ROAD DIST. NO.	STATE	PROJ. NO.	FISCAL YEAR	SHEET NO.	TOTAL SHEETS
HAWAII	HAW.	36AB-02-04M	2005	28	48

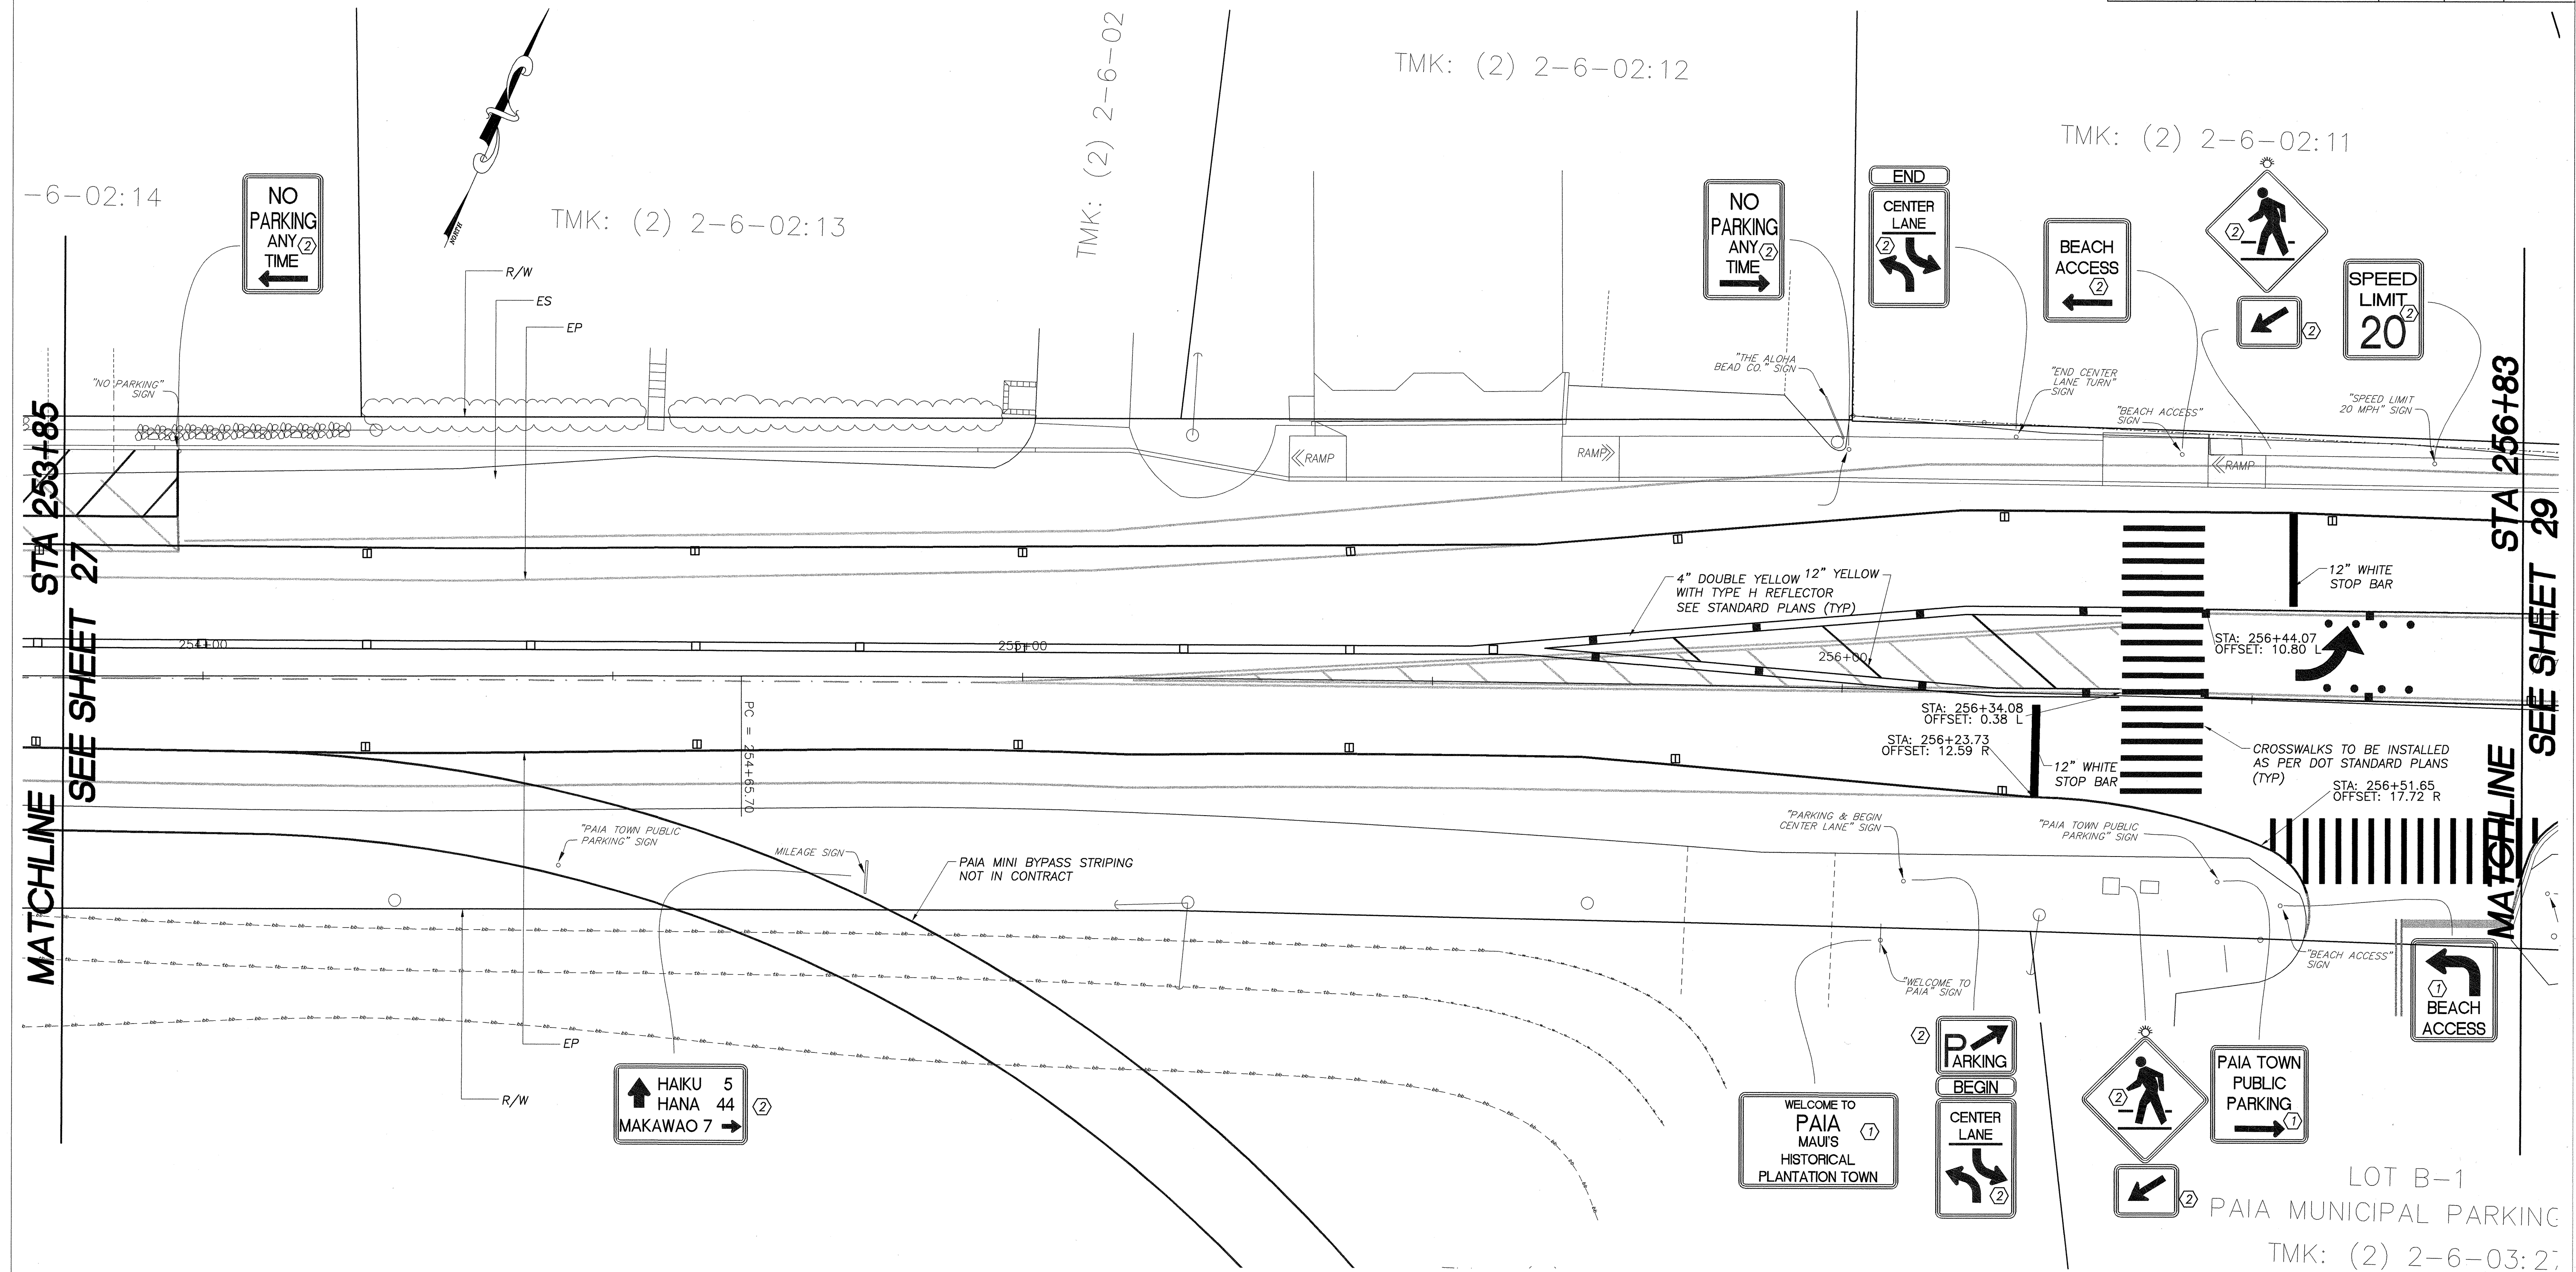

SIGN KEY

- 1 Existing Sign and Post(s) to Remain
- 2 Remove Existing Sign and Post and Replace with New
- 3 Install New Sign(s) w/Post(s) and RM-3(s) (If Required)
- 4 Relocate Existing Sign and Post

PLAN
1" = 10'

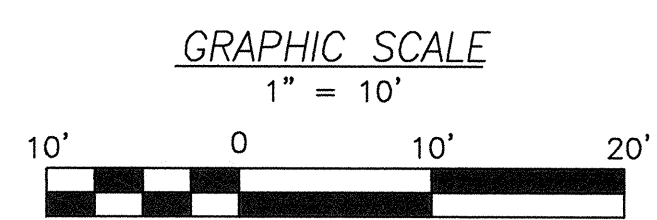

NEAL S. FUKUMOTO
LICENSED PROFESSIONAL ENGINEER
No. 6186-C
HAWAII U.S.A.

STATE OF HAWAII
DEPARTMENT OF TRANSPORTATION
HIGHWAYS DIVISION

STRIPING PLAN
STA 253+83 TO STA 256+83
ROUTE 36, HANA HIGHWAY RESURFACING
HALEAKALA HWY TO HOOKIPA PARK
PAIA TOWN SECTION


Project No. 36AB-02-04M
Scale: As Shown Date: MAY 2005

APR 30, 2006
THIS WORK WAS PREPARED BY ME OR UNDER MY SUPERVISION
EXPIRATION DATE OF THE LICENSE

SHEET No. 2 OF 7 SHEETS


SURVEY PLOTTED BY	DATE
DRAWN BY	
CHECKED BY	
NOTE BOOK	
QUANTITIES BY	
CHECKED BY	
No.	

FED. ROAD DIST. NO.	STATE	PROJ. NO.	FISCAL YEAR	SHEET NO.	TOTAL SHEETS
HAWAII	HAW.	36AB-02-04M	2005	29	48

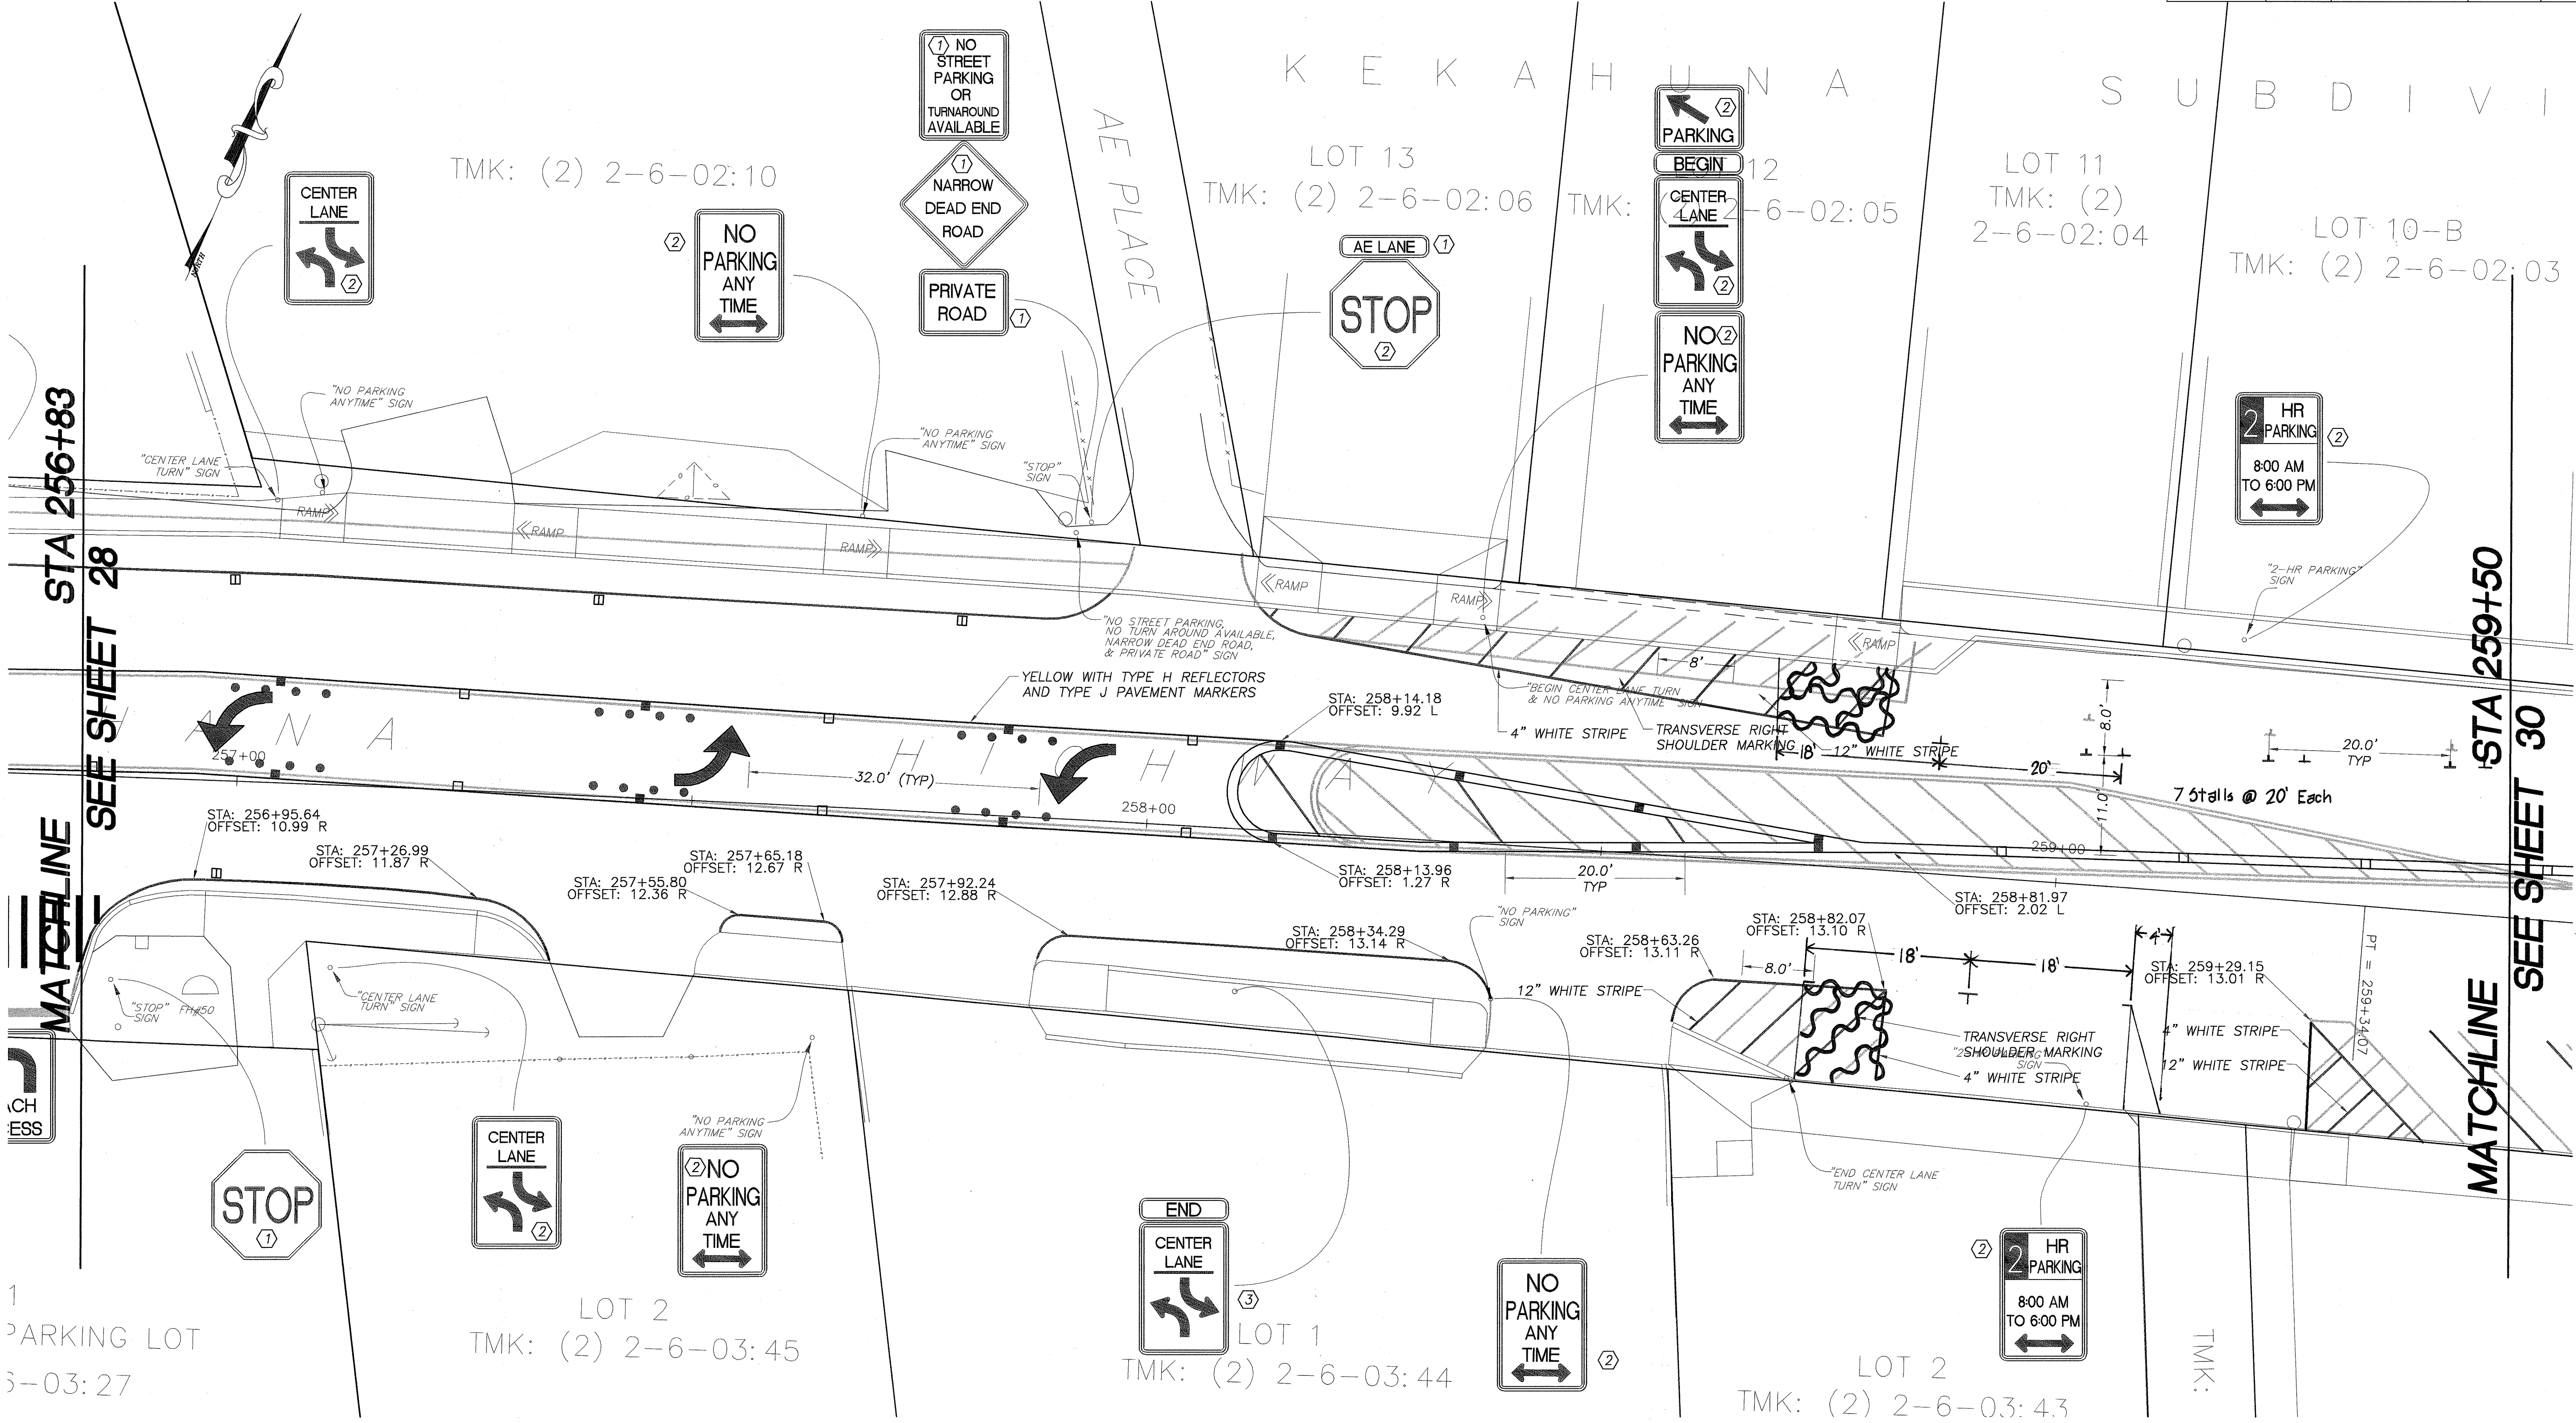

- SIGN KEY**
- 1 Existing Sign and Post(s) to Remain
 - 2 Remove Existing Sign and Post and Replace with New
 - 3 Install New Sign(s) w/Post(s) and RM-3(s) (If Required)
 - 4 Relocate Existing Sign and Post



PLAN
1" = 10'

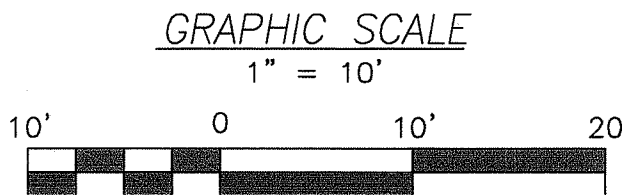


NEAL S. FUKUDA
LICENSED PROFESSIONAL ENGINEER
No. 6186-C
HAWAII U.S.A.

STATE OF HAWAII
DEPARTMENT OF TRANSPORTATION
HIGHWAYS DIVISION
STRIPING PLANS
STA 256+83 TO STA 259+50
ROUTE 36, HANA HIGHWAY RESURFACING
HALEAKALA HWY TO HOOKIPA PARK
PAIA TOWN SECTION
Project No. 36AB-02-04M
Scale: As Shown Date: MAY 2005
SHEET No. 3 OF 7 SHEETS

FED. ROAD DIST. NO.	STATE	PROJ. NO.	FISCAL YEAR	SHEET NO.	TOTAL SHEETS
HAWAII	HAW.	36AB-02-04M	2005	30	48

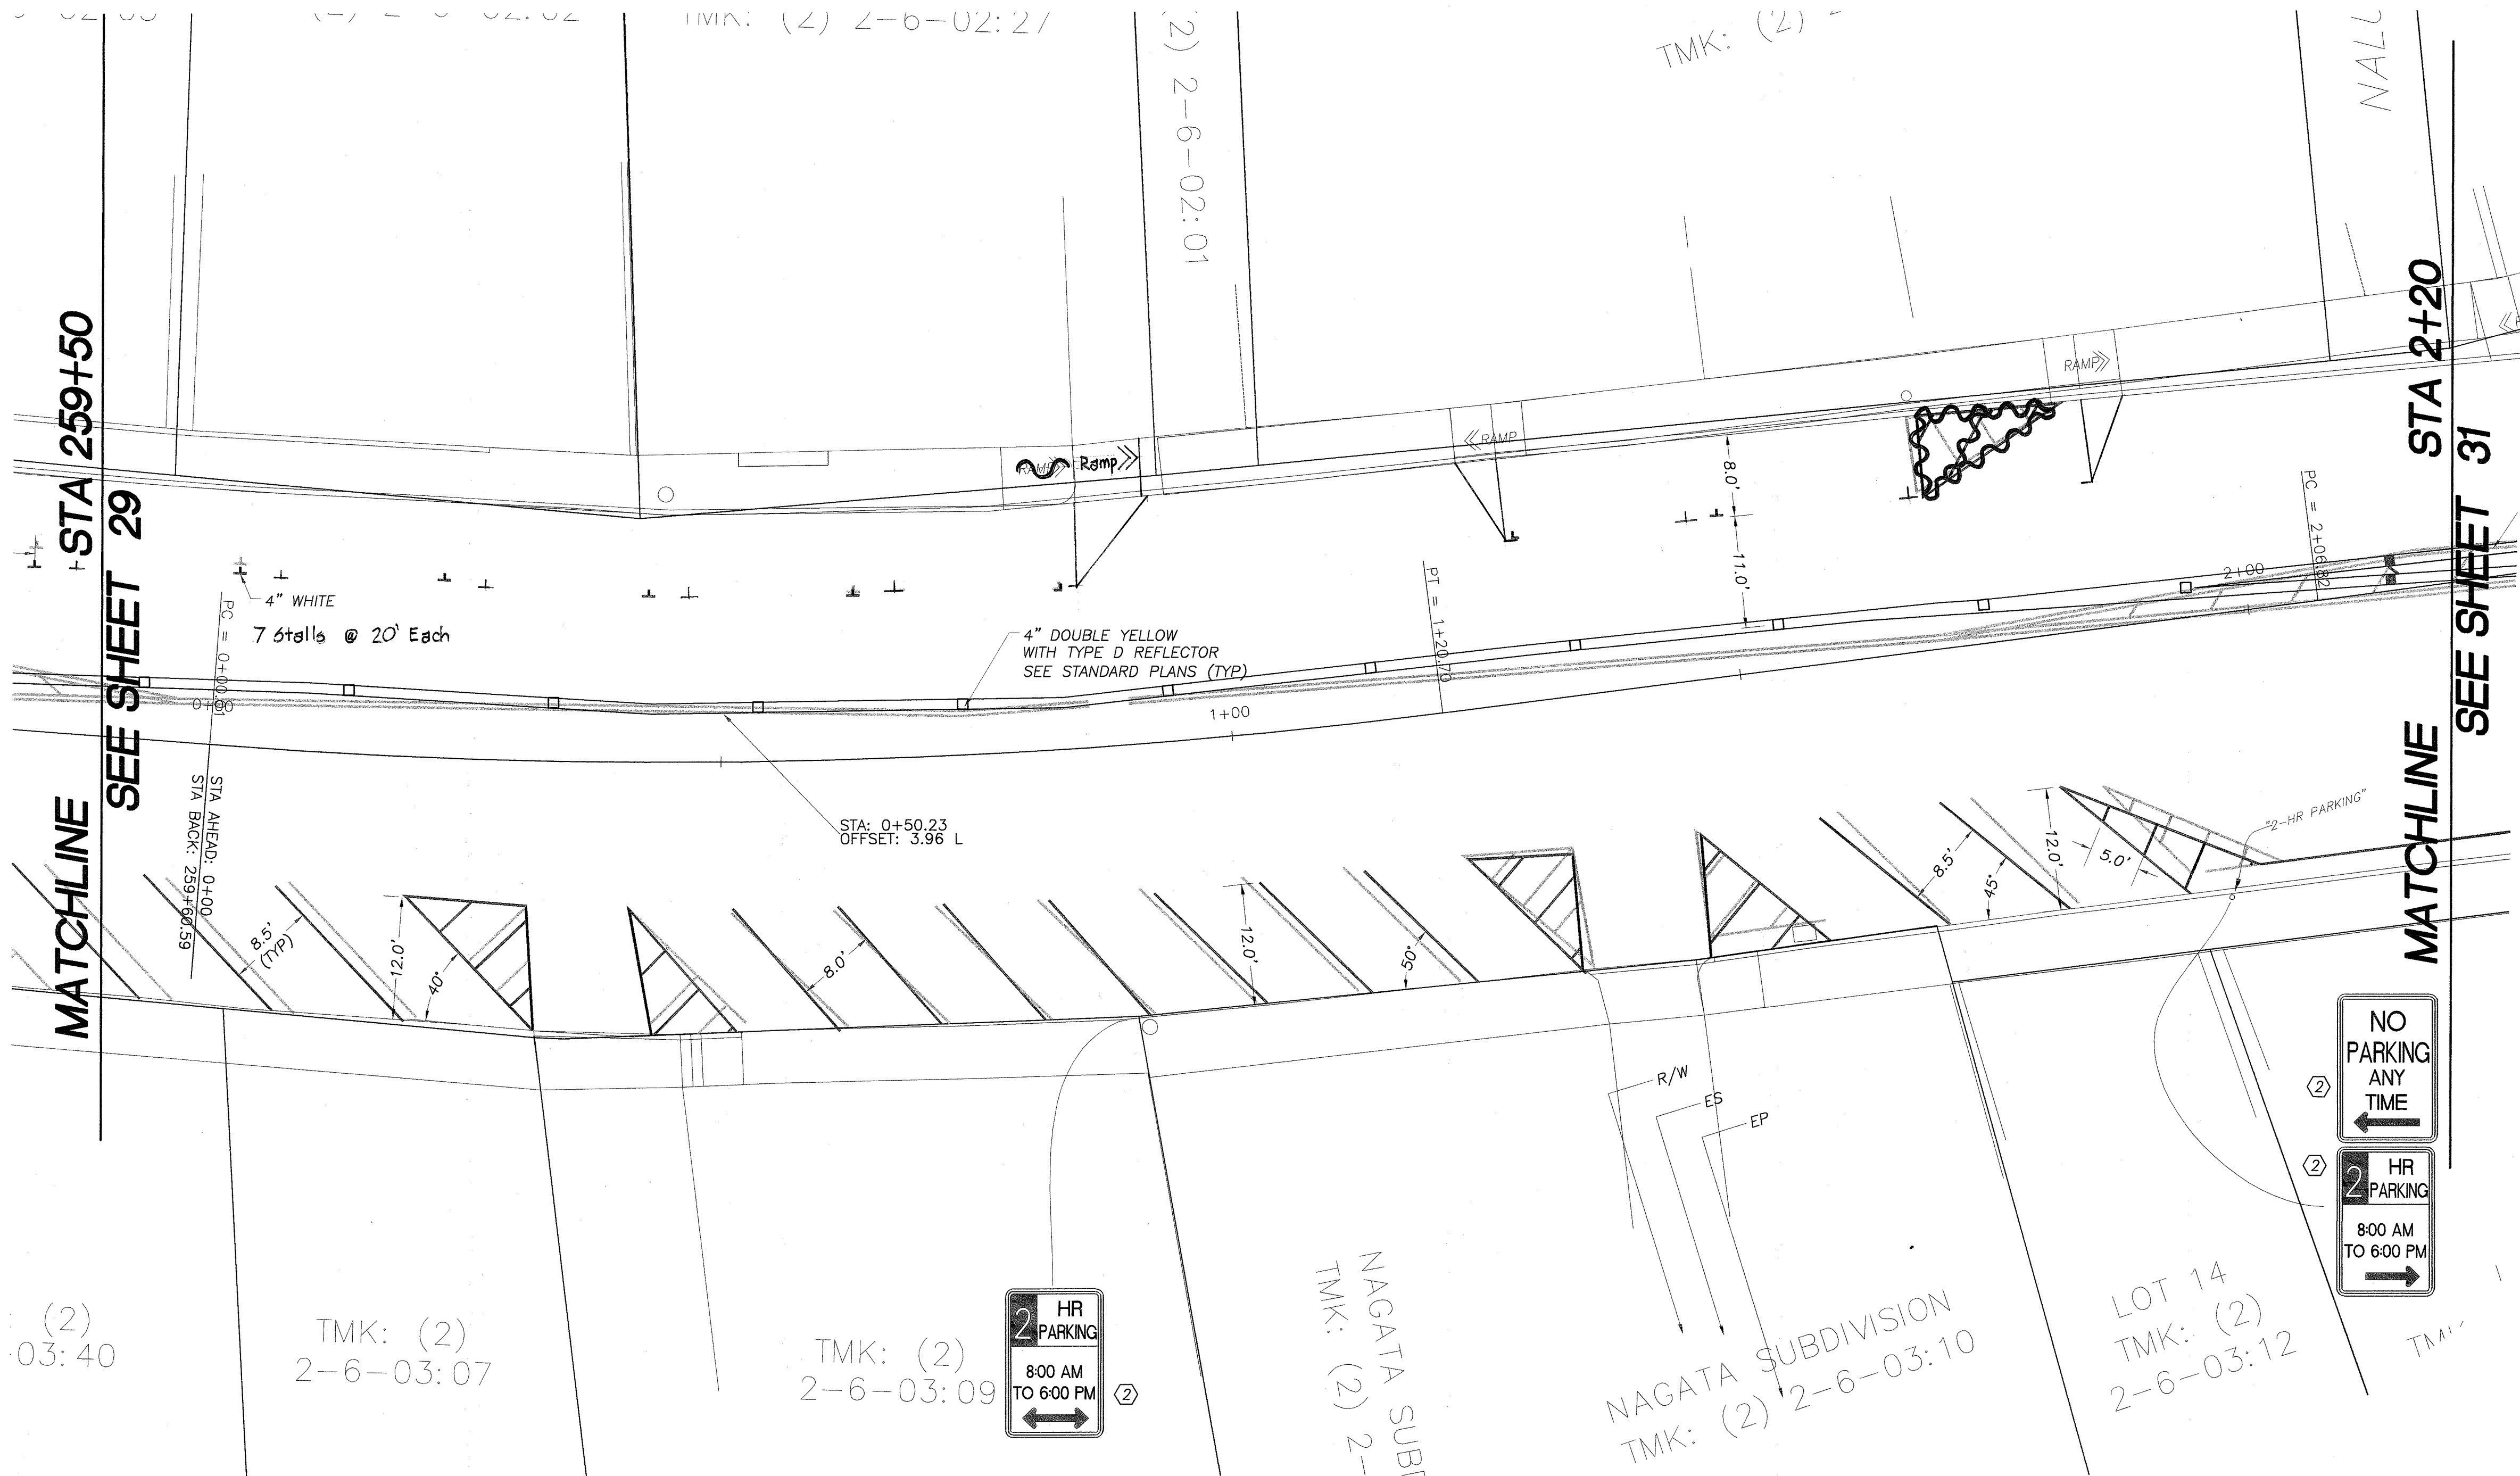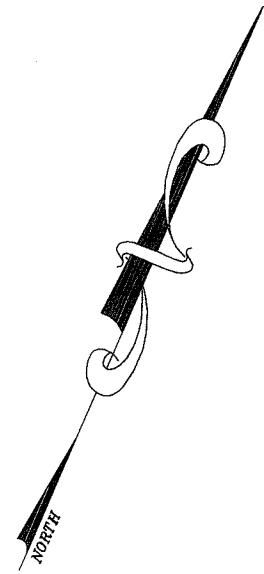


PLAN
1" = 10'

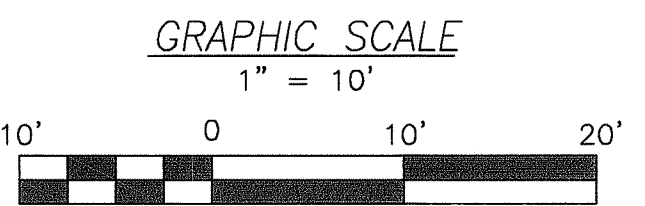

SIGN KEY

- ① Existing Sign and Post(s) to Remain
- ② Remove Existing Sign and Post and Replace with New
- ③ Install New Sign(s) w/Post(s) and RM-3(s) (If Required)
- ④ Relocate Existing Sign and Post

ORIGINAL PLAN	SURVEY PLOTTED BY	DATE
NOTE BOOK	DRAWN BY	
No.	TRACED BY	
	QUANTITIES BY	
	CHECKED BY	

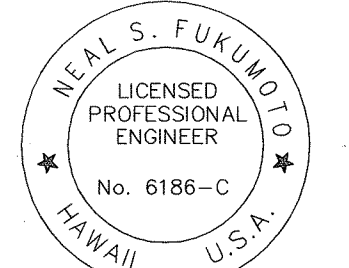

THIS WORK WAS PREPARED BY ME OR UNDER MY SUPERVISION

April 30, 2006

EXPIRATION DATE OF THE LICENSE

STATE OF HAWAII
DEPARTMENT OF TRANSPORTATION
HIGHWAYS DIVISION

STRIPING PLAN

STA 259+50 TO 2+20

ROUTE 36, HANA HIGHWAY RESURFACING

HALEAKALA HWY TO HOOKIPA PARK

PAIA TOWN SECTION

Project No. 36AB-02-04M


Scale: As Shown Date: MAY 2005

SHEET No. 4 OF 7 SHEETS

"AS-BUILT"

30


FED. ROAD DIST. NO.	STATE	PROJ. NO.	FISCAL YEAR	SHEET NO.	TOTAL SHEETS
HAWAII	HAW.	36AB-02-04M	2005	31	48

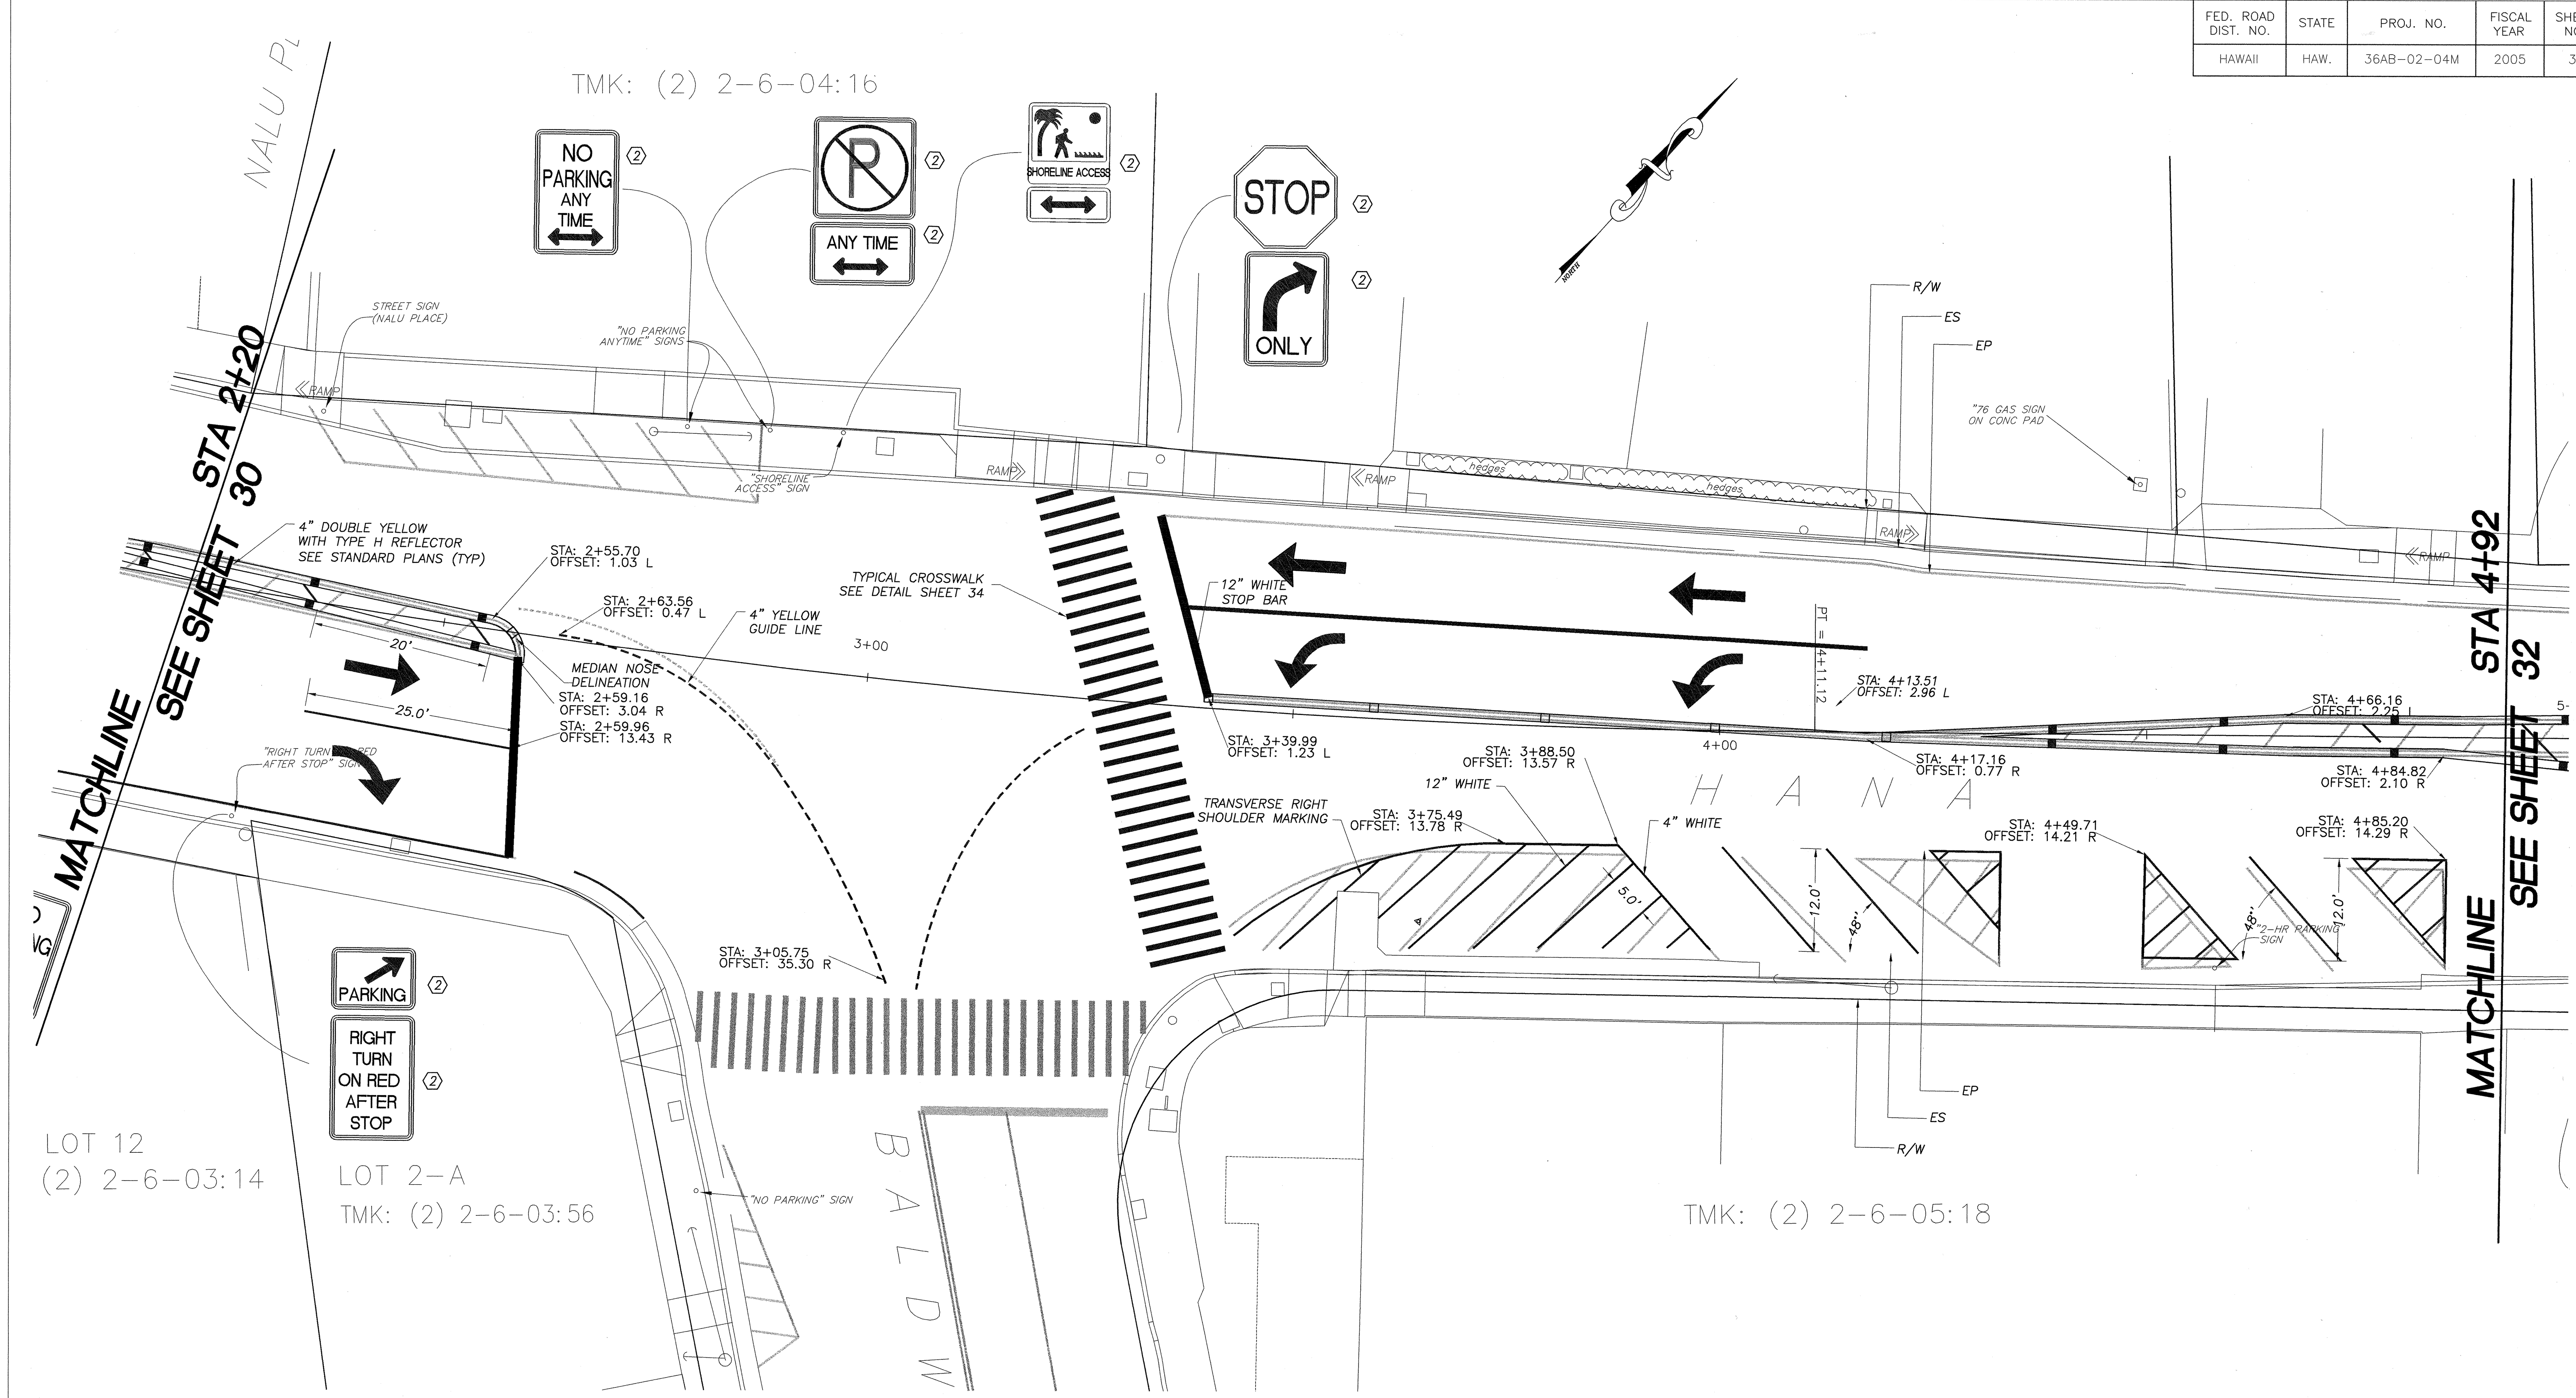

SIGN KEY

- ① Existing Sign and Post(s) to Remain
- ② Remove Existing Sign and Post and Replace with New
- ③ Install New Sign(s) w/Post(s) and RM-3(s) (If Required)
- ④ Relocate Existing Sign and Post

PLAN
1" = 10'

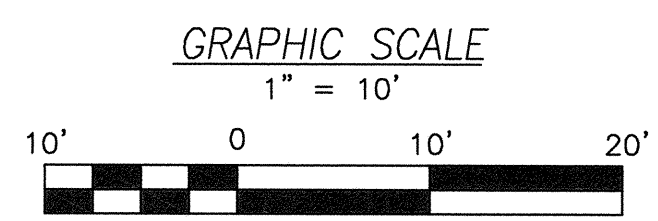

NEAL S. FUKUMOTO
LICENSED PROFESSIONAL ENGINEER
No. 6186-C
HAWAII U.S.A.

THIS WORK WAS PREPARED BY ME OR UNDER MY SUPERVISION
April 30, 2006
EXPIRATION DATE OF THE LICENSE

STATE OF HAWAII
DEPARTMENT OF TRANSPORTATION
HIGHWAYS DIVISION

STRIPING PLAN
STA 2+20 TO 4+92


ROUTE 36, HANA HIGHWAY RESURFACING
HALEAKALA HWY TO HOOKIPA PARK
PAIA TOWN SECTION

Project No. 36AB-02-04M
Scale: As Shown Date: MAY 2005

SHEET No. 5 OF 7 SHEETS

ORIGINAL PLAN	SURVEY PLOTTED BY	DATE
NOTE BOOK	DRAWN BY	
DESIGNED BY	CHECKED BY	
QUANTITIES BY		
CHECKED BY		
No.		

FED. ROAD DIST. NO.	STATE	PROJ. NO.	FISCAL YEAR	SHEET NO.	TOTAL SHEETS
HAWAII	HAW.	36AB-02-04M	2005	32	48

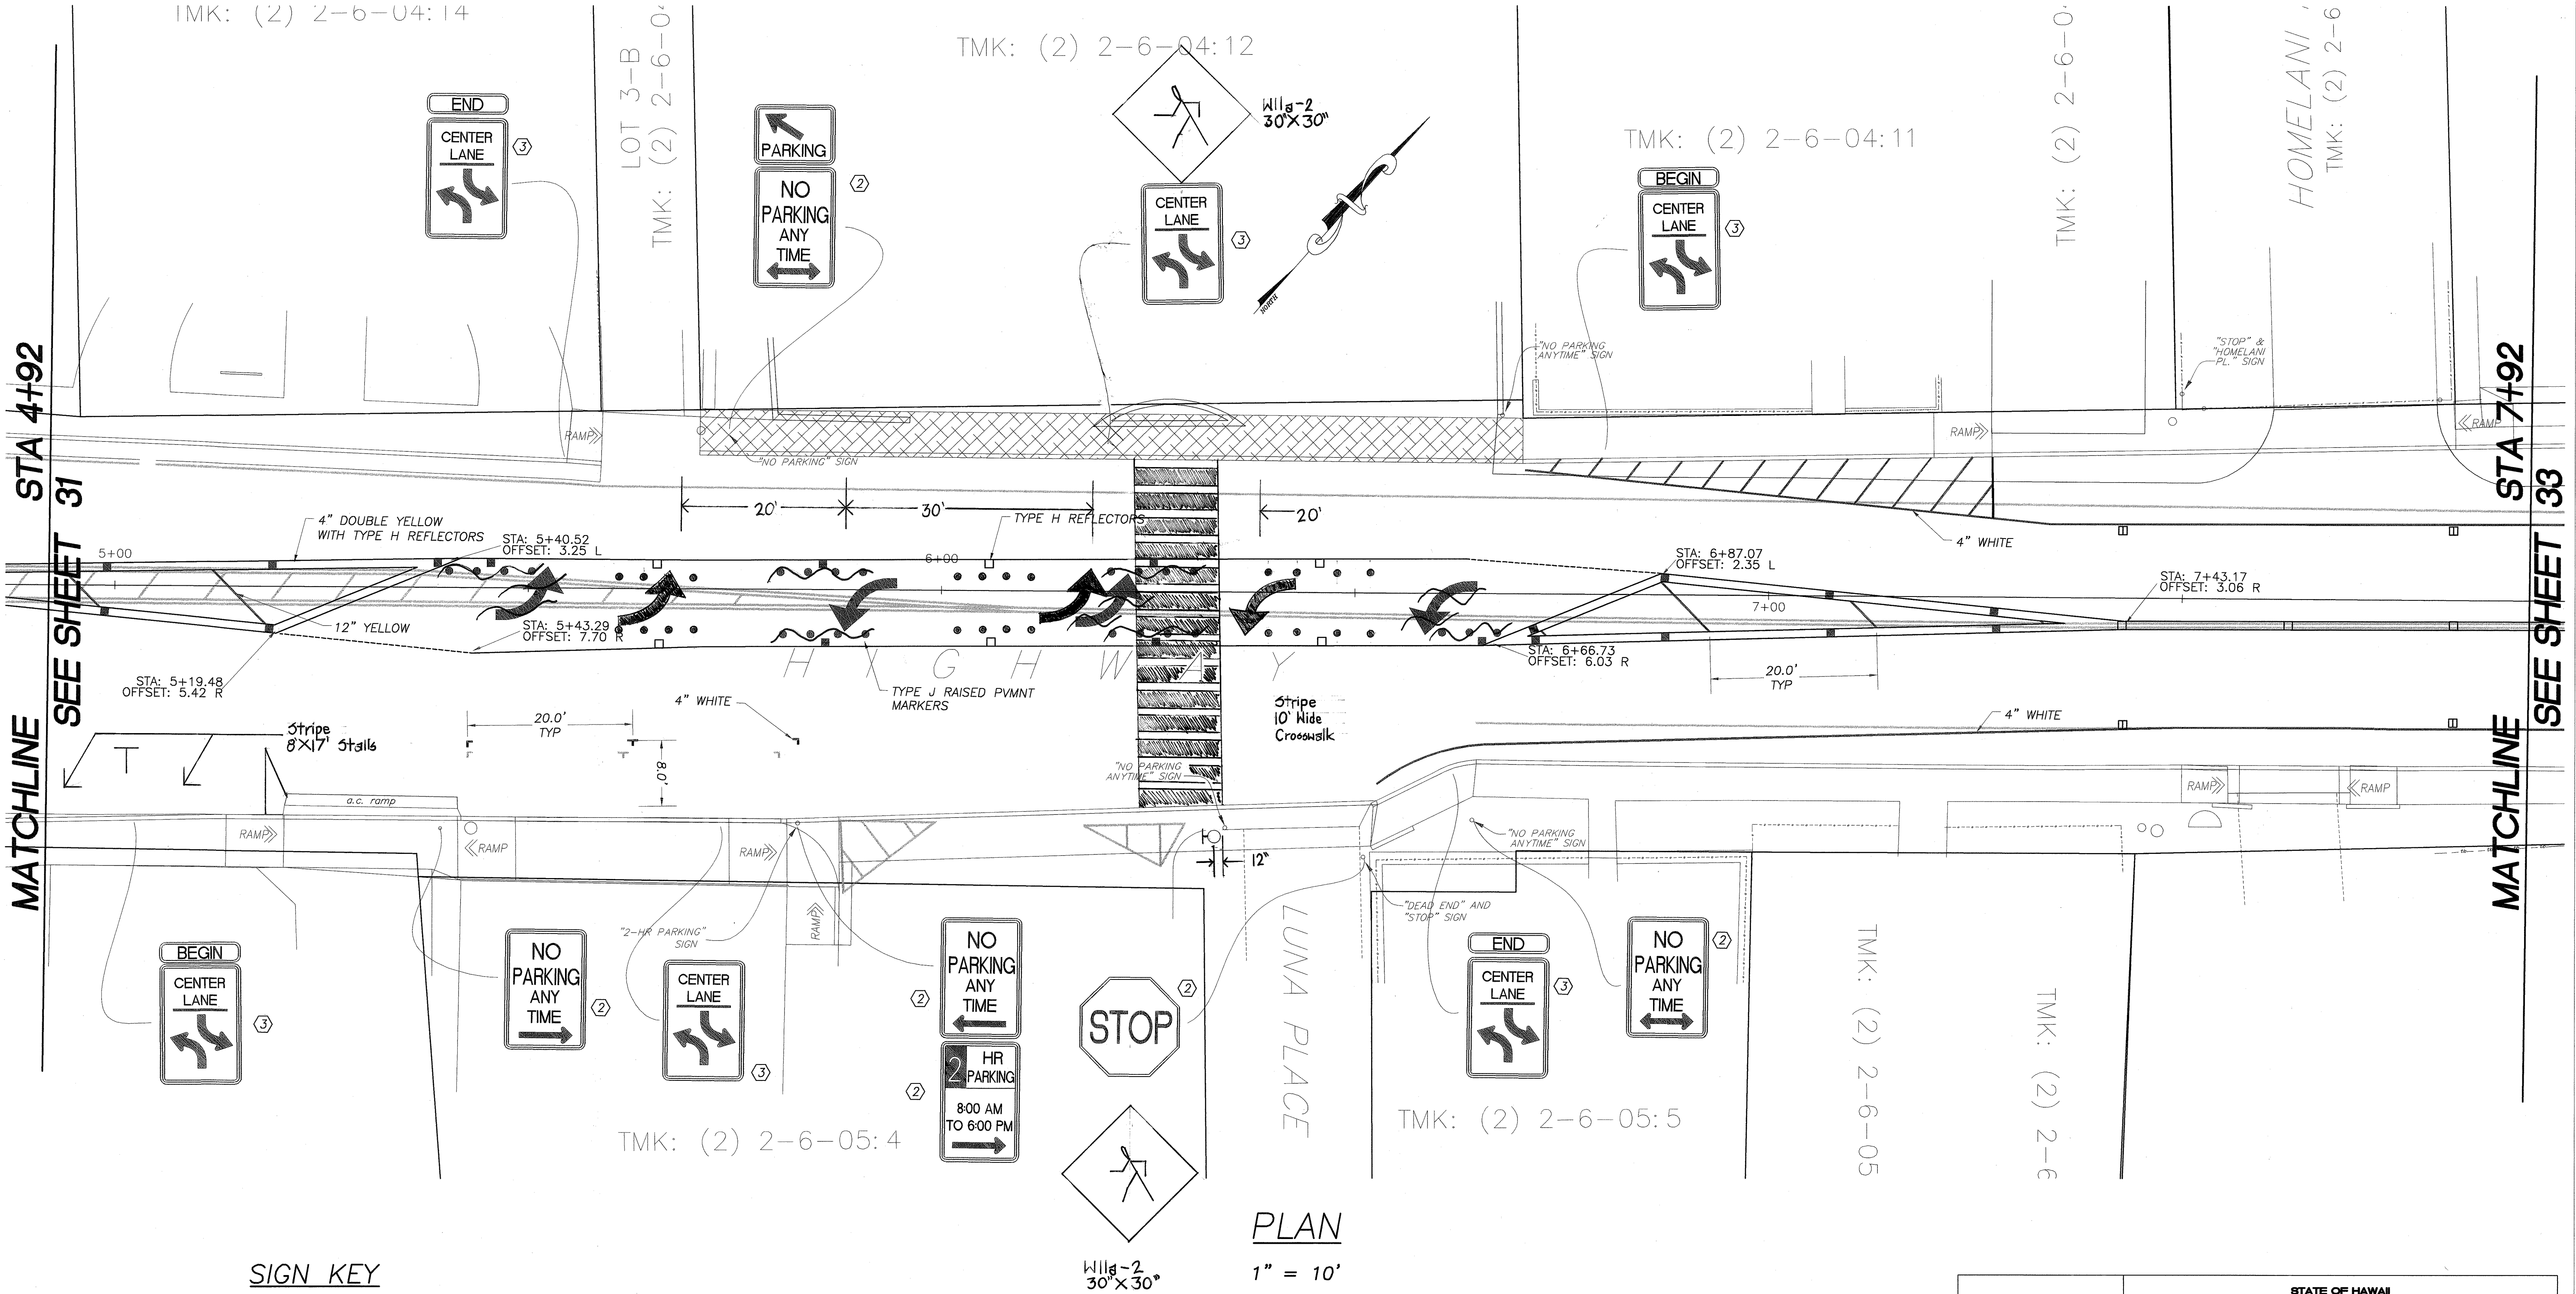

- SIGN KEY**
- ① Existing Sign and Post(s) to Remain
 - ② Remove Existing Sign and Post and Replace with New
 - ③ Install New Sign(s) w/Post(s) and RM-3(s) (If Required)
 - ④ Relocate Existing Sign and Post


GRAPHIC SCALE
1" = 10'

STATE OF HAWAII
DEPARTMENT OF TRANSPORTATION
HIGHWAYS DIVISION
STRIPING PLAN
STA 4+92 TO 7+92
ROUTE 36, HANA HIGHWAY RESURFACING
HALEAKALA HWY TO HOOKIPA PARK
PAIA TOWN SECTION
Project No. 36AB-02-04M
Scale: As Shown Date: MAY 2005
SHEET No. 6 OF 7 SHEETS

32

ORIGINAL PLAN	SURVEY PLOTTED BY	DATE
NOTE BOOK	DRAWN BY	
No.	DESIGNED BY	
	CHECKED BY	

FED. ROAD DIST. NO.	STATE	PROJ. NO.	FISCAL YEAR	SHEET NO.	TOTAL SHEETS
HAWAII	HAW.	36AB-02-04M	2005	33	48

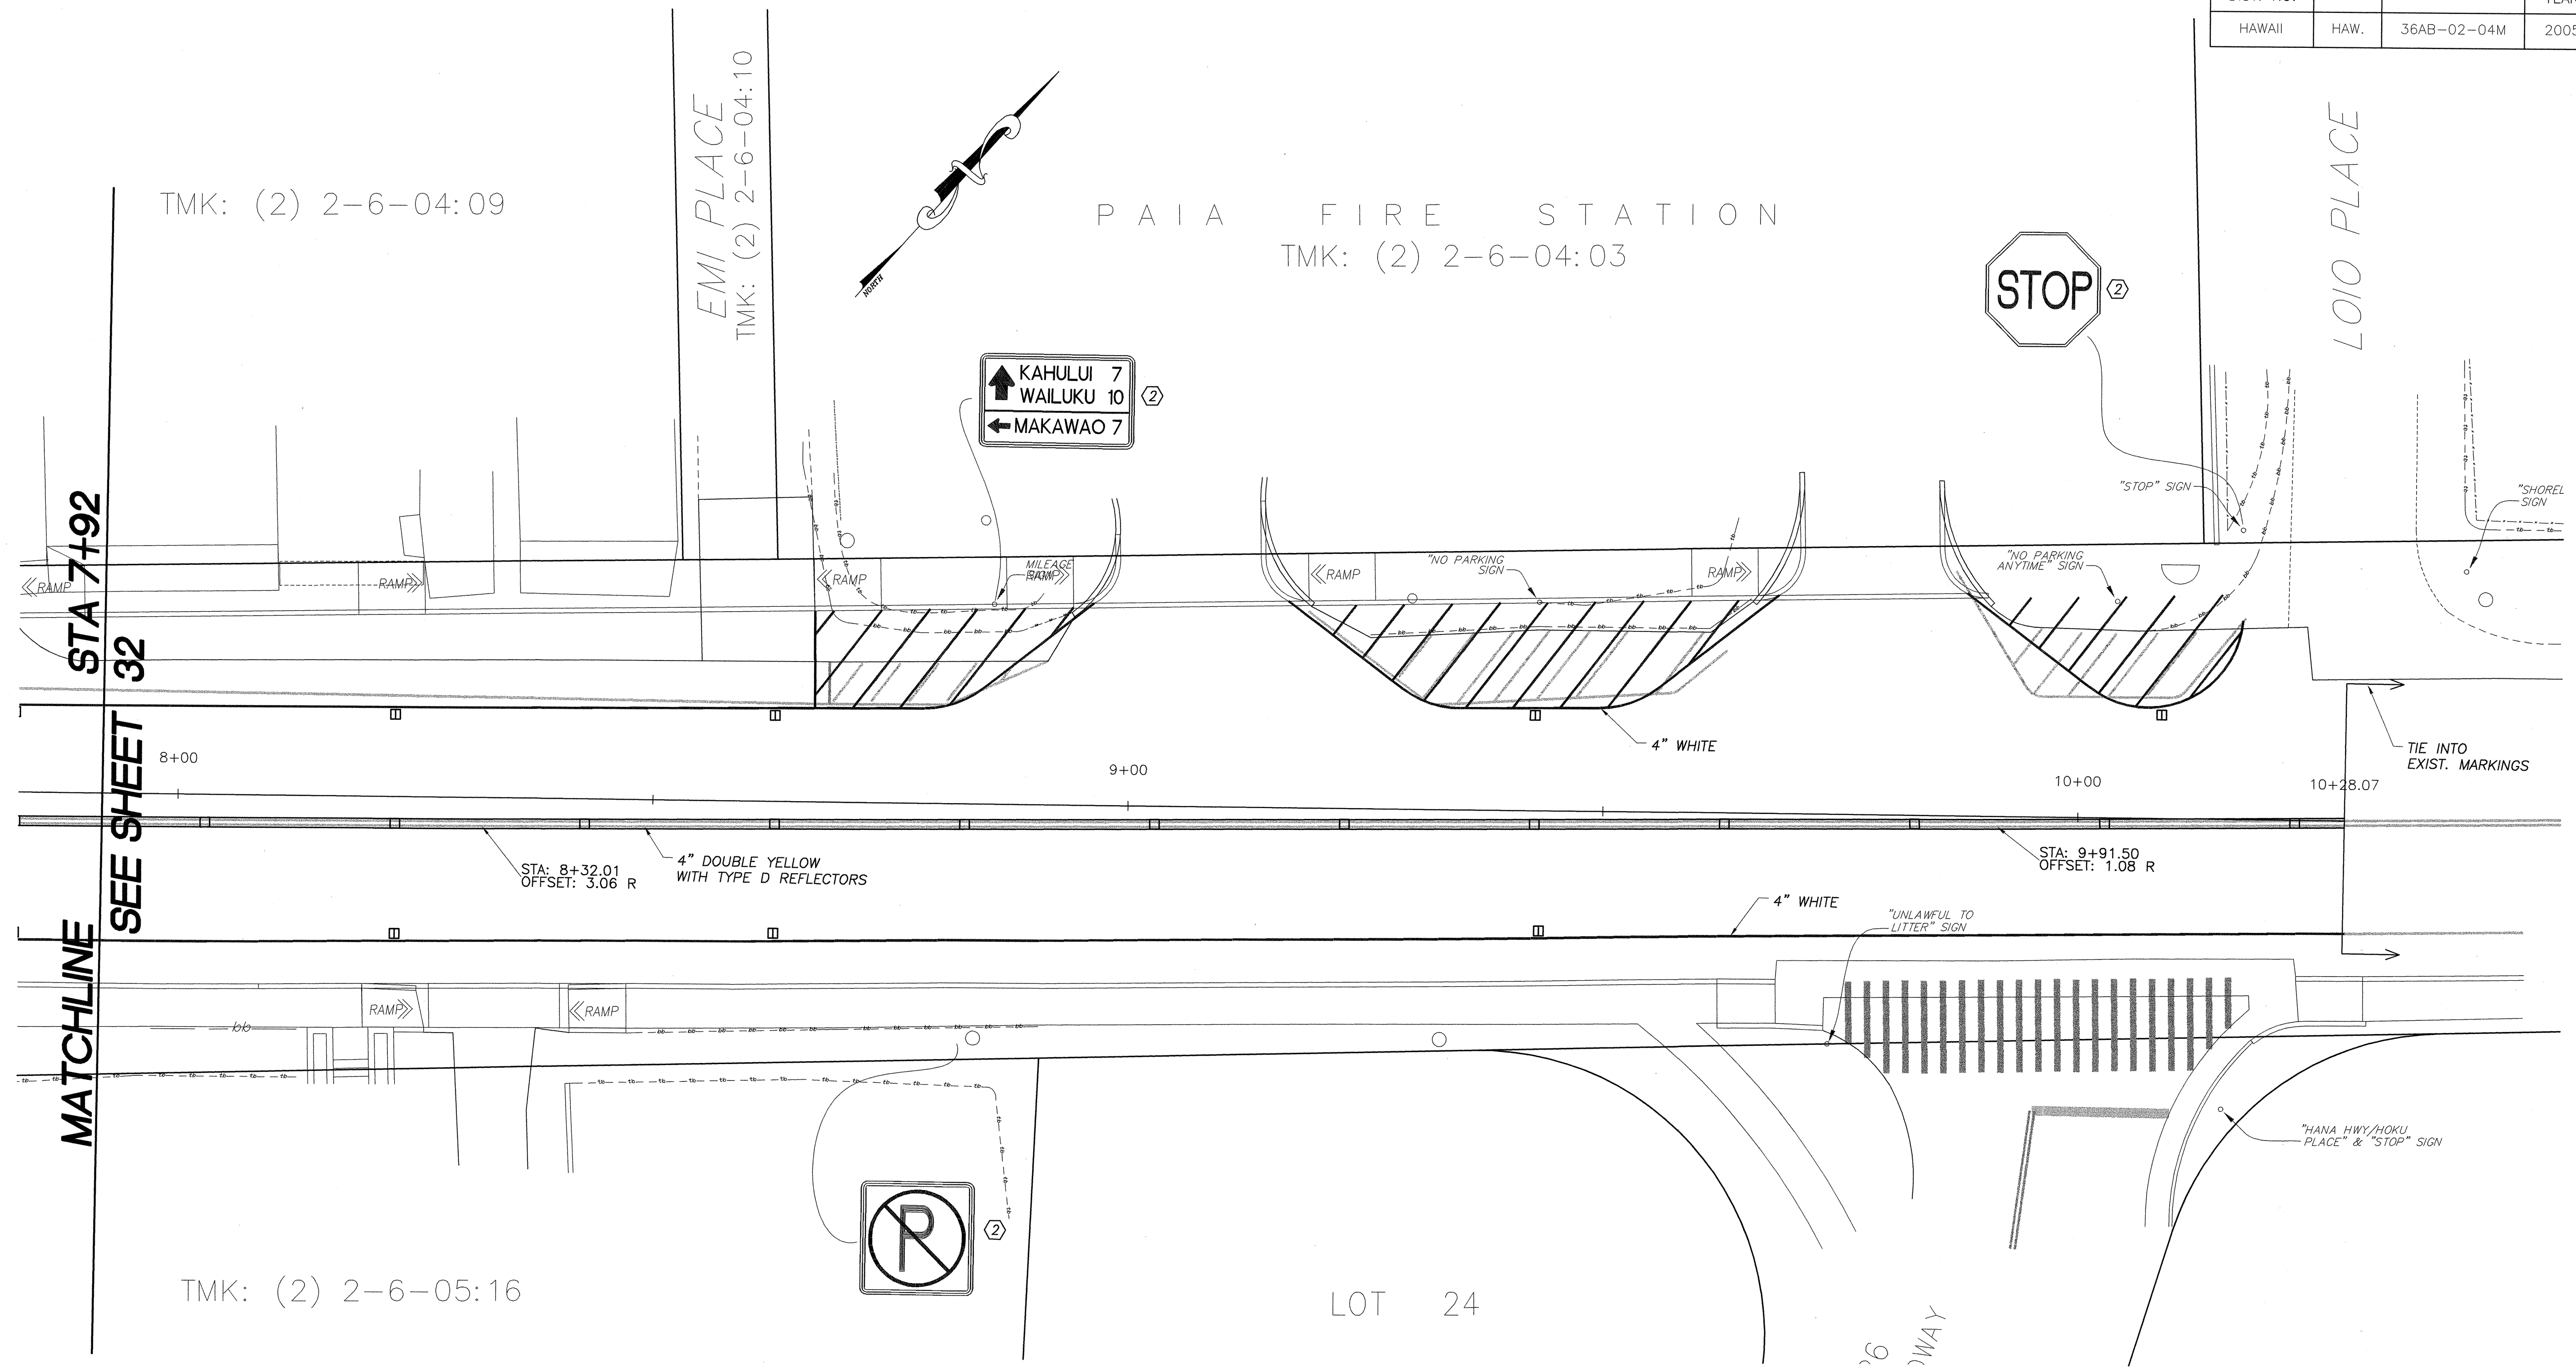


SIGN KEY

- 1 Existing Sign and Post(s) to Remain
- 2 Remove Existing Sign and Post and Replace with New
- 3 Install New Sign(s) w/Post(s) and RM-3(s) (If Required)
- 4 Relocate Existing Sign and Post

PLAN

1" = 10'

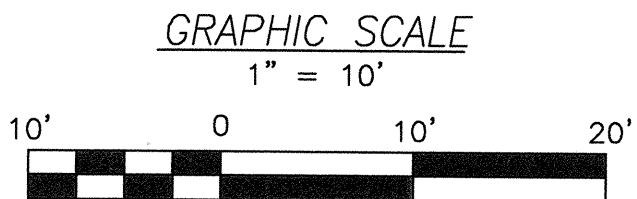

SURVEY PLOTTED BY	DATE
DRAWN BY	
CHECKED BY	
DESIGNED BY	
QUANTITIES BY	
CHECKED BY	
NO.	

NEIL S. FUKUMOTO
LICENSED PROFESSIONAL ENGINEER
No. 6186-C
HAWAII U.S.A.

STATE OF HAWAII
DEPARTMENT OF TRANSPORTATION
HIGHWAYS DIVISION

STRIPING PLANS
STA 7+92 TO END

ROUTE 36, HANA HIGHWAY RESURFACING
HALEAKALA HWY TO HOOKIPA PARK
PAIA TOWN SECTION

Project No. 36AB-02-04M
Scale: As Shown Date: MAY 2005

EXPIRATION DATE OF THE LICENSE