




FED. ROAD DIST. NO.	STATE	PROJ. NO.	FISCAL YEAR	SHEET NO.	TOTAL SHEETS
HAWAII	HAW.	36AB-02-04M	2005	09	48

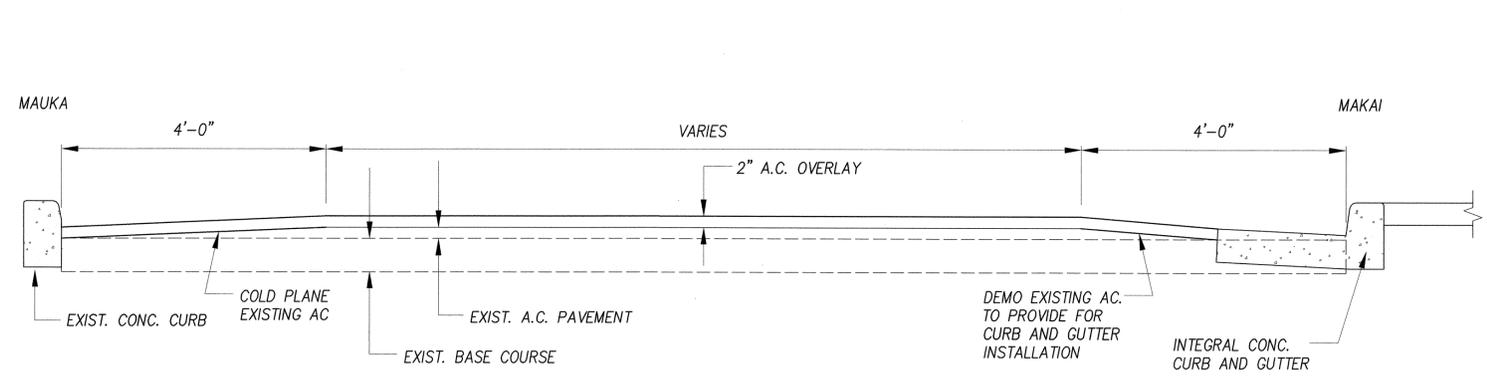



TYPICAL SECTION
SCALE: 3/4"=1'-0"

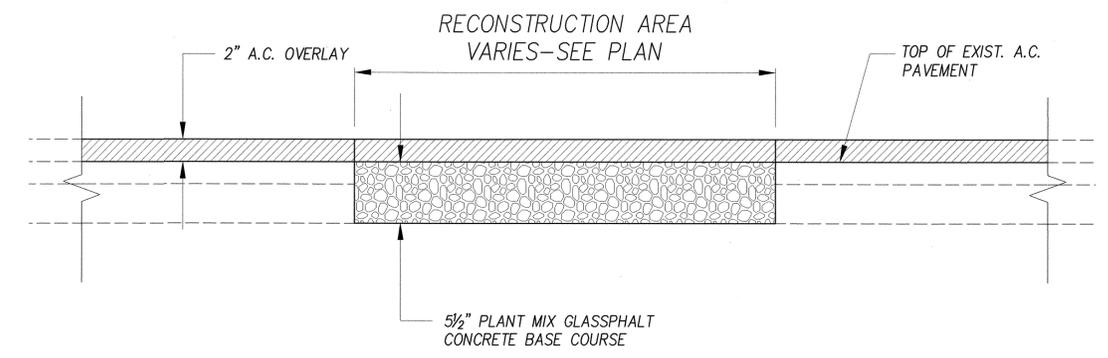


A.C. RECONSTRUCTION DETAIL
SCALE: 1-1/2"=1'-0"

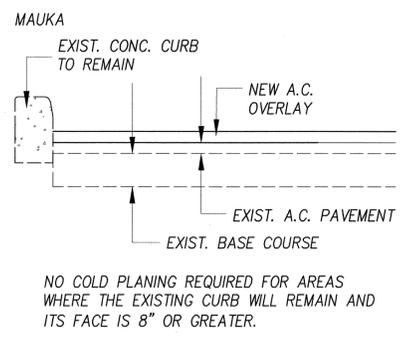


MAUKA SIDE SECTION VARIATIONS
SCALE: 3/4"=1'-0"

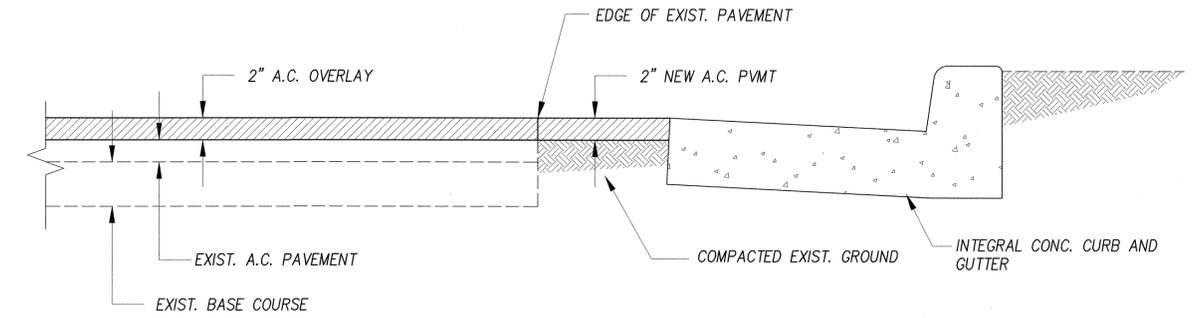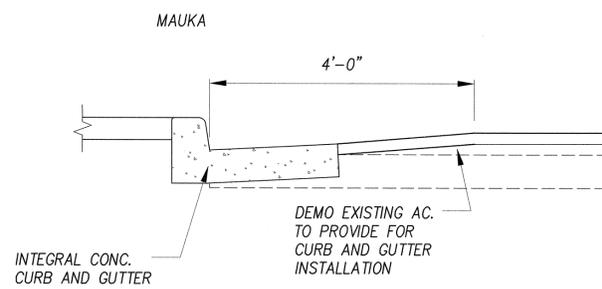

SECTION AT EXIST. NON-A.C. SHOULDER
SCALE: 1-1/2"=1'-0"

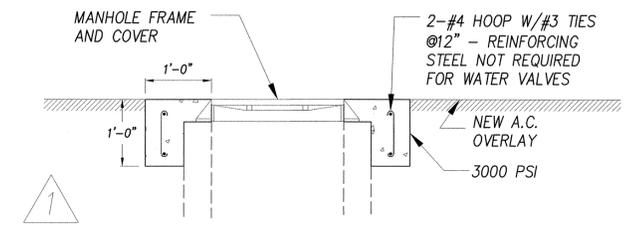

MANHOLE/WATER VALVE ADJUSTMENT DETAIL
SCALE: NOT TO SCALE





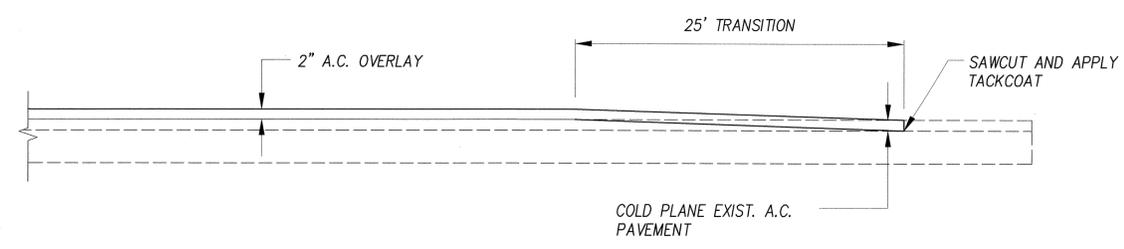


TRANSITION TO EXISTING PAVEMENT
SCALE: 3/4"=1'-0"




SURVEY PLOTTED BY	DATE
DRAWN BY	
DESIGNED BY	
CHECKED BY	
ORIGINAL PLAN	
NOTE BOOK	
No.	

6-17-05	MANHOLE/VALVE ADJUSTMENT DETAIL ADDED
DATE	DESCRIPTION
STATE OF HAWAII DEPARTMENT OF TRANSPORTATION HIGHWAYS DIVISION RESURFACING DETAILS ROUTE 36, HANA HIGHWAY RESURFACING HALEAKALA HWY TO HOOKIPA PARK PAIA TOWN SECTION Project No. 36AB-02-04M Scale: As Shown Date: MAY 2005	
THIS WORK WAS PREPARED BY ME OR UNDER MY SUPERVISION April 30, 2006 EXPIRATION DATE OF THE LICENSE	
SHEET No. 1 OF 2 SHEETS	


FED. ROAD DIST. NO.	STATE	PROJ. NO.	FISCAL YEAR	SHEET NO.	TOTAL SHEETS
HAWAII	HAW.	36AB-02-04M	2005	10	48

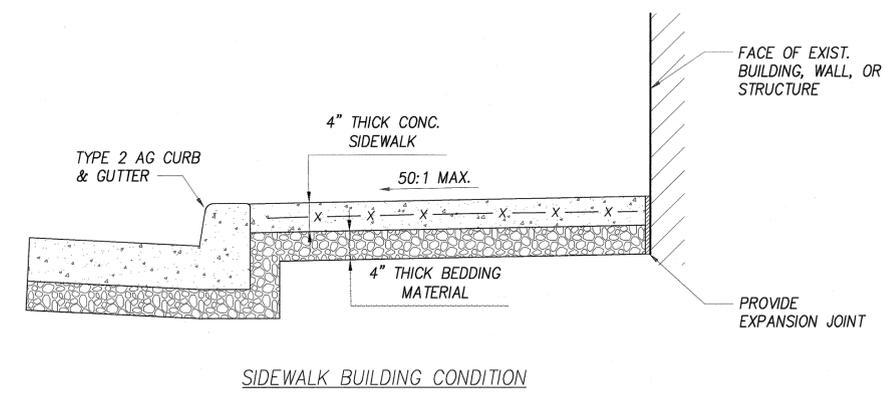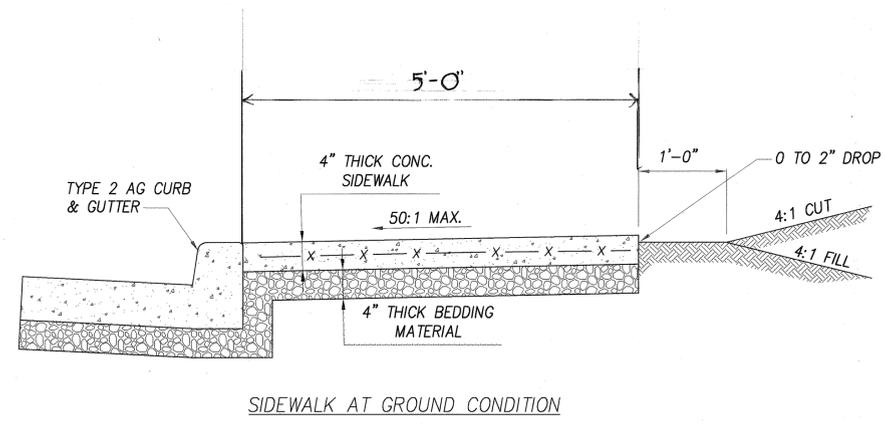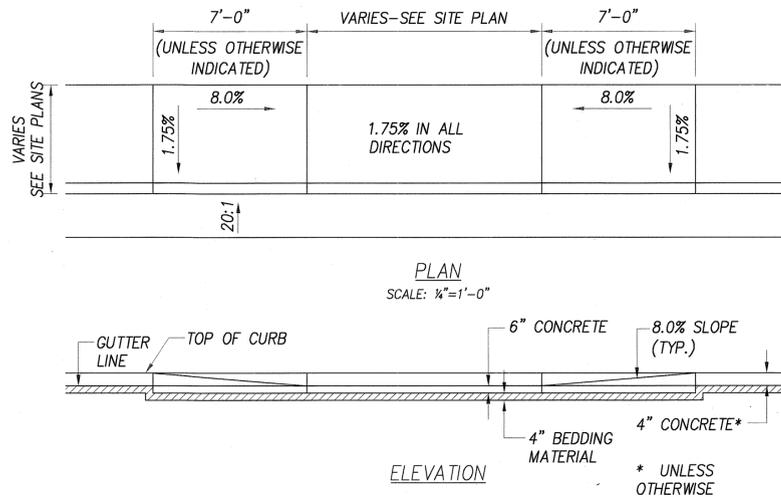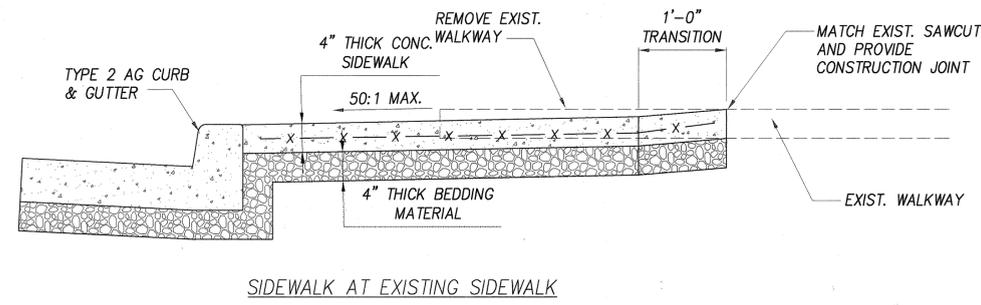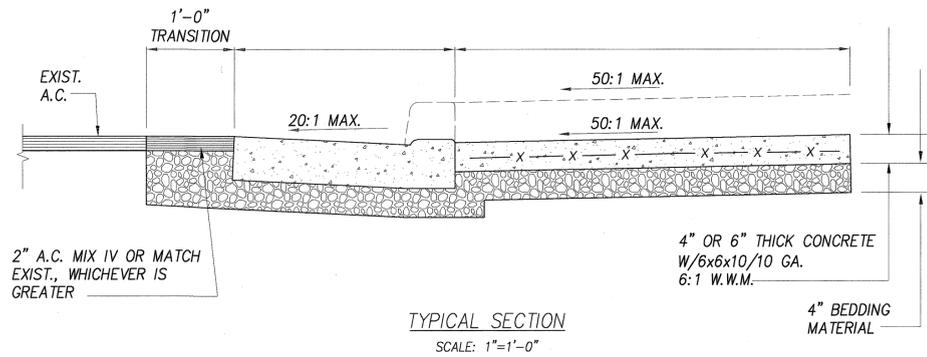

SIDEWALK / RAMP / APRON DETAIL
SCALE: AS NOTED

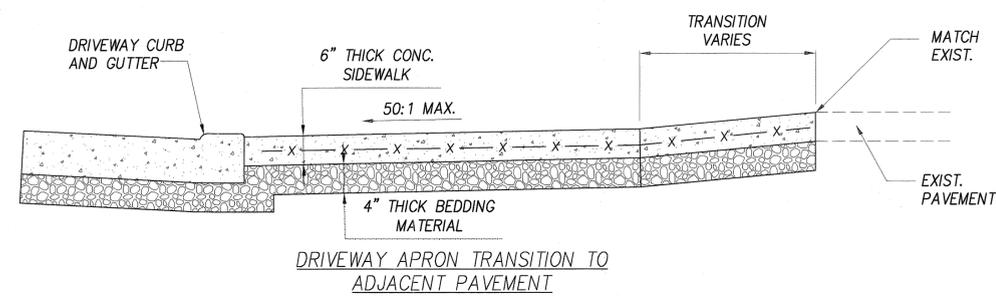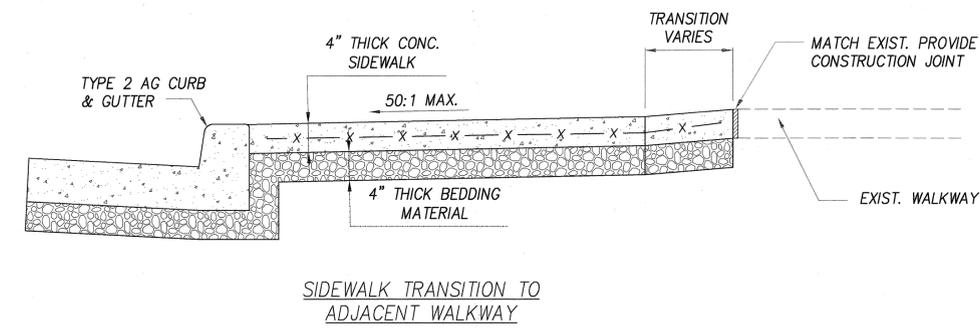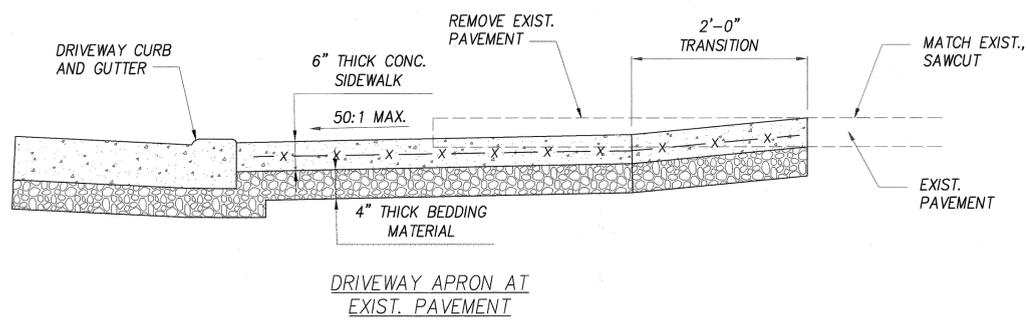

CONCRETE SIDEWALK DETAILS
SCALE: 1"=1'-0"

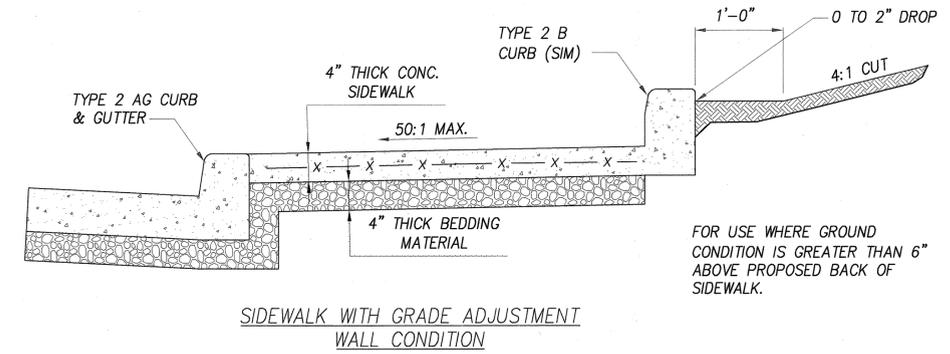

FOR USE WHERE GROUND CONDITION IS GREATER THAN 6" ABOVE PROPOSED BACK OF SIDEWALK.

HEAL S. FUKUMOTO
LICENSED PROFESSIONAL ENGINEER
No. 6186-C
HAWAII U.S.A.

THIS WORK WAS PREPARED BY ME OR UNDER MY SUPERVISION
April 30, 2006
EXPIRATION DATE OF THE LICENSE

STATE OF HAWAII
DEPARTMENT OF TRANSPORTATION
HIGHWAYS DIVISION

RESURFACING DETAILS

ROUTE 36, HANA HIGHWAY RESURFACING
HALEAKALA HWY TO HOOKIPA PARK
PAIA TOWN SECTION

Project No. 36AB-02-04M
Scale: As Shown Date: MAY 2005

SHEET No. 2 OF 2 SHEETS

"AS-BUILT"

SURVEY PLOTTED BY	DATE
DRAWN BY	
DESIGNED BY	
CHECKED BY	
ORIGINAL PLAN	
NOTE BOOK	
QUANTITIES BY	
CHECKED BY	
No.	