

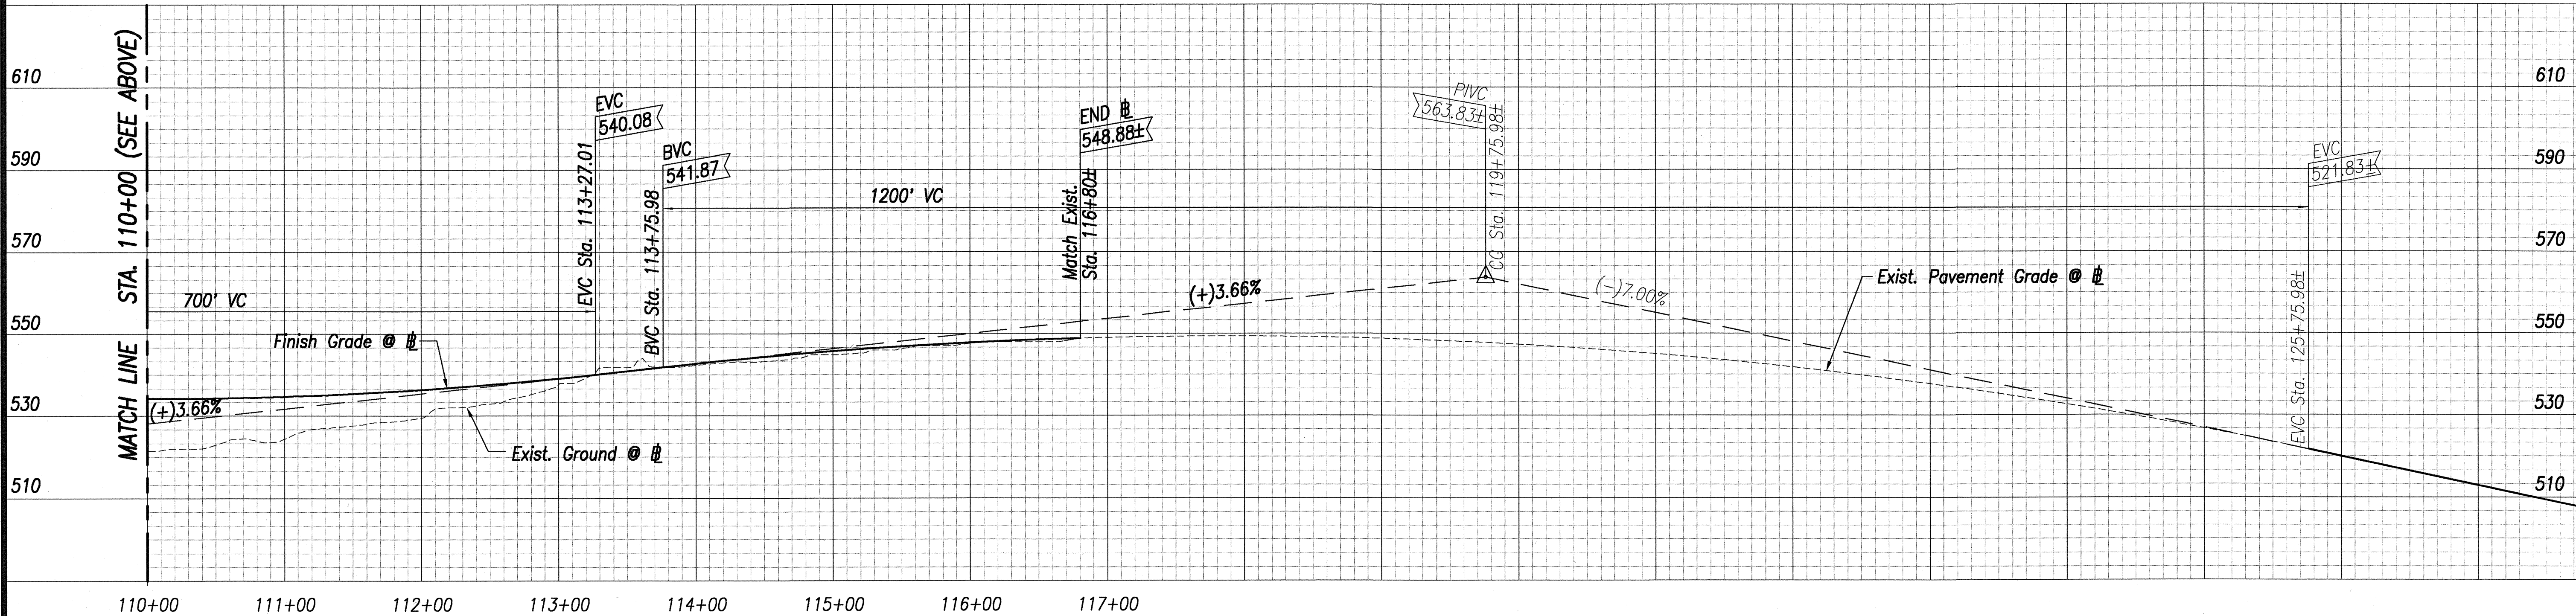
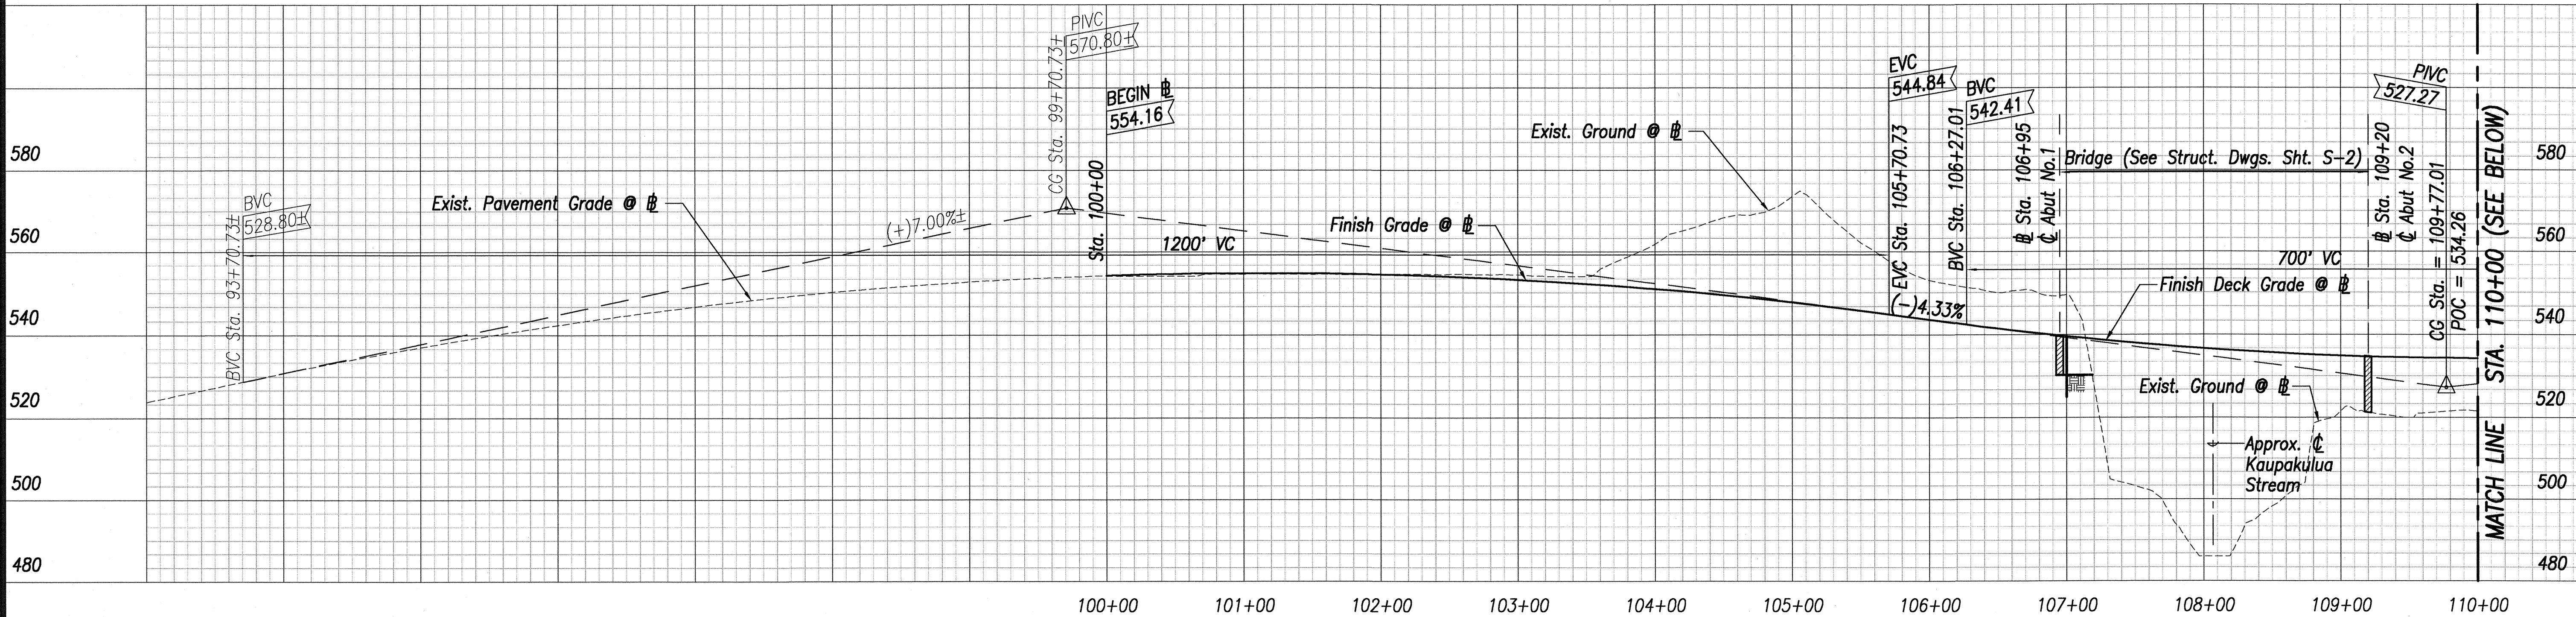


FED. ROAD DIST. NO.	STATE	FED. AID PROJ. NO.	FISCAL YEAR	SHEET NO.	TOTAL SHEETS
HAWAII	HAW.	BR-036-1(15)	2000	6	89

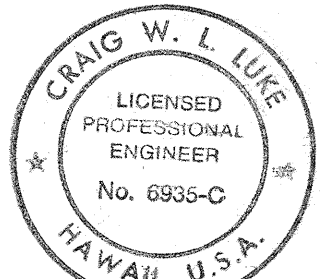

DATE	_____
SURVEY PLANNED BY	_____
DRAWN BY	_____
DESIGNED BY	_____
QUANTITIES BY	_____
CHECKED BY	_____
ORIGINAL PLAN	_____
NOTE BOOK	_____
No.	_____

GENERAL PROFILE (Sta. 100+00 TO Sta. 116+80±)
 SCALES: HORIZ. 1" = 60'
 VERT. 1" = 20'

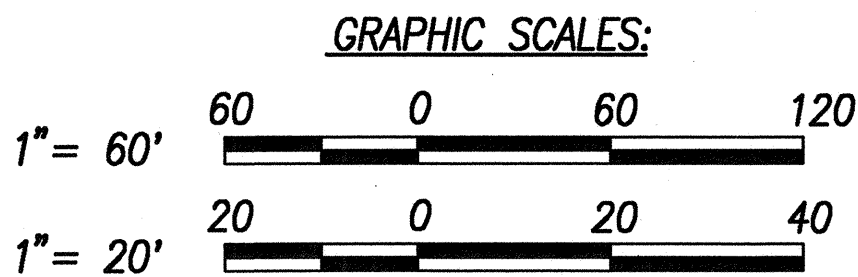

THIS WORK WAS PREPARED BY ME OR UNDER MY SUPERVISION.
 SIGNATURE: _____ DATE: 7/20/00

STATE OF HAWAII
DEPARTMENT OF TRANSPORTATION
HIGHWAYS DIVISION

GENERAL PROFILE
Sta. 100+00 TO Sta. 116+80±
HANA HIGHWAY
REPLACEMENT OF KAUPAKULUA BRIDGE
AND APPROACHES
F.A.P. Proj. No. BR-036-1(15)
Scale: 1" = 60' Date: June 30, 2000

SHEET No. C-4 OF 89 SHEETS