
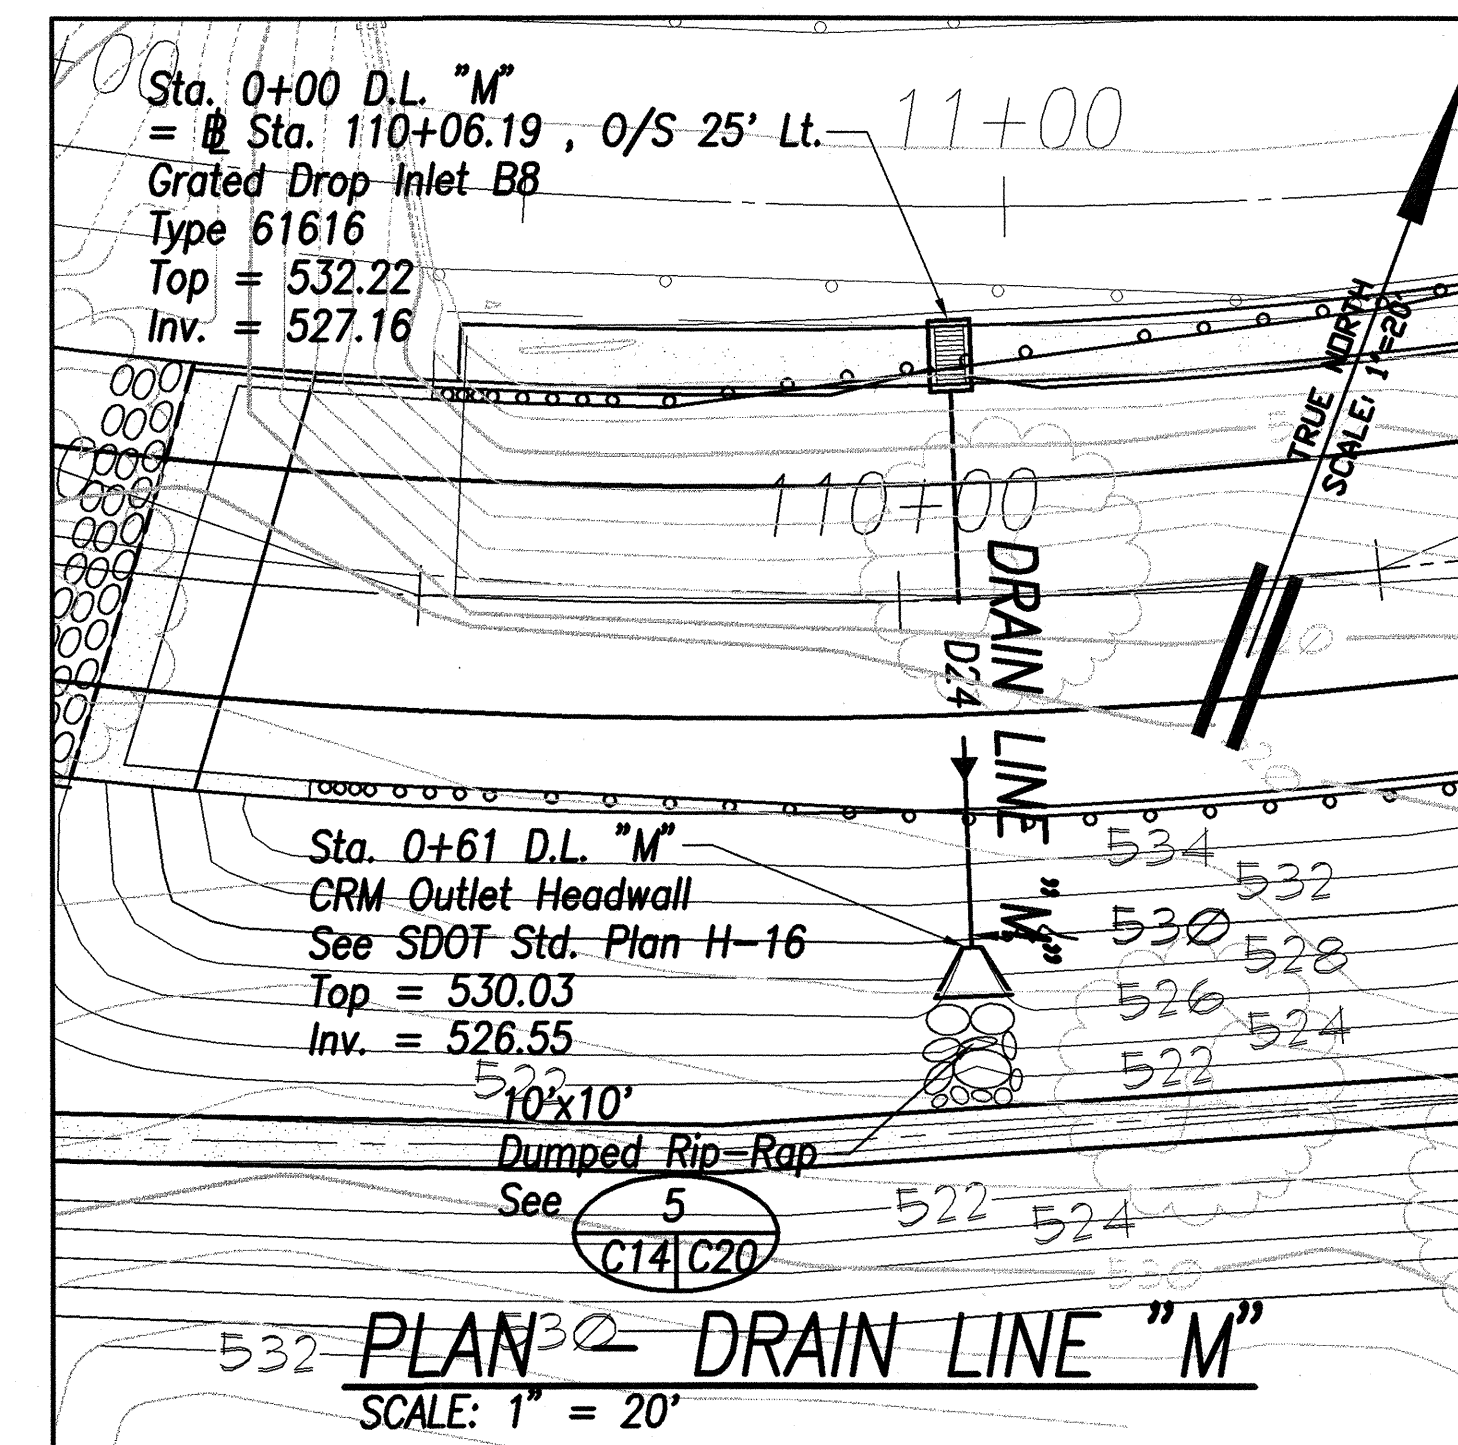
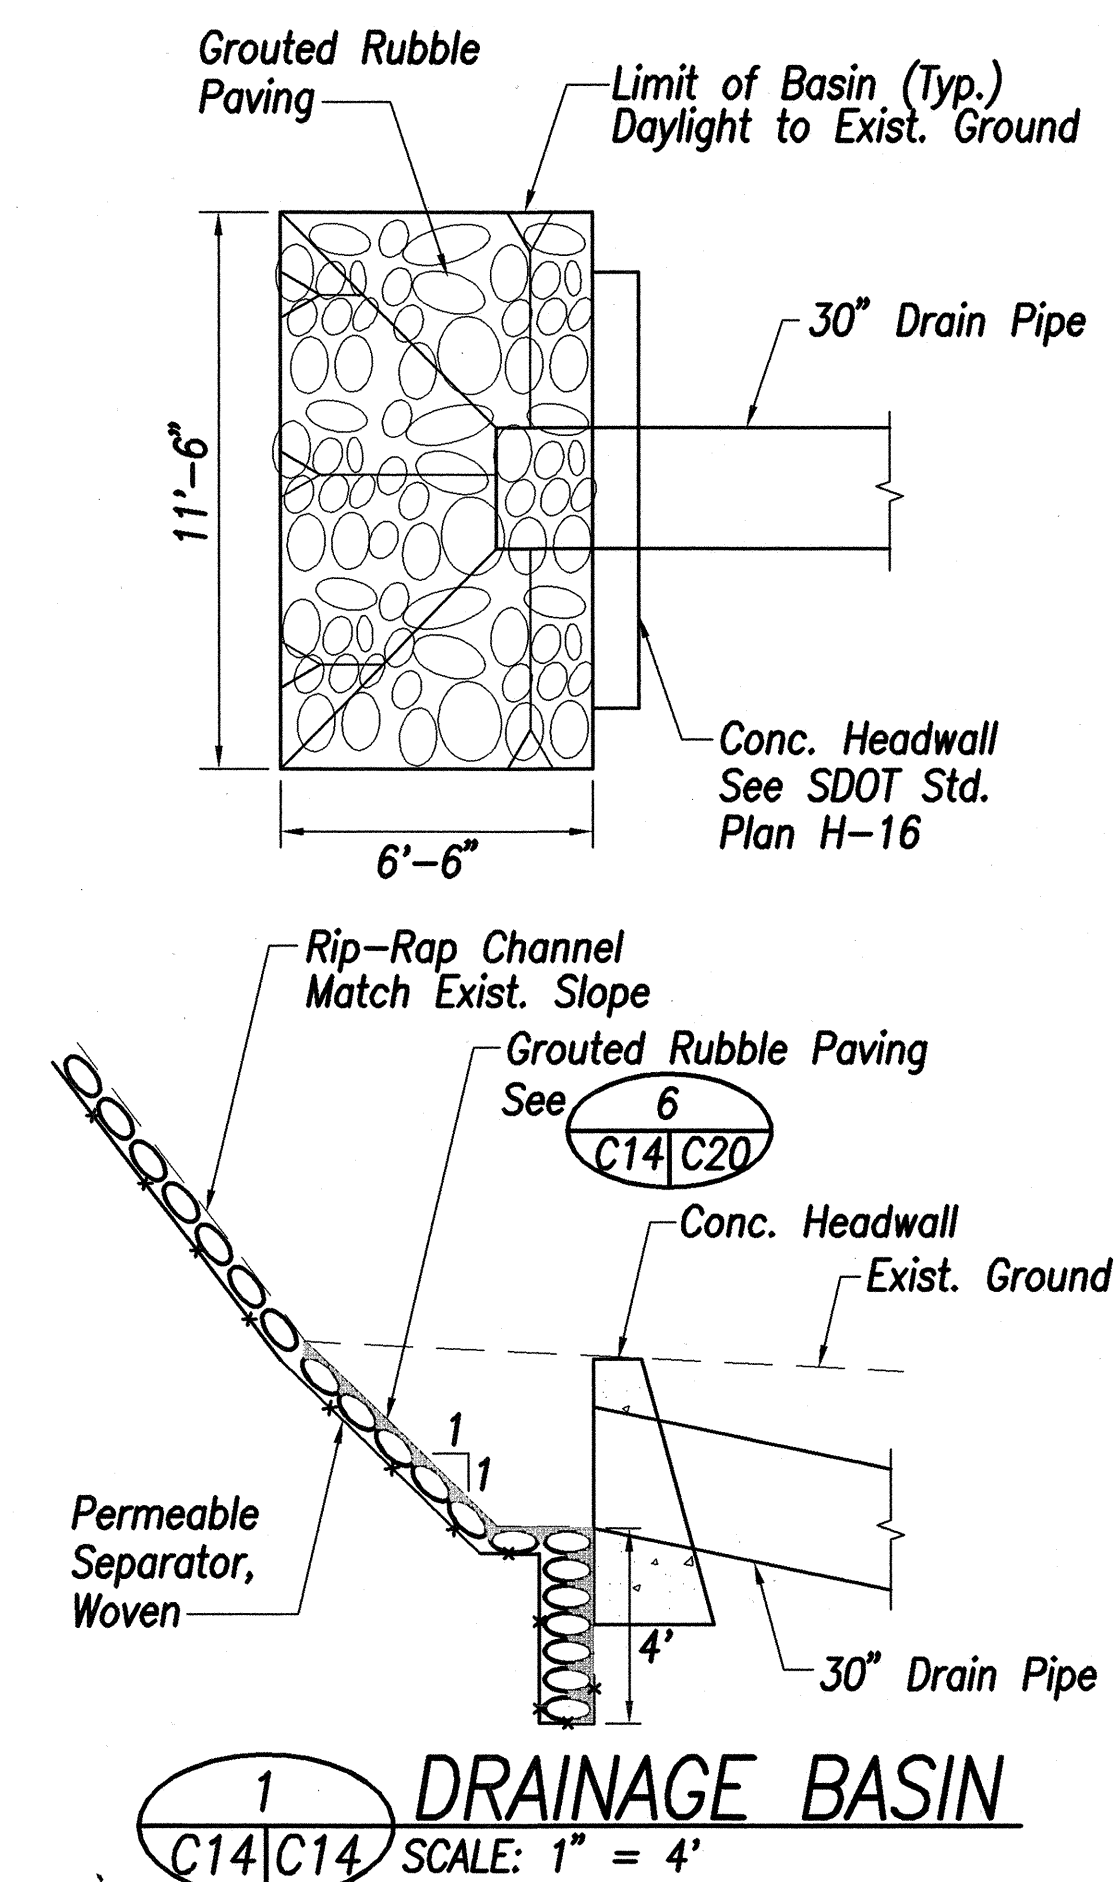


FED. ROAD DIST. NO.	STATE	FED. AID PROJ. NO.	FISCAL YEAR	SHEET NO.	TOTAL SHEETS
HAWAII	HAW.	BR-036-1(15)	2000	16	89

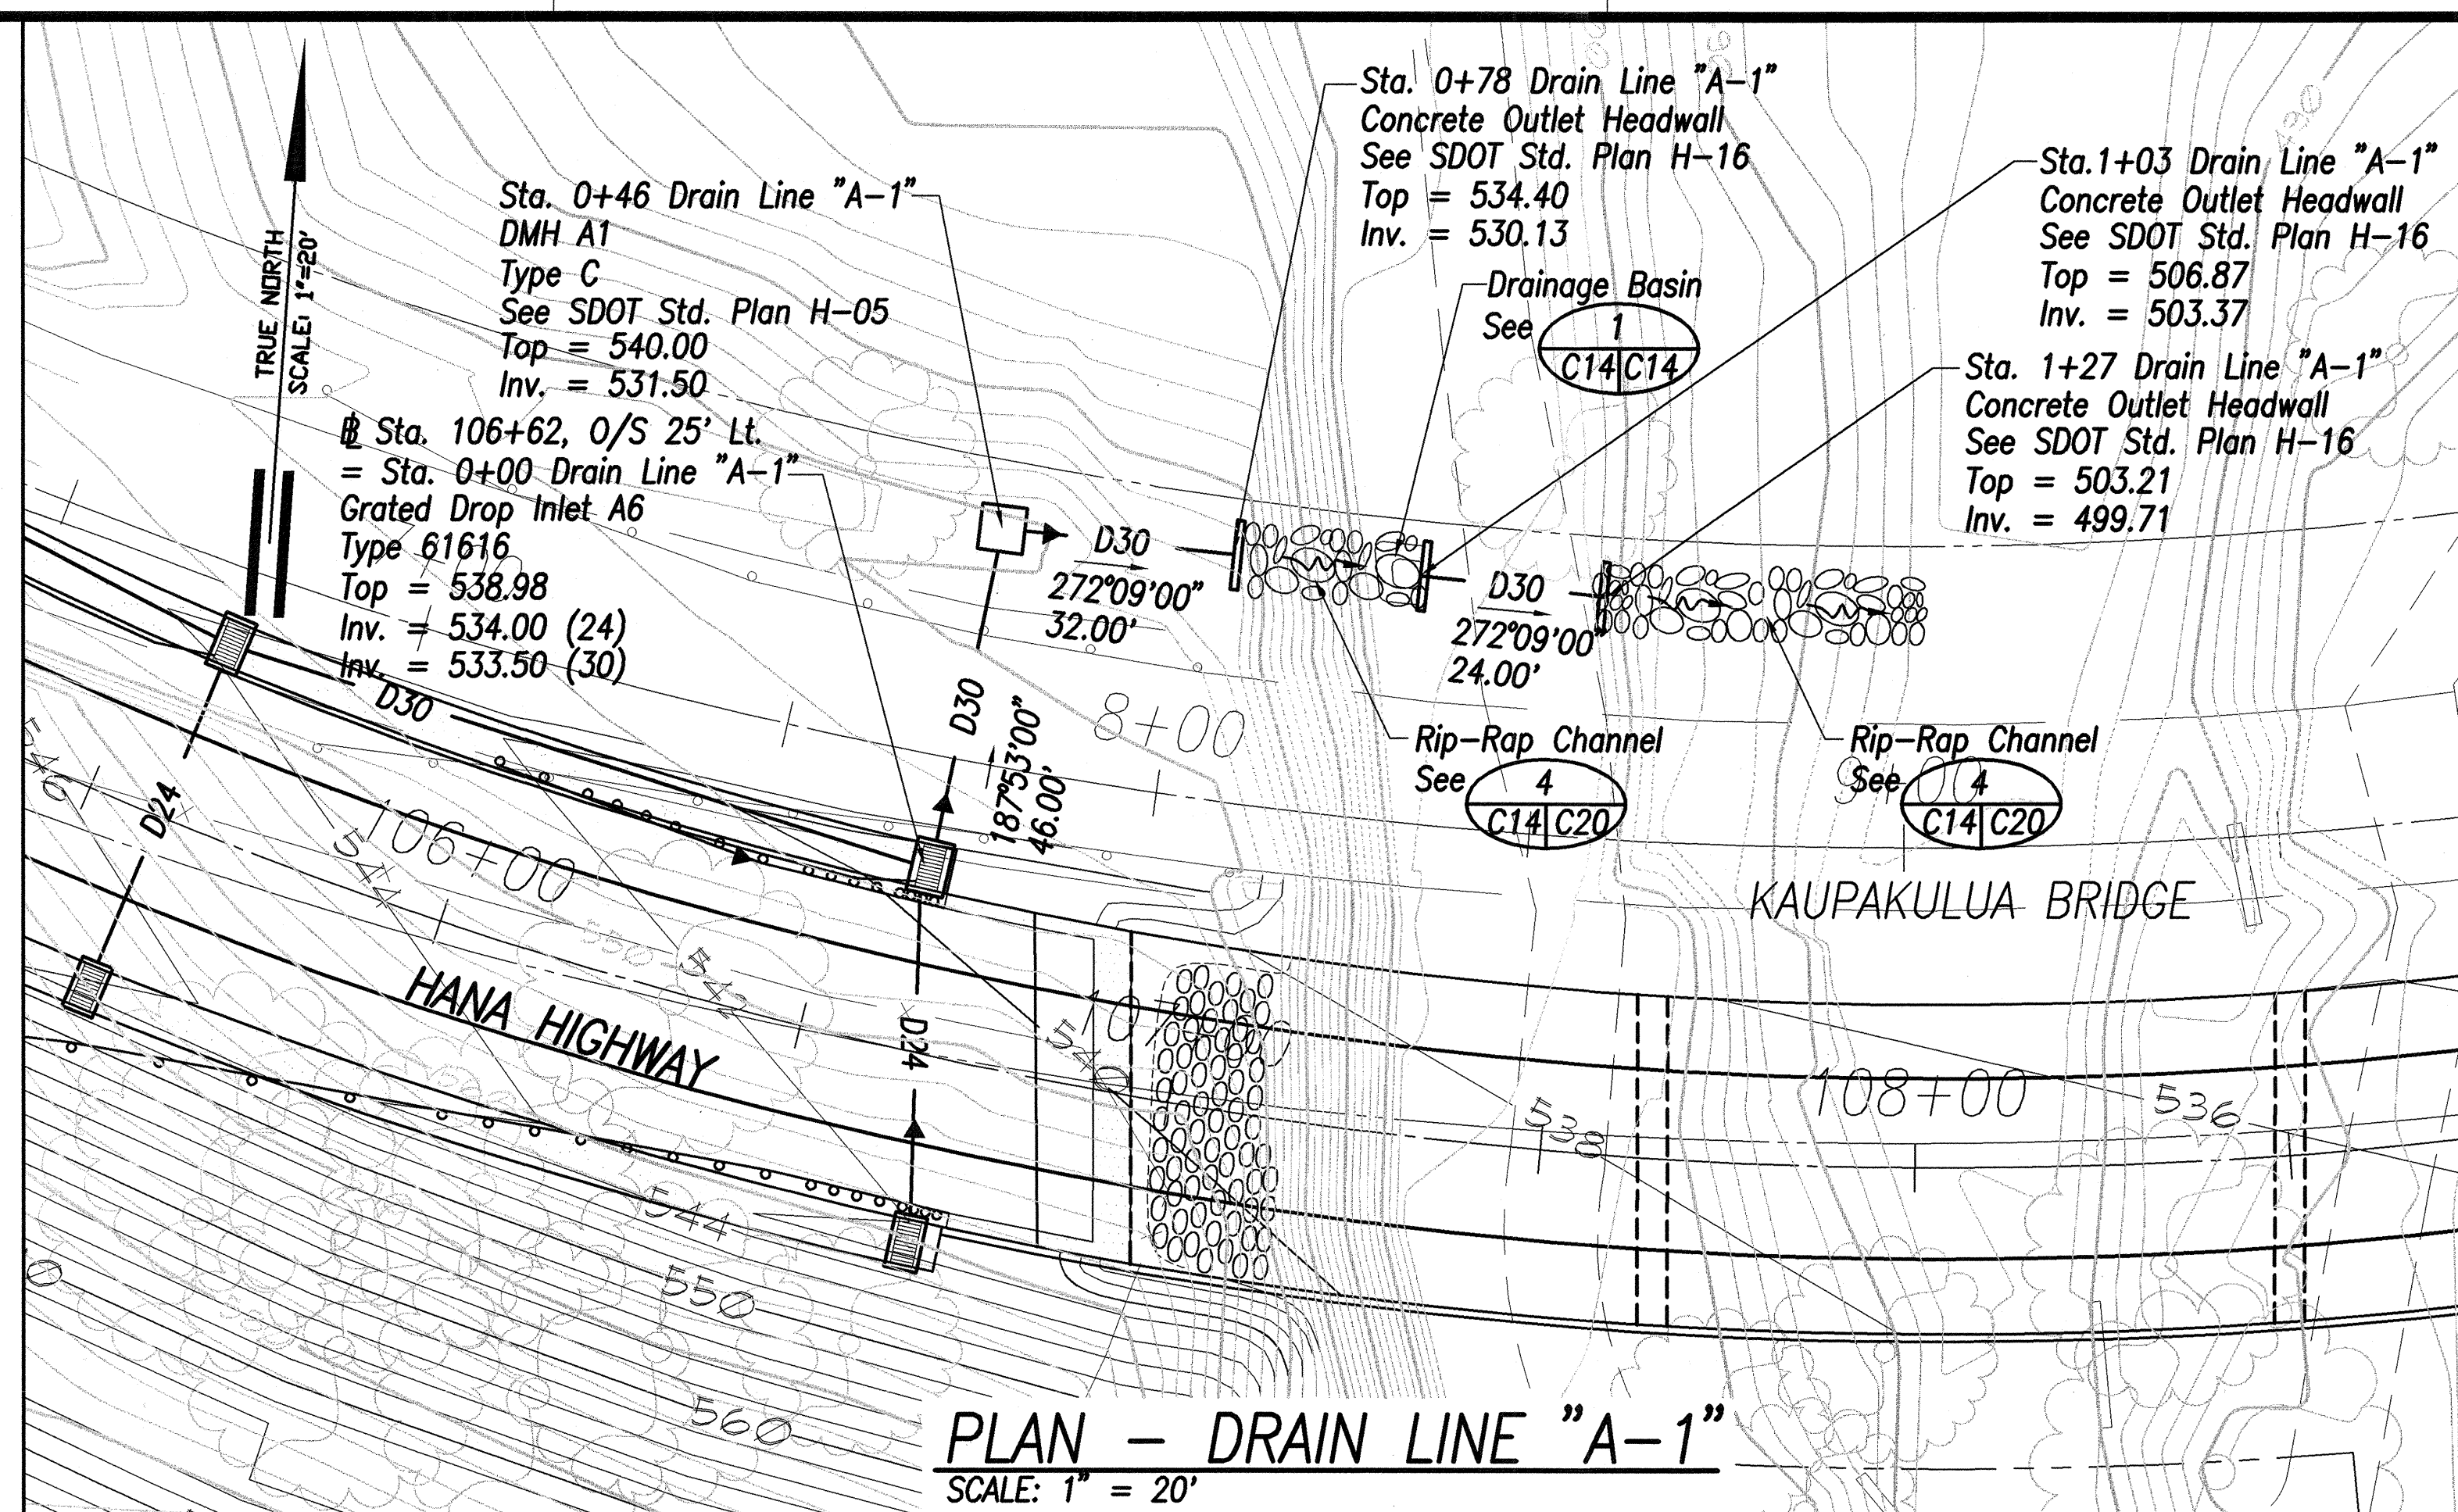


LEGEND

	RUNOFF DIRECTION
	SPOT ELEVATION
	DRAIN INLET
	DRAIN LINE SIZE AND DIRECTION OF FLOW
	CONCRETE SWALE

Notes:

- For Type 61616 Grated Drop Inlet, see DOT Std. Plan H-12 and Sht. C-20.
- Bicycle-safe grates shall be installed on all Type 61616 Grated Drop Inlets. For grate details, see Sht. C-21.

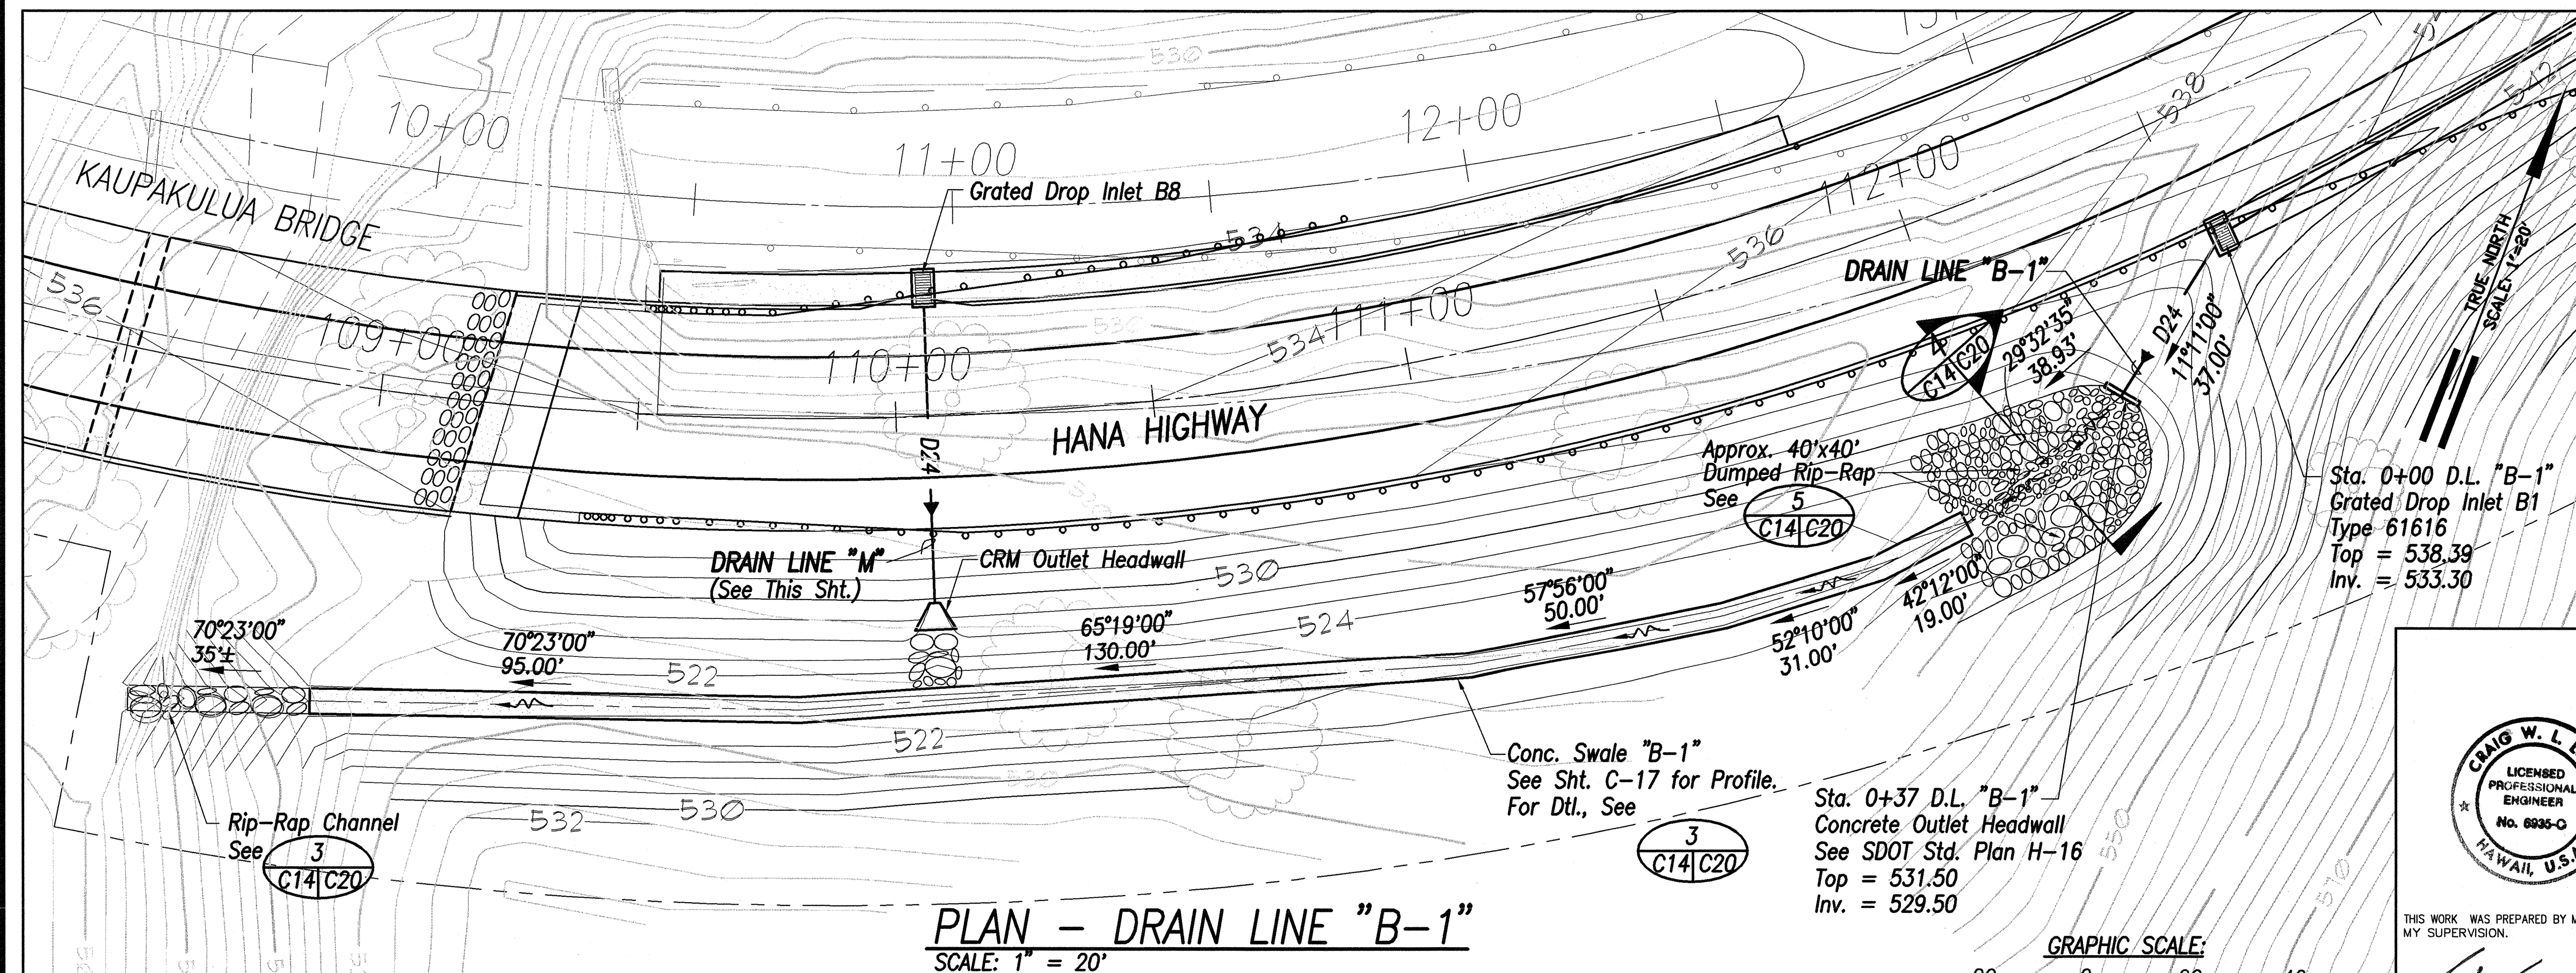

SURVEY PLOTTED BY	DATE
DRAWN BY	
CHECKED BY	
QUANTITIES BY	
NOTE BOOK	
No.	



THIS WORK WAS PREPARED BY ME OR UNDER MY SUPERVISION.

SIGNATURE DATE

STATE OF HAWAII
DEPARTMENT OF TRANSPORTATION
HIGHWAYS DIVISION

OFFSITE DRAINAGE PLAN

HANA HIGHWAY
REPLACEMENT OF KAUPAKULUA BRIDGE
AND APPROACHES

F.A.P. Proj. No. BR-036-1(15)

Scale: 1" = 20'

Date: June 30, 2000

SHEET No. C-14 OF 89 SHEETS