

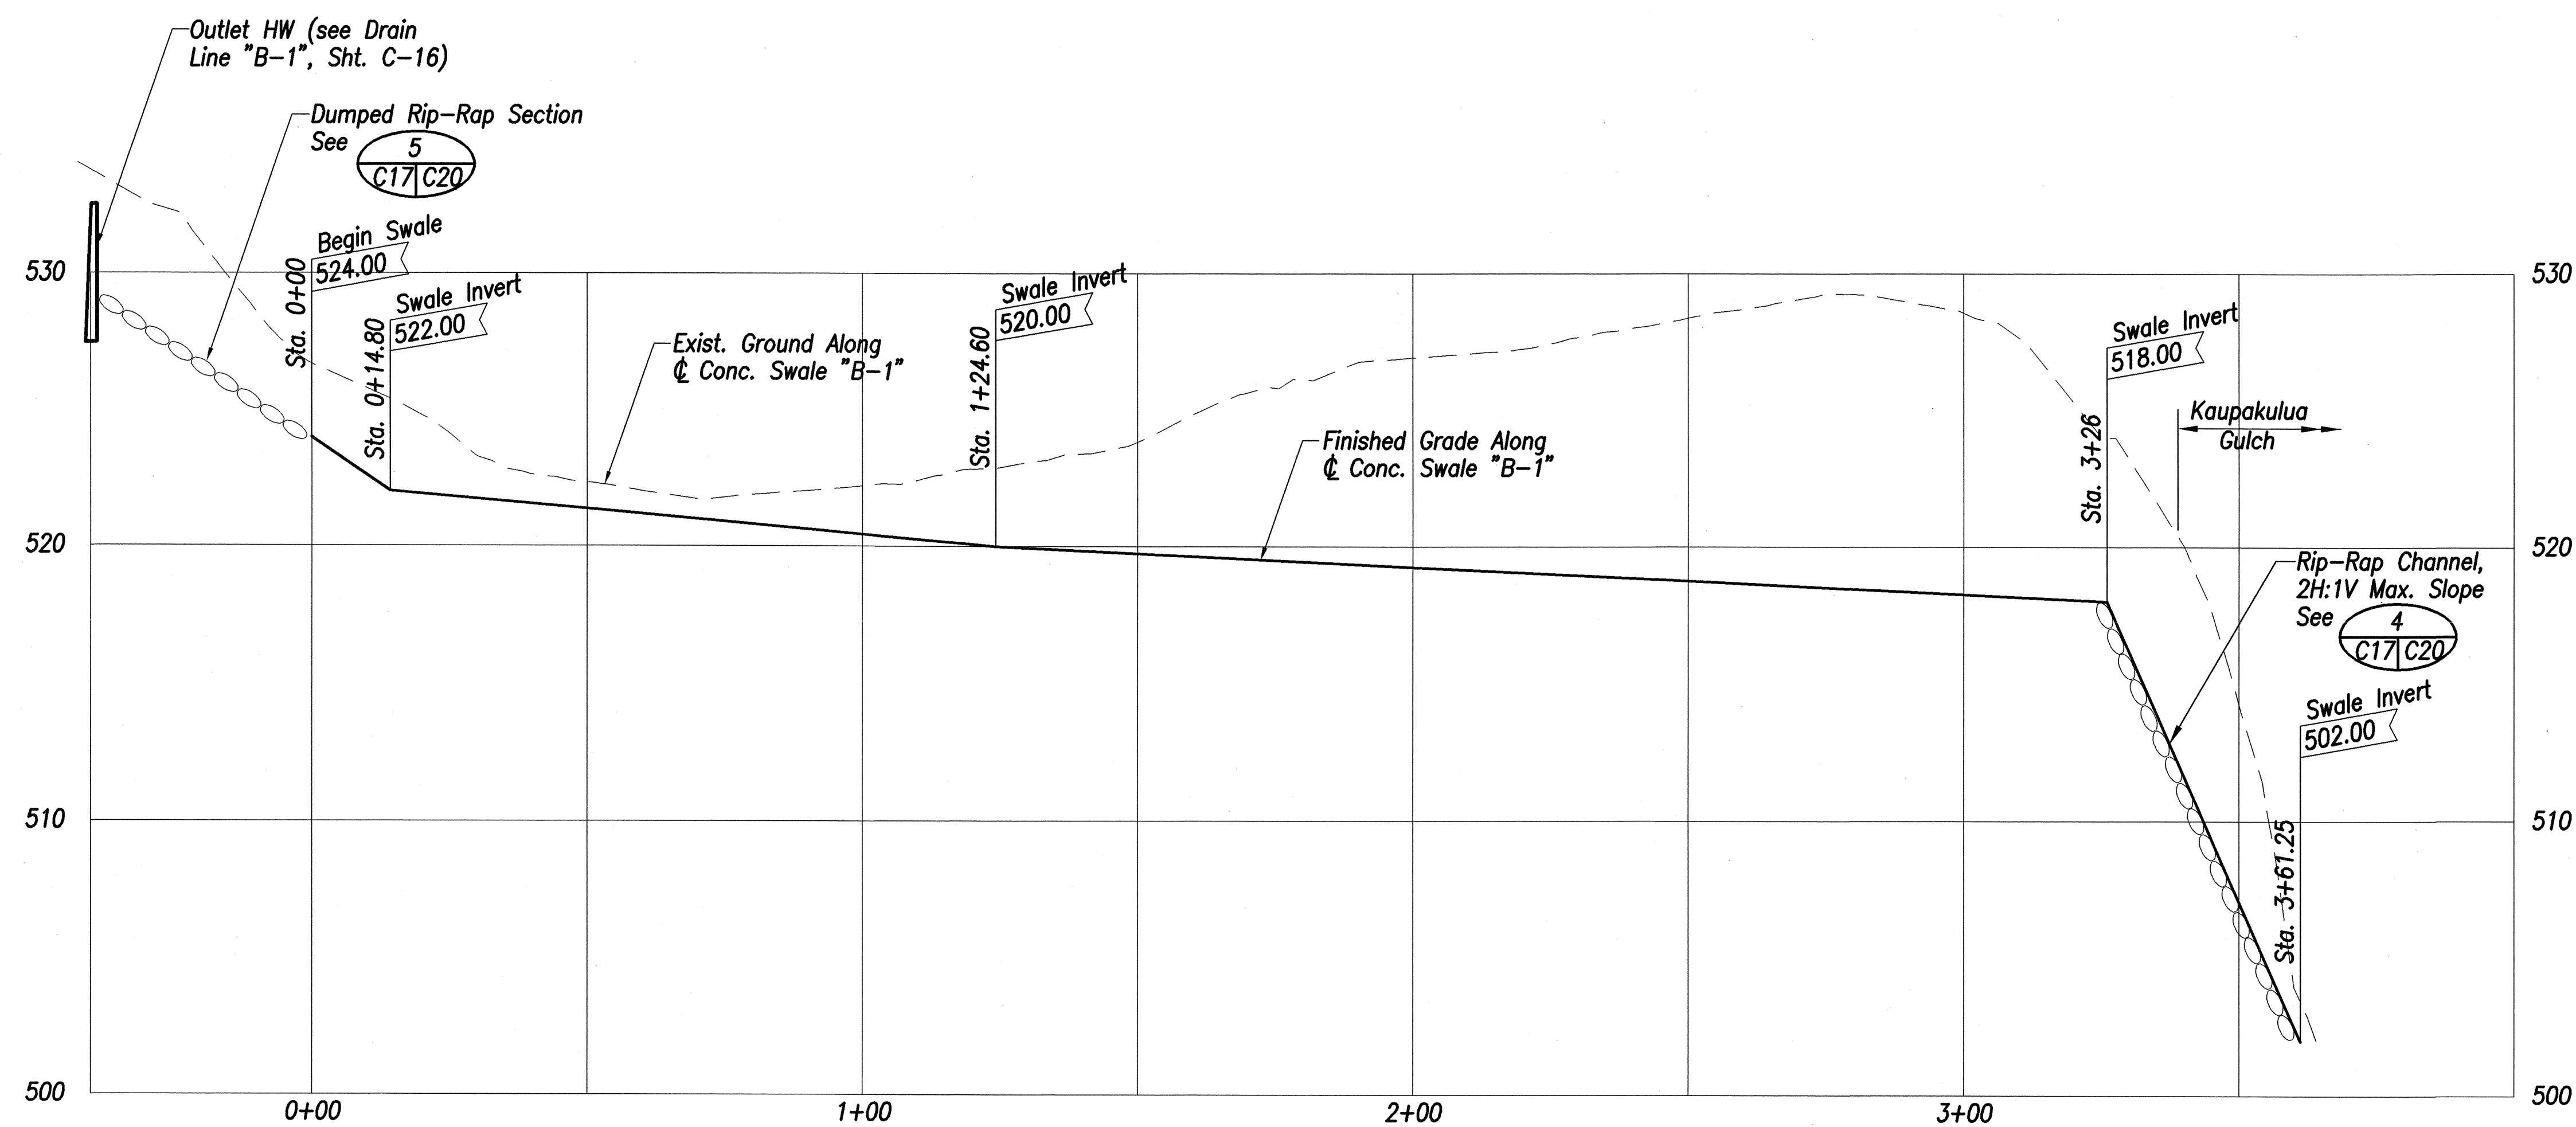


FED. ROAD DIST. NO.	STATE	FED. AID PROJ. NO.	FISCAL YEAR	SHEET NO.	TOTAL SHEETS
HAWAII	HAW.	BR-036-1(15)	2000	19	89

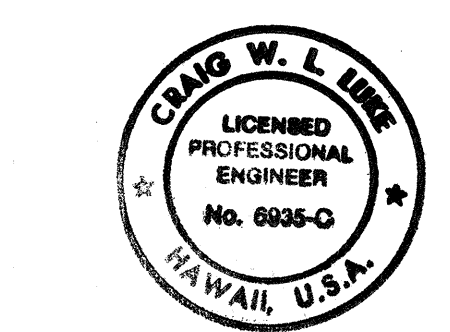

PROFILE — CONCRETE SWALE "B-1"  
 SCALES: HORIZ. 1" = 20'  
 VERT. 1" = 4'

SURVEY PLOTTED BY	DATE
DRAWN BY	
DESIGNED BY	
CHECKED BY	
NO.	

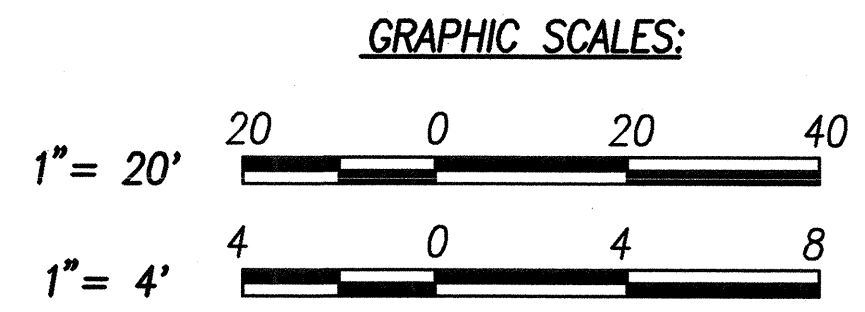

THIS WORK WAS PREPARED BY ME OR UNDER MY SUPERVISION.  
 SIGNATURE: *[Signature]* DATE: 11-14-00

11-14-00	Revised Swale Finished Grade Profile per Addendum No. 1
DATE	REVISION
STATE OF HAWAII DEPARTMENT OF TRANSPORTATION HIGHWAYS DIVISION <b>SWALE PROFILE</b> HANA HIGHWAY REPLACEMENT OF KAUPAKULUA BRIDGE AND APPROACHES F.A.P. Proj. No. BR-036-1(15) Scale: As Shown Date: June 30, 2000 <b>SHEET No. C-17 OF 89 SHEETS</b>	