




INDEX TO DRAWINGS	
SHEET NO.	DESCRIPTION
1	TITLE SHEET
2	STANDARD PLANS SUMMARY
3 - 4	GENERAL NOTES AND LEGEND
5	GENERAL GEOMETRIC PLAN
6	GENERAL PROFILE
7	TYPICAL SECTIONS
8 - 9	DEMOLITION PLAN
10 - 12	PLAN AND PROFILE
13 - 14	GRADING AND DRAINAGE PLAN
15	SUPERELEVATION DIAGRAM
16	OFFSITE DRAINAGE PLAN
17 - 18	DRAIN PROFILES
19	SWALE PROFILE
20 - 21	SIGNING AND STRIPING PLAN
22 - 23	DRAINAGE DETAILS
24	CHAIN LINK FENCE DETAILS
25 - 33	GUARDRAIL DETAILS
34 - 43	CROSS SECTIONS
44 - 47	CONSTRUCTION PHASING & TRAFFIC CONTROL PLAN
48 - 51	BORING LOGS AND LEGEND
52 - 89	STRUCTURAL DRAWINGS •

Sheet Nos. 78 S-I & 78 S-II are supplementary sheets to this project.

Total sheet count after "AS-Built" postings is 91 sheets.

STATE OF HAWAII
DEPARTMENT OF TRANSPORTATION
HIGHWAYS DIVISION
HONOLULU, HAWAII
"AS-BUILT"
PLANS FOR
HANA HIGHWAY
REPLACEMENT OF
KAUPAKULUA BRIDGE AND APPROACHES
FEDERAL AID PROJECT NO. BR-036-1(15)
DISTRICT OF MAKAWAO
ISLAND OF MAUI

FED. ROAD DIST. NO.	STATE	FED. AID PROJ. NO.	FISCAL YEAR	SHEET NO.	TOTAL SHEETS
HAWAII	HAW.	BR-036-1(15)	2000	1	89

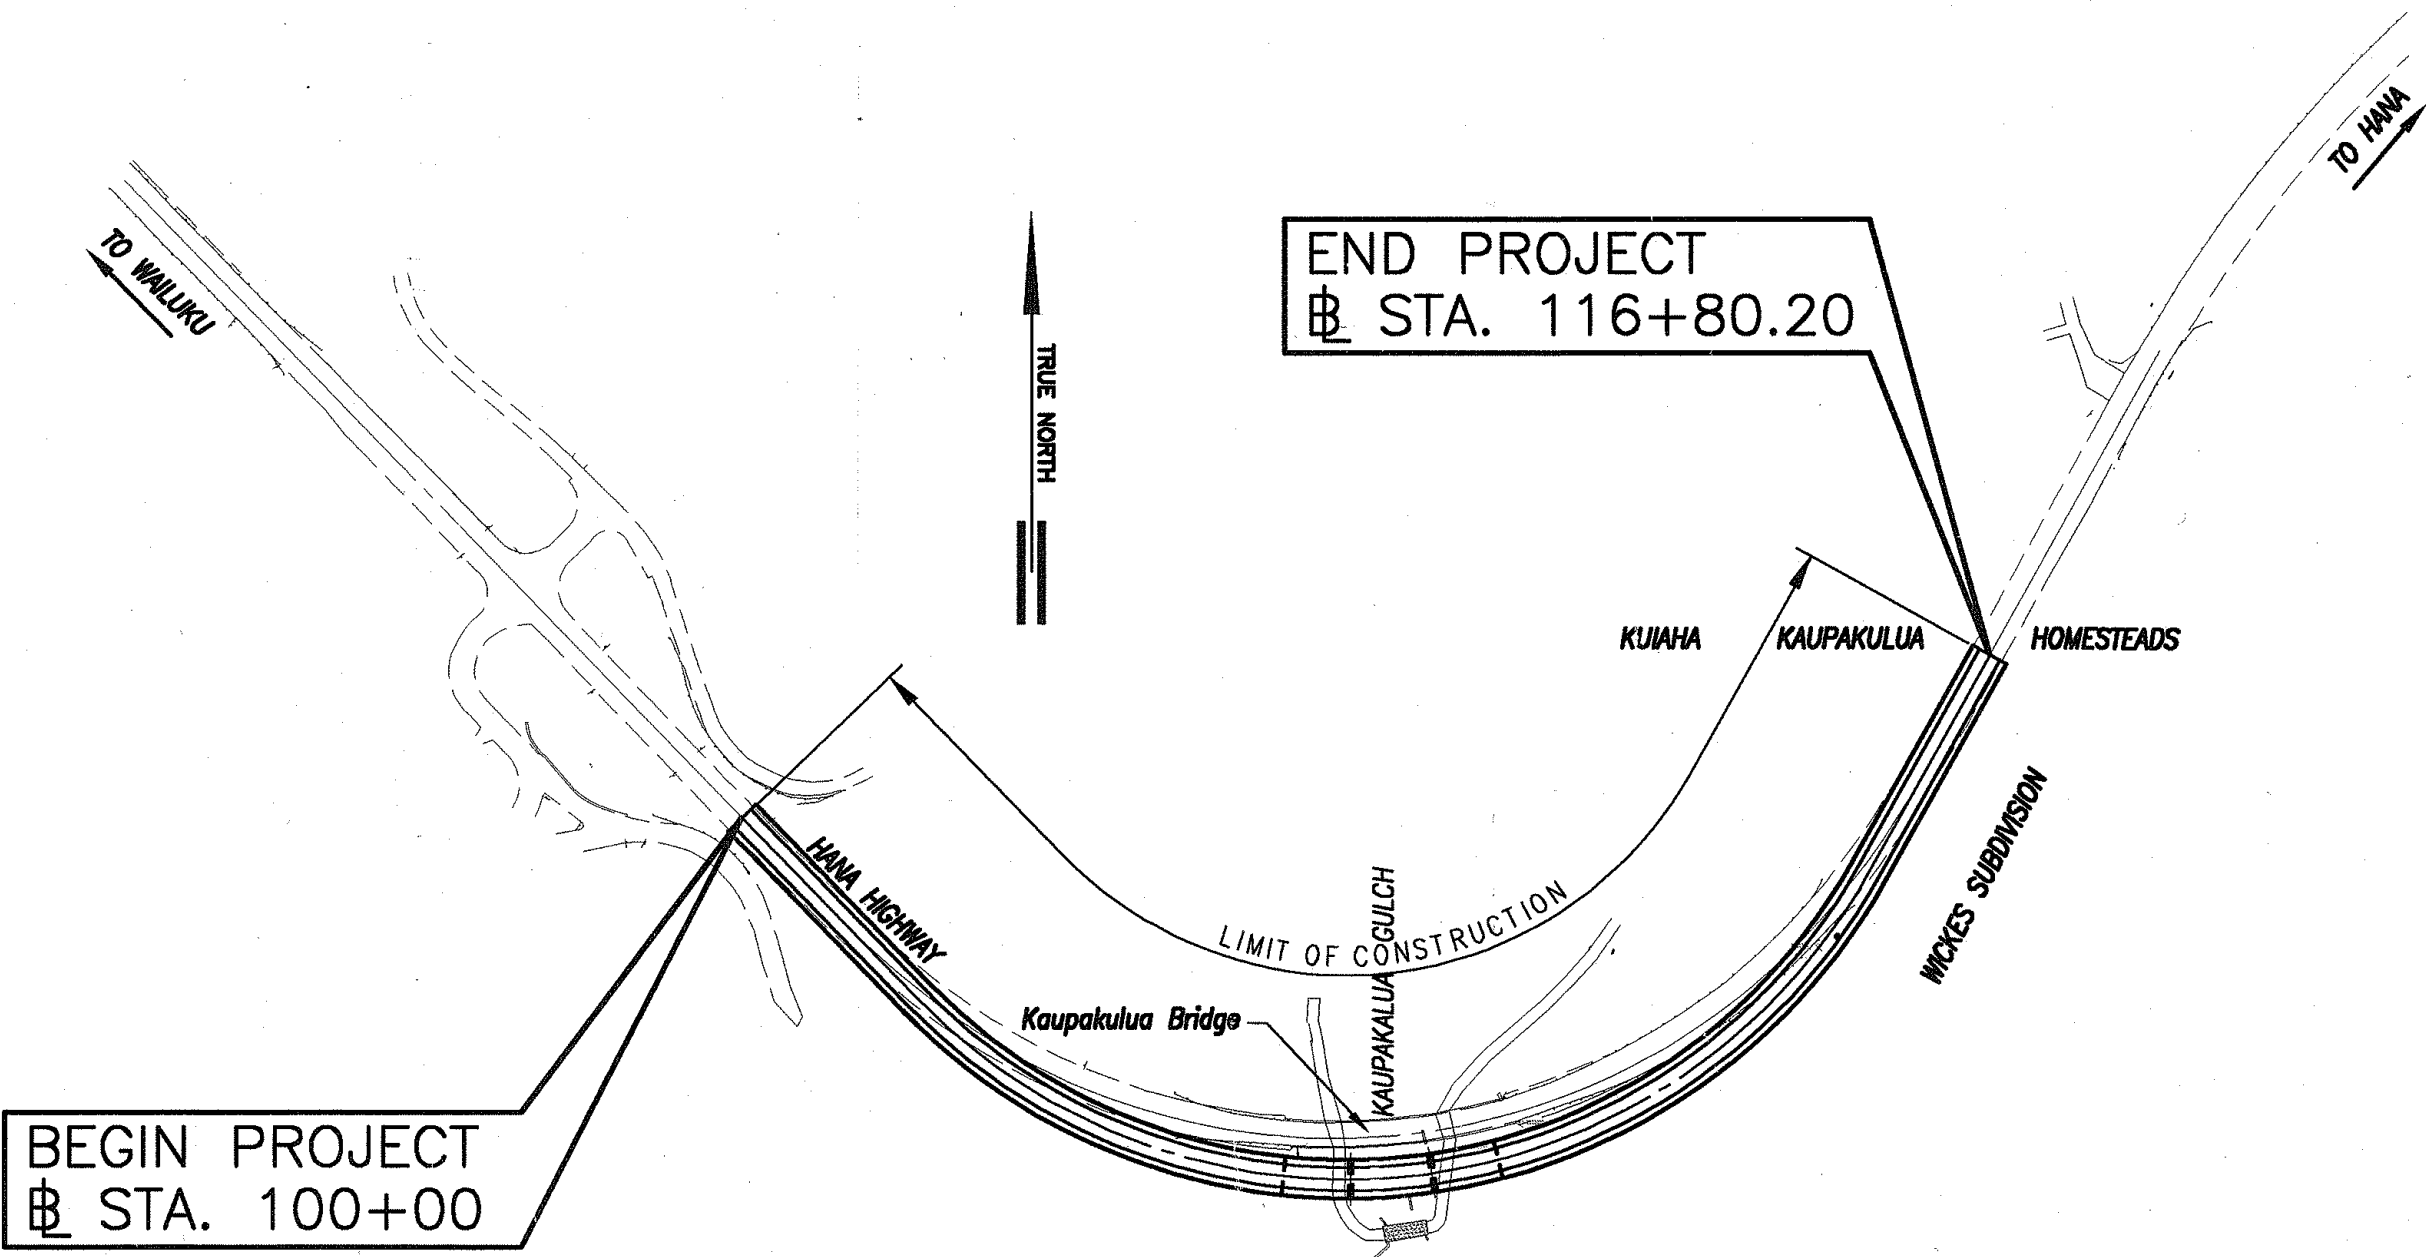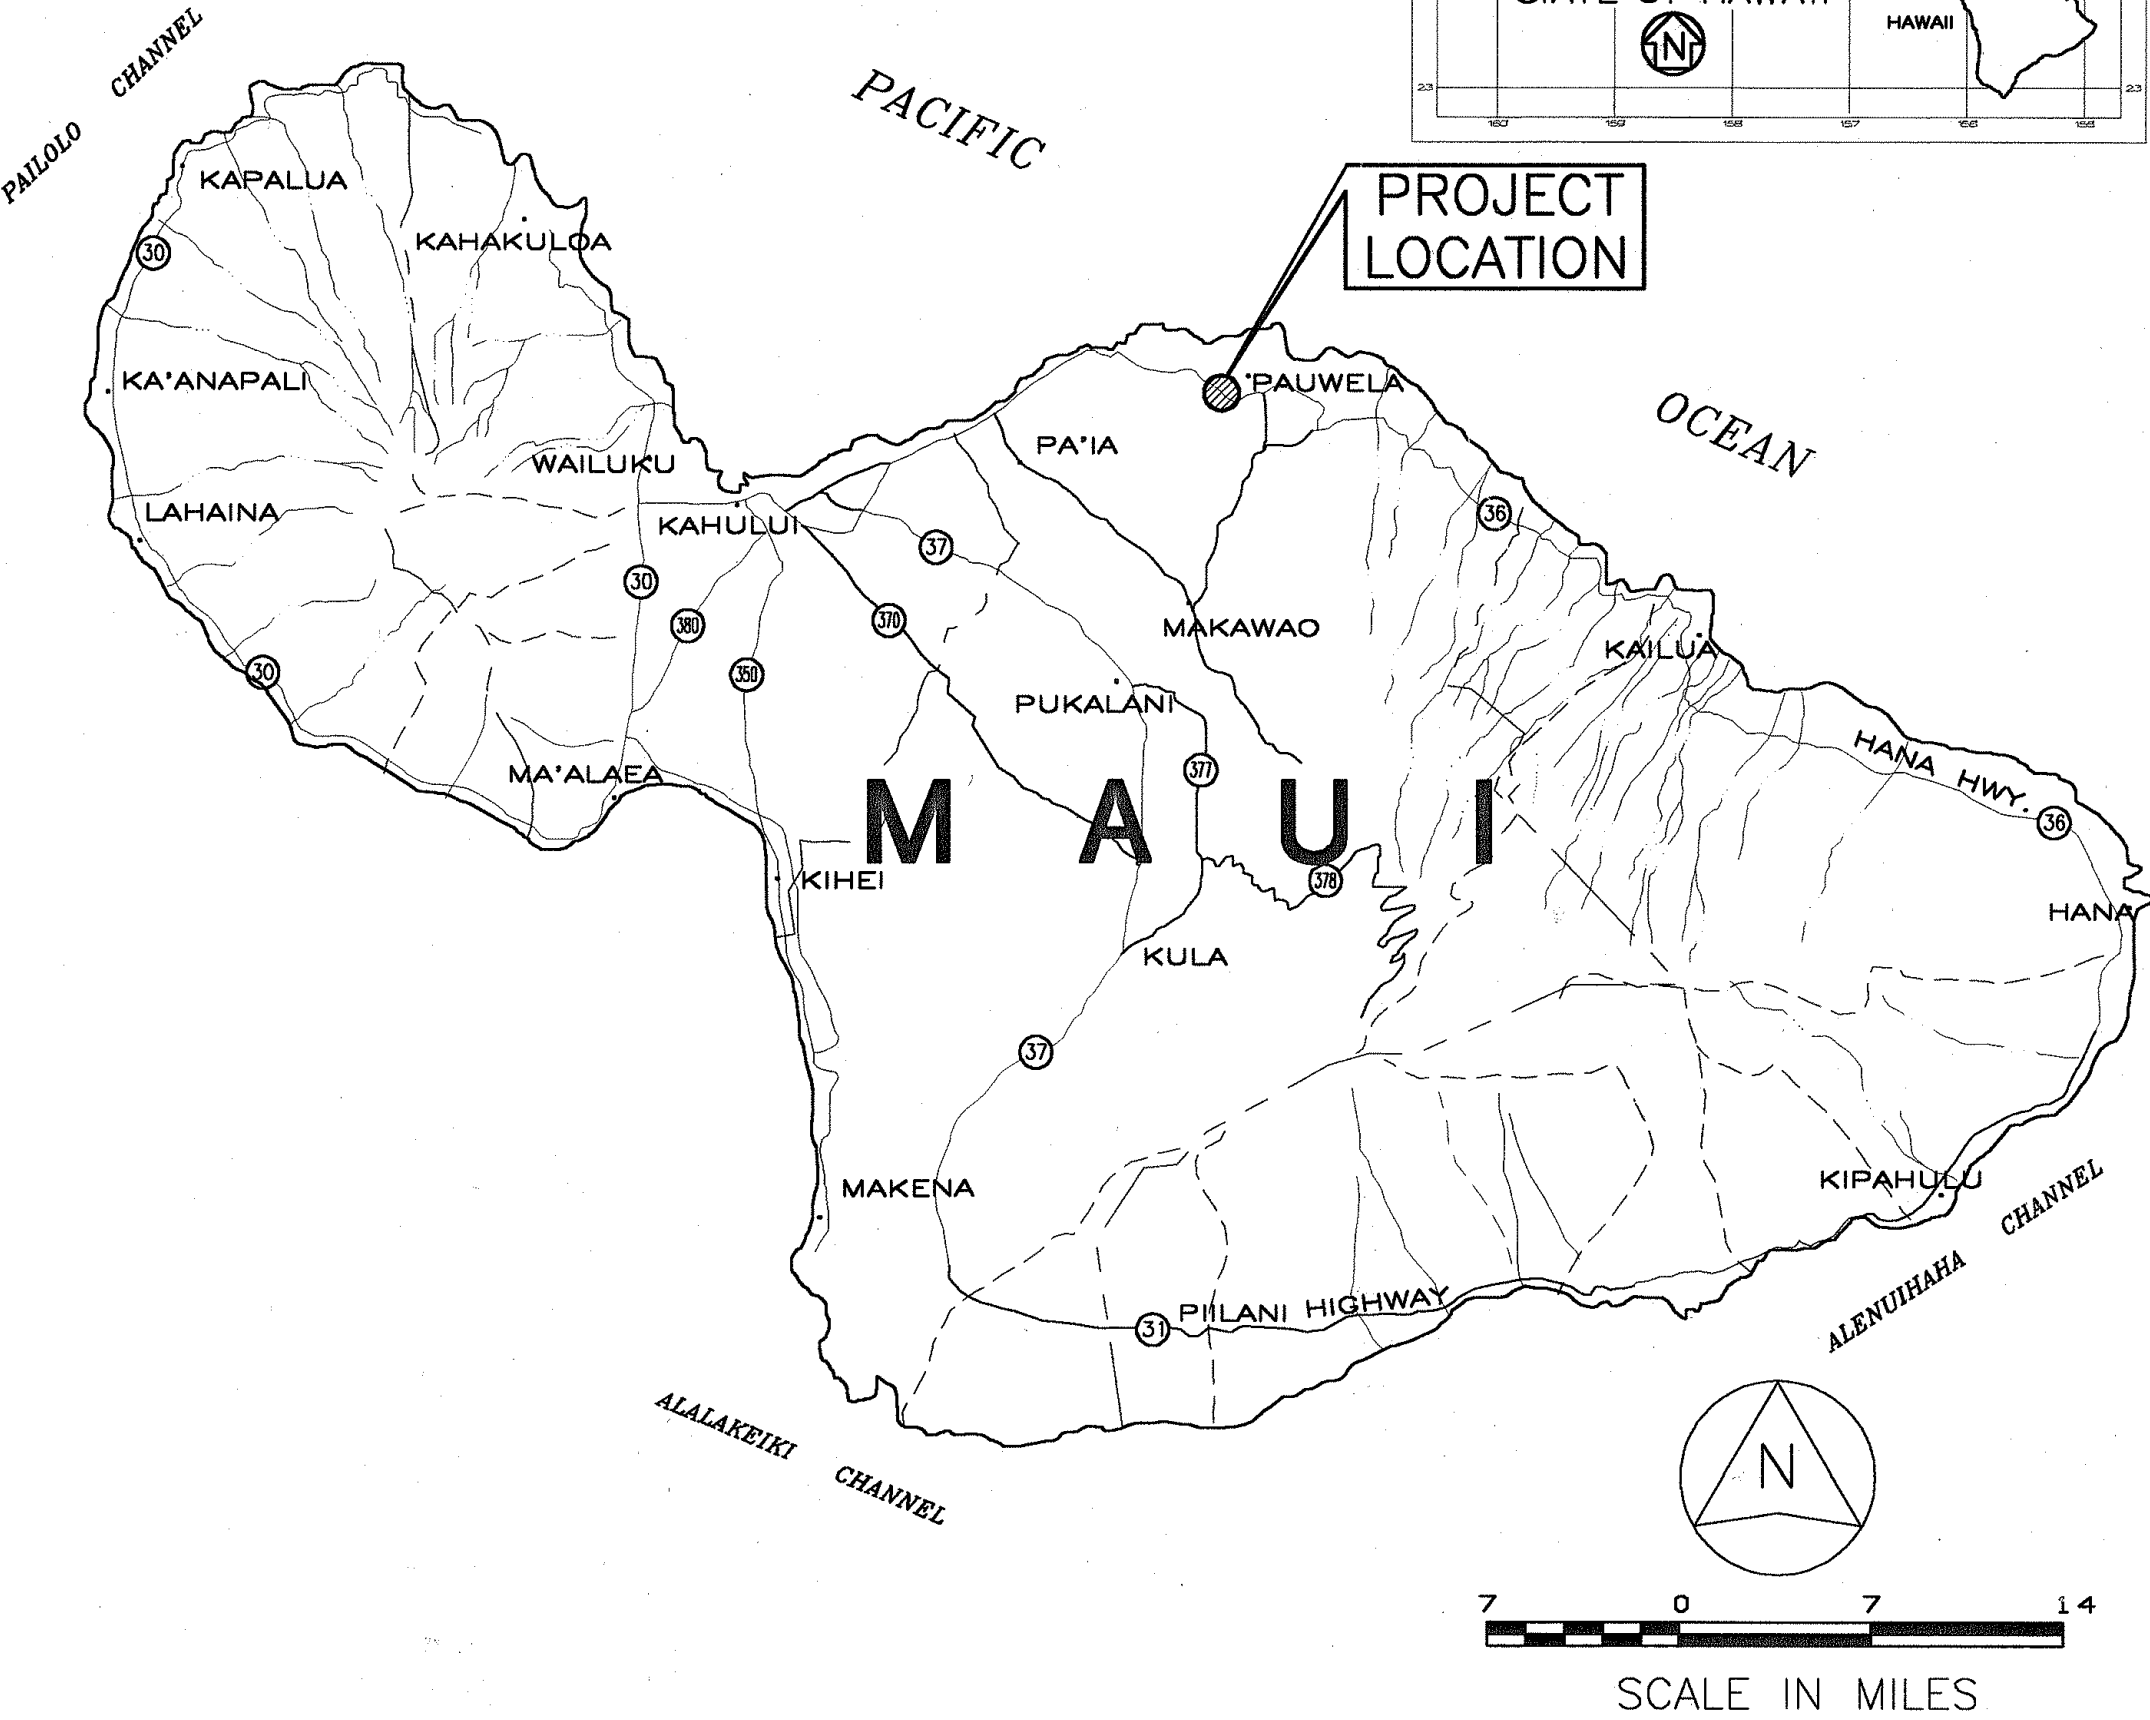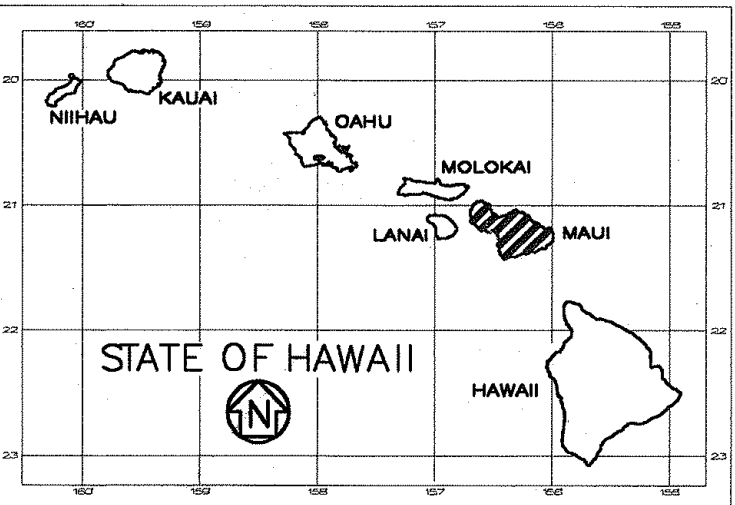

LOCATION PLAN
SCALE: 1" = 200'
LENGTH OF PROJECT = 0.32 MI.

CHANGES MADE DURING CONSTRUCTION HAVE BEEN INCORPORATED ON THESE PLANS EXCEPT CHANGES IN THE ORIGINAL THEORETICAL QUANTITIES. FOR ACTUAL QUANTITIES, REFER TO PROJECT LEDGER AND/OR COMPUTATION BOOK.
Charles M. Brown 6/29/09
RESIDENT ENGINEER DATE

FEDERAL AID INTERSTATE PROJECTS PREVIOUSLY CONSTRUCTED OR UNDER CONSTRUCTION

MILE POST 13.497 TO MILE POST 13.815

DESIGN DESIGNATION

ADT (1997)	5,500
ADT (2017)	7,280
DHV	600
D	70/30
T	1.5
T ₂₄	1.5
V	40 mph

DEPARTMENT OF TRANSPORTATION
STATE OF HAWAII

APPROVED:
Glenn M. Brown 8-15-00
DIR. OF TRANSPORTATION DATE

R.M. TOWILL CORPORATION
DESIGNED BY
EMILIO BARRIGA, JR.
P. S. & E. BY
692-7546
6/30/00
DATE