


FED. ROAD DIST. NO.	STATE	FED. AID PROJ. NO.	FISCAL YEAR	SHEET NO.	TOTAL SHEETS
HAWAII	HAW.	NH-036-K(16)	2006	9	36

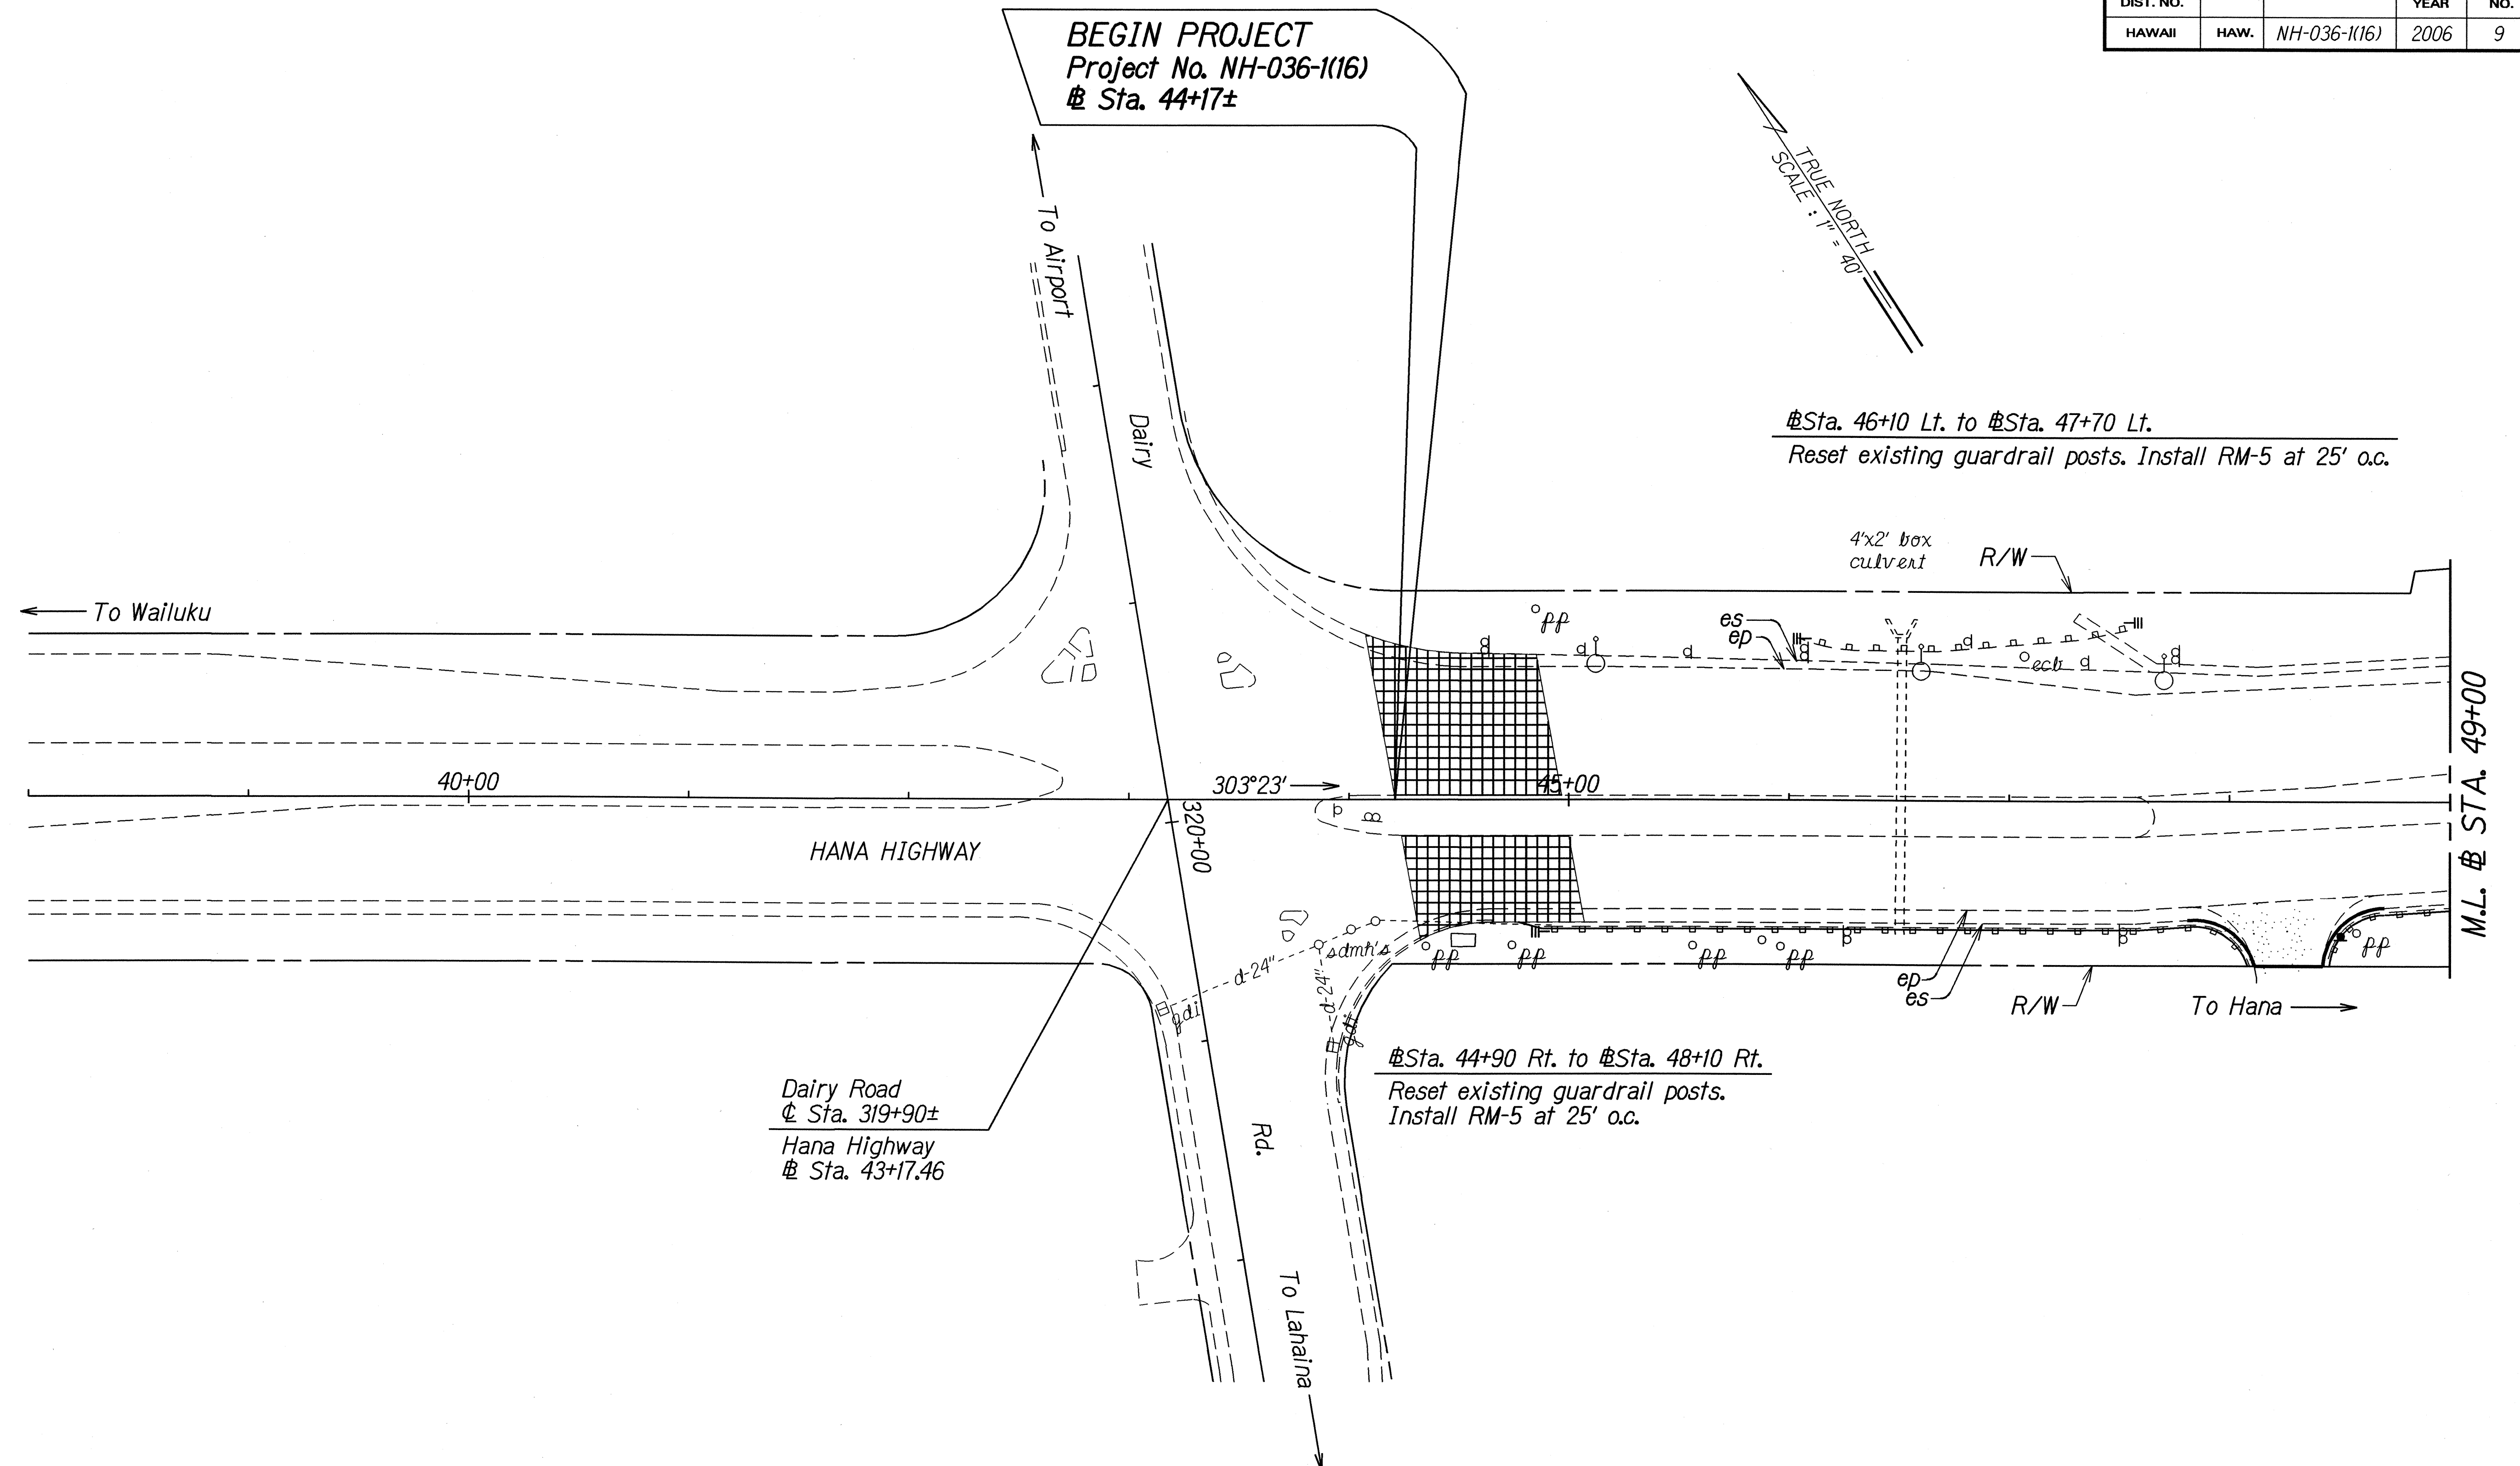

ORIGINAL PLAN	SURVEY PLOTTED BY _____	DATE _____
	DRAWN BY <i>jq</i>	<i>Aug. 1993</i>
	TRACED BY _____	•
	DESIGNED BY _____	•
	NOTE BOOK _____	•
	<i>log in: teddy</i>	•
	QUANTITIES BY _____	•
	CHECKED BY _____	•
	<i>42</i>	•
	<i>armplough</i>	•

STATE OF HAWAII
DEPARTMENT OF TRANSPORTATION
HIGHWAYS DIVISION


ROADWAY PLANS

HANA HIGHWAY RESURFACING
Dairy Road to Haleakala Highway
Project No. NH-036-1(16)

Scale: 1"=40' Date: Oct., 2005

SHEET No. 1 OF 7 SHEETS

FED. ROAD DIST. NO.	STATE	FED. AID PROJ. NO.	FISCAL YEAR	SHEET NO.	TOTAL SHEETS
HAWAII	HAW.	NH-036-1(16)	2006	10	36

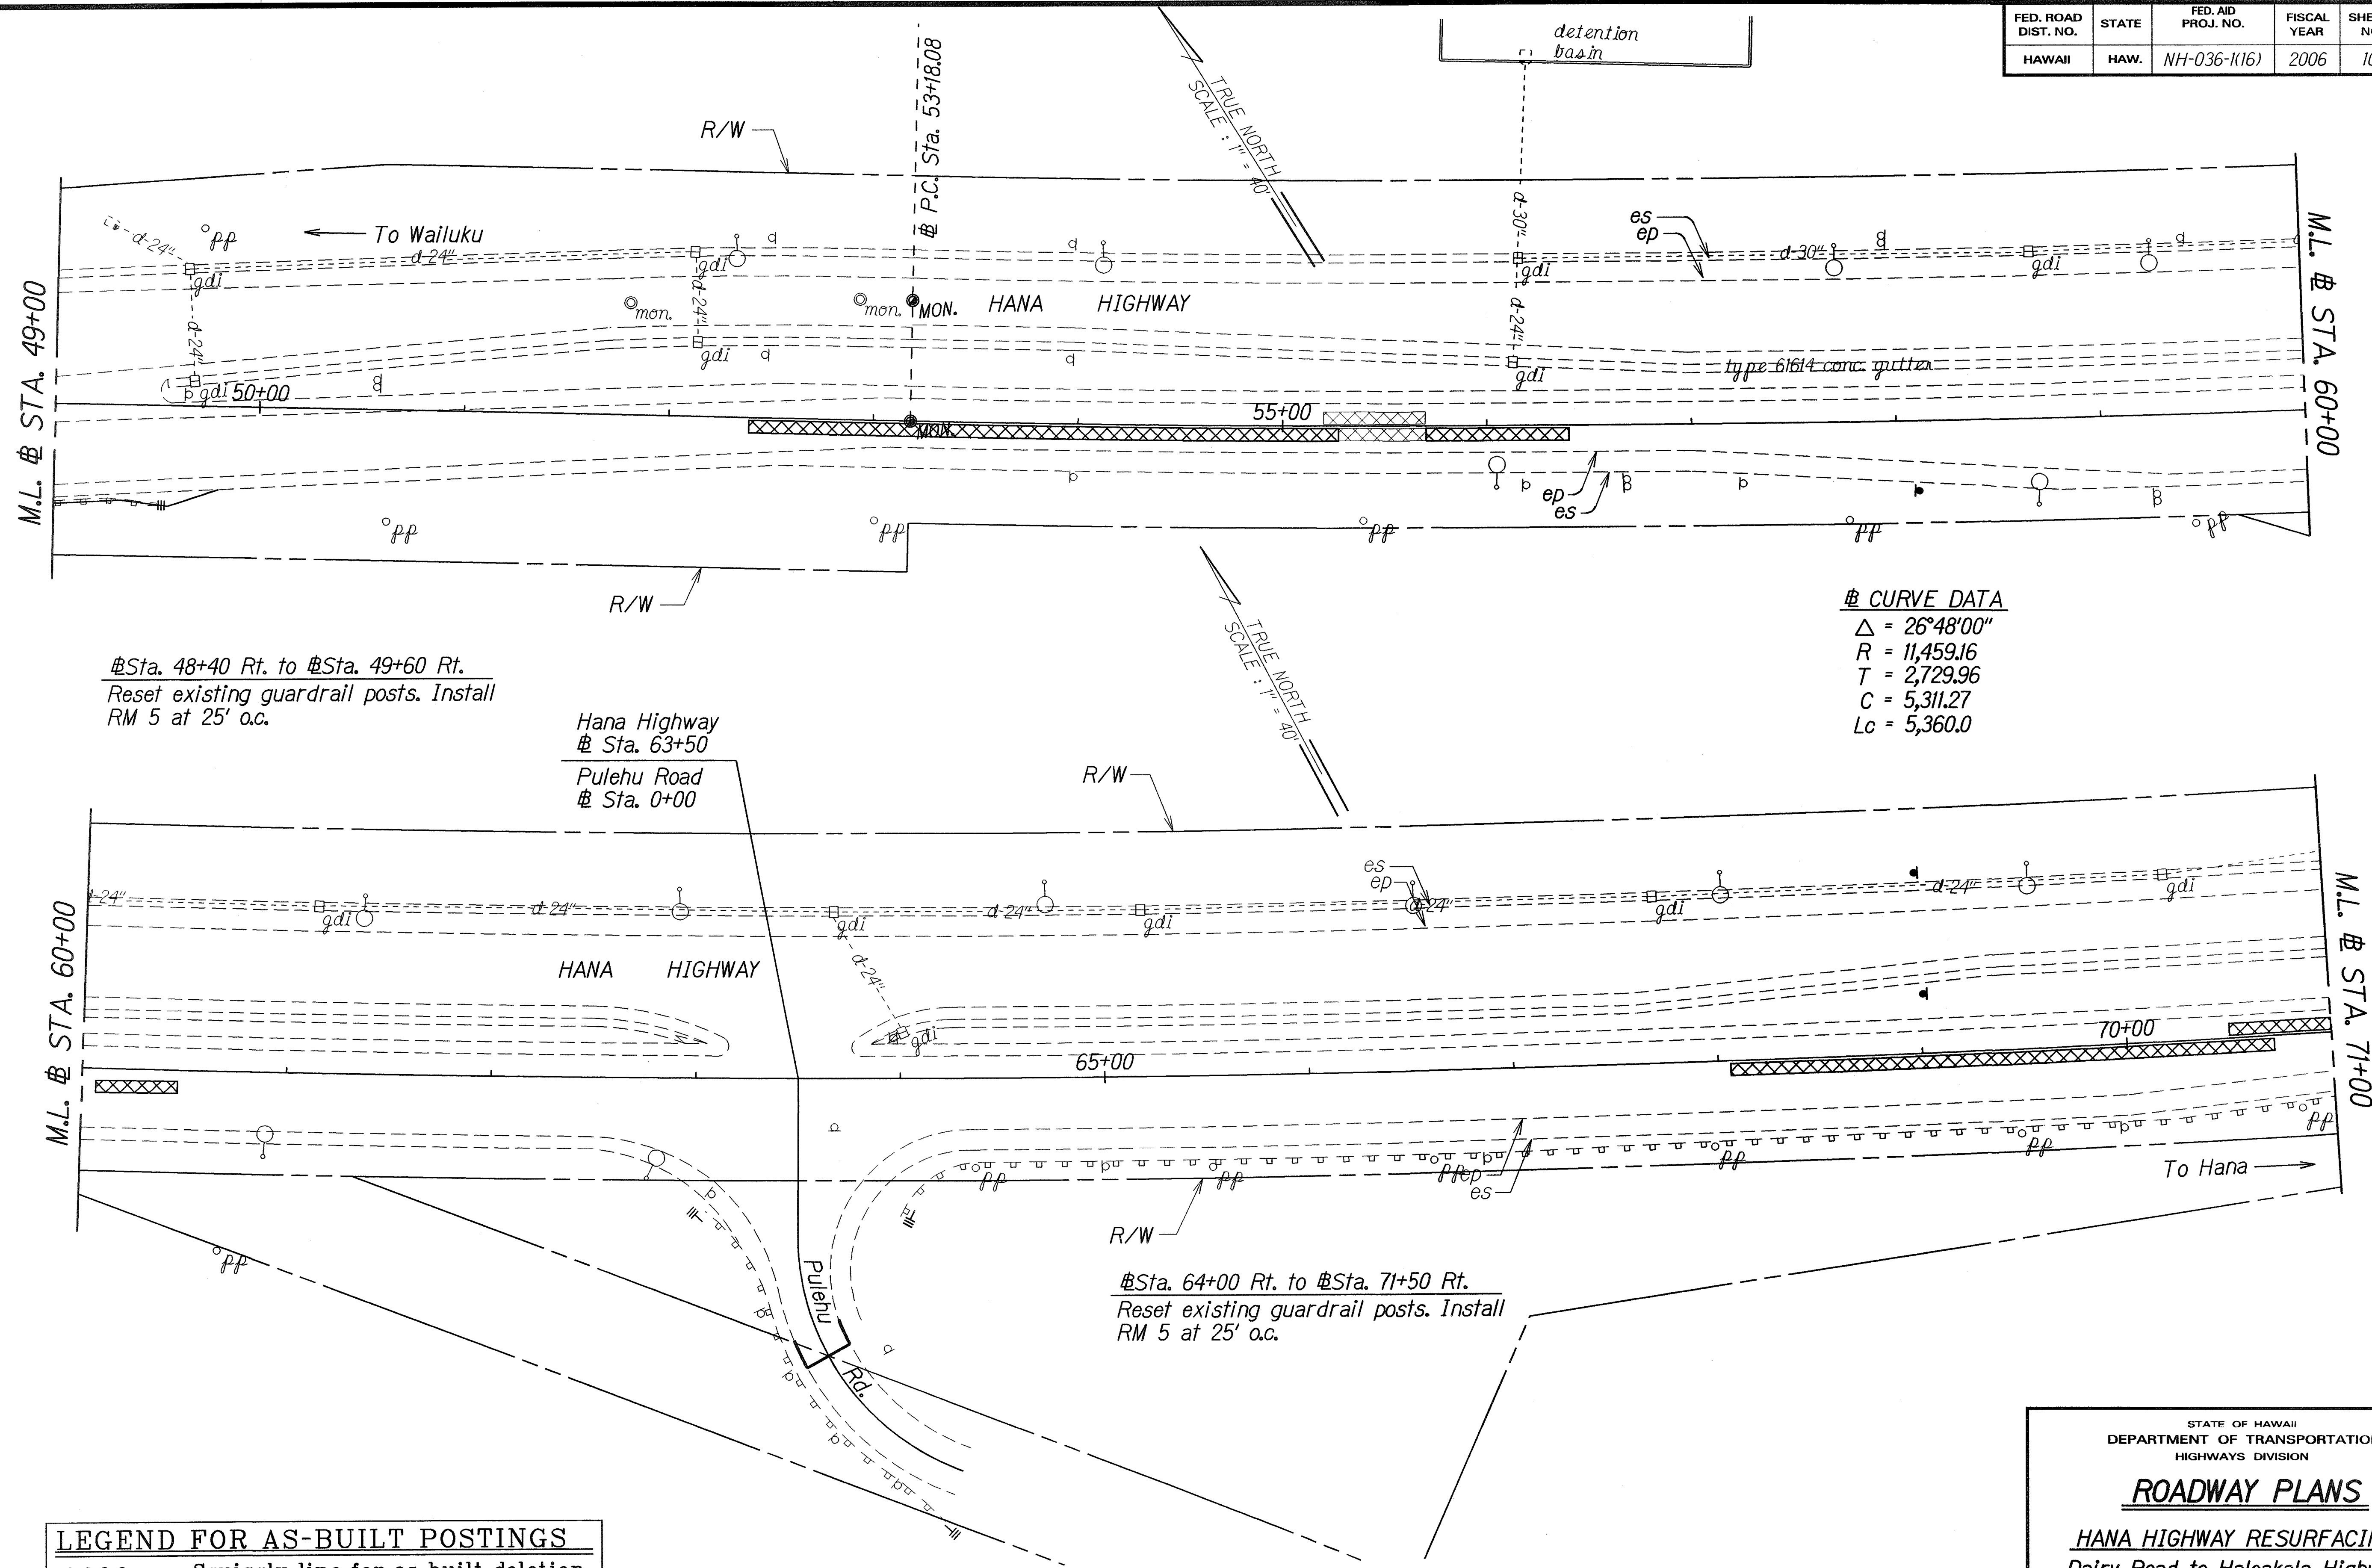

CURVE DATA
 $\Delta = 26^\circ 48' 00''$
 $R = 11,459.16$
 $T = 2,729.96$
 $C = 5,311.27$
 $L_c = 5,360.0$

LEGEND FOR AS-BUILT POSTINGS	
	Squiggly line for as-built deletion
	Double line for as-built deletion
Roadway	Text for as-built posting

STATE OF HAWAII
DEPARTMENT OF TRANSPORTATION
HIGHWAYS DIVISION

ROADWAY PLANS

HANA HIGHWAY RESURFACING
Dairy Road to Haleakala Highway
Project No. NH-036-1(16)


Scale: 1"=40' Date: Oct., 2005

SHEET No. 2 OF 7 SHEETS

"AS-BUILT"

ORIGINAL PLAN	SURVEY PLOTTED BY	DATE
NOTE BOOK	DRAWN BY	10/1/05
log/in field	DESIGNED BY	
QUANTITIES BY	CHECKED BY	
CHECKED BY		

FED. ROAD DIST. NO.	STATE	FED. AID PROJ. NO.	FISCAL YEAR	SHEET NO.	TOTAL SHEETS
HAWAII	HAW.	NH-036-1(16)	2006	11	36

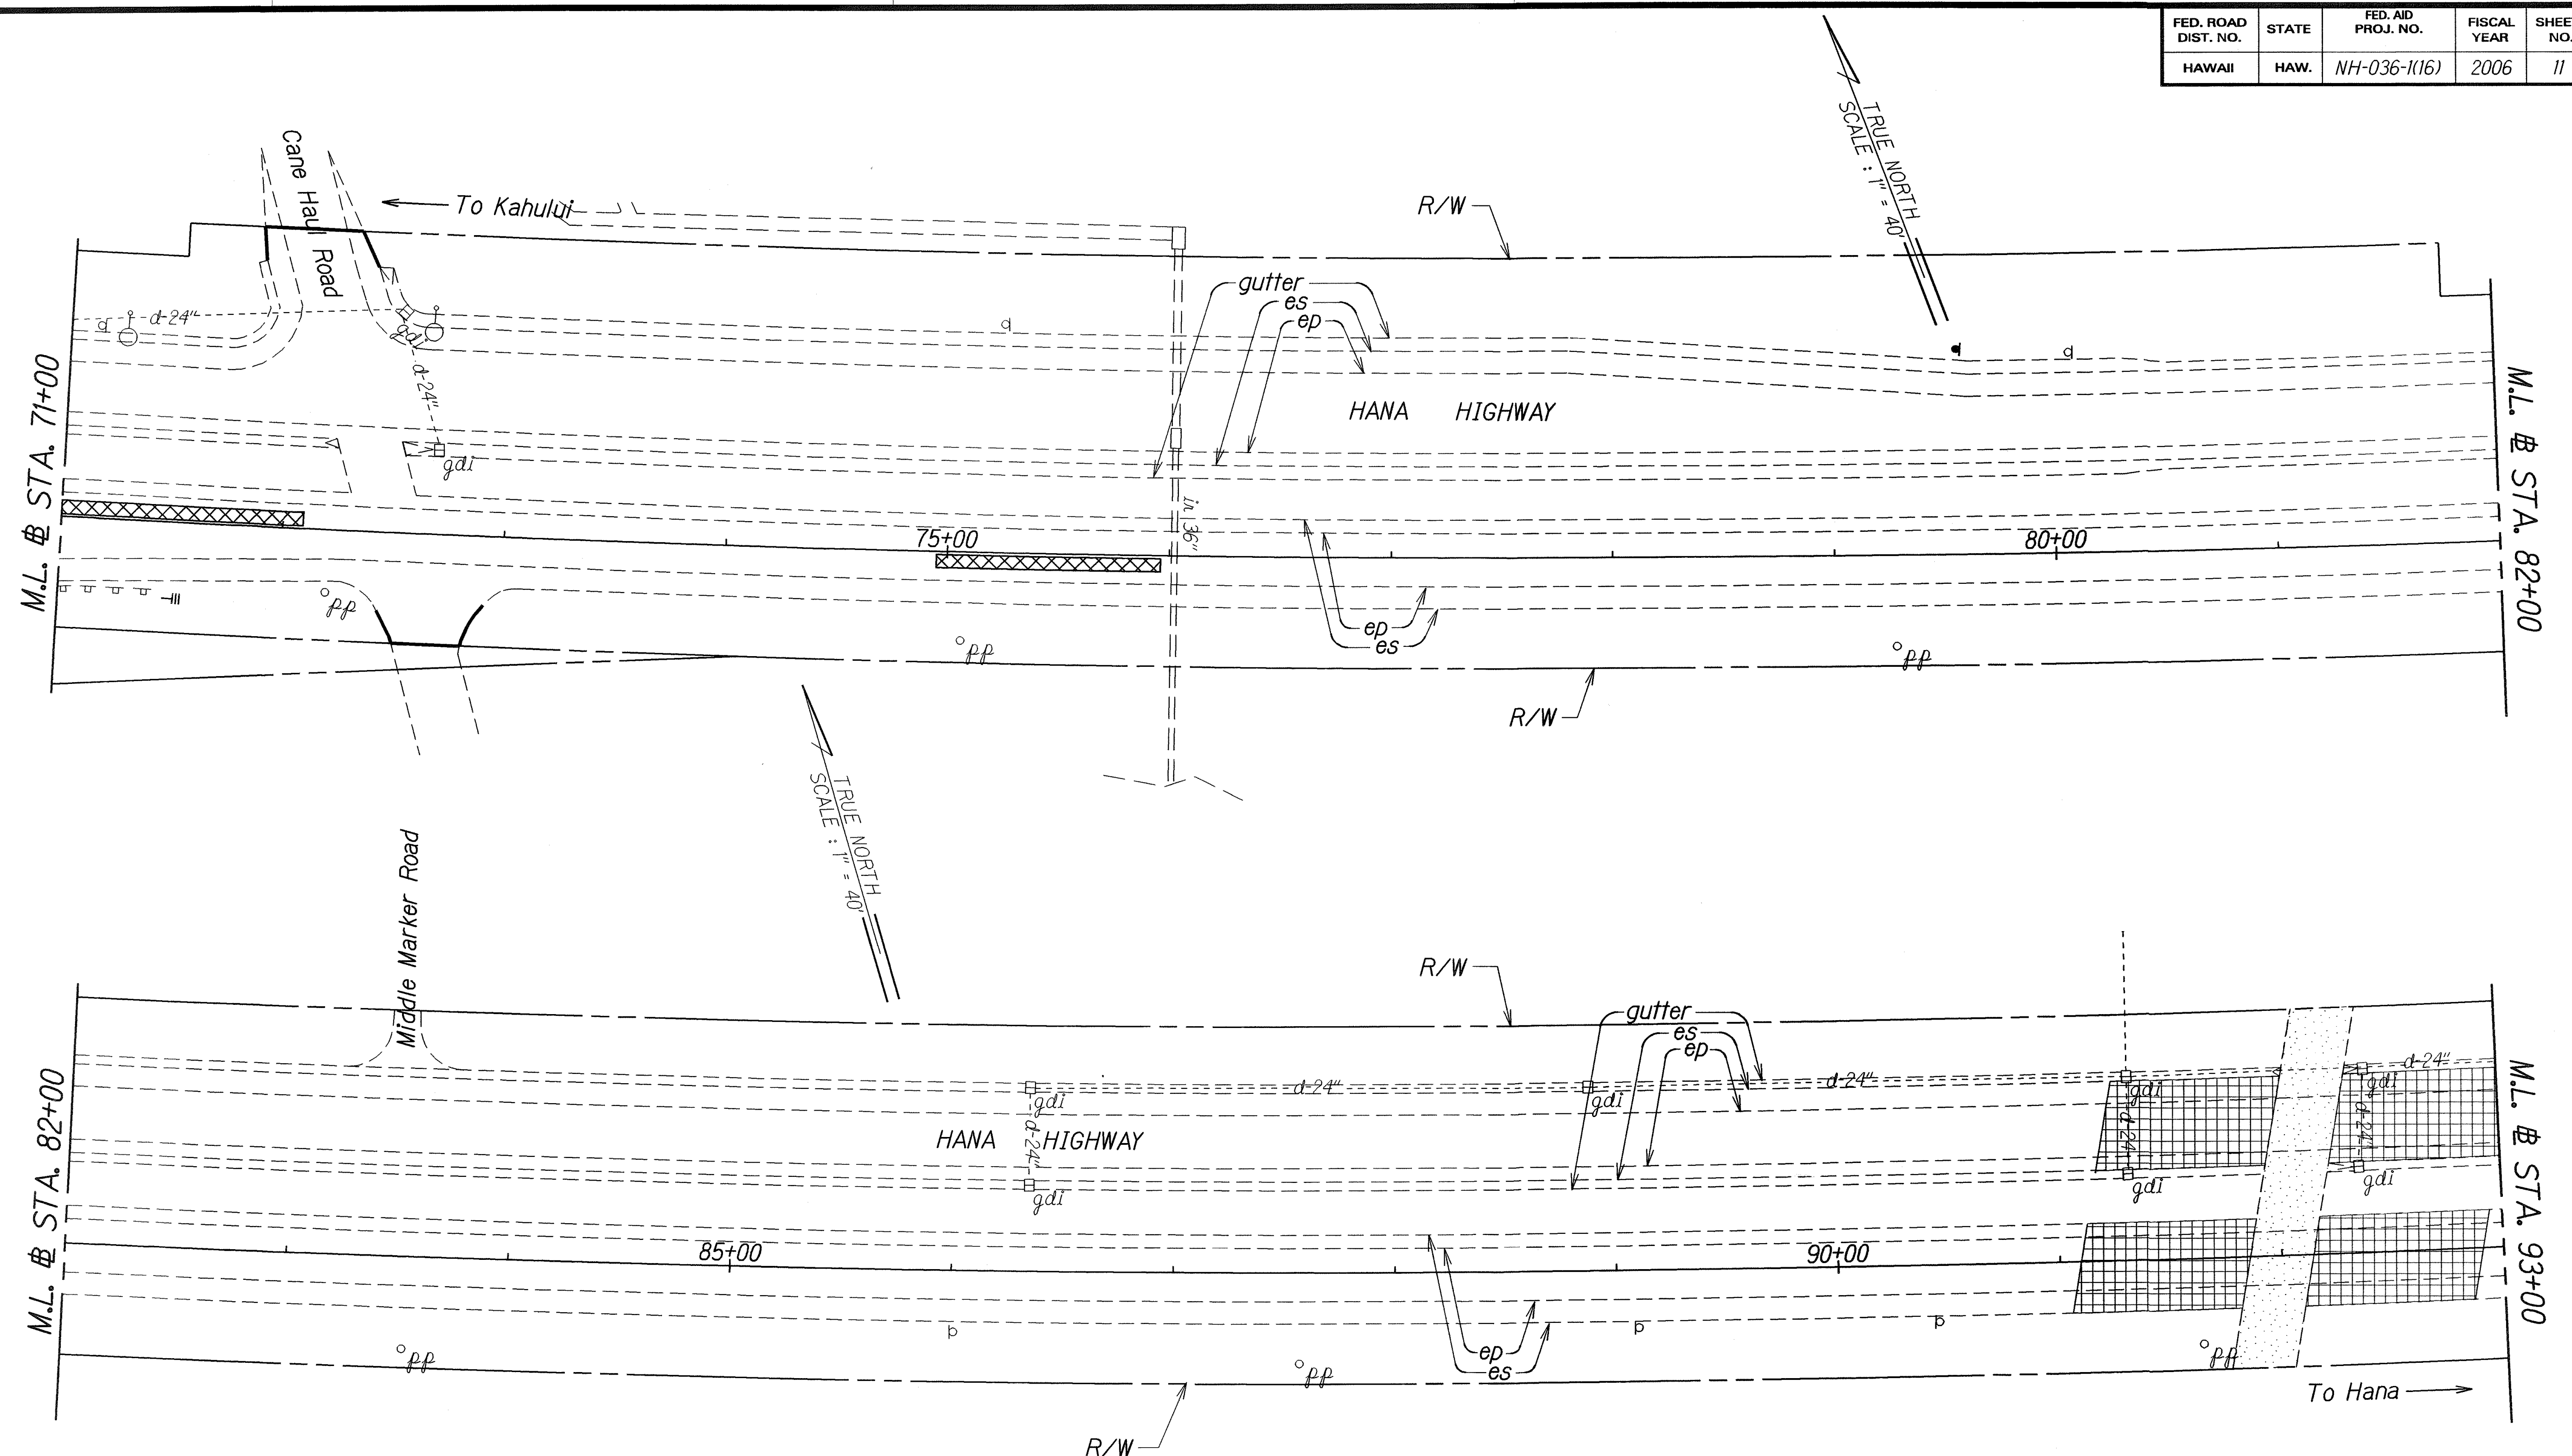

ORIGINAL PLAN	DATE	DESIGNED BY	CHECKED BY
NOTE BOOK	2/10/2006	DESIGNED BY	CHECKED BY
QUANTITIES BY		QUANTITIES BY	
CHECKED BY		CHECKED BY	

LEGEND FOR AS-BUILT POSTINGS	
	Squiggly line for as-built deletion
	Double line for as-built deletion
Roadway	Text for as-built posting

STATE OF HAWAII
DEPARTMENT OF TRANSPORTATION
HIGHWAYS DIVISION

ROADWAY PLANS


HANA HIGHWAY RESURFACING
Dairy Road to Haleakala Highway
Project No. NH-036-1(16)

Scale: 1"=40' Date: Oct., 2005

SHEET No. 3 OF 7 SHEETS

"AS-BUILT"

FED. ROAD DIST. NO.	STATE	FED. AID PROJ. NO.	FISCAL YEAR	SHEET NO.	TOTAL SHEETS
HAWAII	HAW.	NH-036-1(16)	2000	12	36

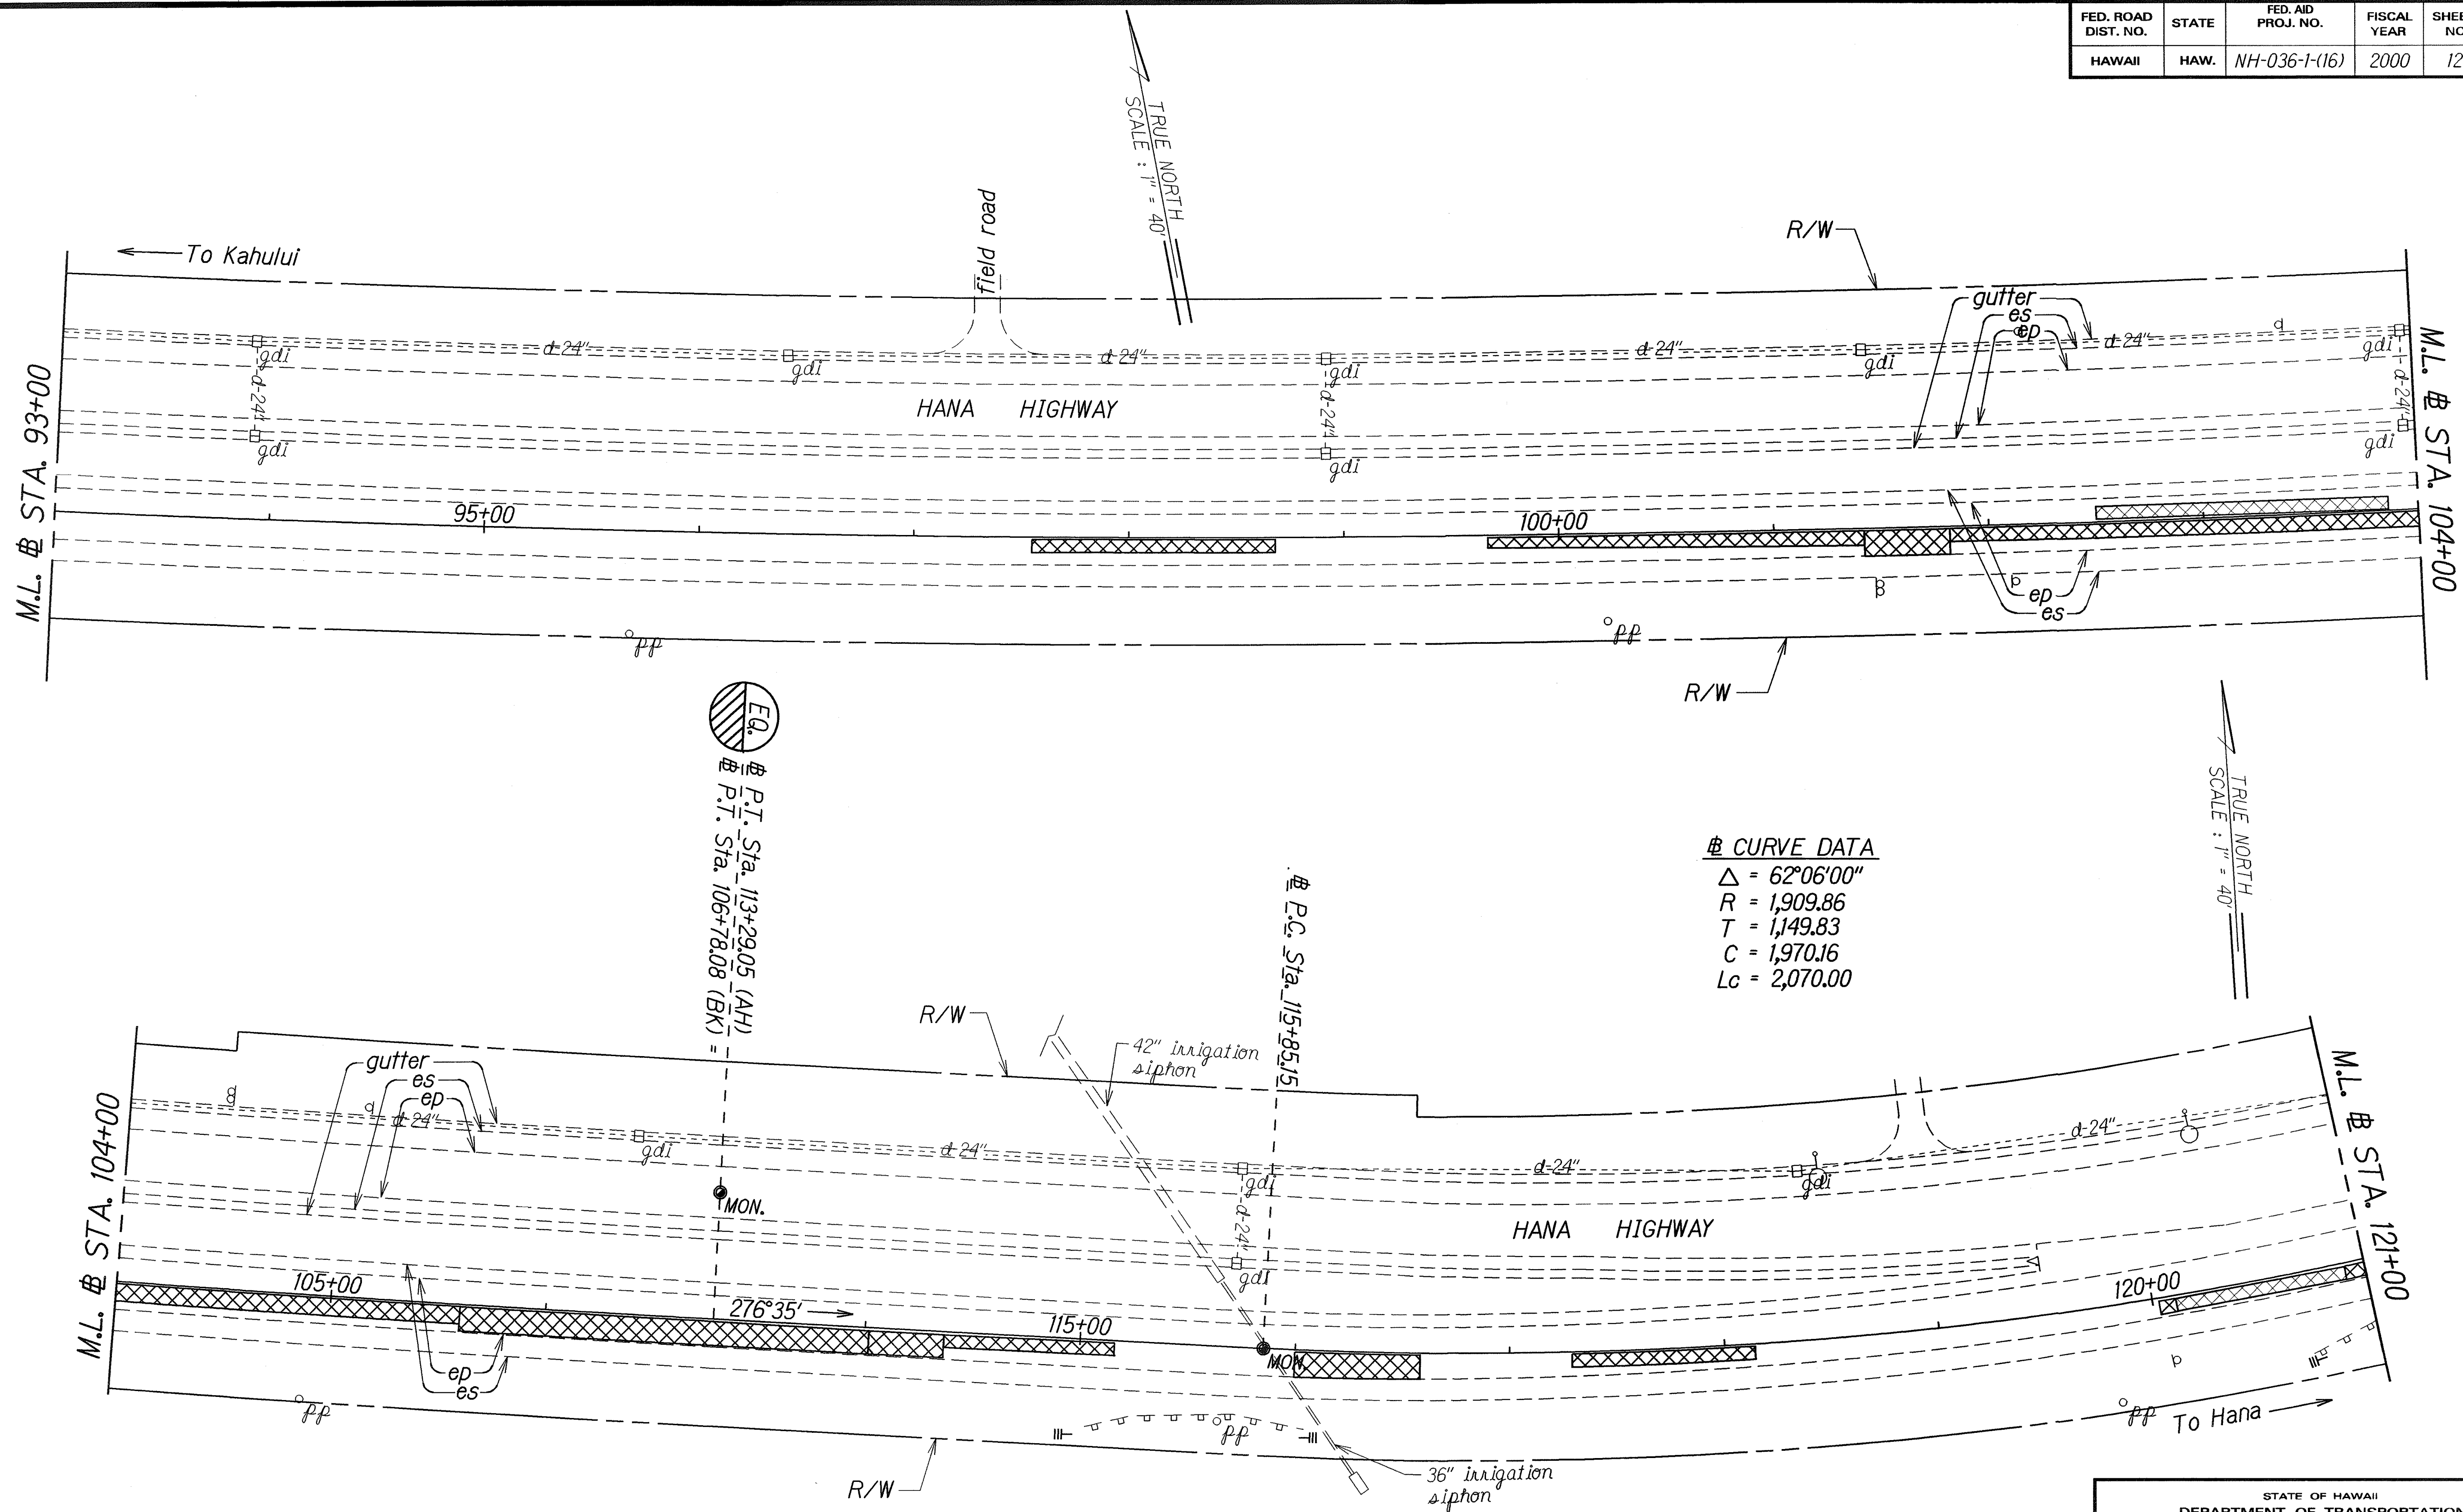

CURVE DATA
 $\Delta = 62^{\circ}06'00''$
 $R = 1,909.86$
 $T = 1,149.83$
 $C = 1,970.16$
 $L_c = 2,070.00$

LEGEND FOR AS-BUILT POSTINGS	
	Squiggly line for as-built deletion
	Double line for as-built deletion
Roadway	Text for as-built posting

STATE OF HAWAII
DEPARTMENT OF TRANSPORTATION
HIGHWAYS DIVISION

ROADWAY PLANS

HANA HIGHWAY RESURFACING
Dairy Road to Haleakala Highway
Project No. NH-036-1(16)


Scale: 1"=40' Date: Oct., 2005

SHEET No. 4 OF 7 SHEETS

DATE	10/10/05
DESIGNED BY	Jim
TRACED BY	Jim
QUANTITIES BY	Jim
CHECKED BY	Jim

"AS-BUILT"

FED. ROAD DIST. NO.	STATE	FED. AID PROJ. NO.	FISCAL YEAR	SHEET NO.	TOTAL SHEETS
HAWAII	HAW.	NH-036-1(16)	2006	13	36

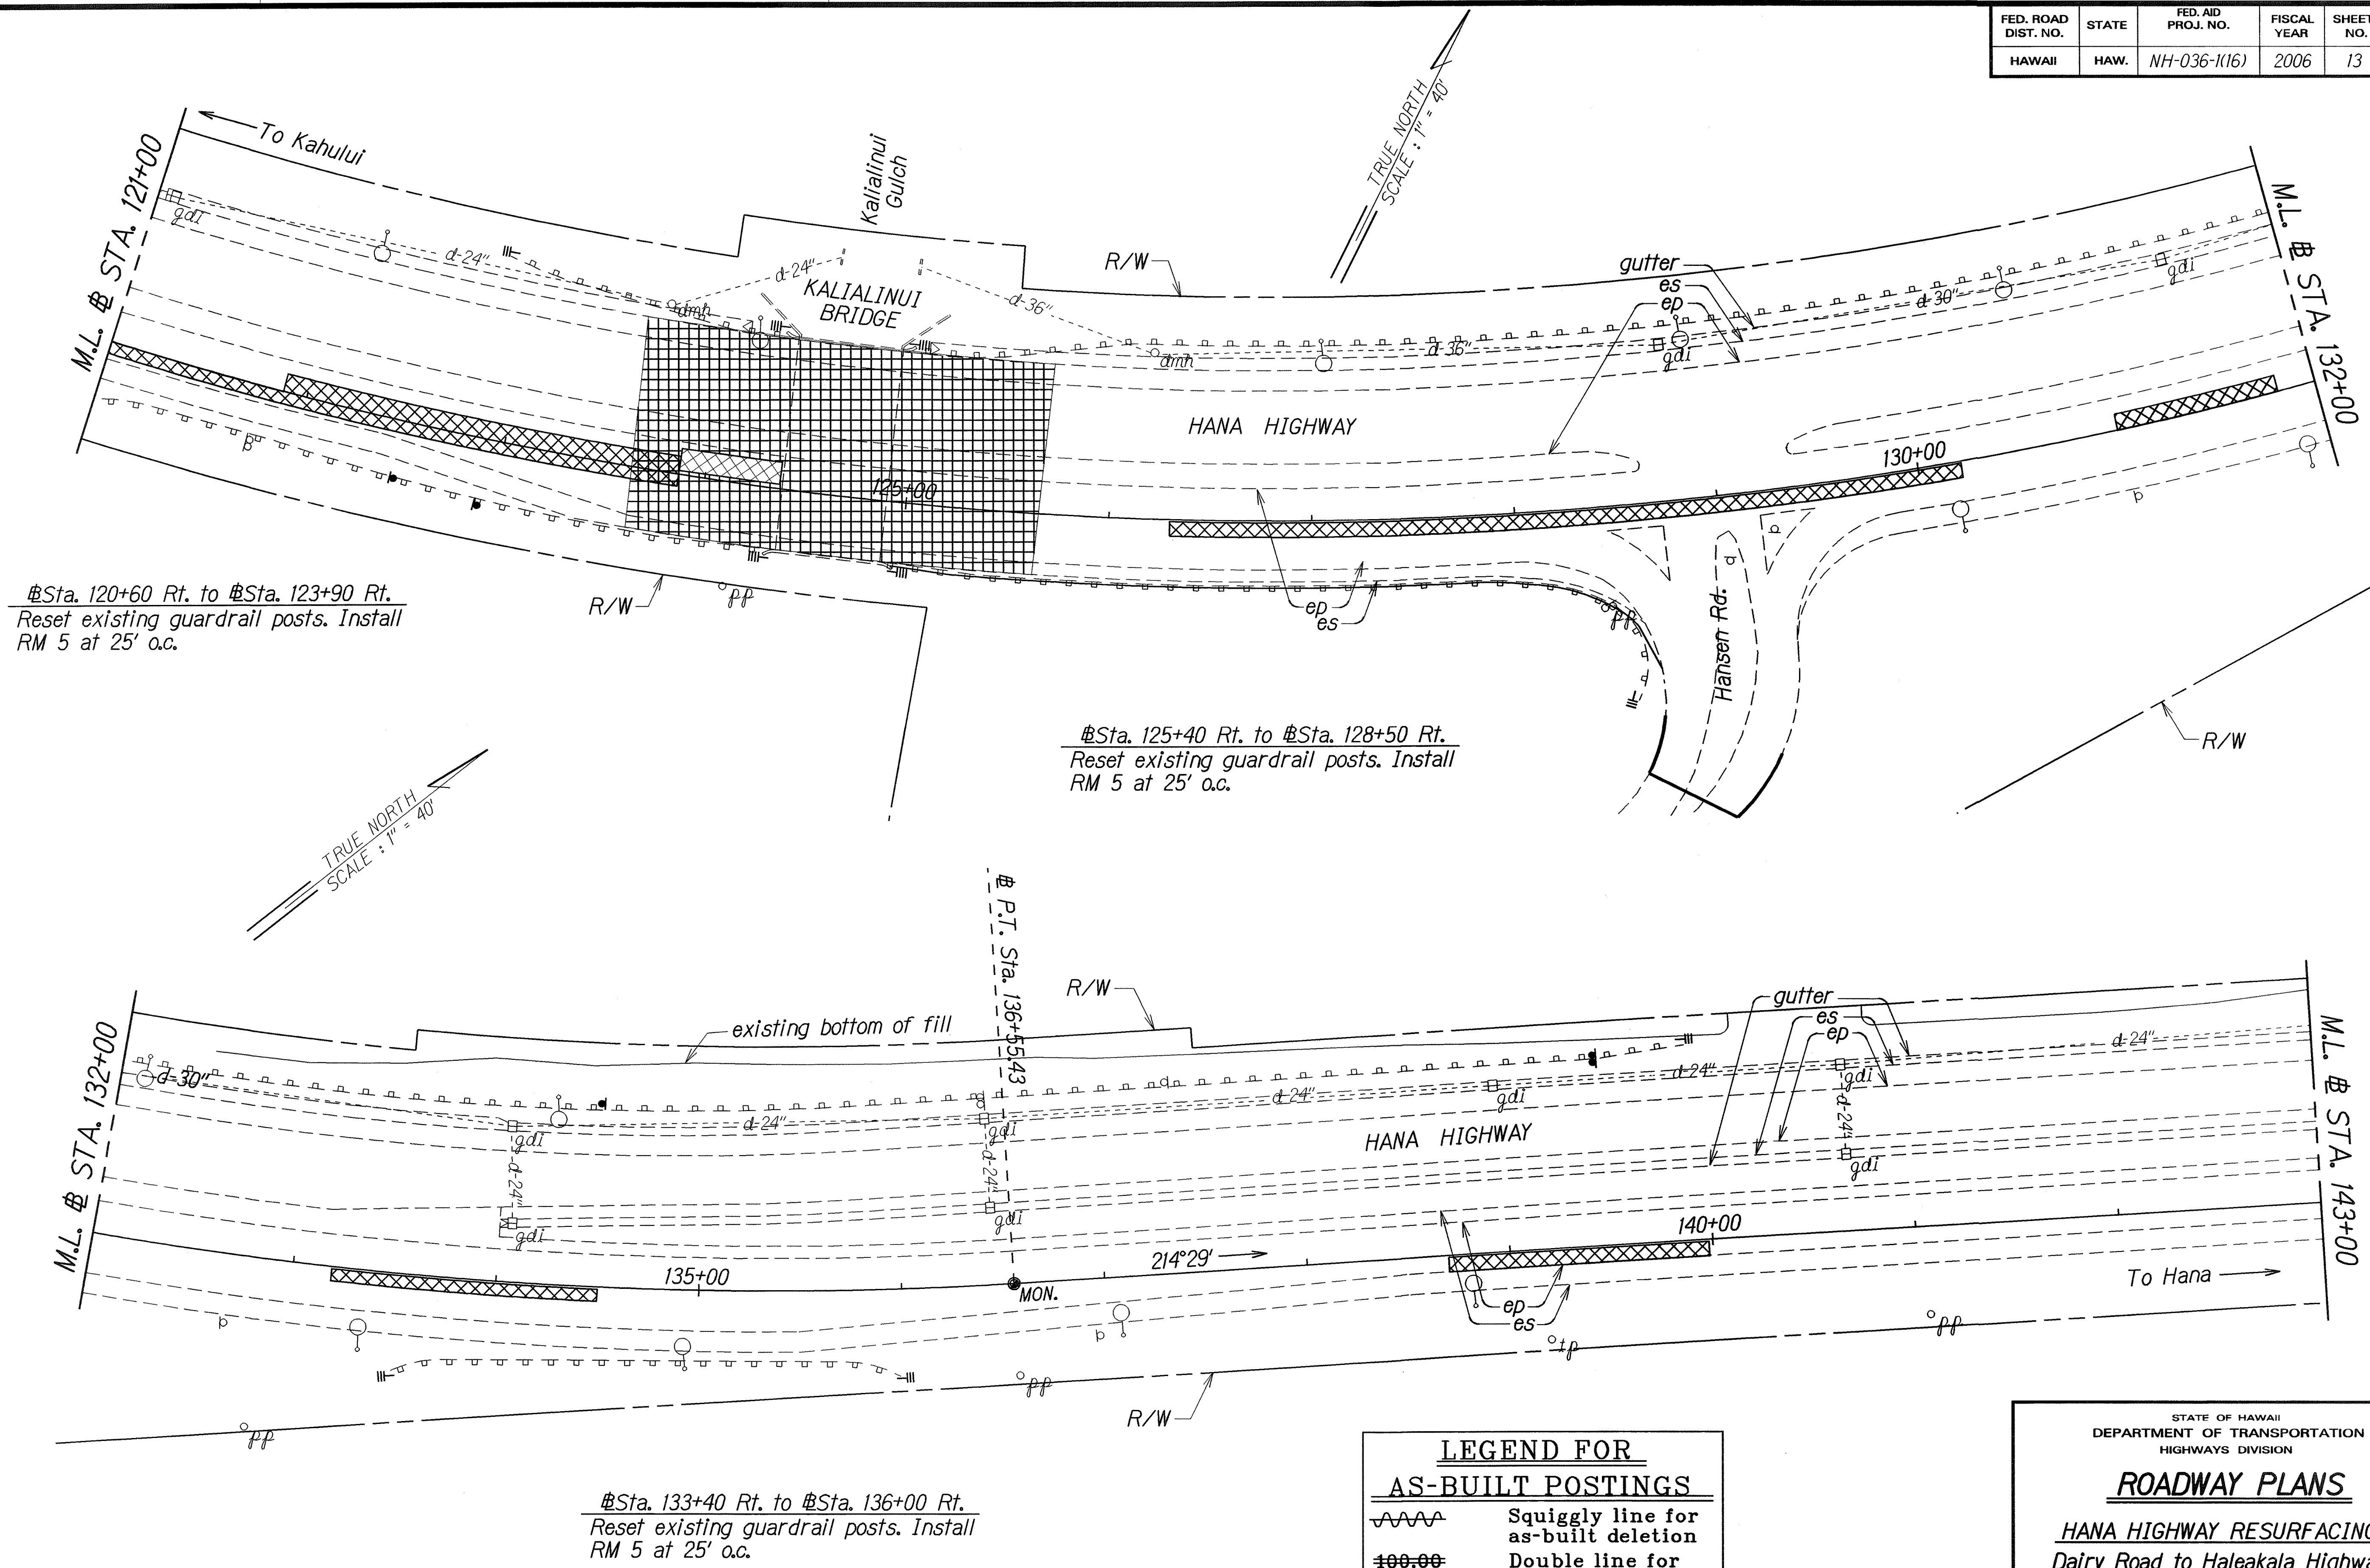

ORIGINAL PLAN	DATE
DESIGNED BY	10/06/2005
QUANTITIES BY	10/06/2005
CHECKED BY	10/06/2005

LEGEND FOR AS-BUILT POSTINGS	
	Squiggly line for as-built deletion
	Double line for as-built deletion
Roadway	Text for as-built posting

STATE OF HAWAII
DEPARTMENT OF TRANSPORTATION
HIGHWAYS DIVISION

ROADWAY PLANS


HANA HIGHWAY RESURFACING
Dairy Road to Haleakala Highway
Project No. NH-036-1(16)

Scale: 1"=40' Date: Oct., 2005


SHEET No. 5 OF 7 SHEETS

"AS-BUILT"

FED. ROAD DIST. NO.	STATE	FED. AID PROJ. NO.	FISCAL YEAR	SHEET NO.	TOTAL SHEETS
HAWAII	HAW.	NH-036-1(16)	2006	14	36

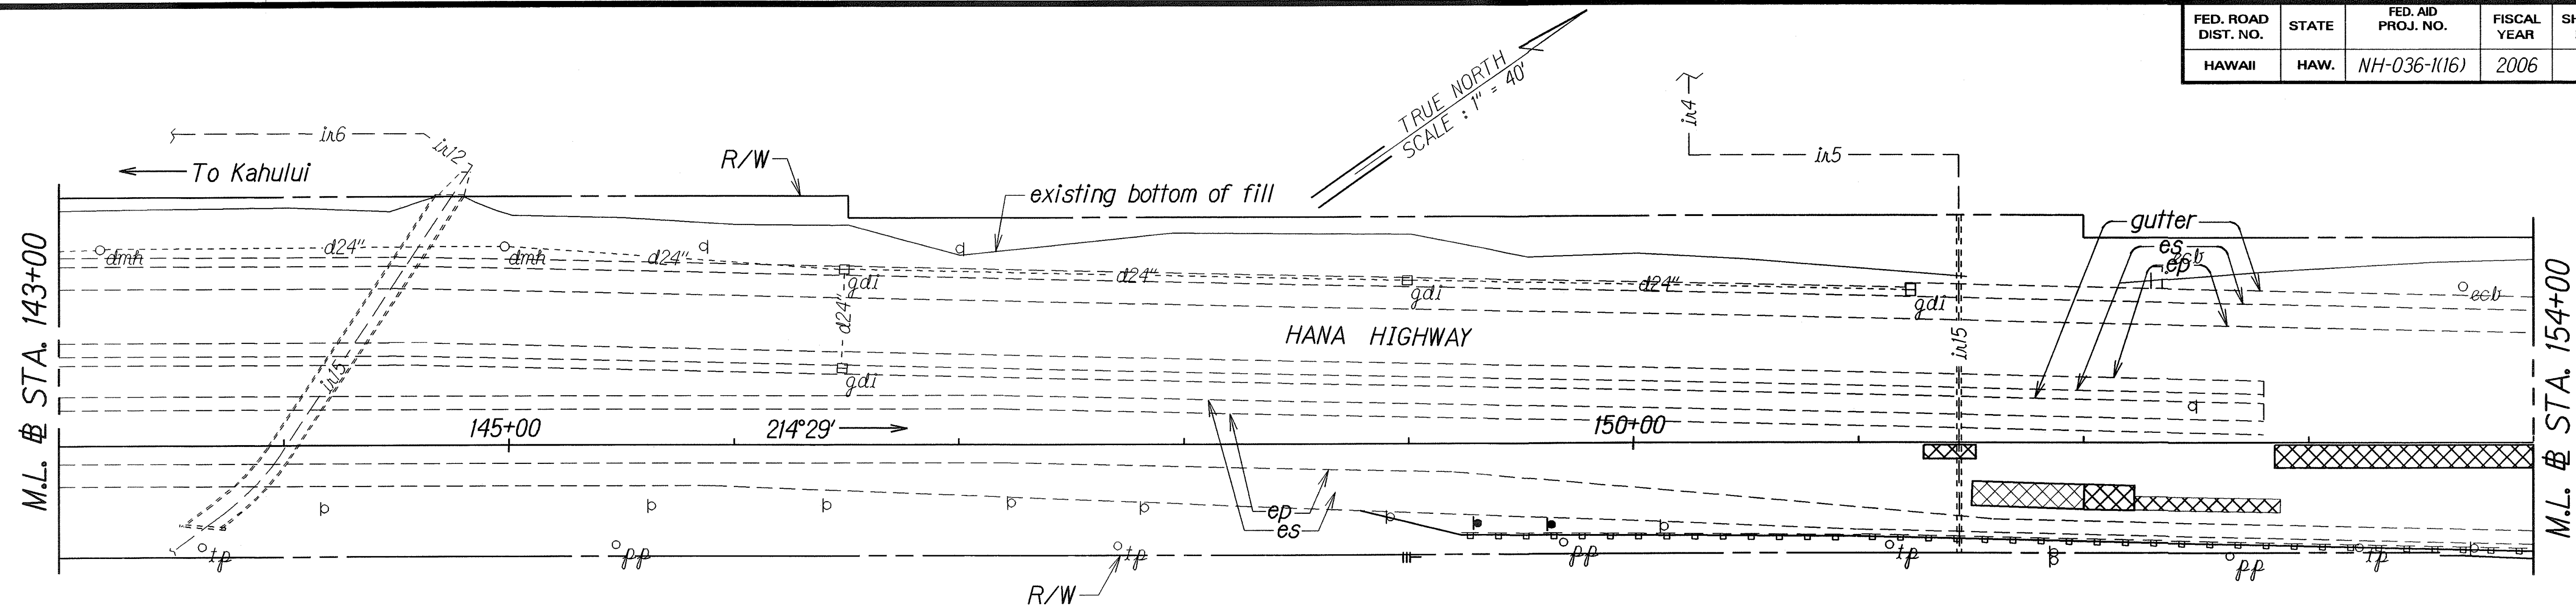

#Sta. 149+20 Rt. to #Sta. 155+80 Rt.
Reset existing guardrail post. Install
RM 5 at 25' o.c.

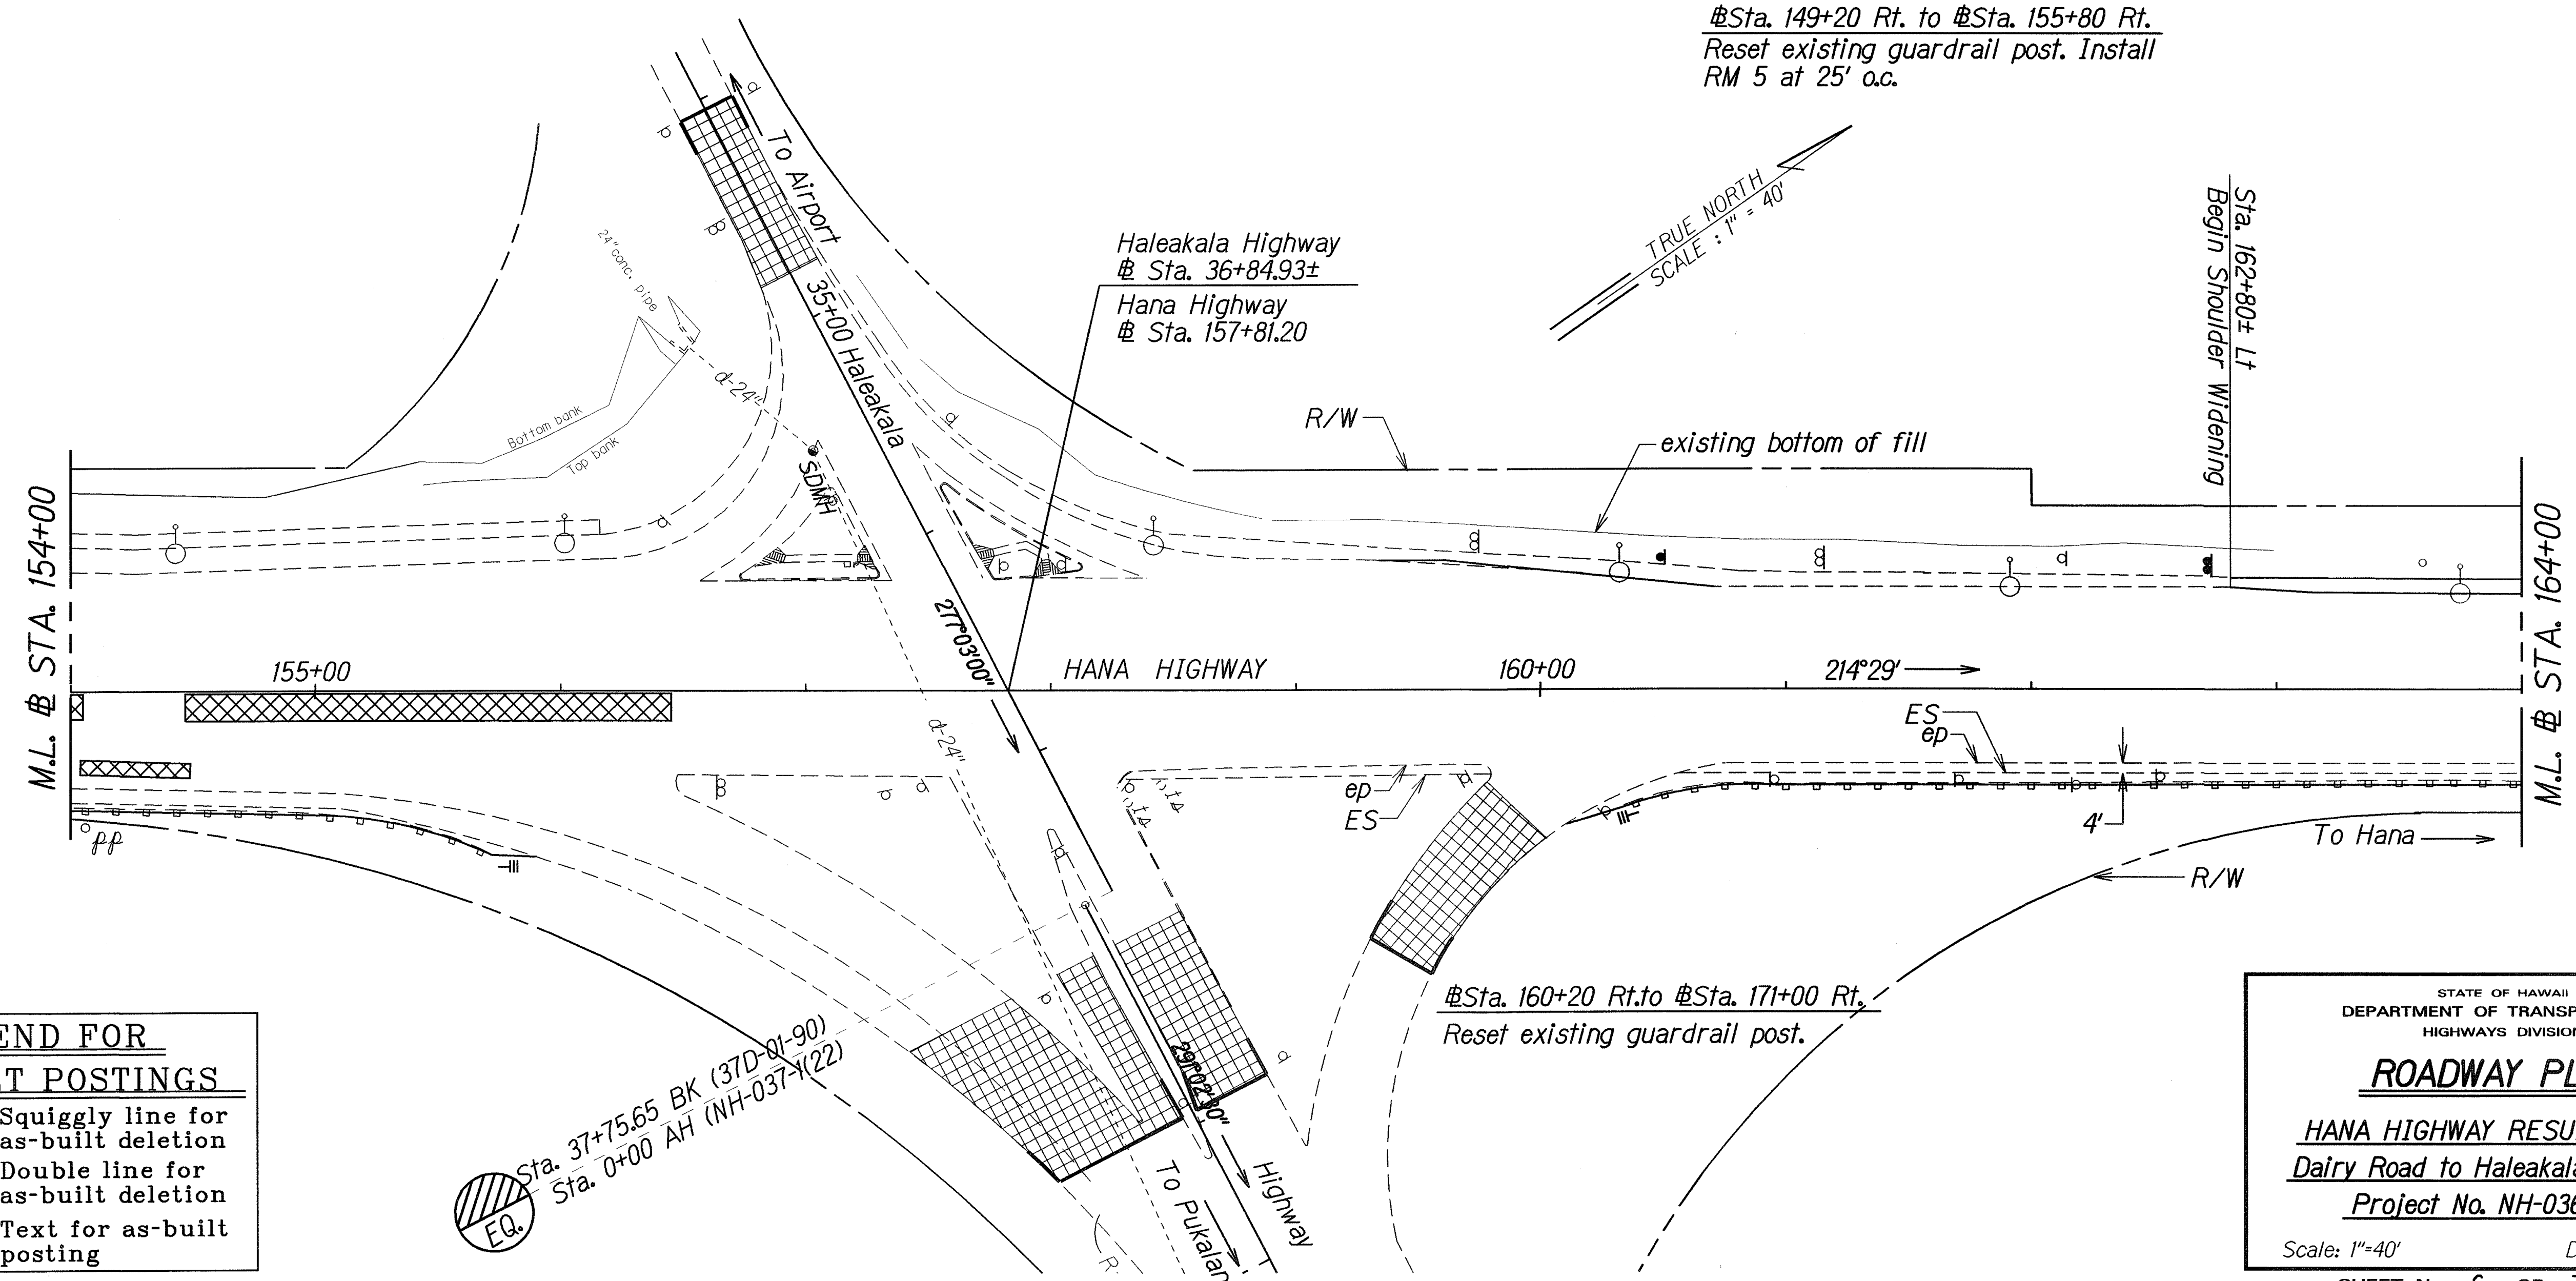

#Sta. 160+20 Rt. to #Sta. 171+00 Rt.
Reset existing guardrail post.

LEGEND FOR AS-BUILT POSTINGS	
	Squiggly line for as-built deletion
	Double line for as-built deletion
Roadway	Text for as-built posting

Sta. 37+75.65 BK (37D-01-90)
Sta. 0+00 AH (NH-037-1(22))

STATE OF HAWAII
DEPARTMENT OF TRANSPORTATION
HIGHWAYS DIVISION

ROADWAY PLANS

HANA HIGHWAY RESURFACING
Dairy Road to Haleakala Highway
Project No. NH-036-1(16)


Scale: 1"=40' Date: Oct., 2005

SHEET No. 6 OF 7 SHEETS

DESIGNED BY	DATE
TRACED BY	
NOTED BY	
QUANTITIES BY	
CHECKED BY	

"AS-BUILT"

FED. ROAD DIST. NO.	STATE	FED. AID PROJ. NO.	FISCAL YEAR	SHEET NO.	TOTAL SHEETS
HAWAII	HAW.	NH-036-1(16)	2006	15	36

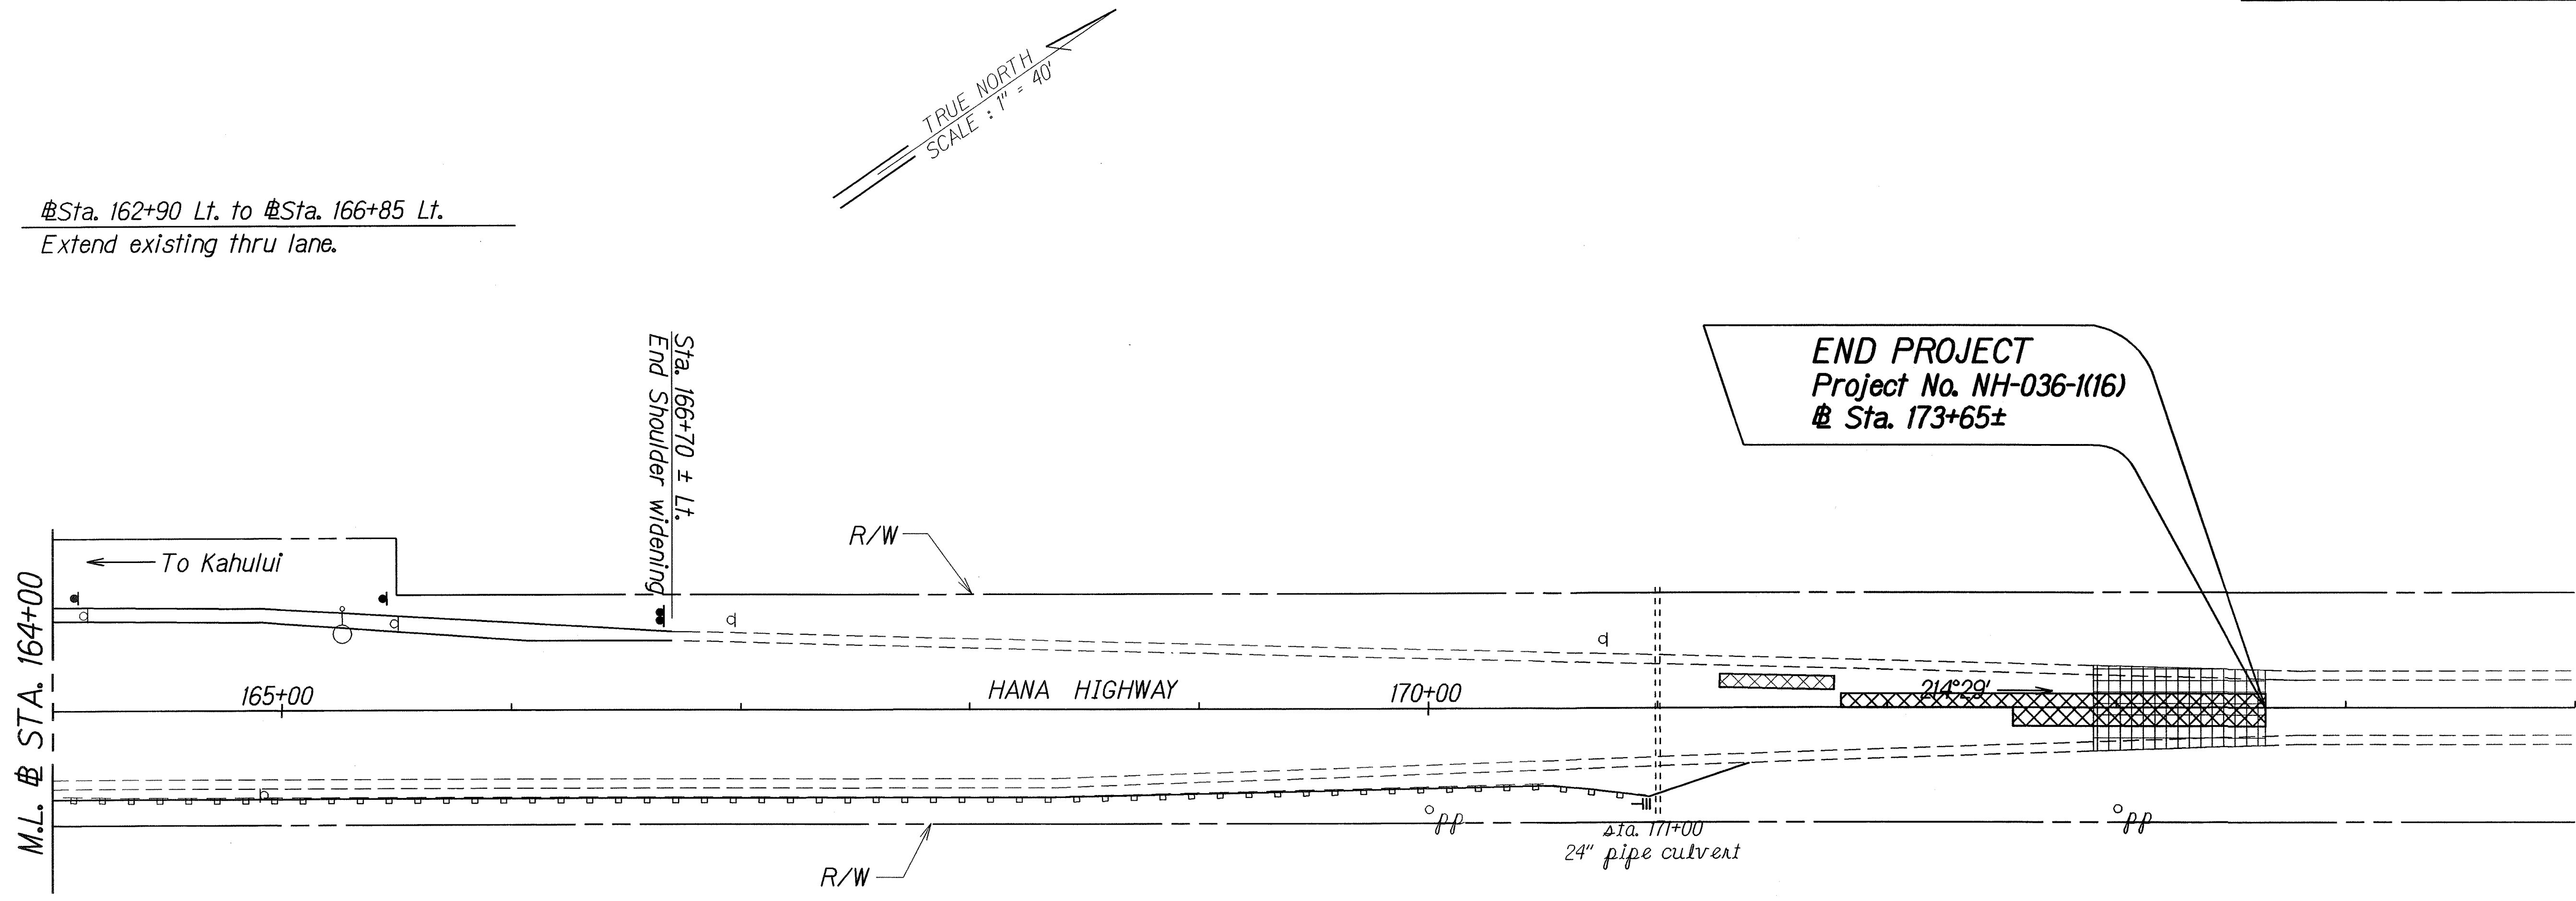

ORIGINAL PLANS	DATE	10/1/05
DESIGNED BY	TRACED BY	10/1/05
QUANTITIES BY	CHECKED BY	10/1/05

LEGEND FOR AS-BUILT POSTINGS	
	Squiggly line for as-built deletion
	Double line for as-built deletion
Roadway	Text for as-built posting

STATE OF HAWAII
DEPARTMENT OF TRANSPORTATION
HIGHWAYS DIVISION

ROADWAY PLANS

HANA HIGHWAY RESURFACING
Dairy Road to Haleakala Highway
Project No. NH-036-1(16)

Scale: 1"=40' Date: Oct., 2005

SHEET No. 7 OF 7 SHEETS

"AS-BUILT"