
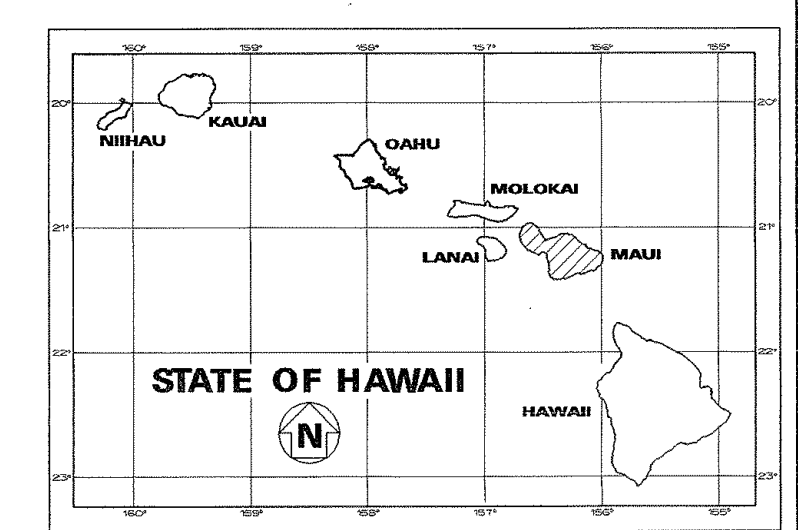




INDEX TO DRAWINGS	
SHEET NO.	DESCRIPTION
1	TITLE SHEET
2	STANDARD PLANS SUMMARY
3	GENERAL NOTES & LEGEND
4 - 5	WATER POLLUTION & EROSION CONTROL NOTES
6 - 8	TYPICAL SECTIONS & DETAILS
9 - 15	ROADWAY PLANS
16	PAVEMENT MARKING LEGEND, DETAILS & NOTES
17 - 18	WORK ZONE SIGNING PLAN NOTES & DETAILS
19 - 25	SIGNING & PAVEMENT MARKING PLANS
26	TRAFFIC SIGNAL PLAN
27	LOOP DETECTOR DETAILS
28	GUARDRAIL DETAILS AND NOTES
29 - 32	KALIALINUI BRIDGE DETAILS
33	SIGN PANEL LAYOUT AND NOTES
34 - 35	SIGN PANEL LAYOUT
36	MISCELLANEOUS SUMMARIES

STATE OF HAWAII
DEPARTMENT OF TRANSPORTATION
HIGHWAYS DIVISION
HONOLULU, HAWAII
"AS-BUILT"
PLANS FOR
HANA HIGHWAY RESURFACING
DAIRY ROAD TO HALEAKALA HIGHWAY
PROJECT NO. NH-036-1(16)
DISTRICT OF WAILUKU
ISLAND OF MAUI


FED. ROAD DIST. NO.	STATE	FED. AID PROJ. NO.	FISCAL YEAR	SHEET NO.	TOTAL SHEETS
HAWAII	HAW.	NH-036-1(16)	2006	1	36

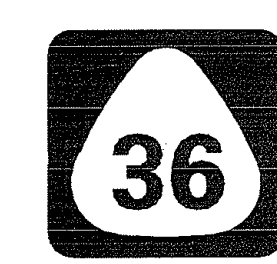

PROJECT LOCATION

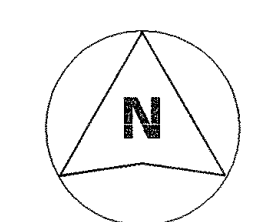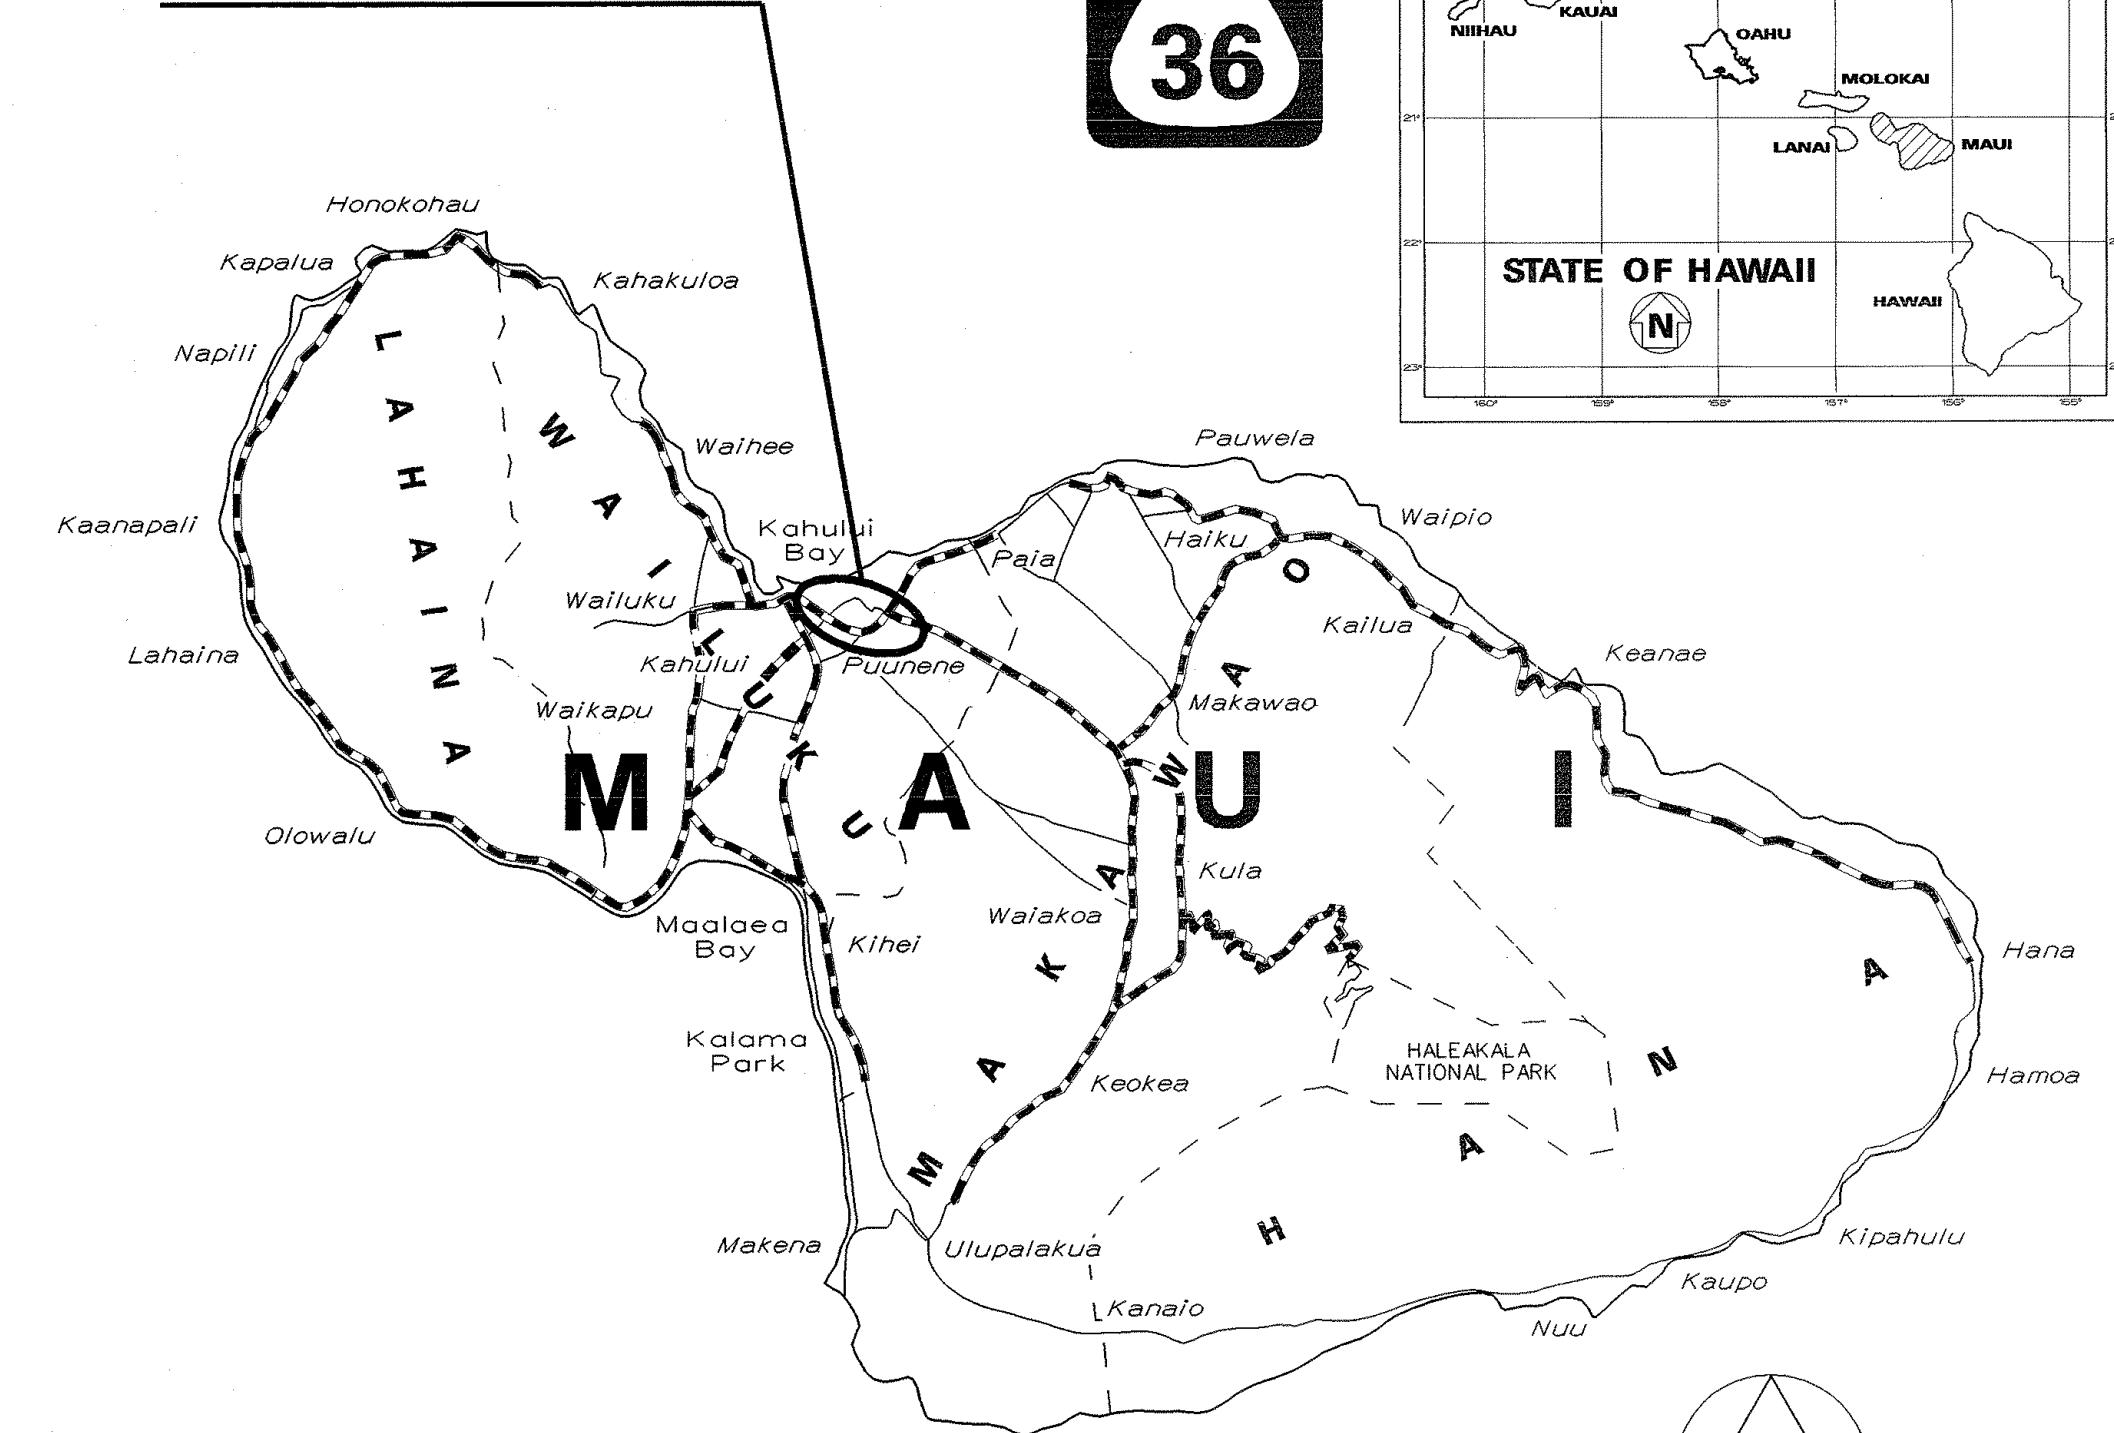

5 0 5 10
SCALE IN MILES

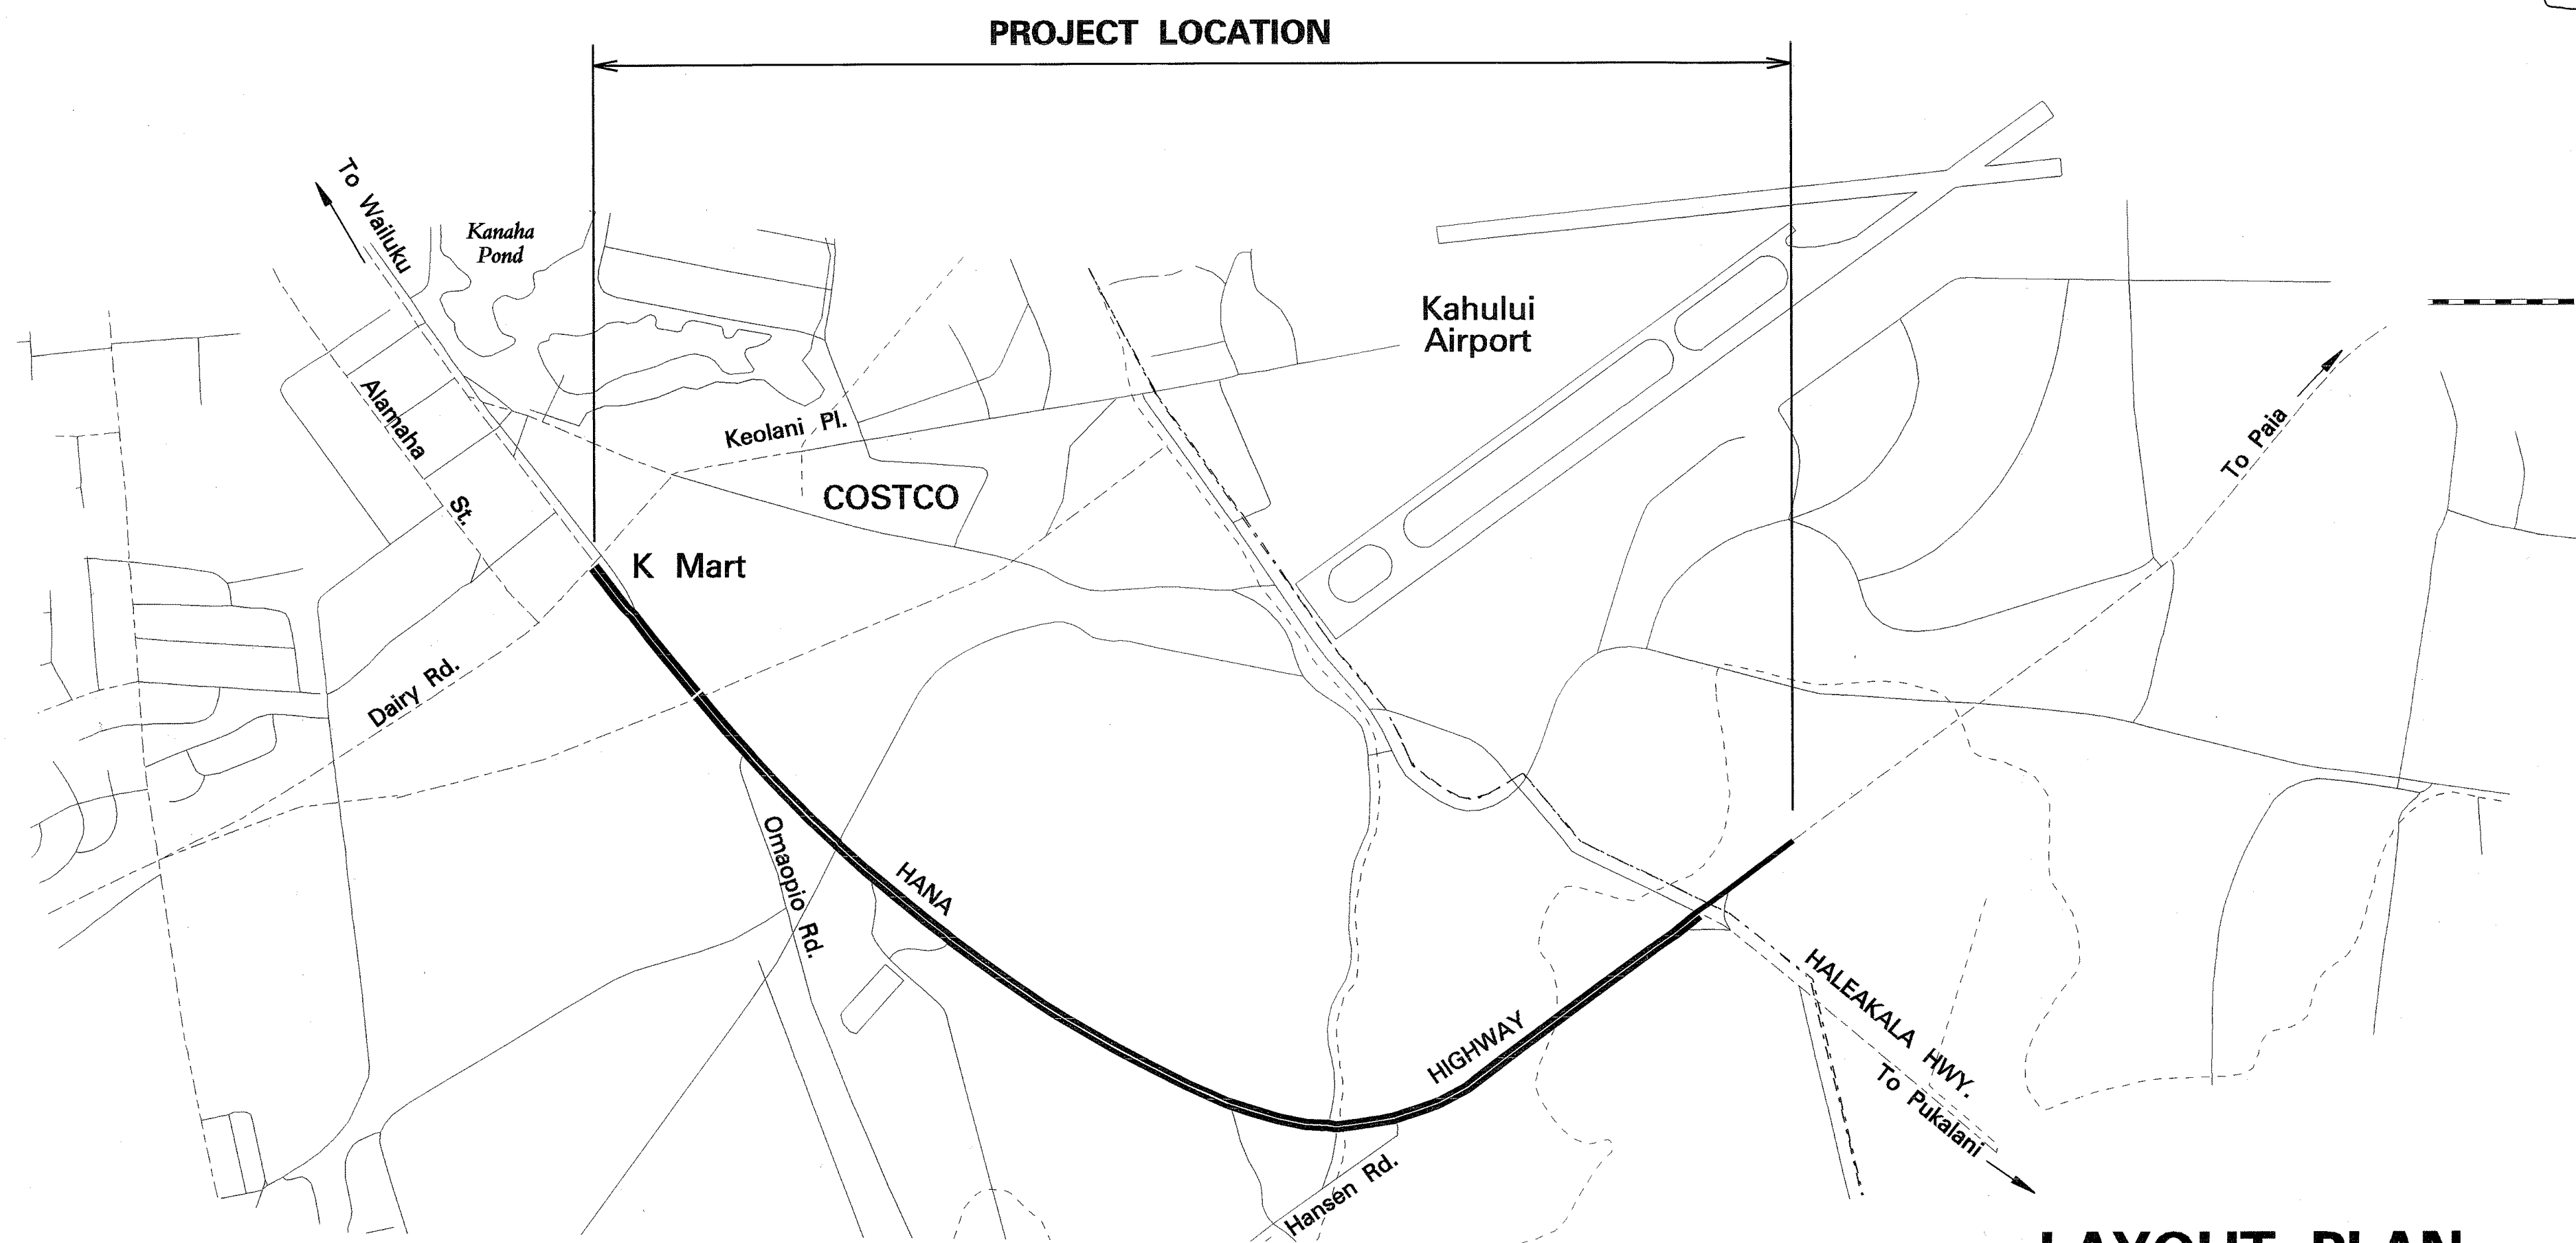

----- FEDERAL AID PROJECTS PREVIOUSLY CONSTRUCTED OR UNDER CONSTRUCTION

MILE POST 0.87 TO MILE POST 3.21

DESIGN DESIGNATION

ADT (2005).....	40,900
ADT (2015).....	48,100
DHV	4,330
D	80/20
T	5.0 %
V	55/45 M.P.H.

CHANGES MADE DURING CONSTRUCTION HAVE BEEN INCORPORATED ON THESE PLANS EXCEPT CHANGES IN THE ORIGINAL THEORETICAL QUANTITIES. FOR ACTUAL QUANTITIES, REFER TO PROJECT LEDGER AND/OR COMPUTATION BOOK.

Don M. Kelly
RESIDENT ENGINEER
10-20-09
DATE

LAYOUT PLAN

GROSS LENGTH OF PROJECT.....2.34 MILES
NET LENGTH OF PROJECT.....2.34 MILES

1 0 1 2 3
SCALE IN THOUSAND FEET

DEPARTMENT OF TRANSPORTATION
STATE OF HAWAII
APPROVED:
Paul F. Johnson
DIR. OF TRANSPORTATION
4/5/06
DATE

HWY-M
DESIGNED BY
HWY-ME
MANAGED BY
873-3535
PHONE
OCT., 2005
DATE