


FED. ROAD DIST. NO.	STATE	FED. AID PROJ. NO.	FISCAL YEAR	SHEET NO.	TOTAL SHEETS
HAWAII	HAW.	NH-036-1(16)	2006	ADD. 26	36

NOTES:

1. This Traffic Signal plan sheet is a typical representation and is attached for reference purposes only. Contractor shall verify the "AS-BUILT" drawings at the DOT office at 650, Palapala Drive, Kahului for original equipments furnished.
2. Replacement of signal head and appurtenances shall be in accordance with the latest standards and as directed by the Engineer.
3. Traffic signal to be improved is located at Dairy Road intersection Sta. 43+00±.
4. Scope of Traffic Signal upgrade work shall be as described in Section 623 of the Special Provisions or as mutually agreed upon between the Contractor and the State.

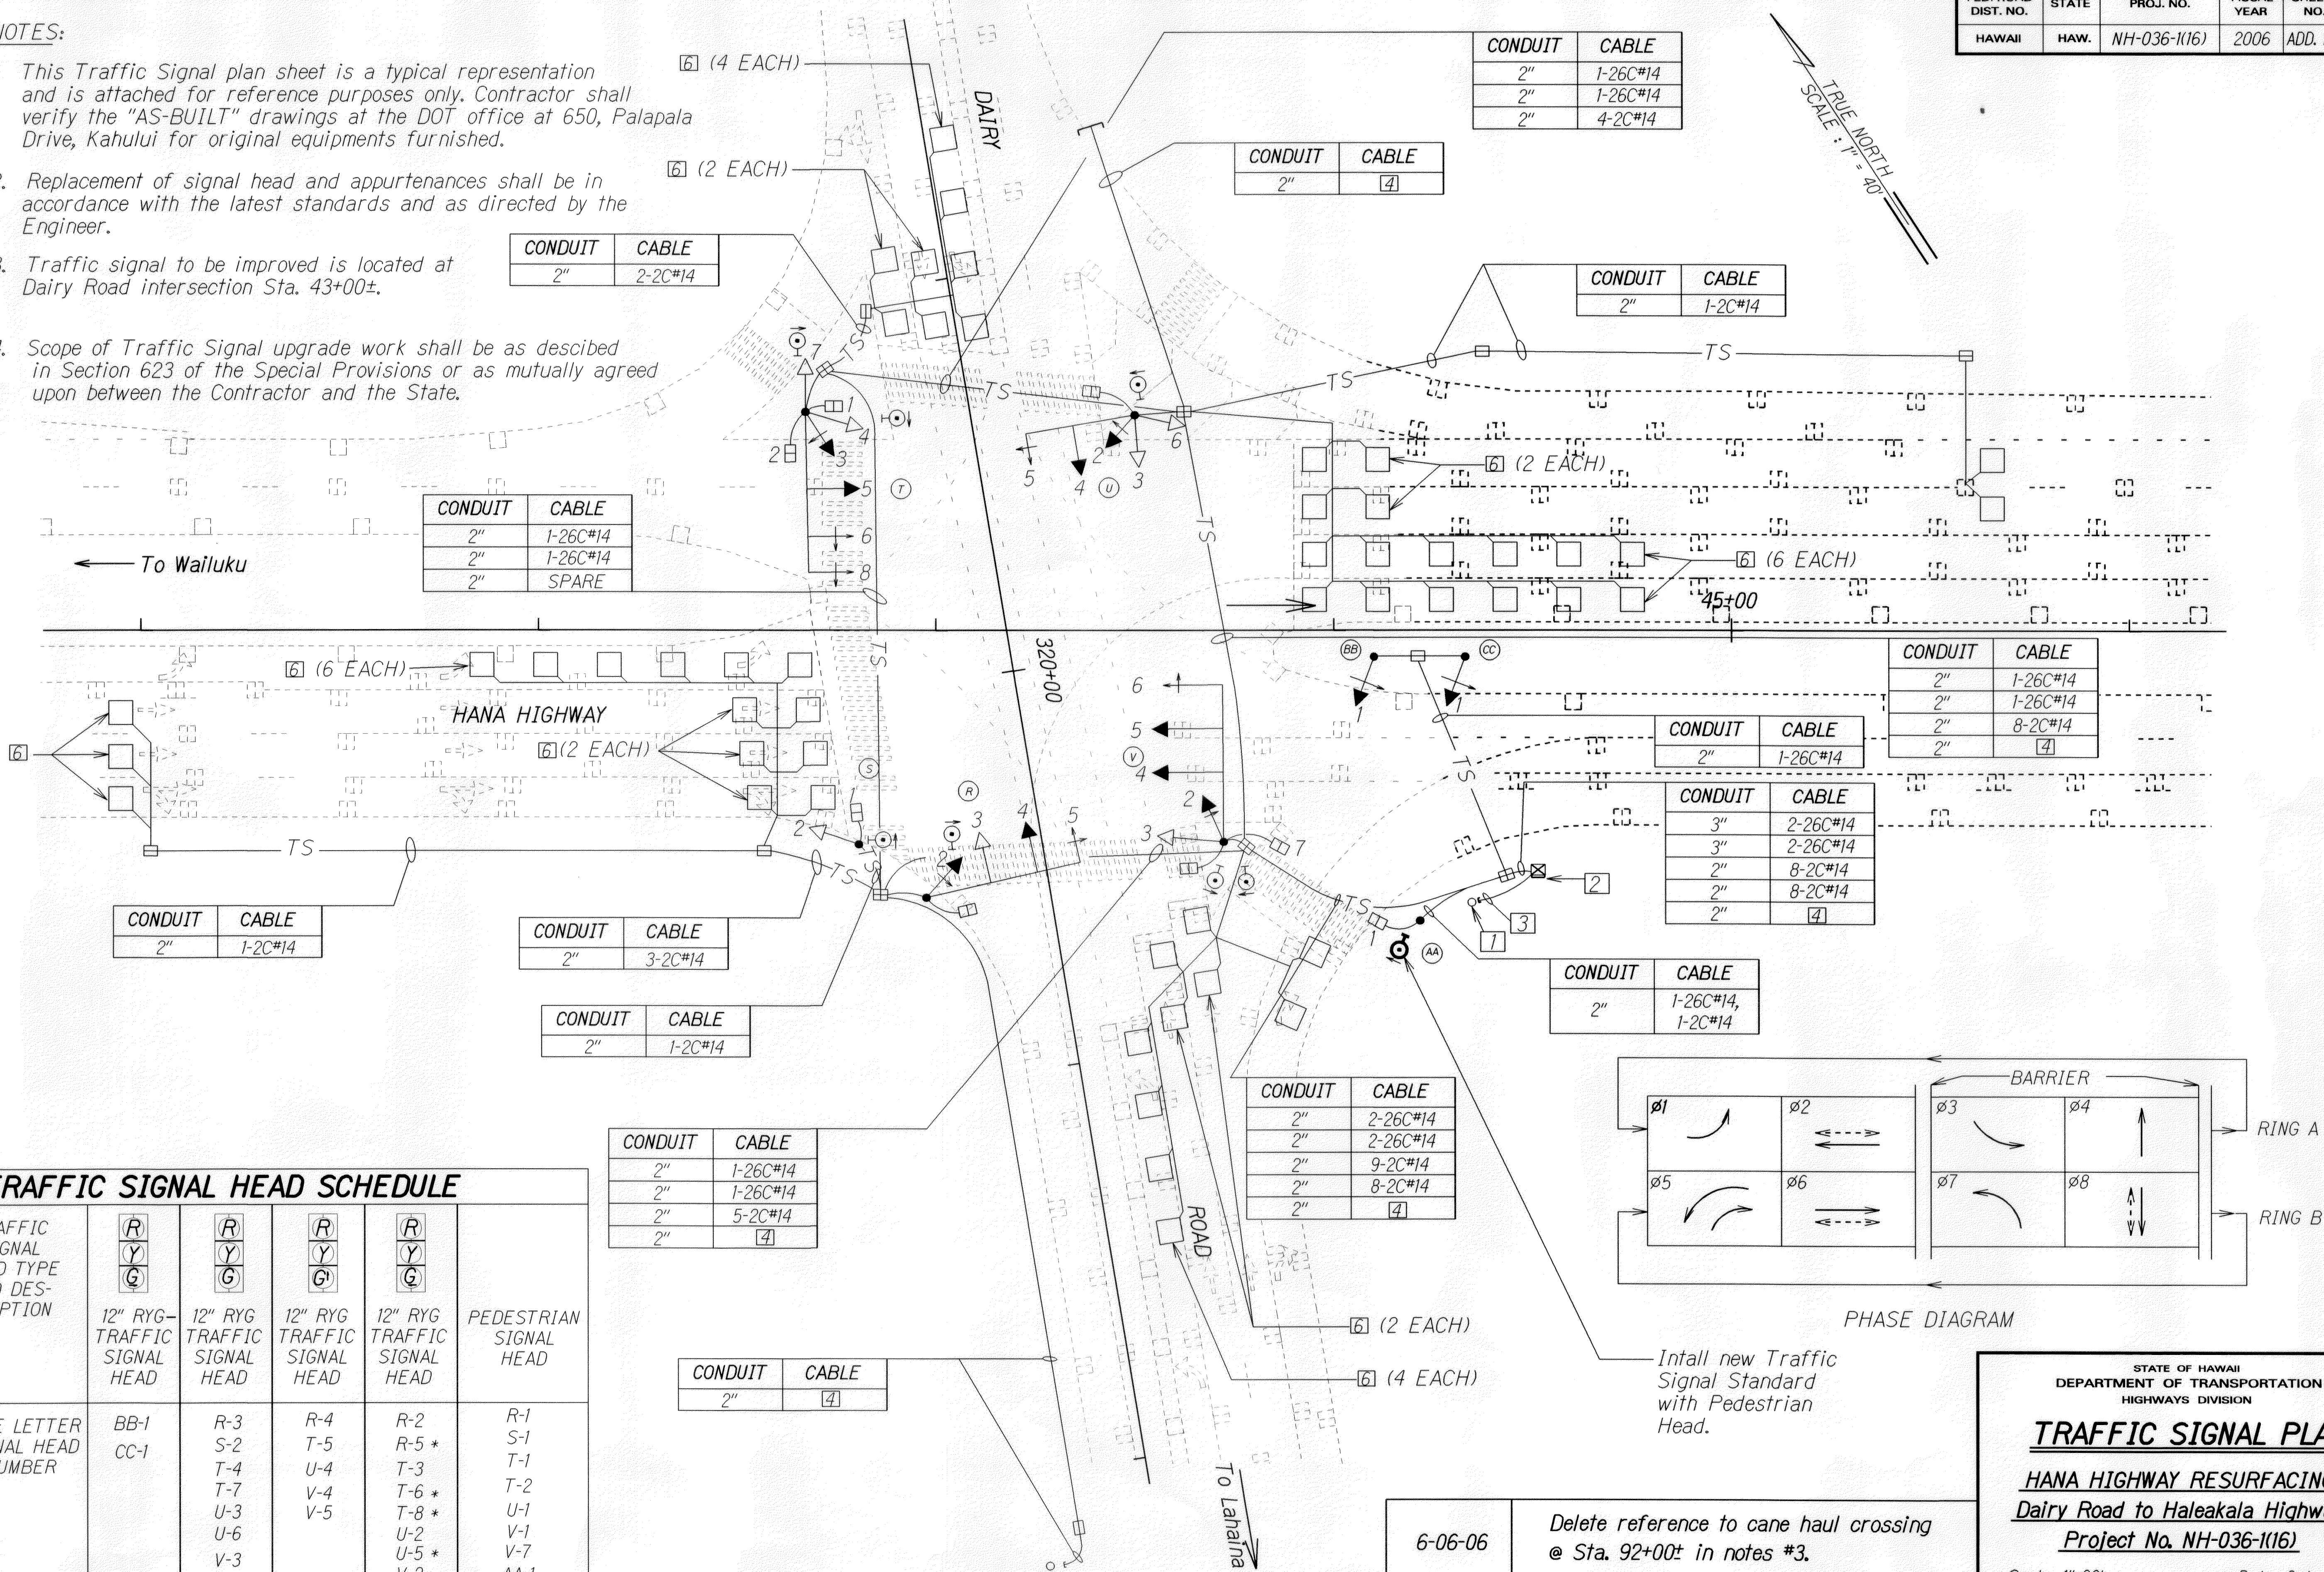

TRAFFIC SIGNAL HEAD SCHEDULE					
TRAFFIC SIGNAL HEAD TYPE AND DESCRIPTION					
	12" RYG-TRAFFIC SIGNAL HEAD	12" RYG-TRAFFIC SIGNAL HEAD	12" RYG-TRAFFIC SIGNAL HEAD	12" RYG-TRAFFIC SIGNAL HEAD	PEDESTRIAN SIGNAL HEAD
POLE LETTER SIGNAL HEAD NUMBER	BB-1 CC-1	R-3 S-2 T-4 T-7 U-3 U-6 V-3	R-4 T-5 U-4 V-4 V-5	R-2 R-5 * T-3 T-6 * T-8 * U-2 U-5 * V-2 V-6 *	R-1 S-1 T-2 U-1 V-1 V-7 AA-1

* WITH PROGRAMMED VISIBILITY

6-06-06	Delete reference to cane haul crossing @ Sta. 92+00± in notes #3.
DATE	REVISION

STATE OF HAWAII
DEPARTMENT OF TRANSPORTATION
HIGHWAYS DIVISION

TRAFFIC SIGNAL PLAN
HANA HIGHWAY RESURFACING
Dairy Road to Haleakala Highway
Project No. NH-036-1(16)
Scale: 1"=20' Date: Oct., 2005
SHEET No. 1 OF 1 SHEETS