


FED. ROAD DIST. NO.	STATE	PROJ. NO.	FISCAL YEAR	SHEET NO.	TOTAL SHEETS
HAWAII	HAW.	36B-02-02	2003	6	13

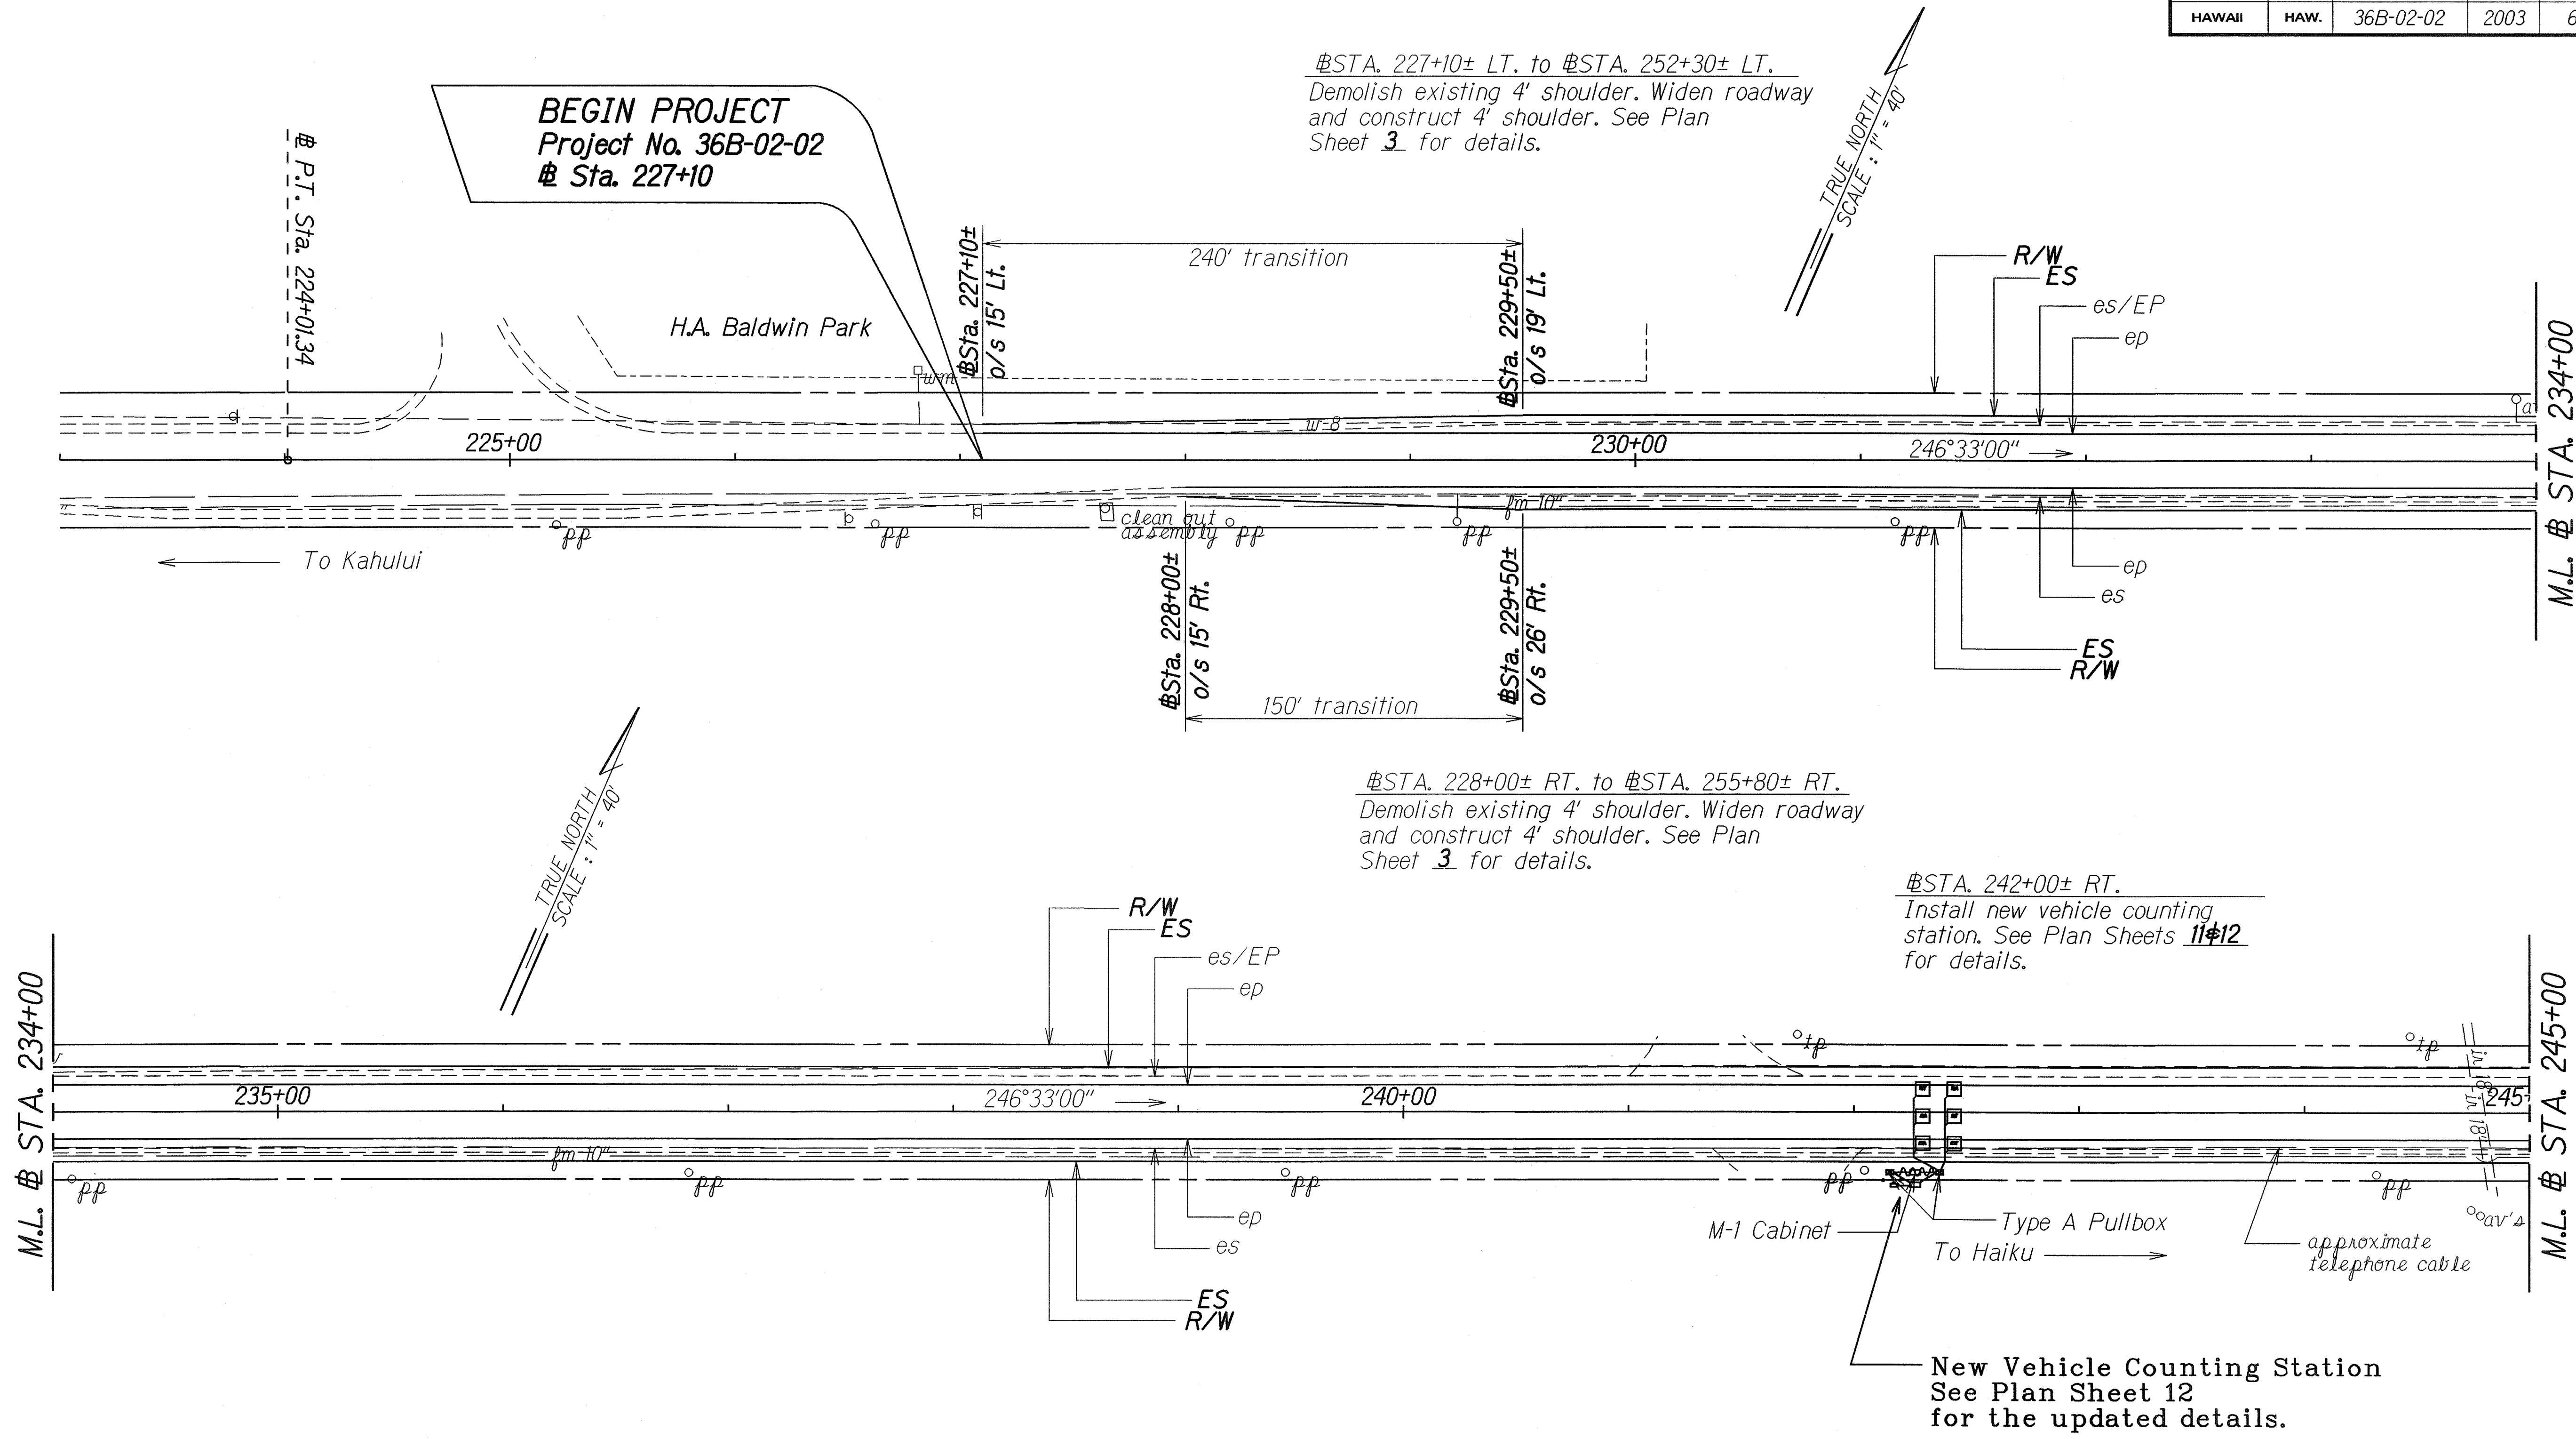

DESIGNED BY	DATE
DRAWN BY	
CHECKED BY	
NOTED BY	
QUANTITIES BY	
CHECKED BY	

asbui12008.dgn



LEGEND FOR AS-BUILT POSTINGS	
	Squiggly line for as-built deletion
	Double line for as-built deletion
Roadway	Text for as-built posting

STATE OF HAWAII
DEPARTMENT OF TRANSPORTATION
HIGHWAYS DIVISION

ROADWAY PLANS
HANA HIGHWAY SHOULDER LANE
Alawai Rd. to Paia
Project No. 36B-02-02

Scale: 1"=40'
Date: Sep., 2002

FED. ROAD DIST. NO.	STATE	PROJ. NO.	FISCAL YEAR	SHEET NO.	TOTAL SHEETS
HAWAII	HAW.	36B-02-02	2003	7	13

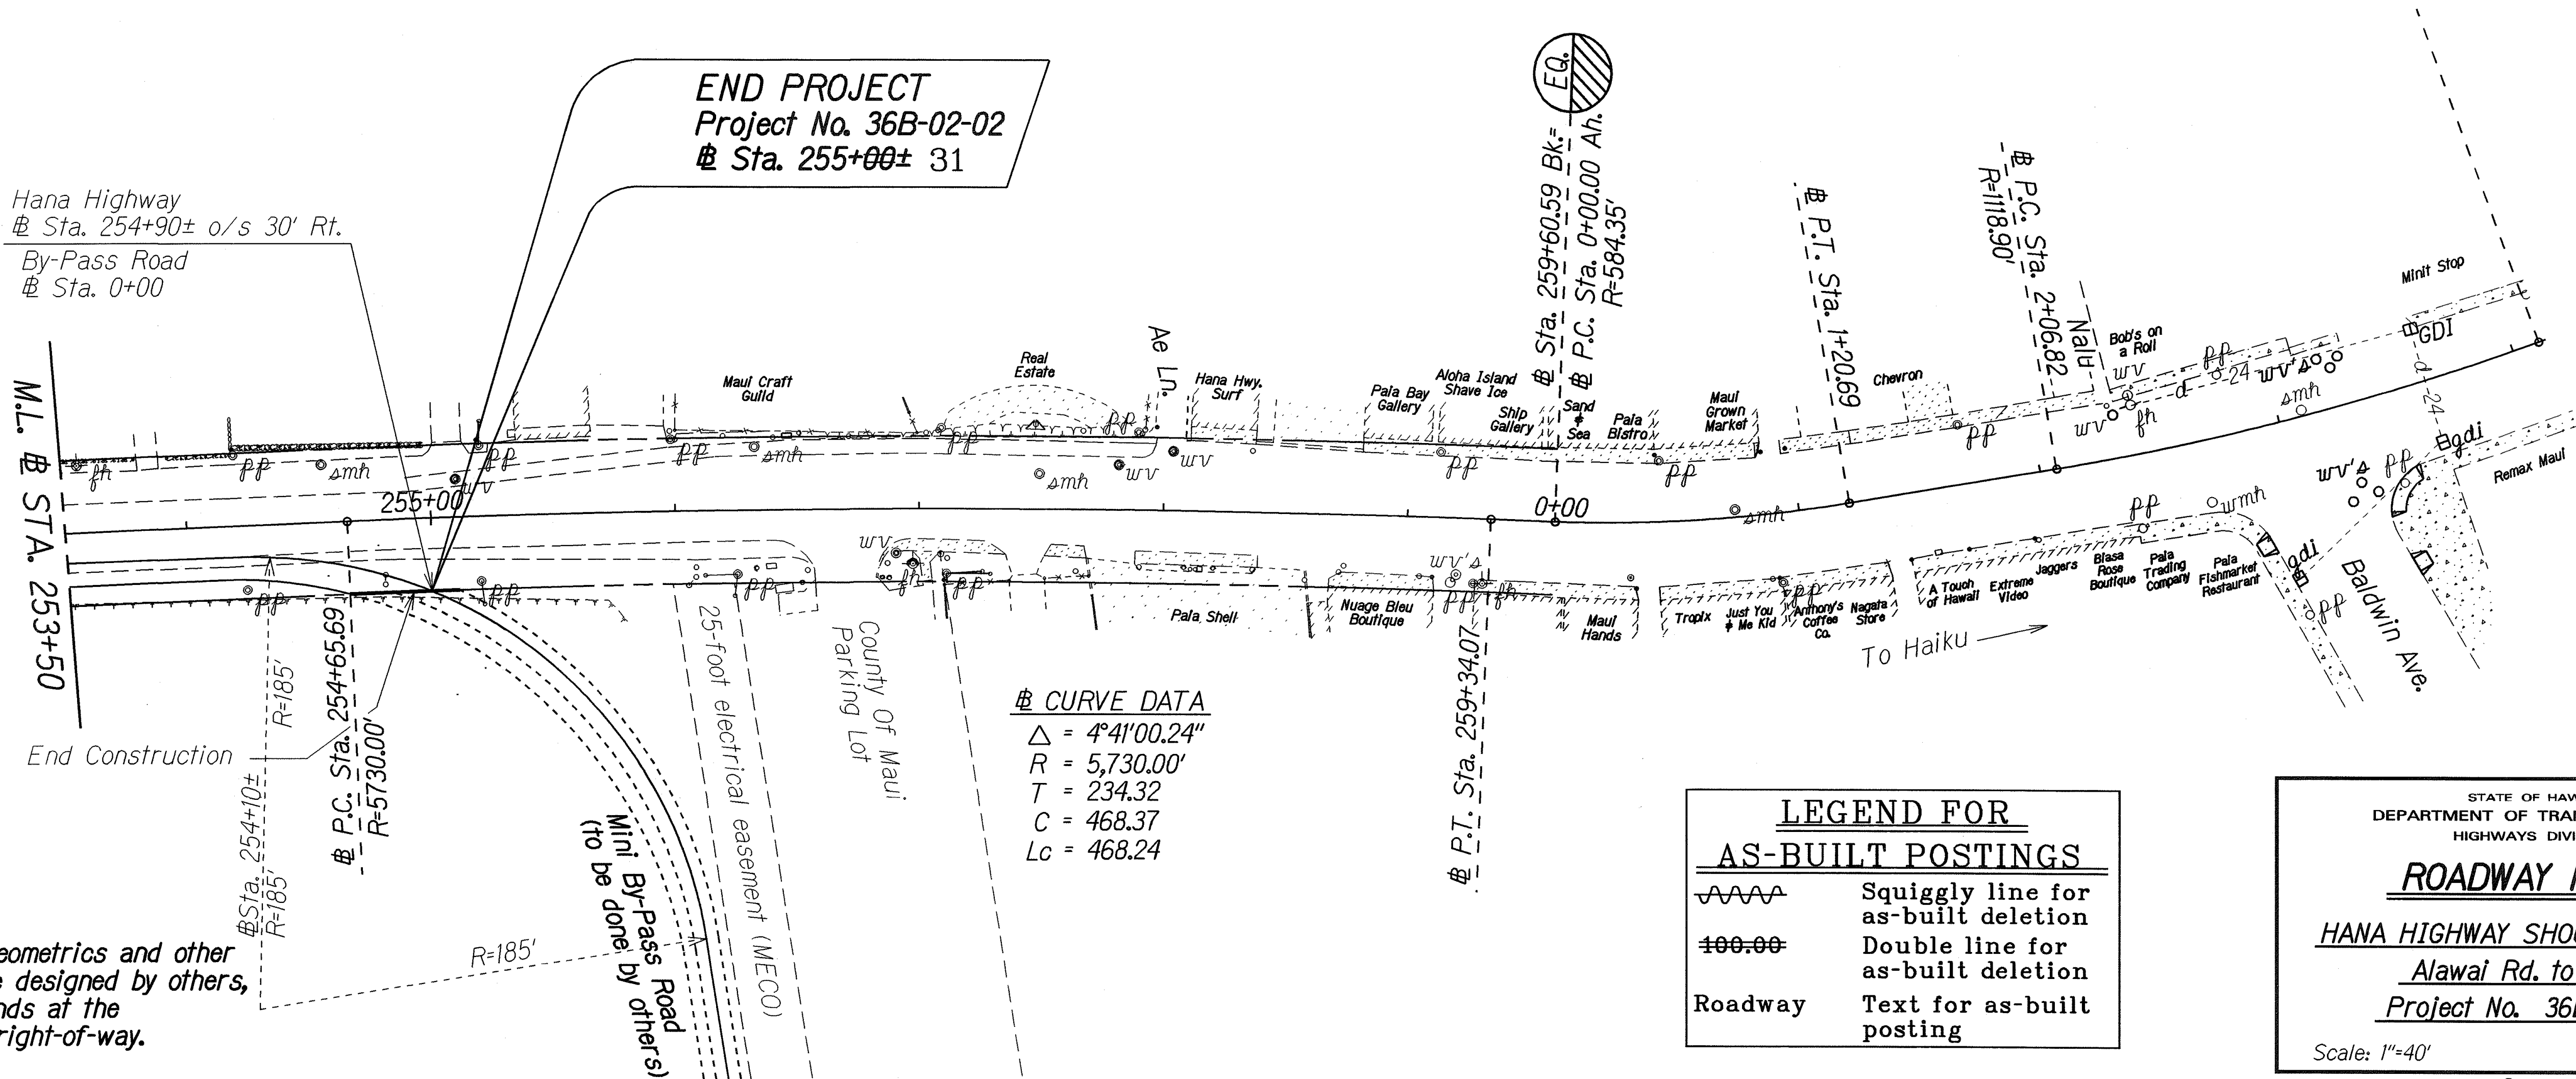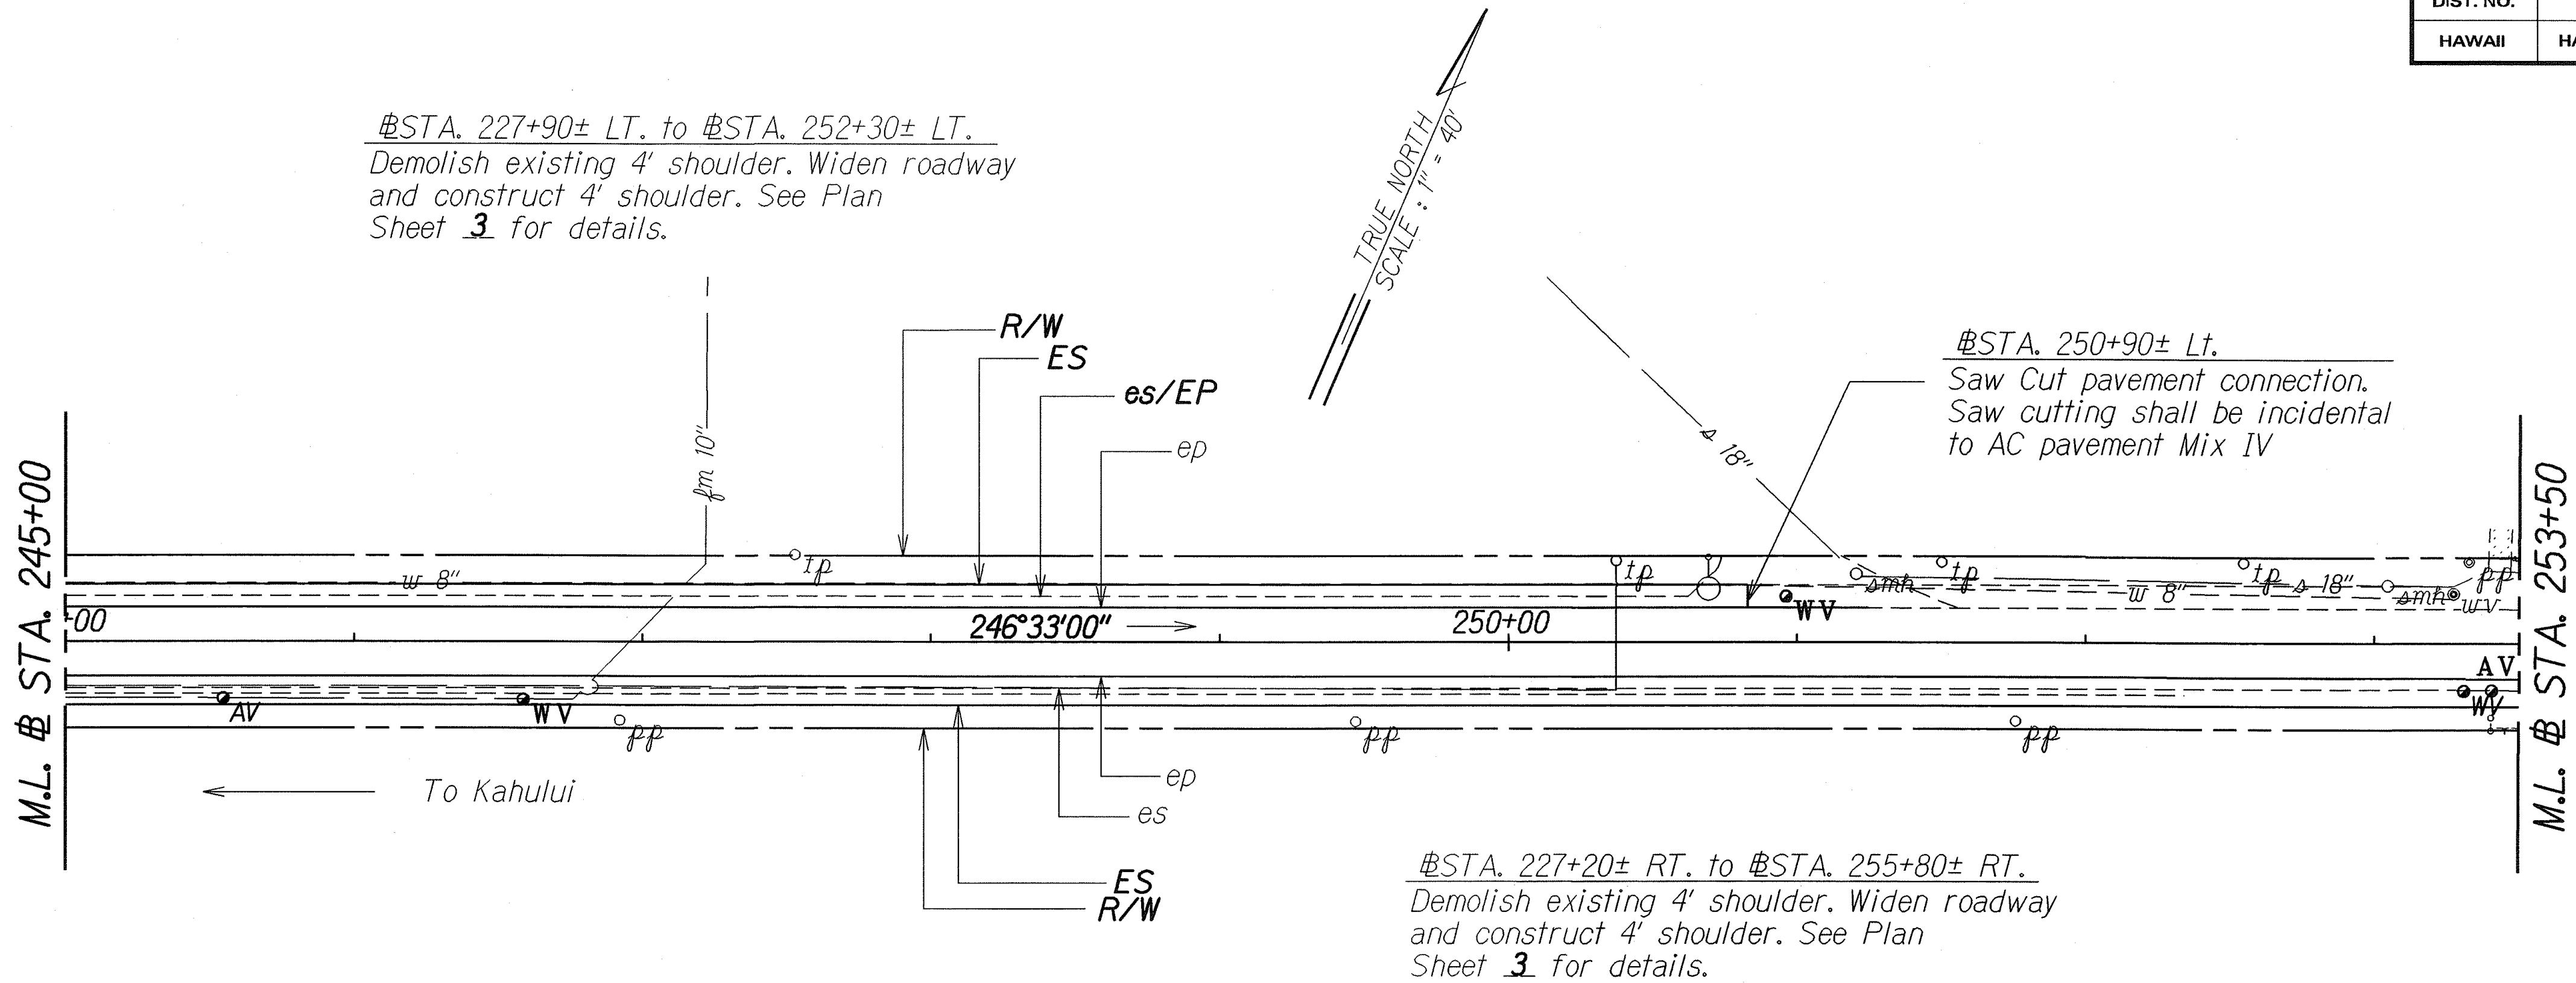

ORIGINAL PLAN	DATE: Sep. 2002
SURVEY PLOTTED BY	
DRAWN BY	
DESIGNED BY	
CHECKED BY	
NOTED BY	
DATE: 10/16/03	
CHECKED BY	

NOTE:
By-pass road geometrics and other features will be designed by others, State project ends at the State Highway right-of-way.

"AS-BUILT"