


FED. ROAD DIST. NO.	STATE	PROJ. NO.	FISCAL YEAR	SHEET NO.	TOTAL SHEETS
HAWAII	HAW.	36B-02-02	2003	9	13

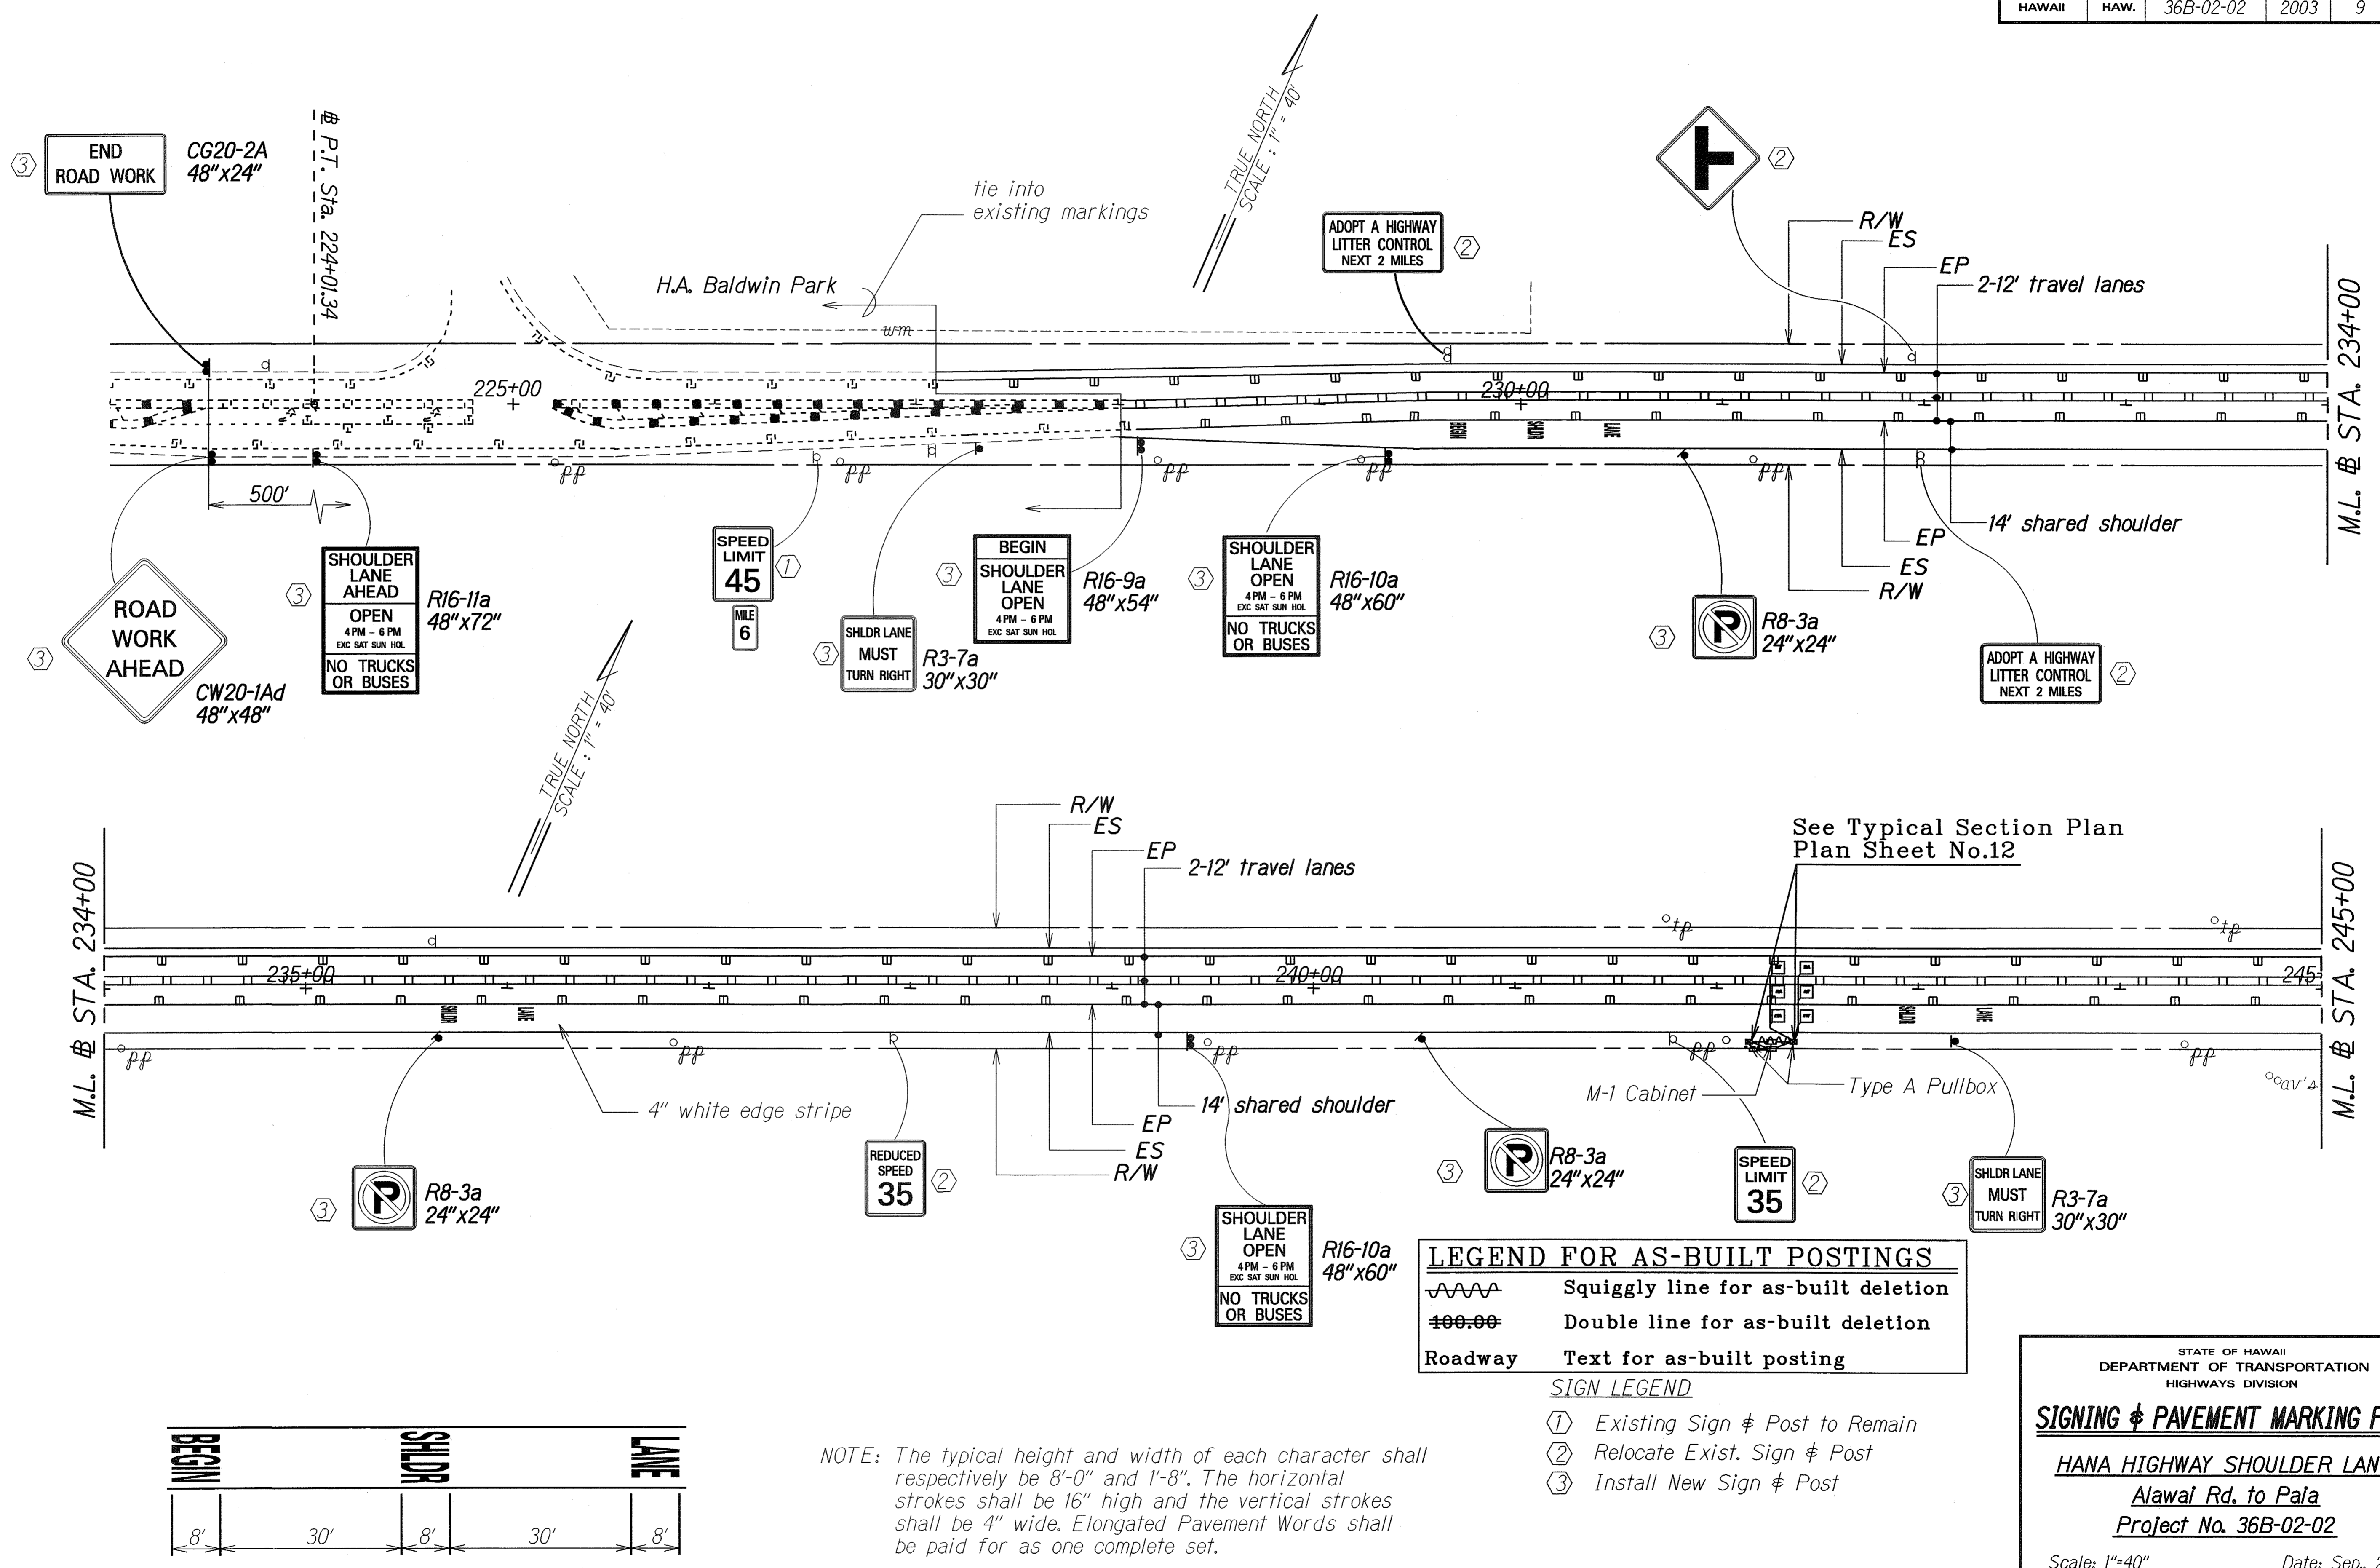

③ END ROAD WORK CG20-2A 48"x24"

③ ROAD WORK AHEAD CW20-1Ad 48"x48"

③ SHOULDER LANE AHEAD R16-11a 48"x72"  
OPEN 4 PM - 6 PM  
EXC SAT SUN HOL  
NO TRUCKS OR BUSES

① SPEED LIMIT 45 MILE 6

③ SHLDR LANE MUST TURN RIGHT R3-7a 30"x30"

③ BEGIN SHOULDER LANE OPEN R16-9a 48"x54"  
4 PM - 6 PM  
EXC SAT SUN HOL

③ SHOULDER LANE OPEN R16-10a 48"x60"  
4 PM - 6 PM  
EXC SAT SUN HOL  
NO TRUCKS OR BUSES

③ R8-3a 24"x24"

② ADOPT A HIGHWAY LITTER CONTROL NEXT 2 MILES

② REDUCED SPEED 35

③ SHOULDER LANE OPEN R16-10a 48"x60"  
4 PM - 6 PM  
EXC SAT SUN HOL  
NO TRUCKS OR BUSES

③ R8-3a 24"x24"


② SPEED LIMIT 35

③ SHLDR LANE MUST TURN RIGHT R3-7a 30"x30"

LEGEND FOR AS-BUILT POSTINGS	
	Squiggly line for as-built deletion
	Double line for as-built deletion
Roadway	Text for as-built posting

**SIGN LEGEND**

- ① Existing Sign & Post to Remain
- ② Relocate Exist. Sign & Post
- ③ Install New Sign & Post

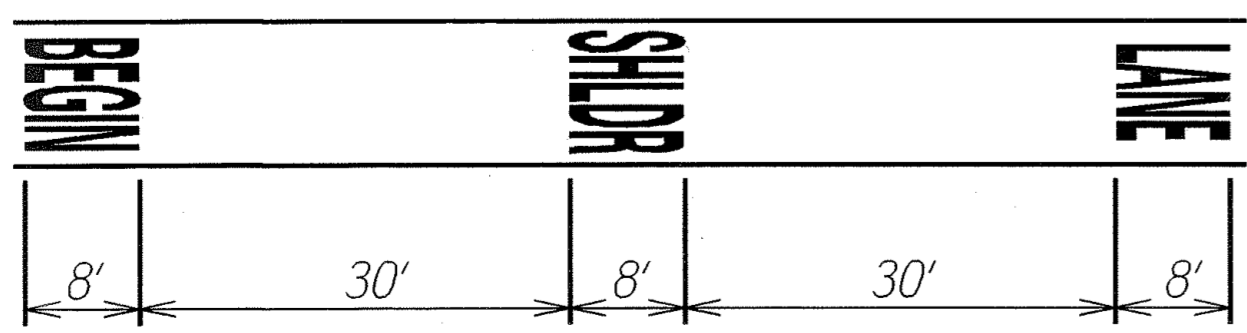

NOTE: The typical height and width of each character shall respectively be 8'-0" and 1'-8". The horizontal strokes shall be 16" high and the vertical strokes shall be 4" wide. Elongated Pavement Words shall be paid for as one complete set.

ORIGINAL PLAN SURVEY PLOTTED BY DATE: . . . . .  
 DRAWN BY: . . . . .  
 DESIGNED BY: . . . . .  
 CHECKED BY: . . . . .  
 AS-BUILT SIGN

asbuilt2006.qhanmtpi.dgn

STATE OF HAWAII  
 DEPARTMENT OF TRANSPORTATION  
 HIGHWAYS DIVISION

**SIGNING & PAVEMENT MARKING PLANS**


**HANA HIGHWAY SHOULDER LANE**  
 Alawai Rd. to Paia  
 Project No. 36B-02-02

Scale: 1"=40" Date: Sep., 2002

SHEET No. 1 OF 2 SHEETS

"AS-BUILT"

FED. ROAD DIST. NO.	STATE	PROJ. NO.	FISCAL YEAR	SHEET NO.	TOTAL SHEETS
HAWAII	HAW.	36B-02-02	2004	10	13

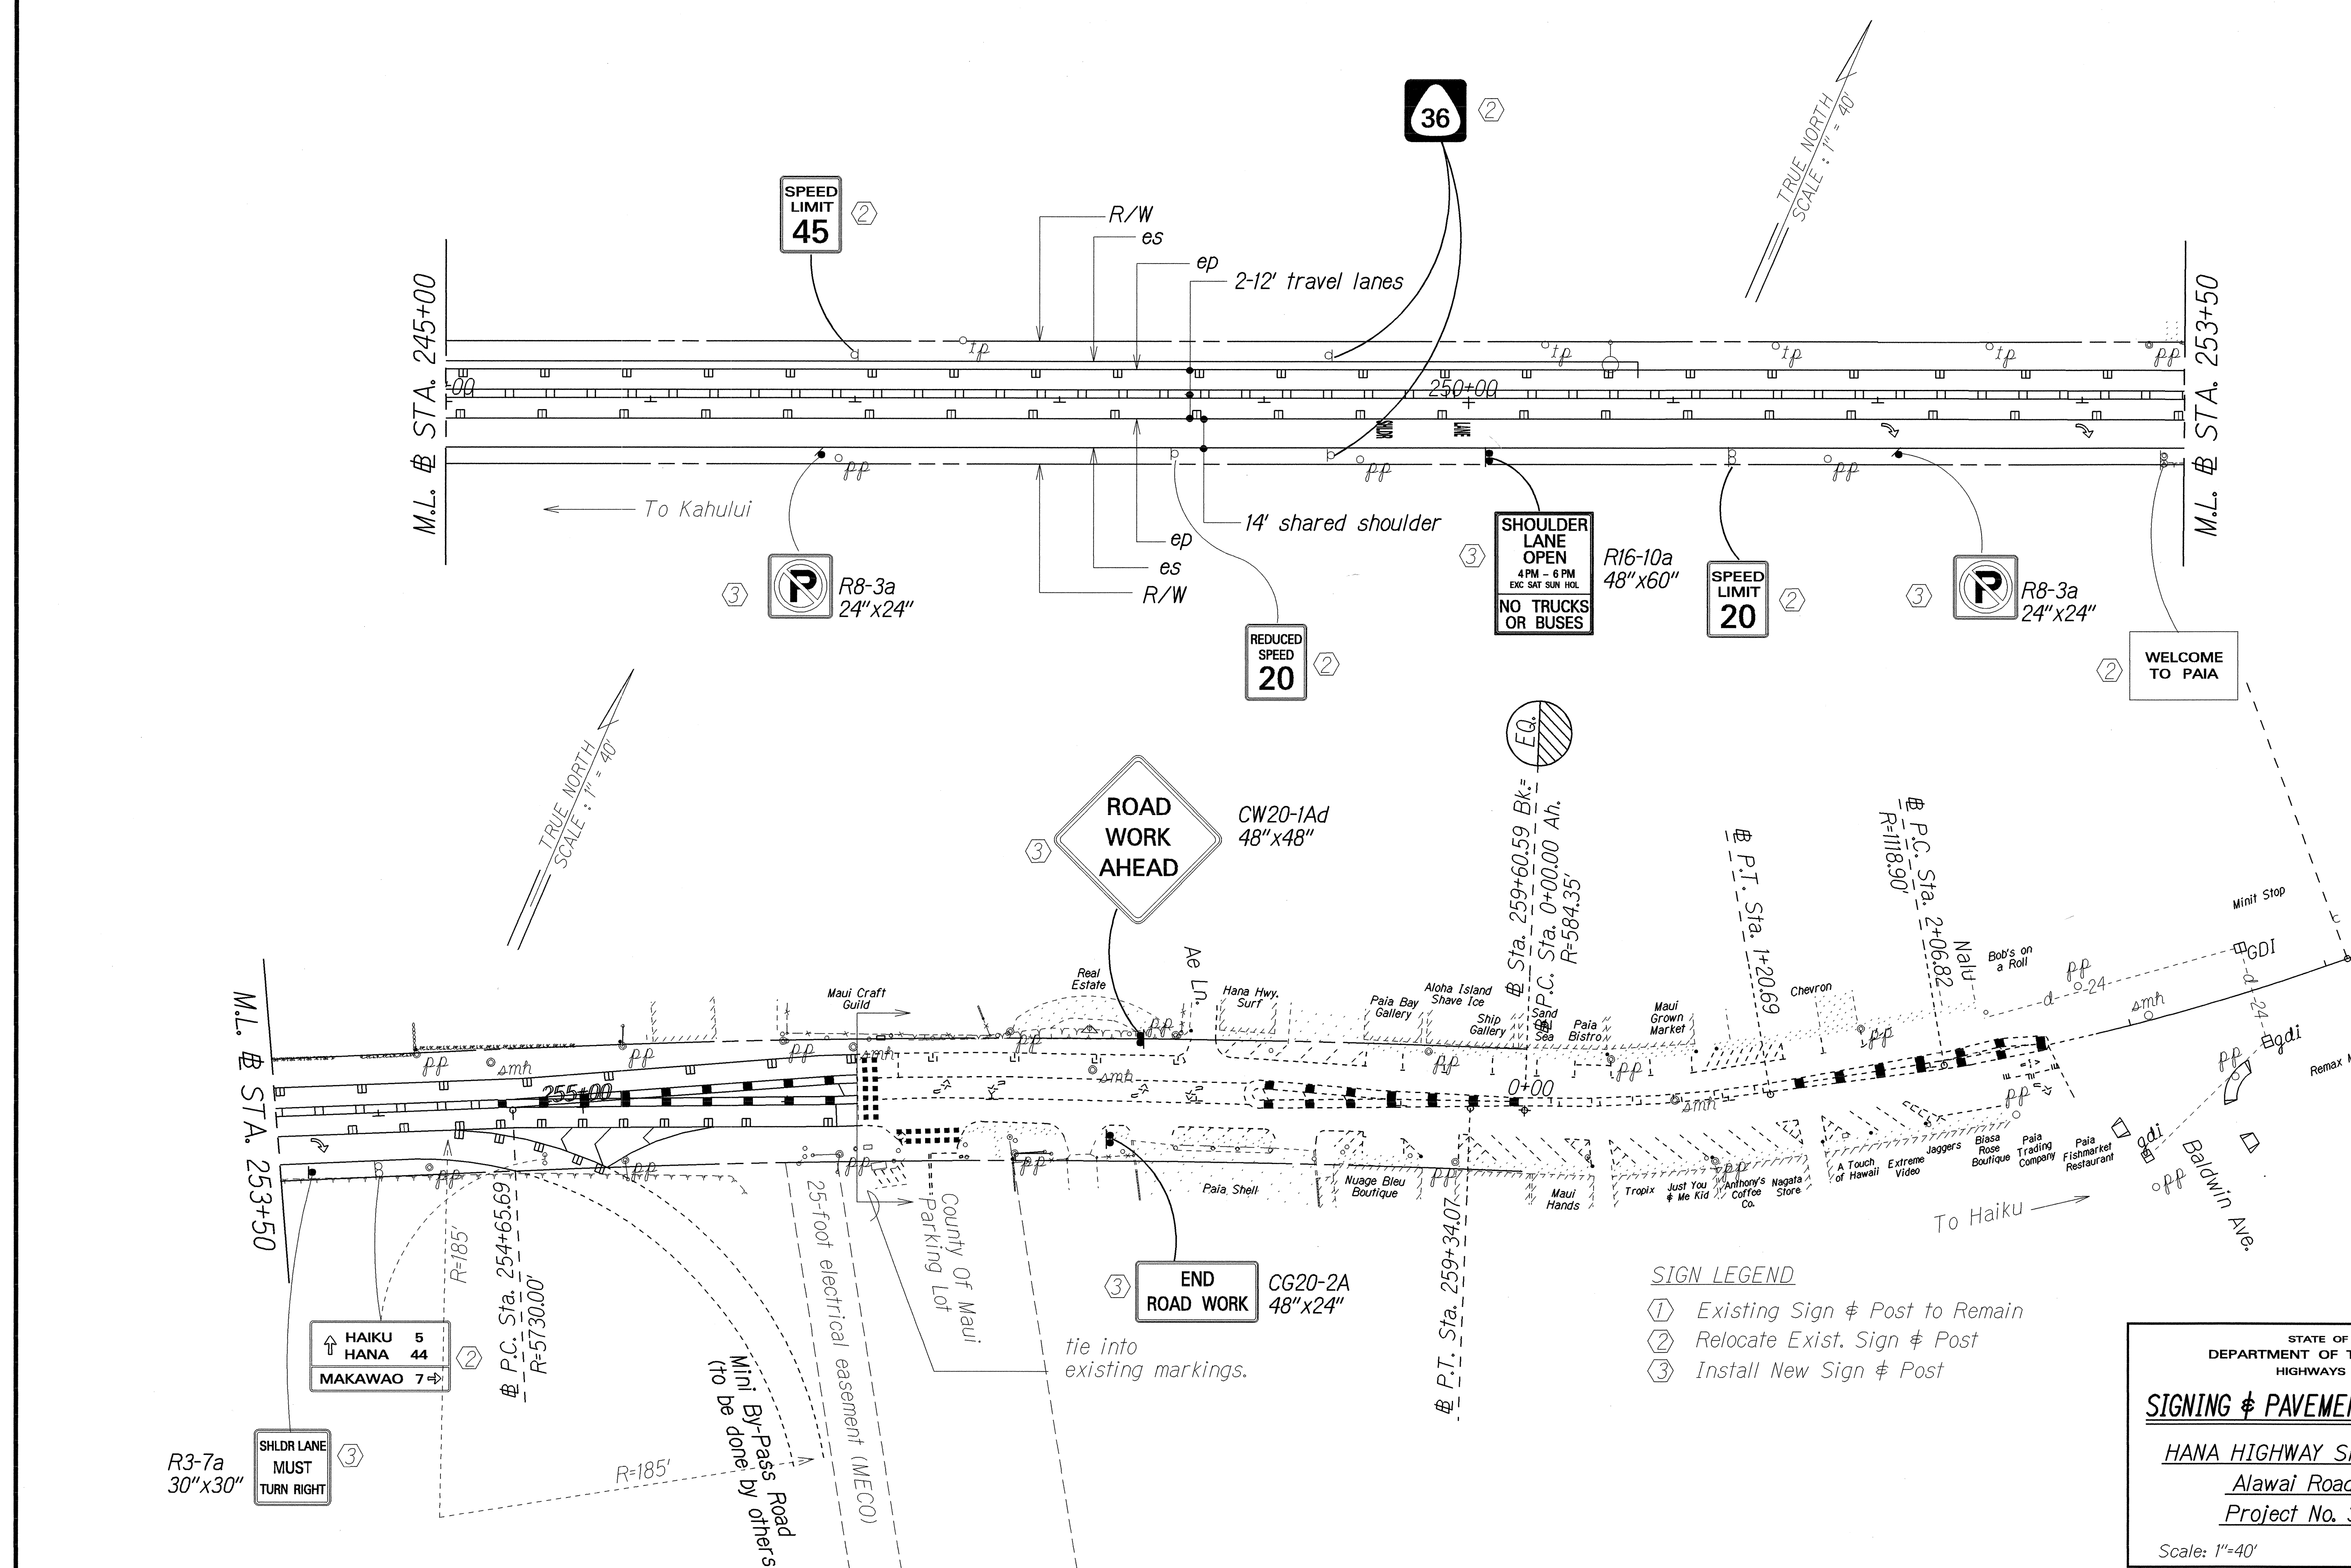

DATE	✓
SURVEY PLOTTED BY	
DRAWN BY	L.M.
DESIGNED BY	L.M.
QUANTITIES BY	
CHECKED BY	
ORIGINAL PLAN	
NOTE BOOK	
REVISIONS	

- SIGN LEGEND**
- ① Existing Sign & Post to Remain
  - ② Relocate Exist. Sign & Post
  - ③ Install New Sign & Post

STATE OF HAWAII  
DEPARTMENT OF TRANSPORTATION  
HIGHWAYS DIVISION

**SIGNING & PAVEMENT MARKING PLANS**

HANA HIGHWAY SHOULDER LANE  
Alawai Road to Paia  
Project No. 36B-02-02

Scale: 1"=40'      Date: Sep., 2002

SHEET No. 2 OF 2 SHEETS