



FED. ROAD DIST. NO.	STATE	FED. AID PROJ. NO.	FISCAL YEAR	SHEET NO.	TOTAL SHEETS
HAWAII	HAW.	NH-036-1(17)	2008	6	13

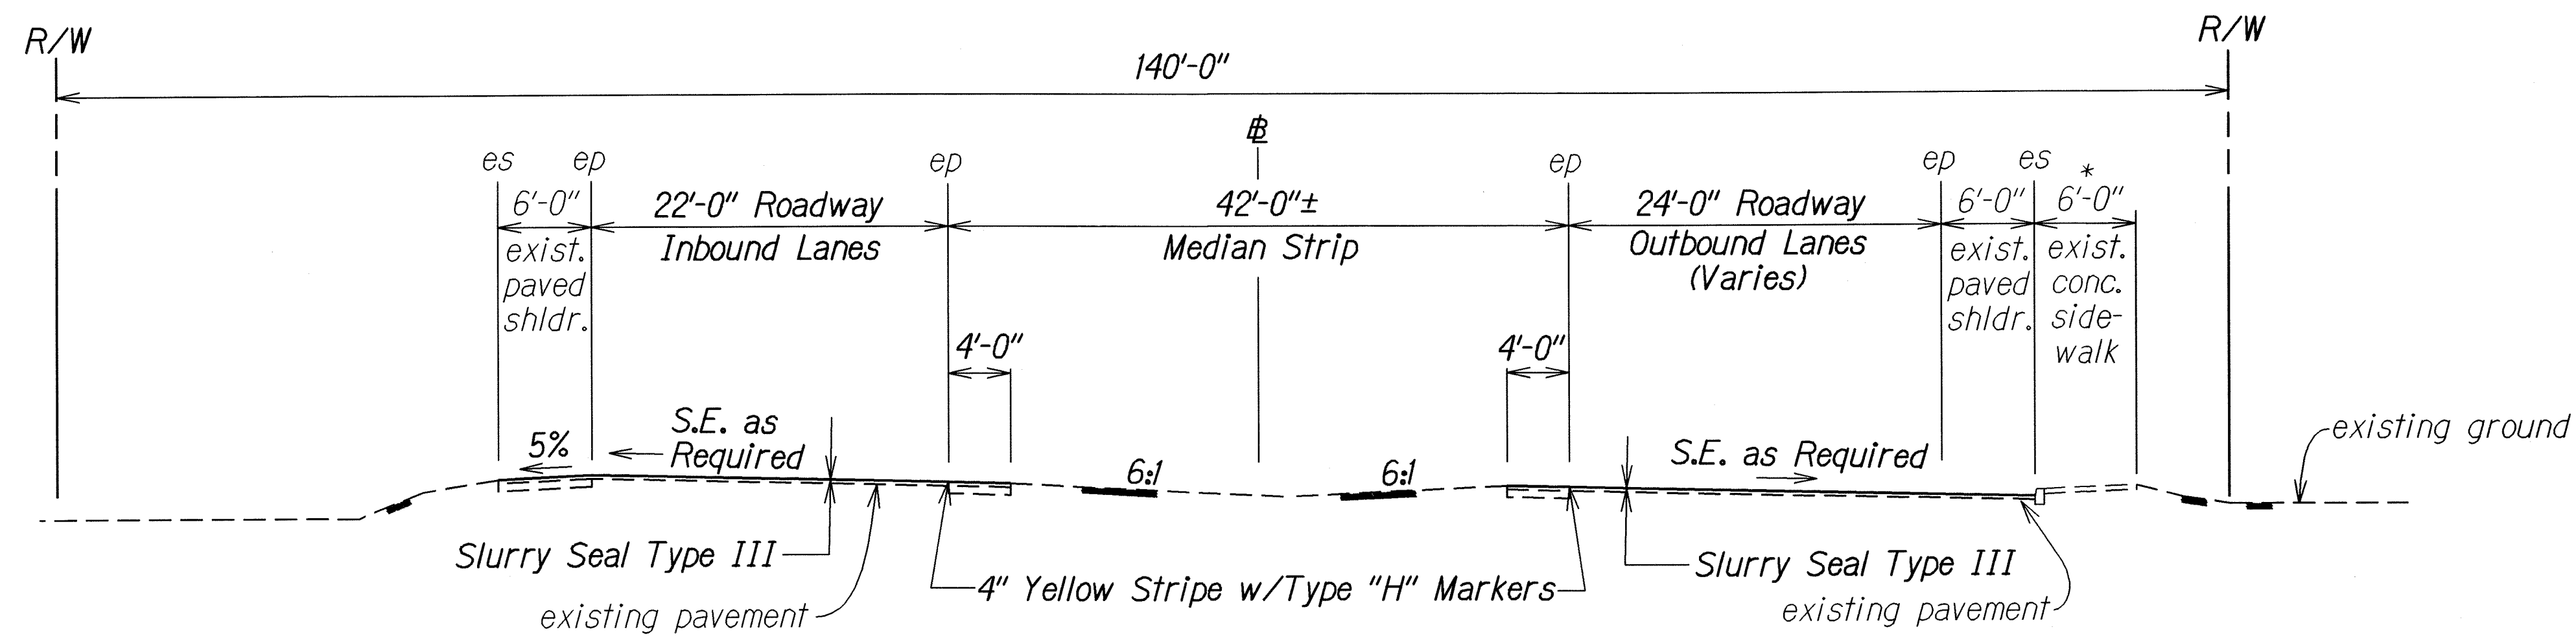

**TYPICAL SECTION DIVIDED HIGHWAY**  
 ± STA. 0+00 TO ± STA. 10+00±\*  
 ± STA. 10+00± TO ± STA. 38+80±  
 Scale:  $\frac{1}{8}$ " = 1'-0"

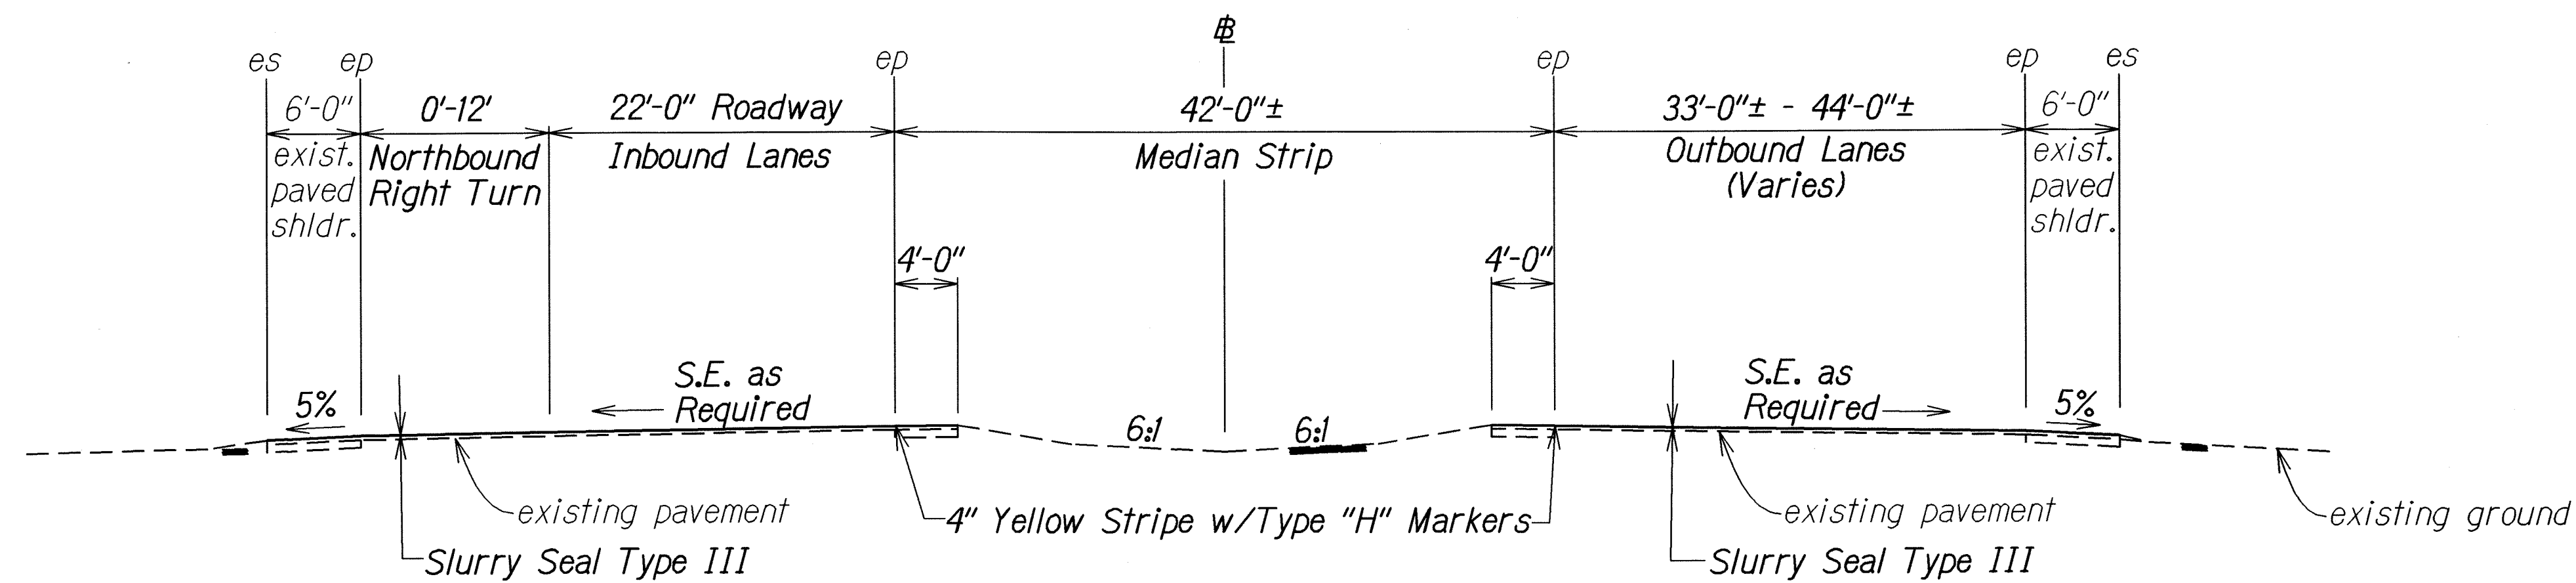

**TYPICAL SECTION DIVIDED HIGHWAY**  
 ± STA. 38+80± TO ± STA. 43+00±  
 Scale:  $\frac{1}{8}$ " = 1'-0"

SURVEY PLOTTED BY	DATE
DESIGNED BY	08/08
CHECKED BY	
NOTED BY	
QUANTITIES BY	
CHECKED BY	

STATE OF HAWAII  
 DEPARTMENT OF TRANSPORTATION  
 HIGHWAYS DIVISION

**TYPICAL SECTIONS & DETAILS**

HANA HIGHWAY PAVEMENT  
 PREVENTIVE MAINTENANCE  
 Kaahumanu Avenue to Dairy Road  
 Federal-Aid Project No. NH-036-1(17)

Scale: As Shown Date: August, 2008

SHEET No. 1 OF 1 SHEETS