


FED. ROAD DIST. NO.	STATE	PROJ. NO.	FISCAL YEAR	SHEET NO.	TOTAL SHEETS
HAWAII	HAW.	36C-01-09	2010	7	10

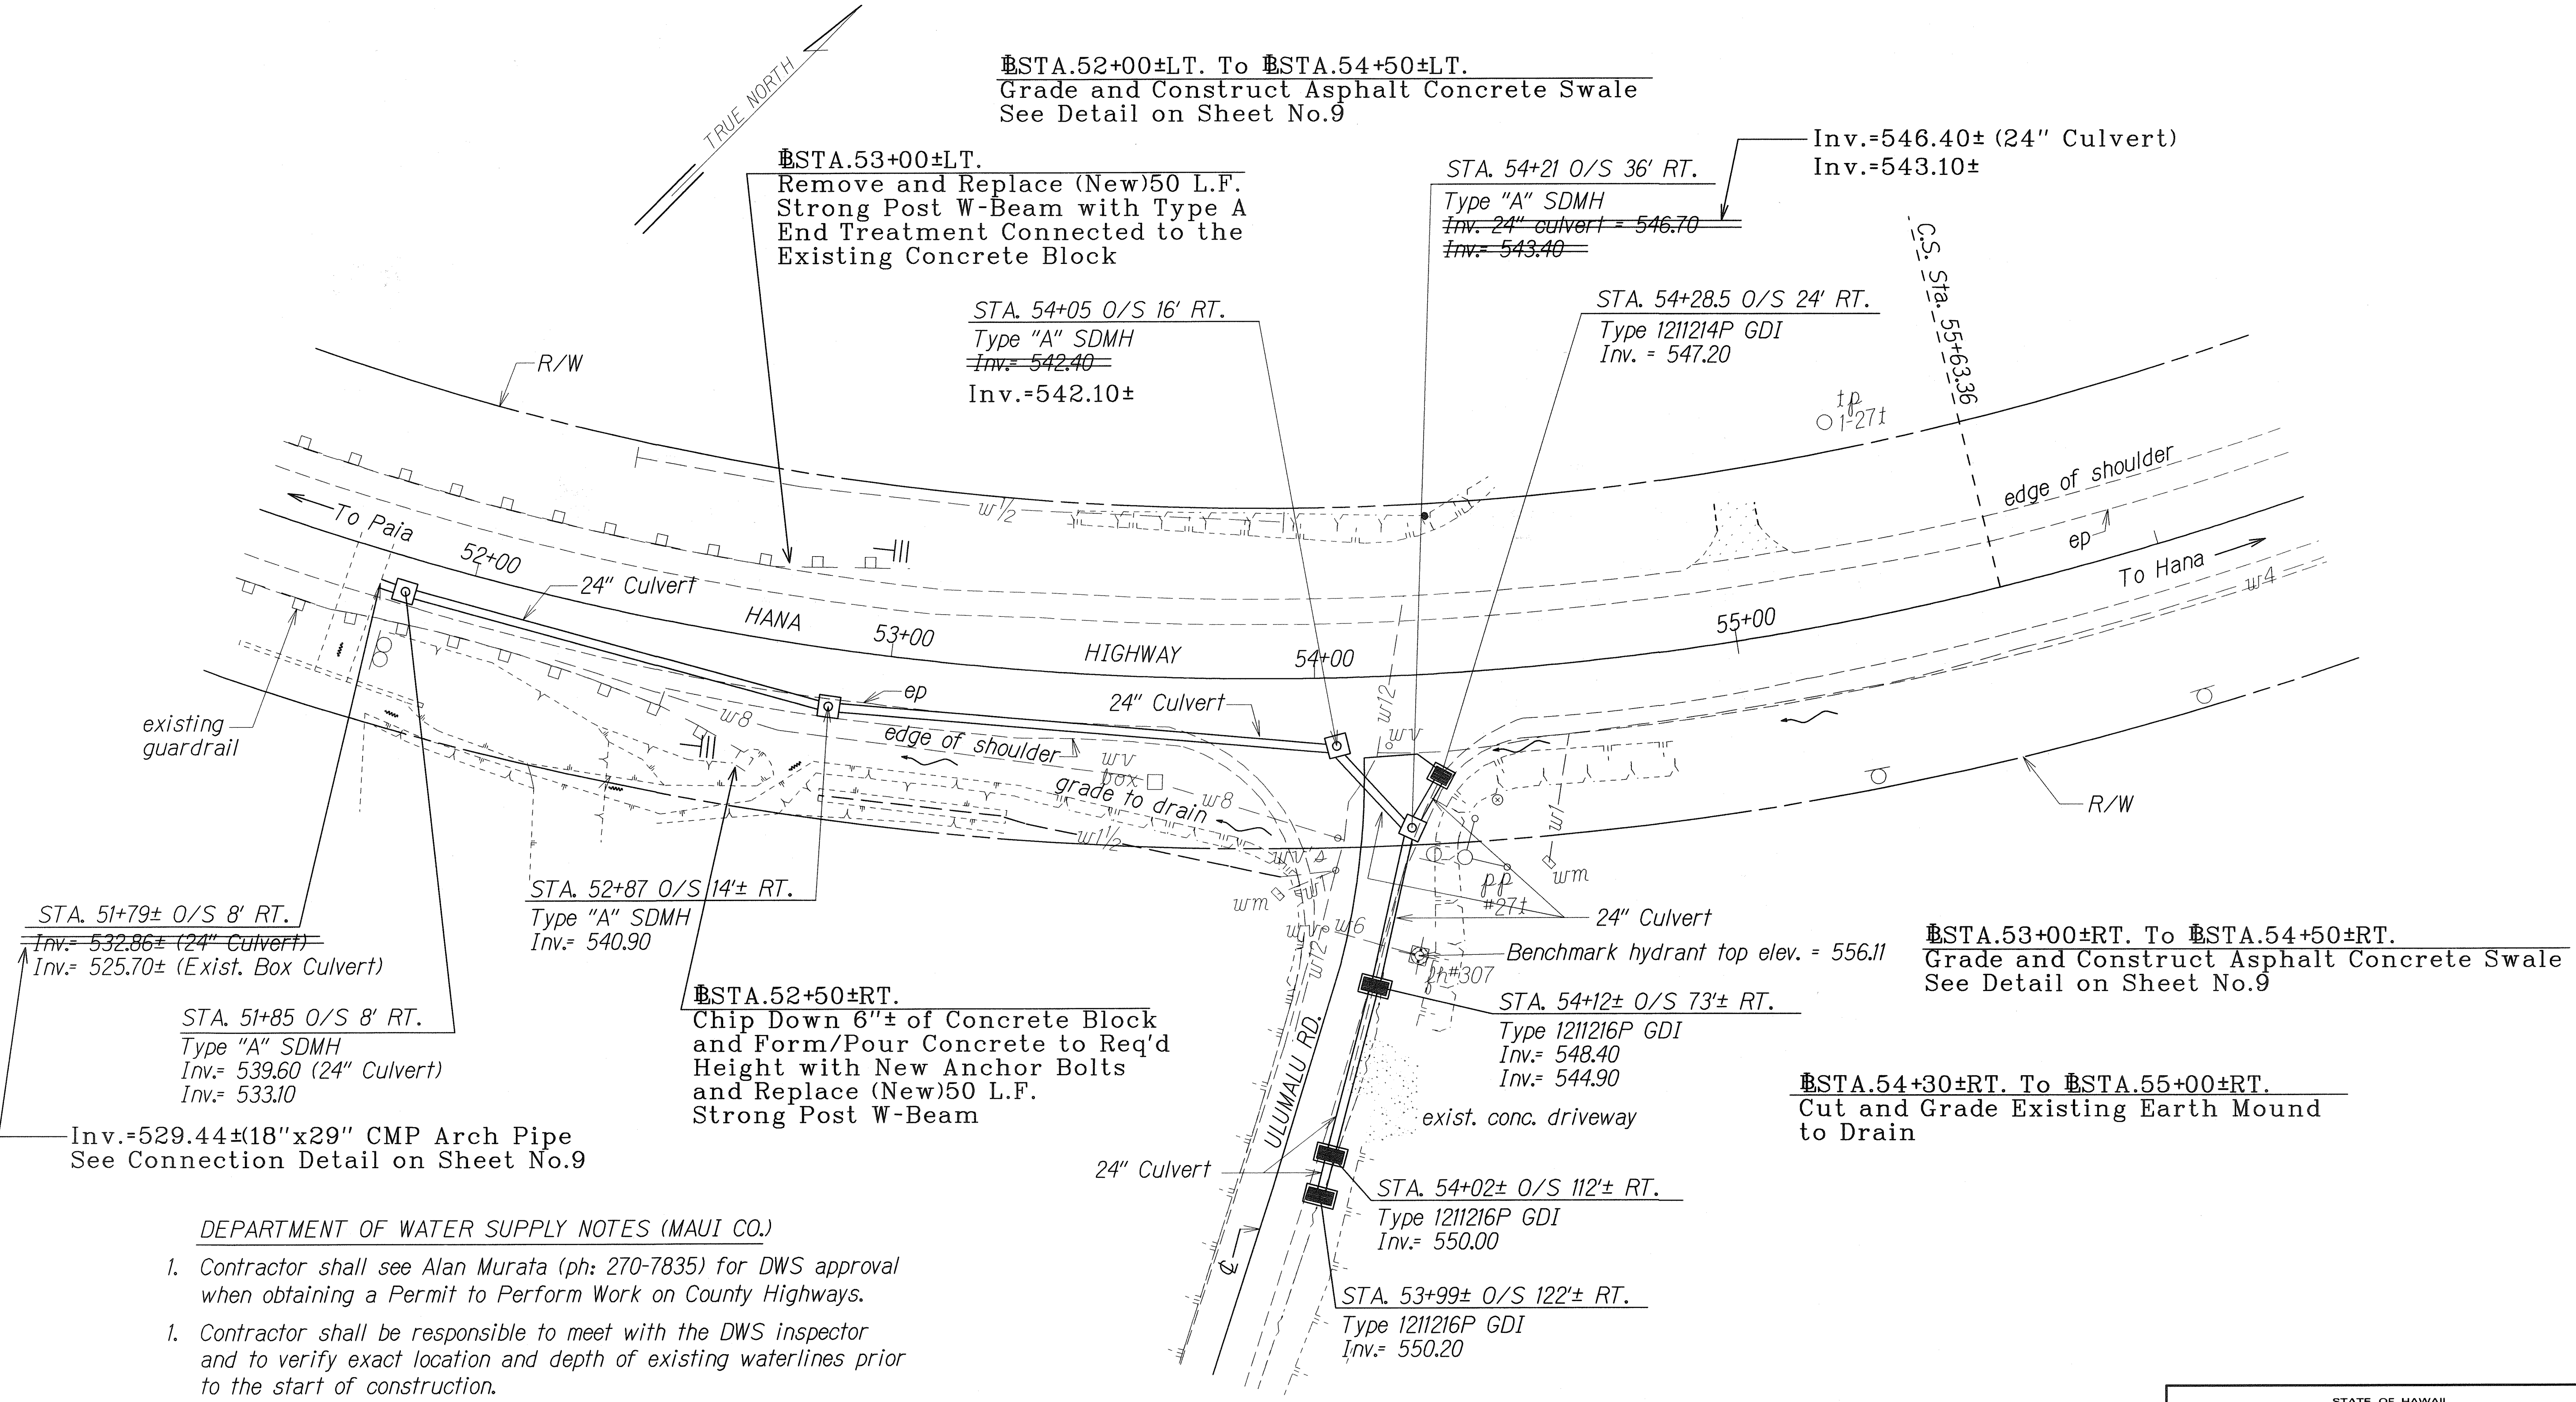

- DEPARTMENT OF WATER SUPPLY NOTES (MAUI CO.)
- Contractor shall see Alan Murata (ph: 270-7835) for DWS approval when obtaining a Permit to Perform Work on County Highways.
 - Contractor shall be responsible to meet with the DWS inspector and to verify exact location and depth of existing waterlines prior to the start of construction.
 - Maintain a minimum of 3 ft. clear horizontal separation between existing waterlines and new drain lines.
 - Maintain a minimum of 12" clear vertical separation between existing waterlines and new drain line. If the clearance is less than twelve inches (12"), the waterline shall be concrete jacketed in accordance with the 1985 DWS Standard Details.
 - At water line crossings, restore waterline pipe cushion per 2002 Water System Standards.

LEGEND FOR AS-BUILT POSTINGS	
	Squiggly line for as-built deletion
	Double line for as-built deletion
	Text for as-built posting

STATE OF HAWAII
DEPARTMENT OF TRANSPORTATION
HIGHWAYS DIVISION

DRAINAGE PLAN

HANA HIGHWAY DRAINAGE IMPROVEMENTS
Vicinity of Ulumalu Road
Project No. 36C-01-09

Scale: As Shown Date: April, 2010

SHEET No. H1 OF 3 SHEETS

PLAN
Scale: 1"=20'

"AS-BUILT"