



FED. ROAD DIST. NO.	STATE	PROJ. NO.	FISCAL YEAR	SHEET NO.	TOTAL SHEETS
HAWAII	HAW.	36C-01-09	2010	8	10

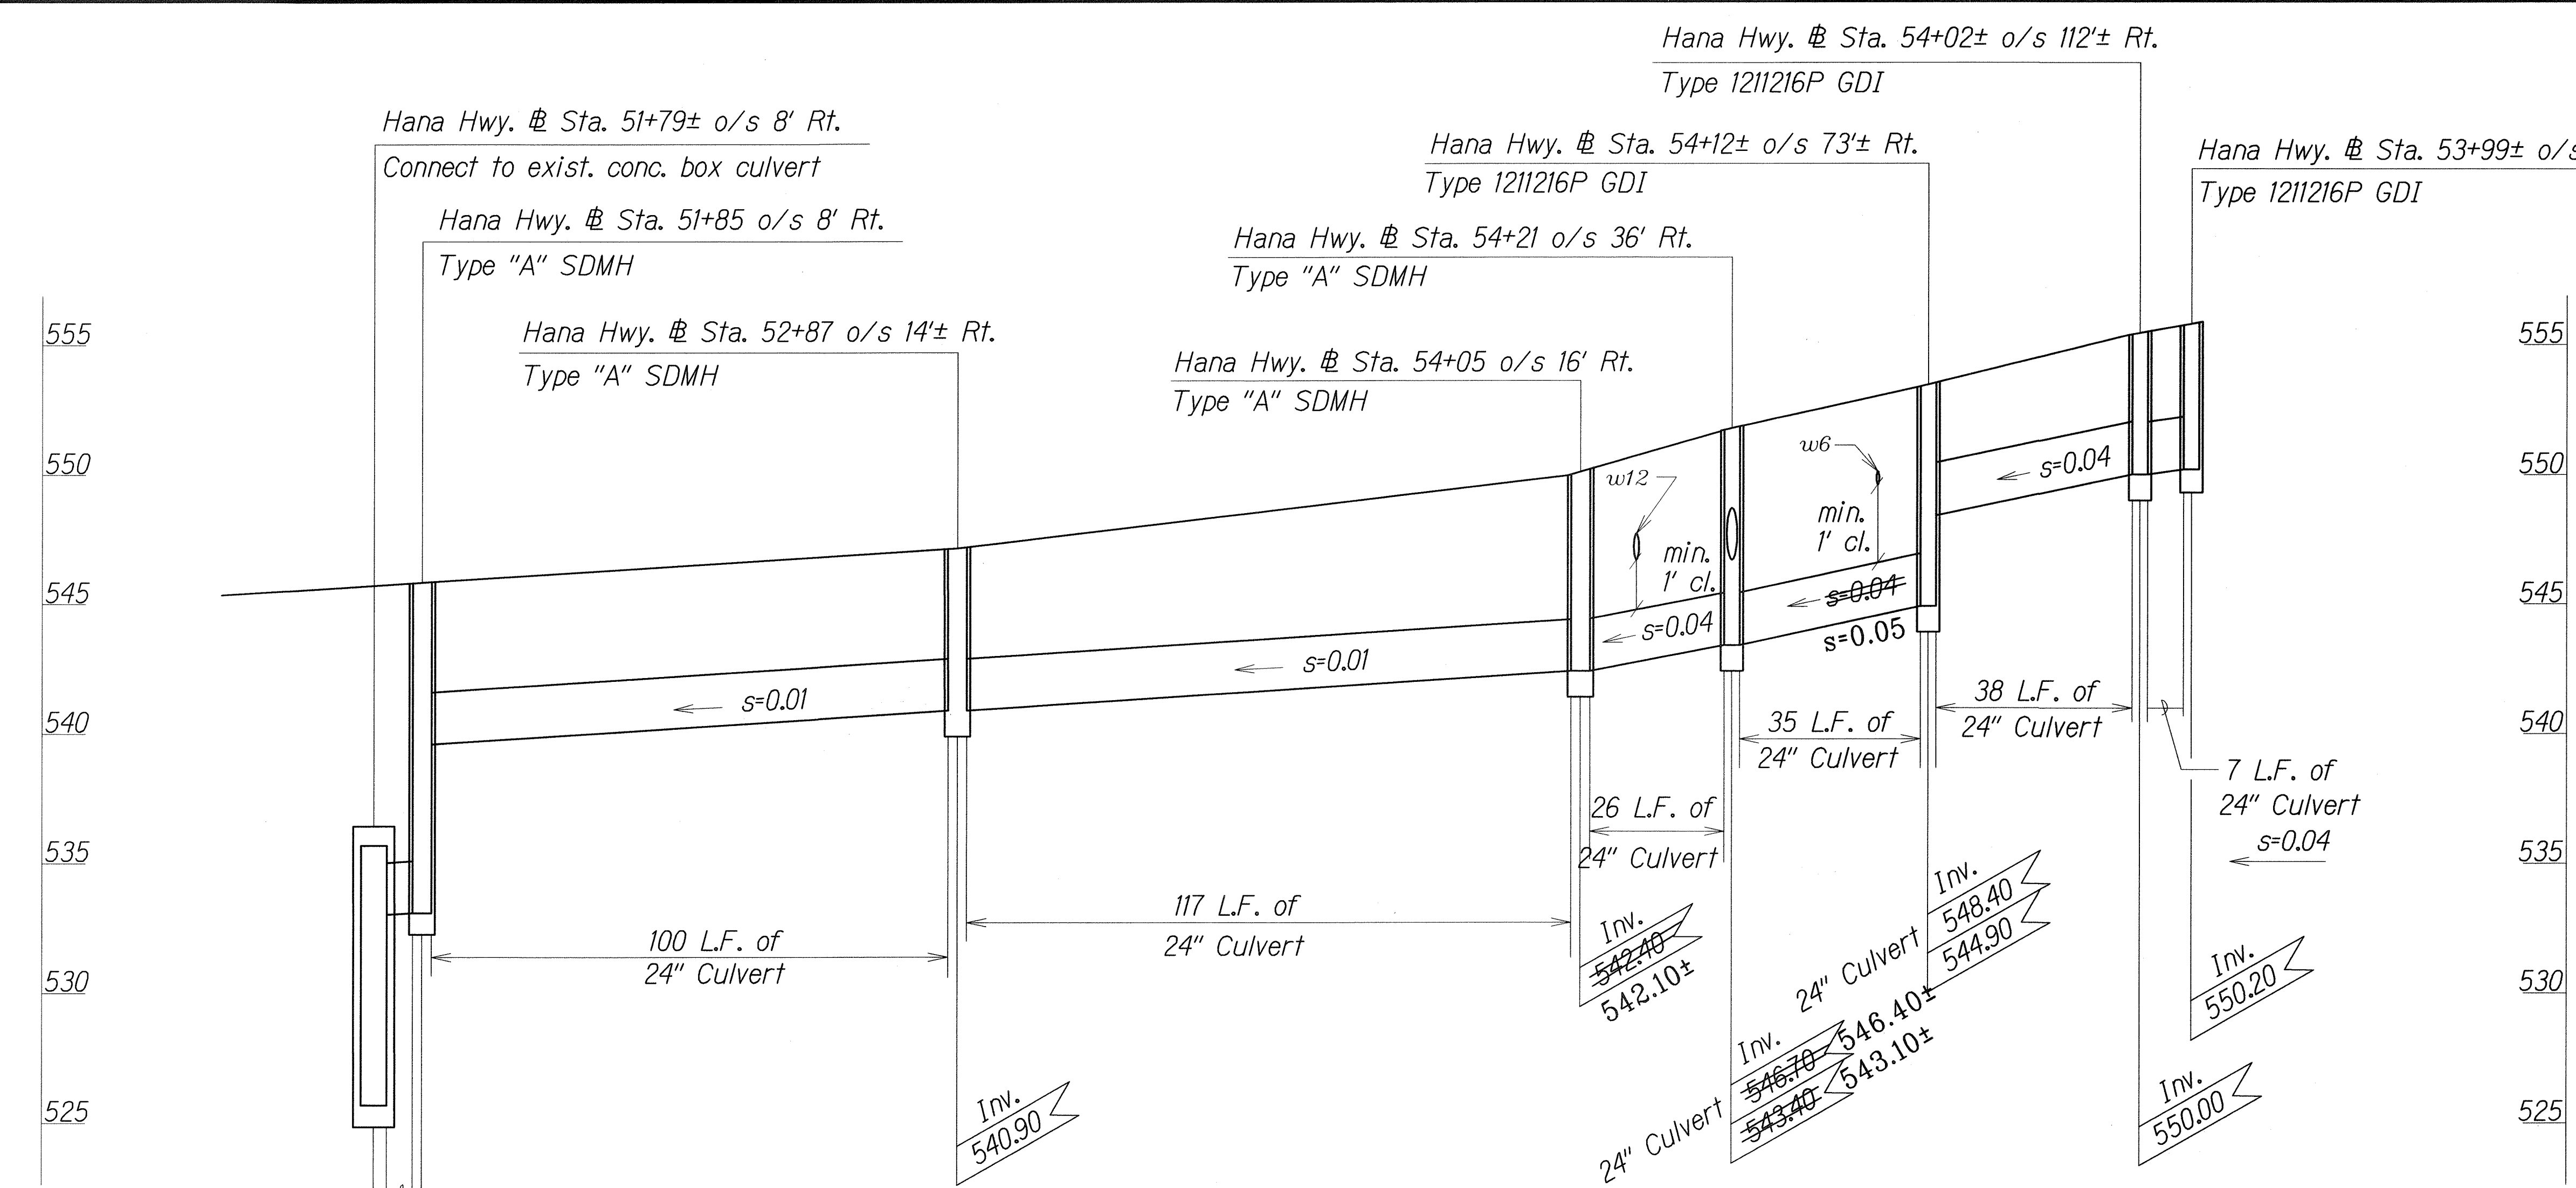

PROFILE - ALONG ϕ CULVERTS ϕ STA. 53+99 $\pm$ O/S 122' $\pm$ RT. TO ϕ STA. 51+79 $\pm$ O/S 8' RT.


Scale: Vert. 1"= 4'
Horz. 1"= 20'

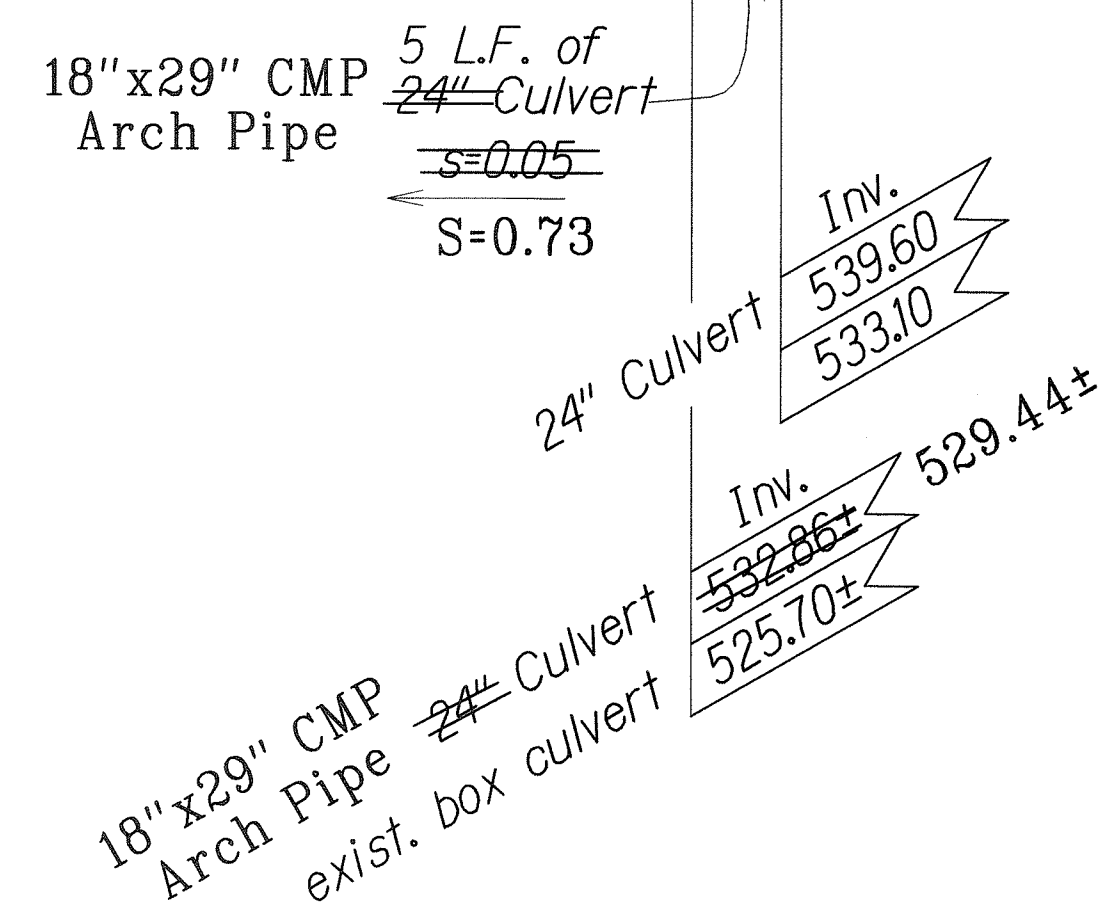

PROFILE - ALONG ϕ CULVERTS ϕ STA. 54+28.5

O/S 24' RT. TO ϕ STA. 54+21 O/S 36' RT.

Scale: Vert. 1"= 4'
Horz. 1"= 20'

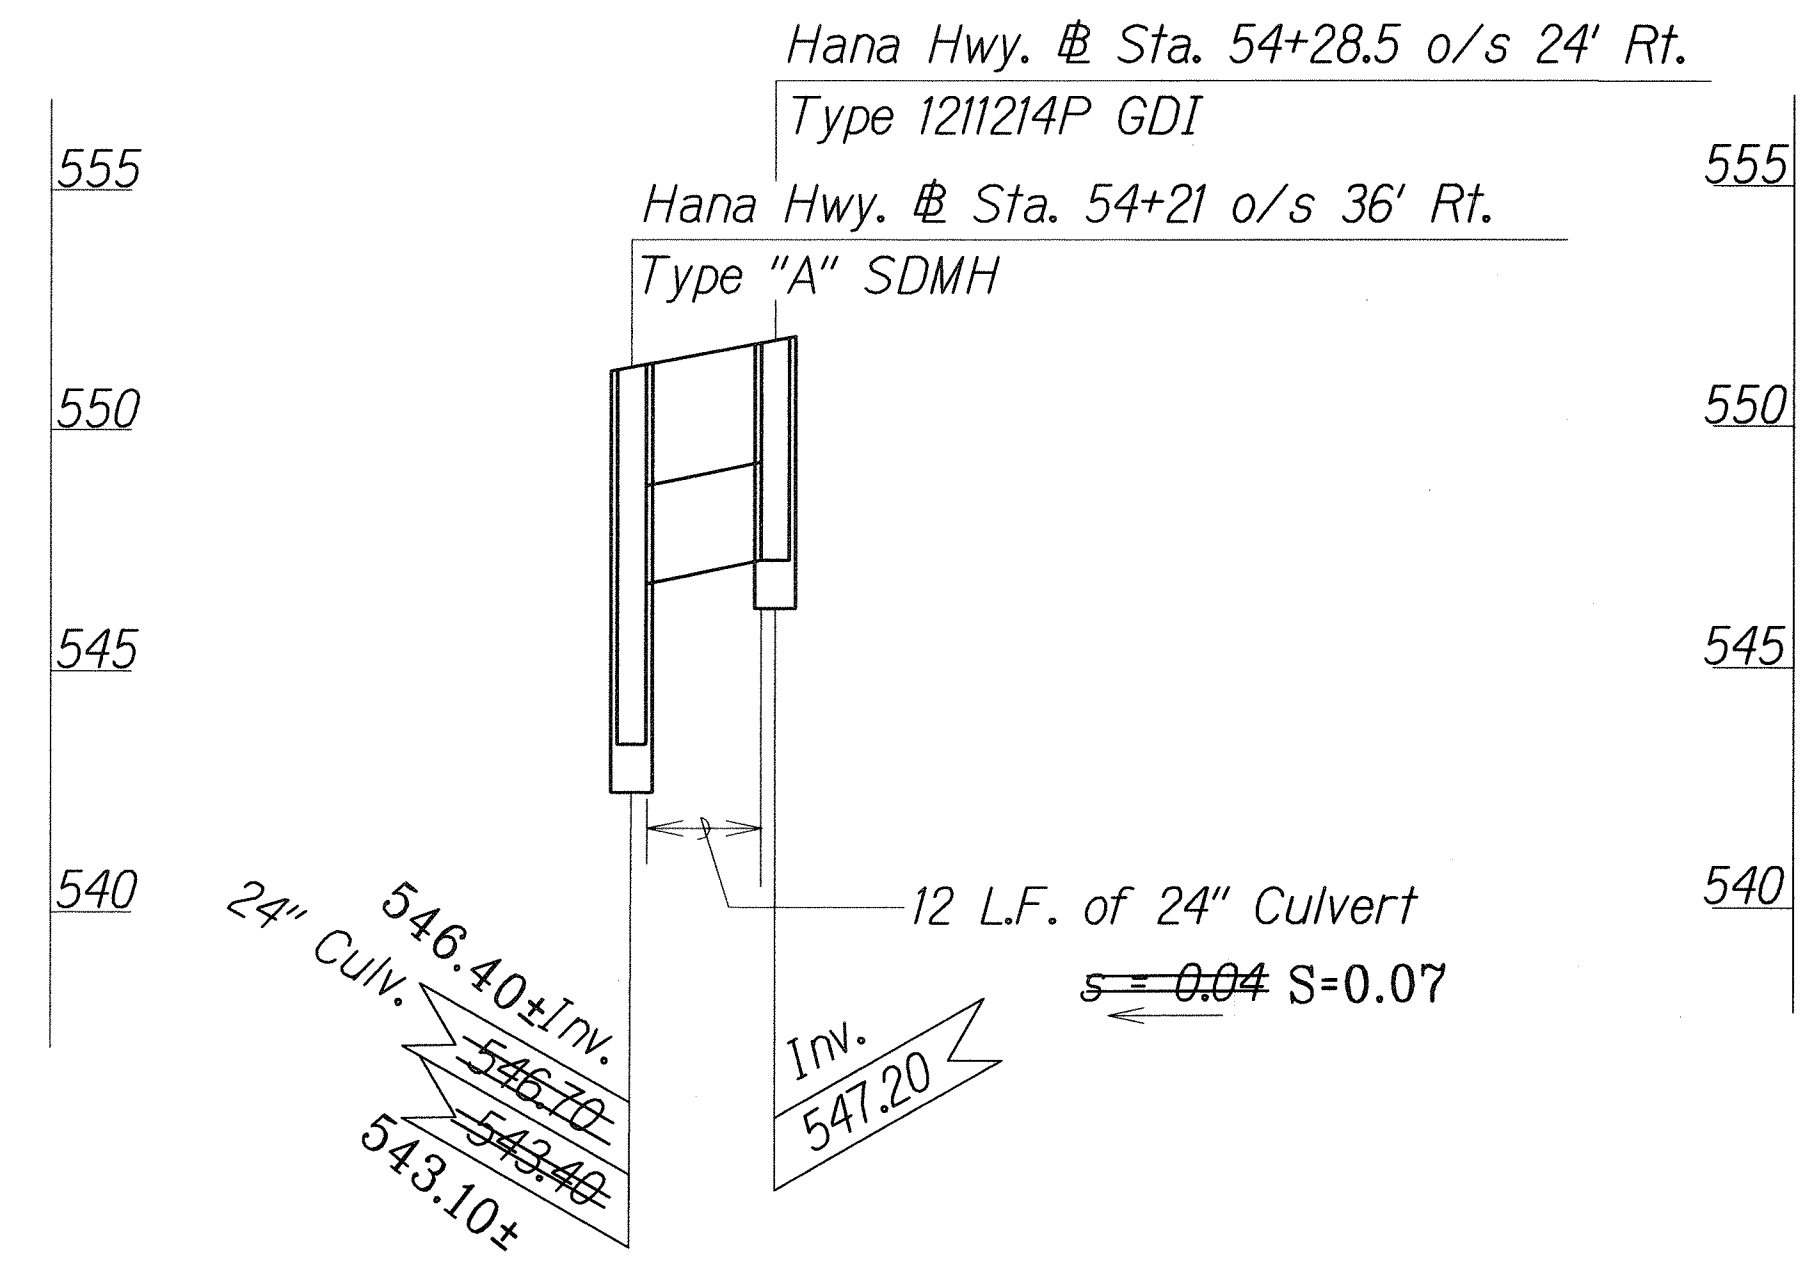

LEGEND FOR AS-BUILT POSTINGS	
	Squiggly line for as-built deletion
	Double line for as-built deletion
Roadway	Text for as-built posting

STATE OF HAWAII
DEPARTMENT OF TRANSPORTATION
HIGHWAYS DIVISION

DRAINAGE PROFILE

HANA HIGHWAY DRAINAGE IMPROVEMENTS

Vicinity of Ulumalu Road

Project No. 36C-01-09

Scale: As Noted
Date: April, 2010

SHEET No. H2 OF 3 SHEETS

"AS-BUILT"