



NOTES

- 1. Layout of pavement markings and striping shall be done by the Contractor and approved by the Engineer prior to any installation work.
- 2. Existing pavement markings not incorporated in the final traffic pattern shall be removed as directed by the Engineer. Costs shall be incidental to the various pavement marking items.
- 3. Raised pavement markers shall not be installed within crosswalks.
- 4. Final locations of all signs shall be approved by the Engineer prior to any installation work.
- 5. Existing signs not shown on these plans shall remain as posted unless otherwise directed by the Engineer. Removal and disposal of existing signs and/or post as designated on these plans shall be incidental to the various signing items.
- 6. Final locations of all Stop Lines shall be approved by the Engineer prior to installation.
- 7. All pavement striping shall be as noted on the legend or plans.
- 8. All preformed payement marking tapes over existing payement shall be applied with an approved primer as recommended by the tape manufacturer and as approved by the Engineer. The primer shall be allowed to dry to the tacky stage prior to tape application.
- 9. The Contractor shall erect at the beginning of the project and at the end of the project advance construction warning signs placed as indicated on the plans or as directed by the Engineer for the duration of the highway project and shall be maintained by the Contractor. These signs shall be placed in addition to the required traffic control signs called for in Section 645 - Traffic Control. The advance construction warning signs shall be new and become the property of the State. The Contractor shall remove, clean, and deliver the signs and posts to the District Baseyard, or as directed by the Engineer, upon the completion of

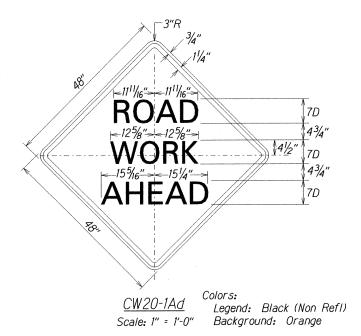

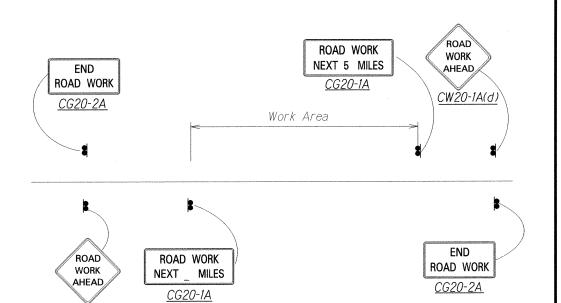

CONSTRUCTION SIGN LAYOUT DETAIL

Not to Scale

STATE

HAW


HAWAII

12

23

2015

36C-01-15M

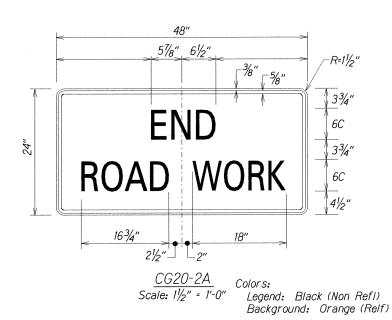

CW20-1A(d)

STATE OF HAWAII
DEPARTMENT OF TRANSPORTATION PAVEMENT MARKING LEGEND, DETAILS & NOTES HANA HIGHWAY RESURFACING

Kaupakalua Road to Huelo Project No. 36C-01-15M

Scale: As Noted Date: April, 2015

SHEET No. 1 OF 1 SHEETS