


FED. ROAD DIST. NO.	STATE	PROJ. NO.	FISCAL YEAR	SHEET NO.	TOTAL SHEETS
HAWAII	HAW.	36BC-02-17M	2018	ADD.30	42

STA. 37+60 LT. TO STA. 37+22.5 LT.

Demolish and remove existing end terminal and install new end terminal Type FLEAT 350 (1 EA). Pave under guardrail, behind and front of end terminal. Payment shall be paid under contract Item No. 401.0200.

STA. 41+70 LT. TO STA. 52+40 LT.

Pave under guardrail, behind and front of end terminals. Payment shall be paid under contract Item No. 401.0200.

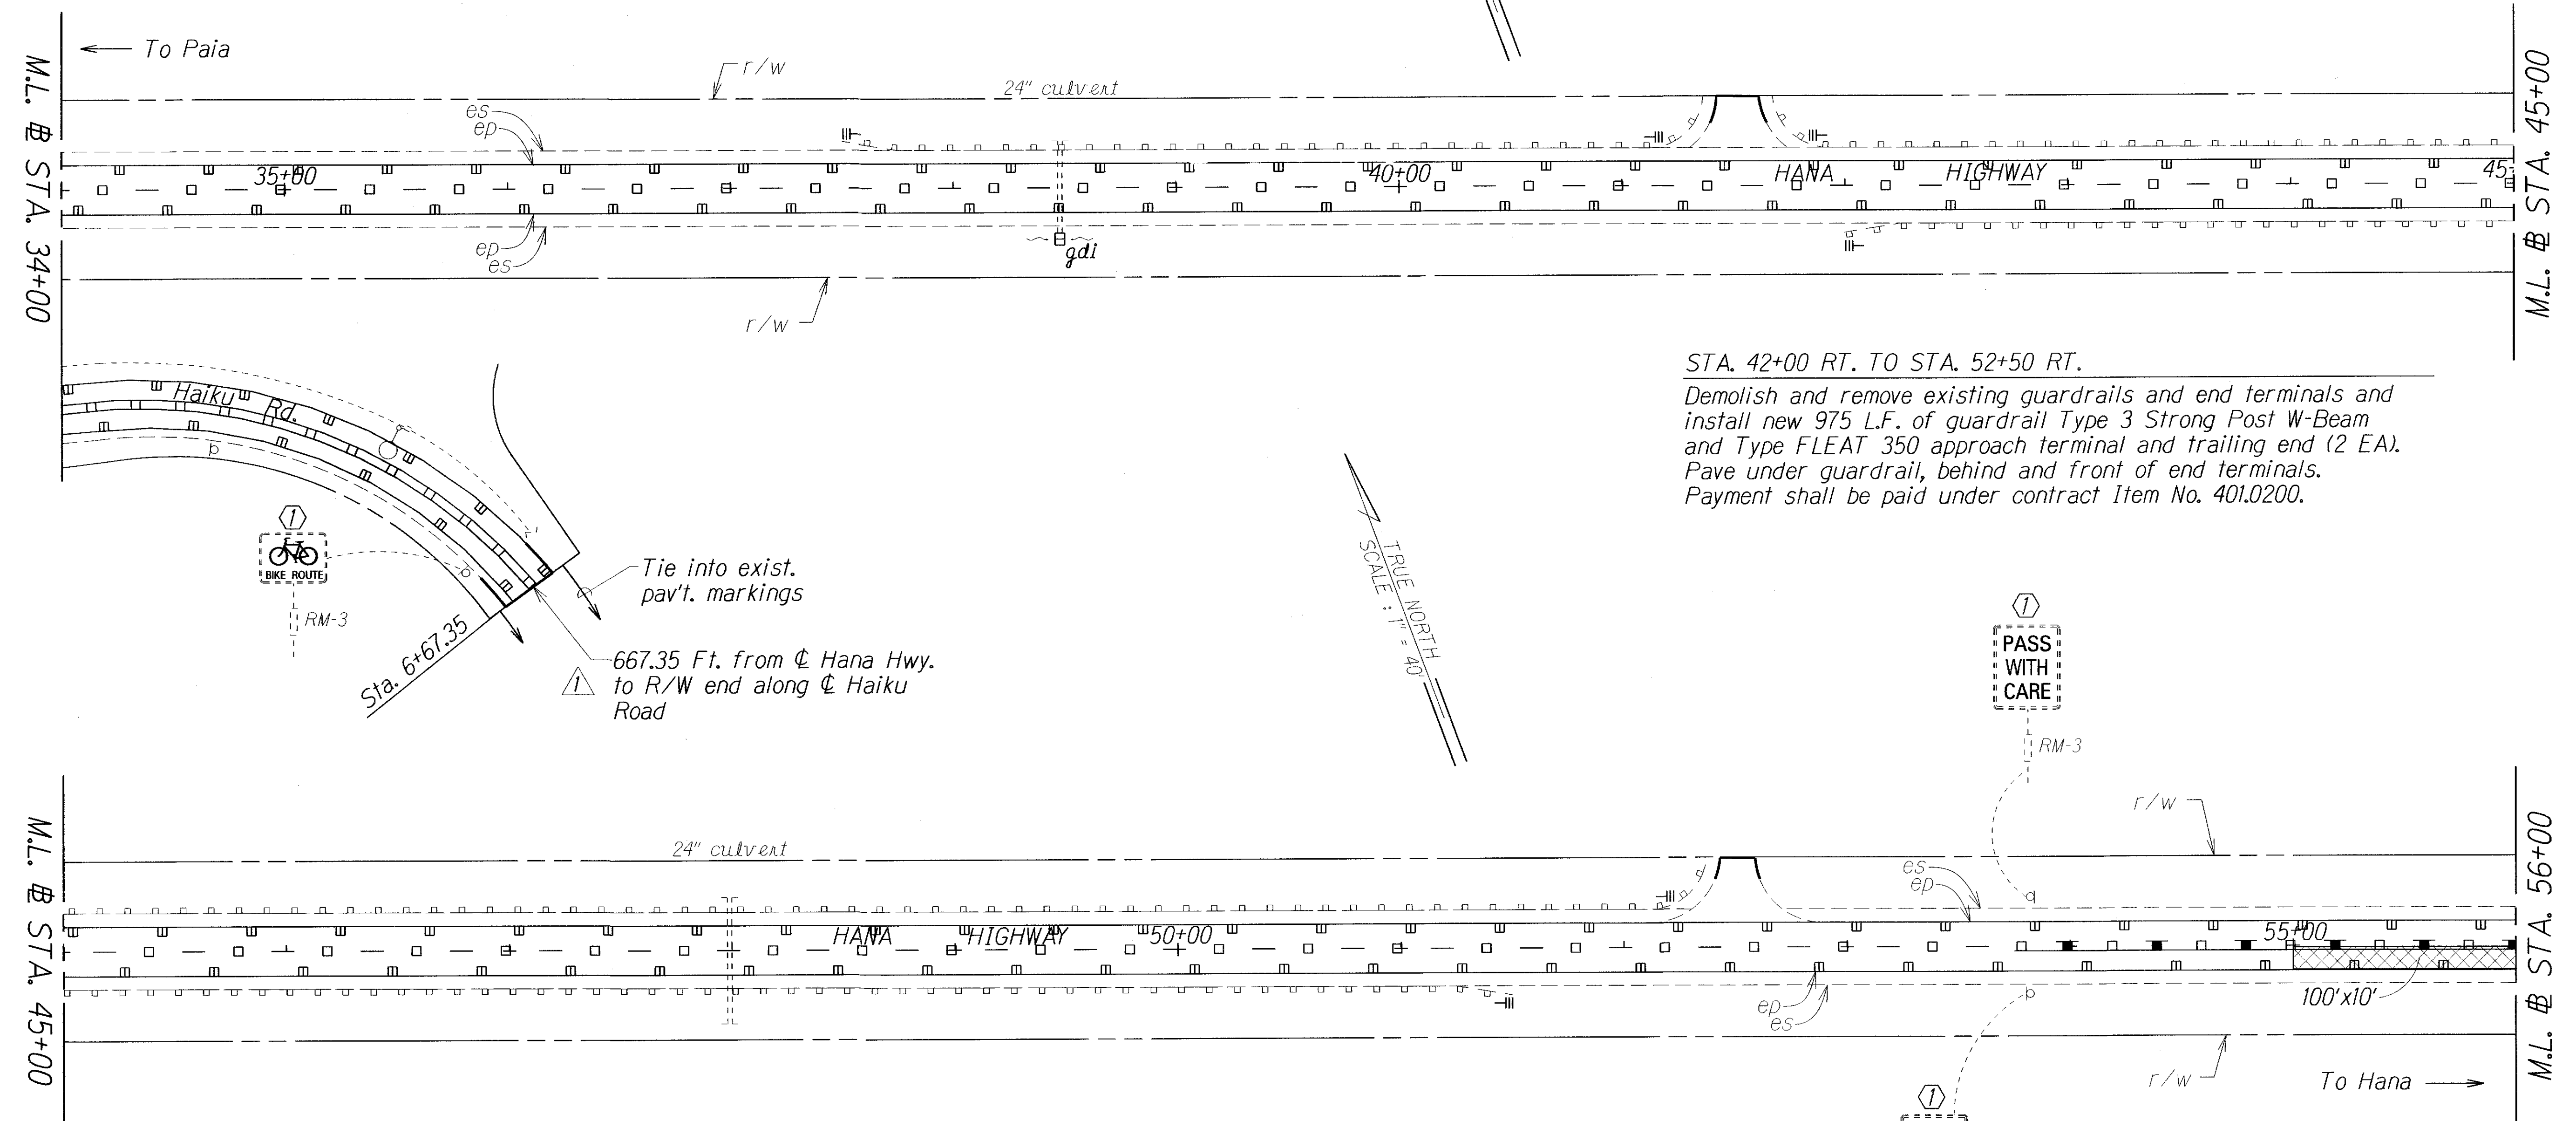

1	11-15-17	Station of Side Roads.
DATE	REVISION	


KEY:

- ① Exist. Sign(s) & Post(s) to Remain
- ② Remove Exist. Sign(s) & Post(s)
- ③ Remove Exist. & Install New Sign(s) & Post(s)
- ④ Install New Sign(s) & Post(s)

STATE OF HAWAII
DEPARTMENT OF TRANSPORTATION
HIGHWAYS DIVISION

ROADWAY & PAVEMENT MARKING PLAN
HANA HIGHWAY RESURFACING
Hookipa Park to Kaupakalua Road
Project No. 36BC-02-17M
Scale: 1" = 40' Date: December, 2016
SHEET No. 7 OF 19 SHEETS

FED. ROAD DIST. NO.	STATE	PROJ. NO.	FISCAL YEAR	SHEET NO.	TOTAL SHEETS
HAWAII	HAW.	36BC-02-17M	2018	ADD.32	42

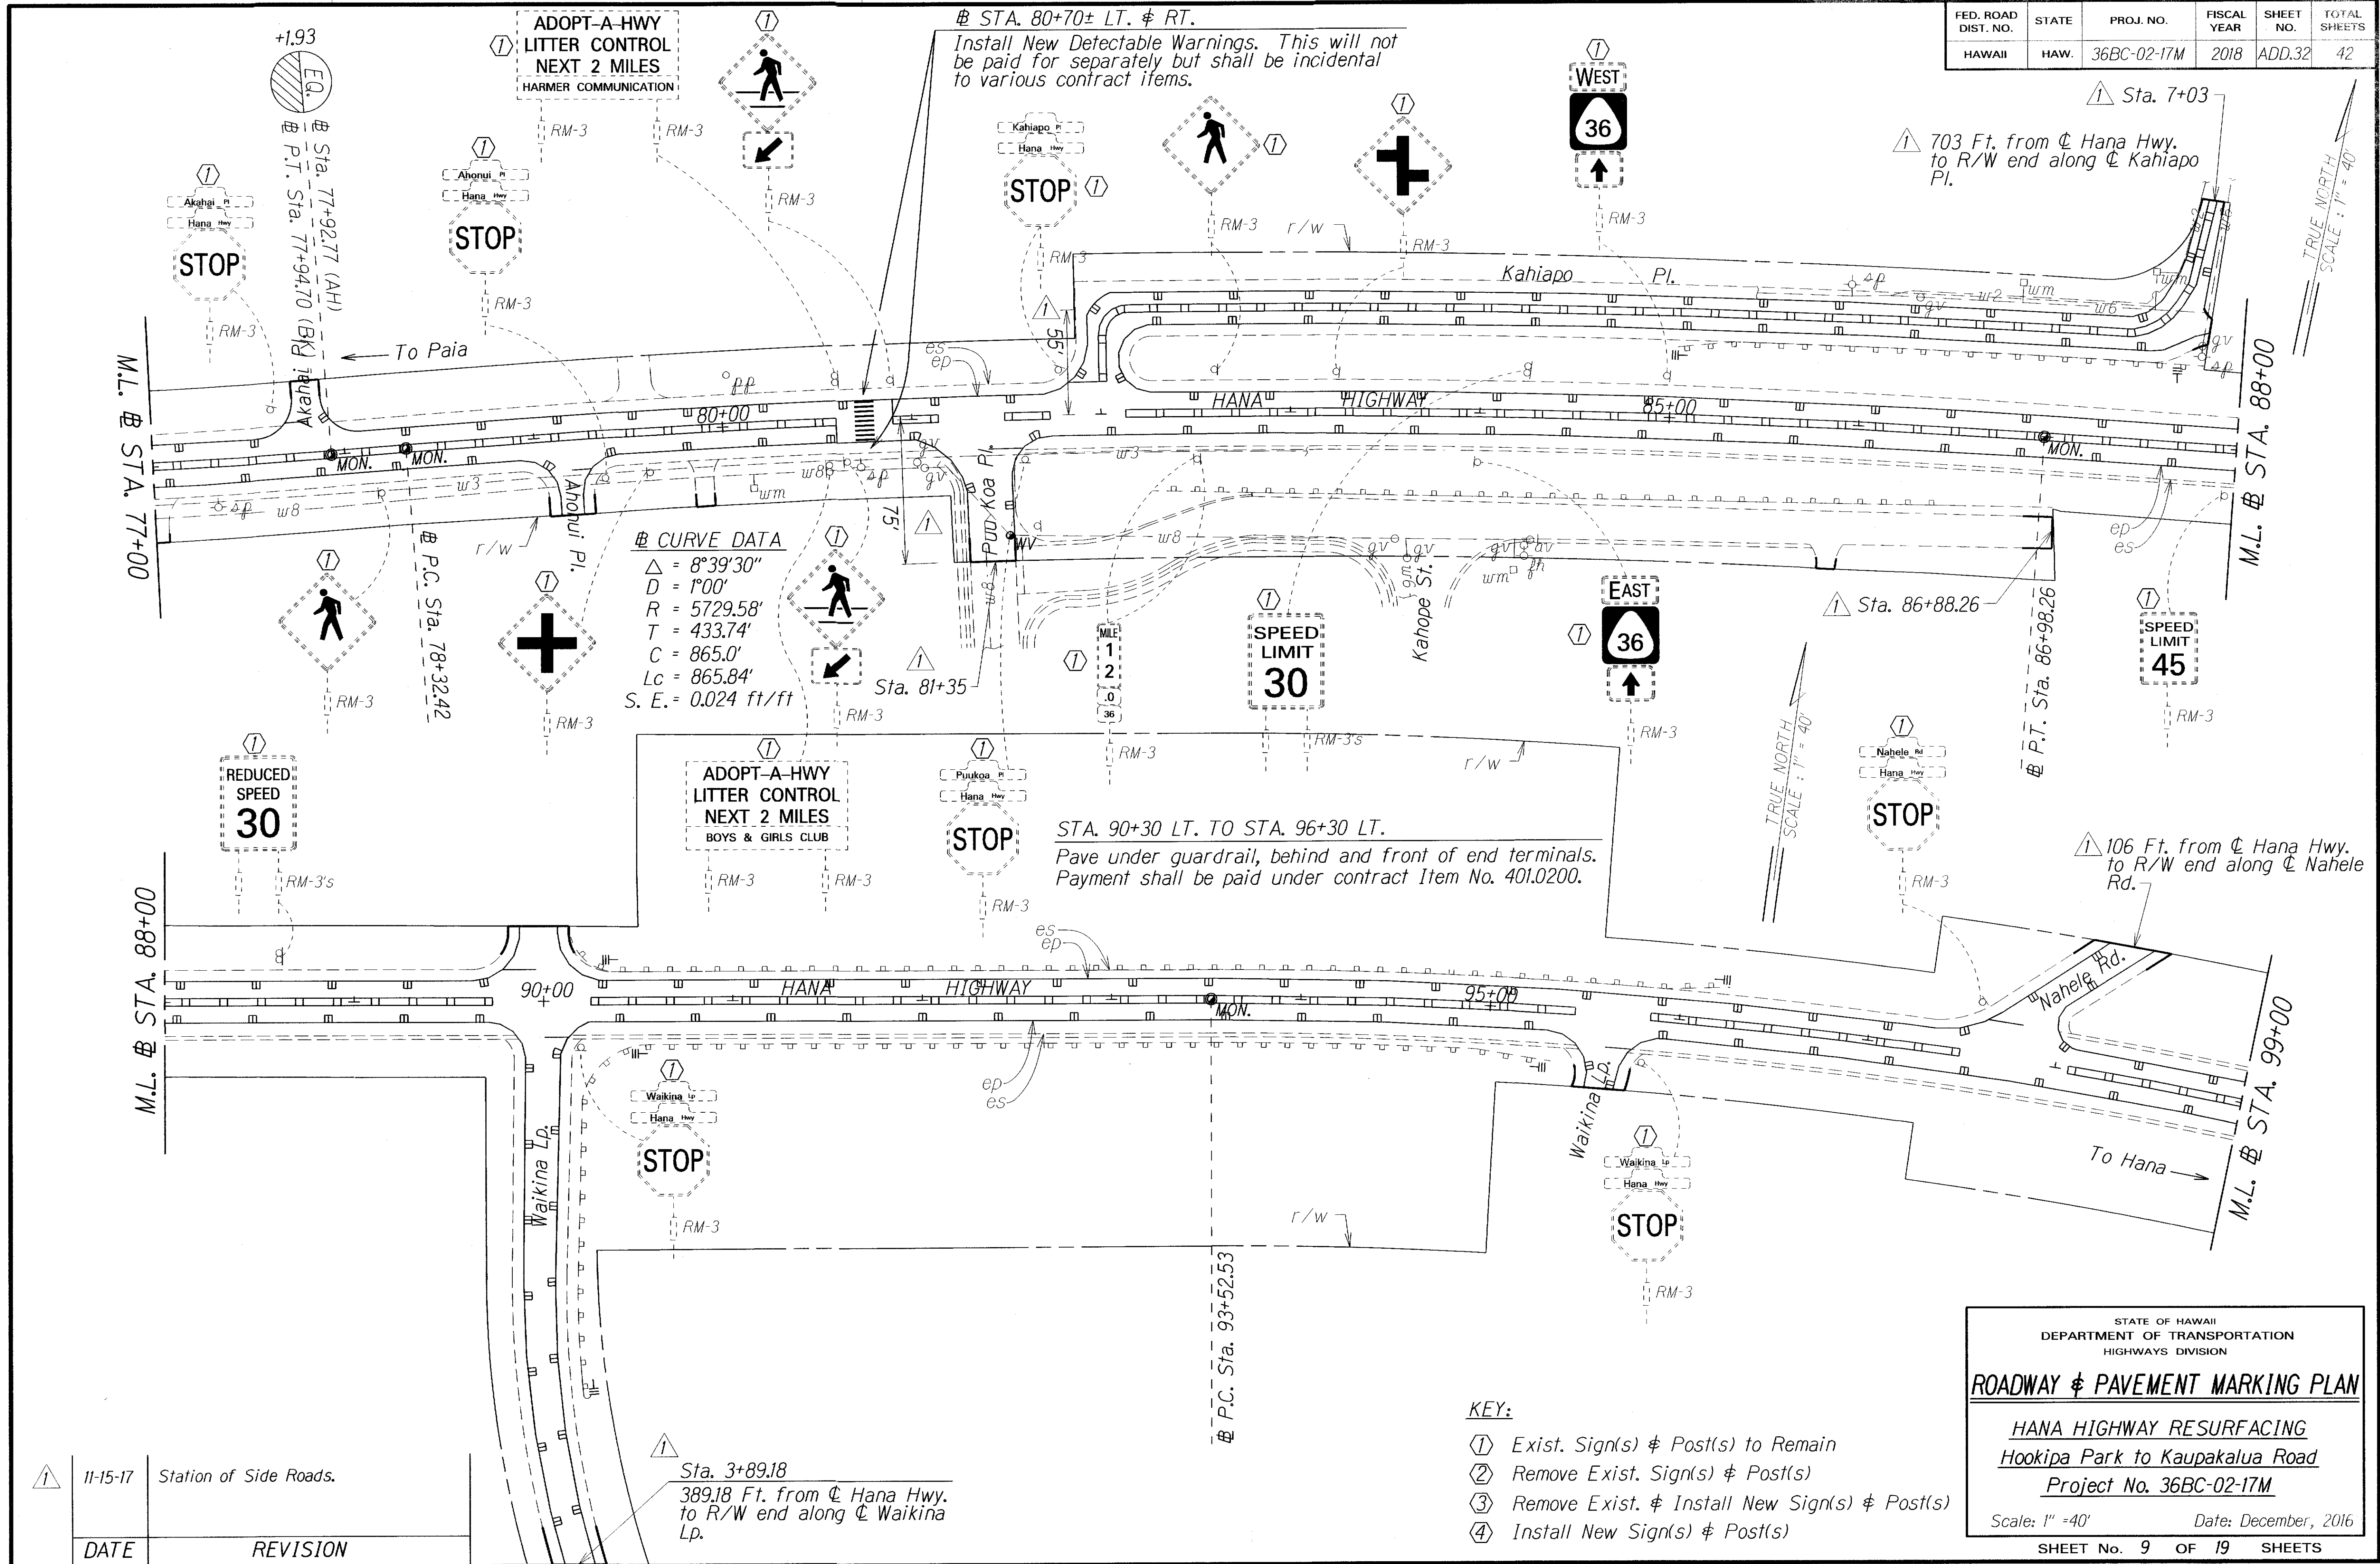


ORIGINAL PLAN	DATE
DRAWN BY	
DESIGNED BY	
QUANTITIES BY	
CHECKED BY	

1	11-15-17	Station of Side Roads.
DATE	REVISION	

FED. ROAD DIST. NO.	STATE	PROJ. NO.	FISCAL YEAR	SHEET NO.	TOTAL SHEETS
HAWAII	HAW.	36BC-02-17M	2018	ADD.33	42

STA. 108+80 LT. TO STA. 113+00 LT.
Pave under guardrail, behind and front of end terminals.
Payment shall be paid under contract Item No. 401.0200.

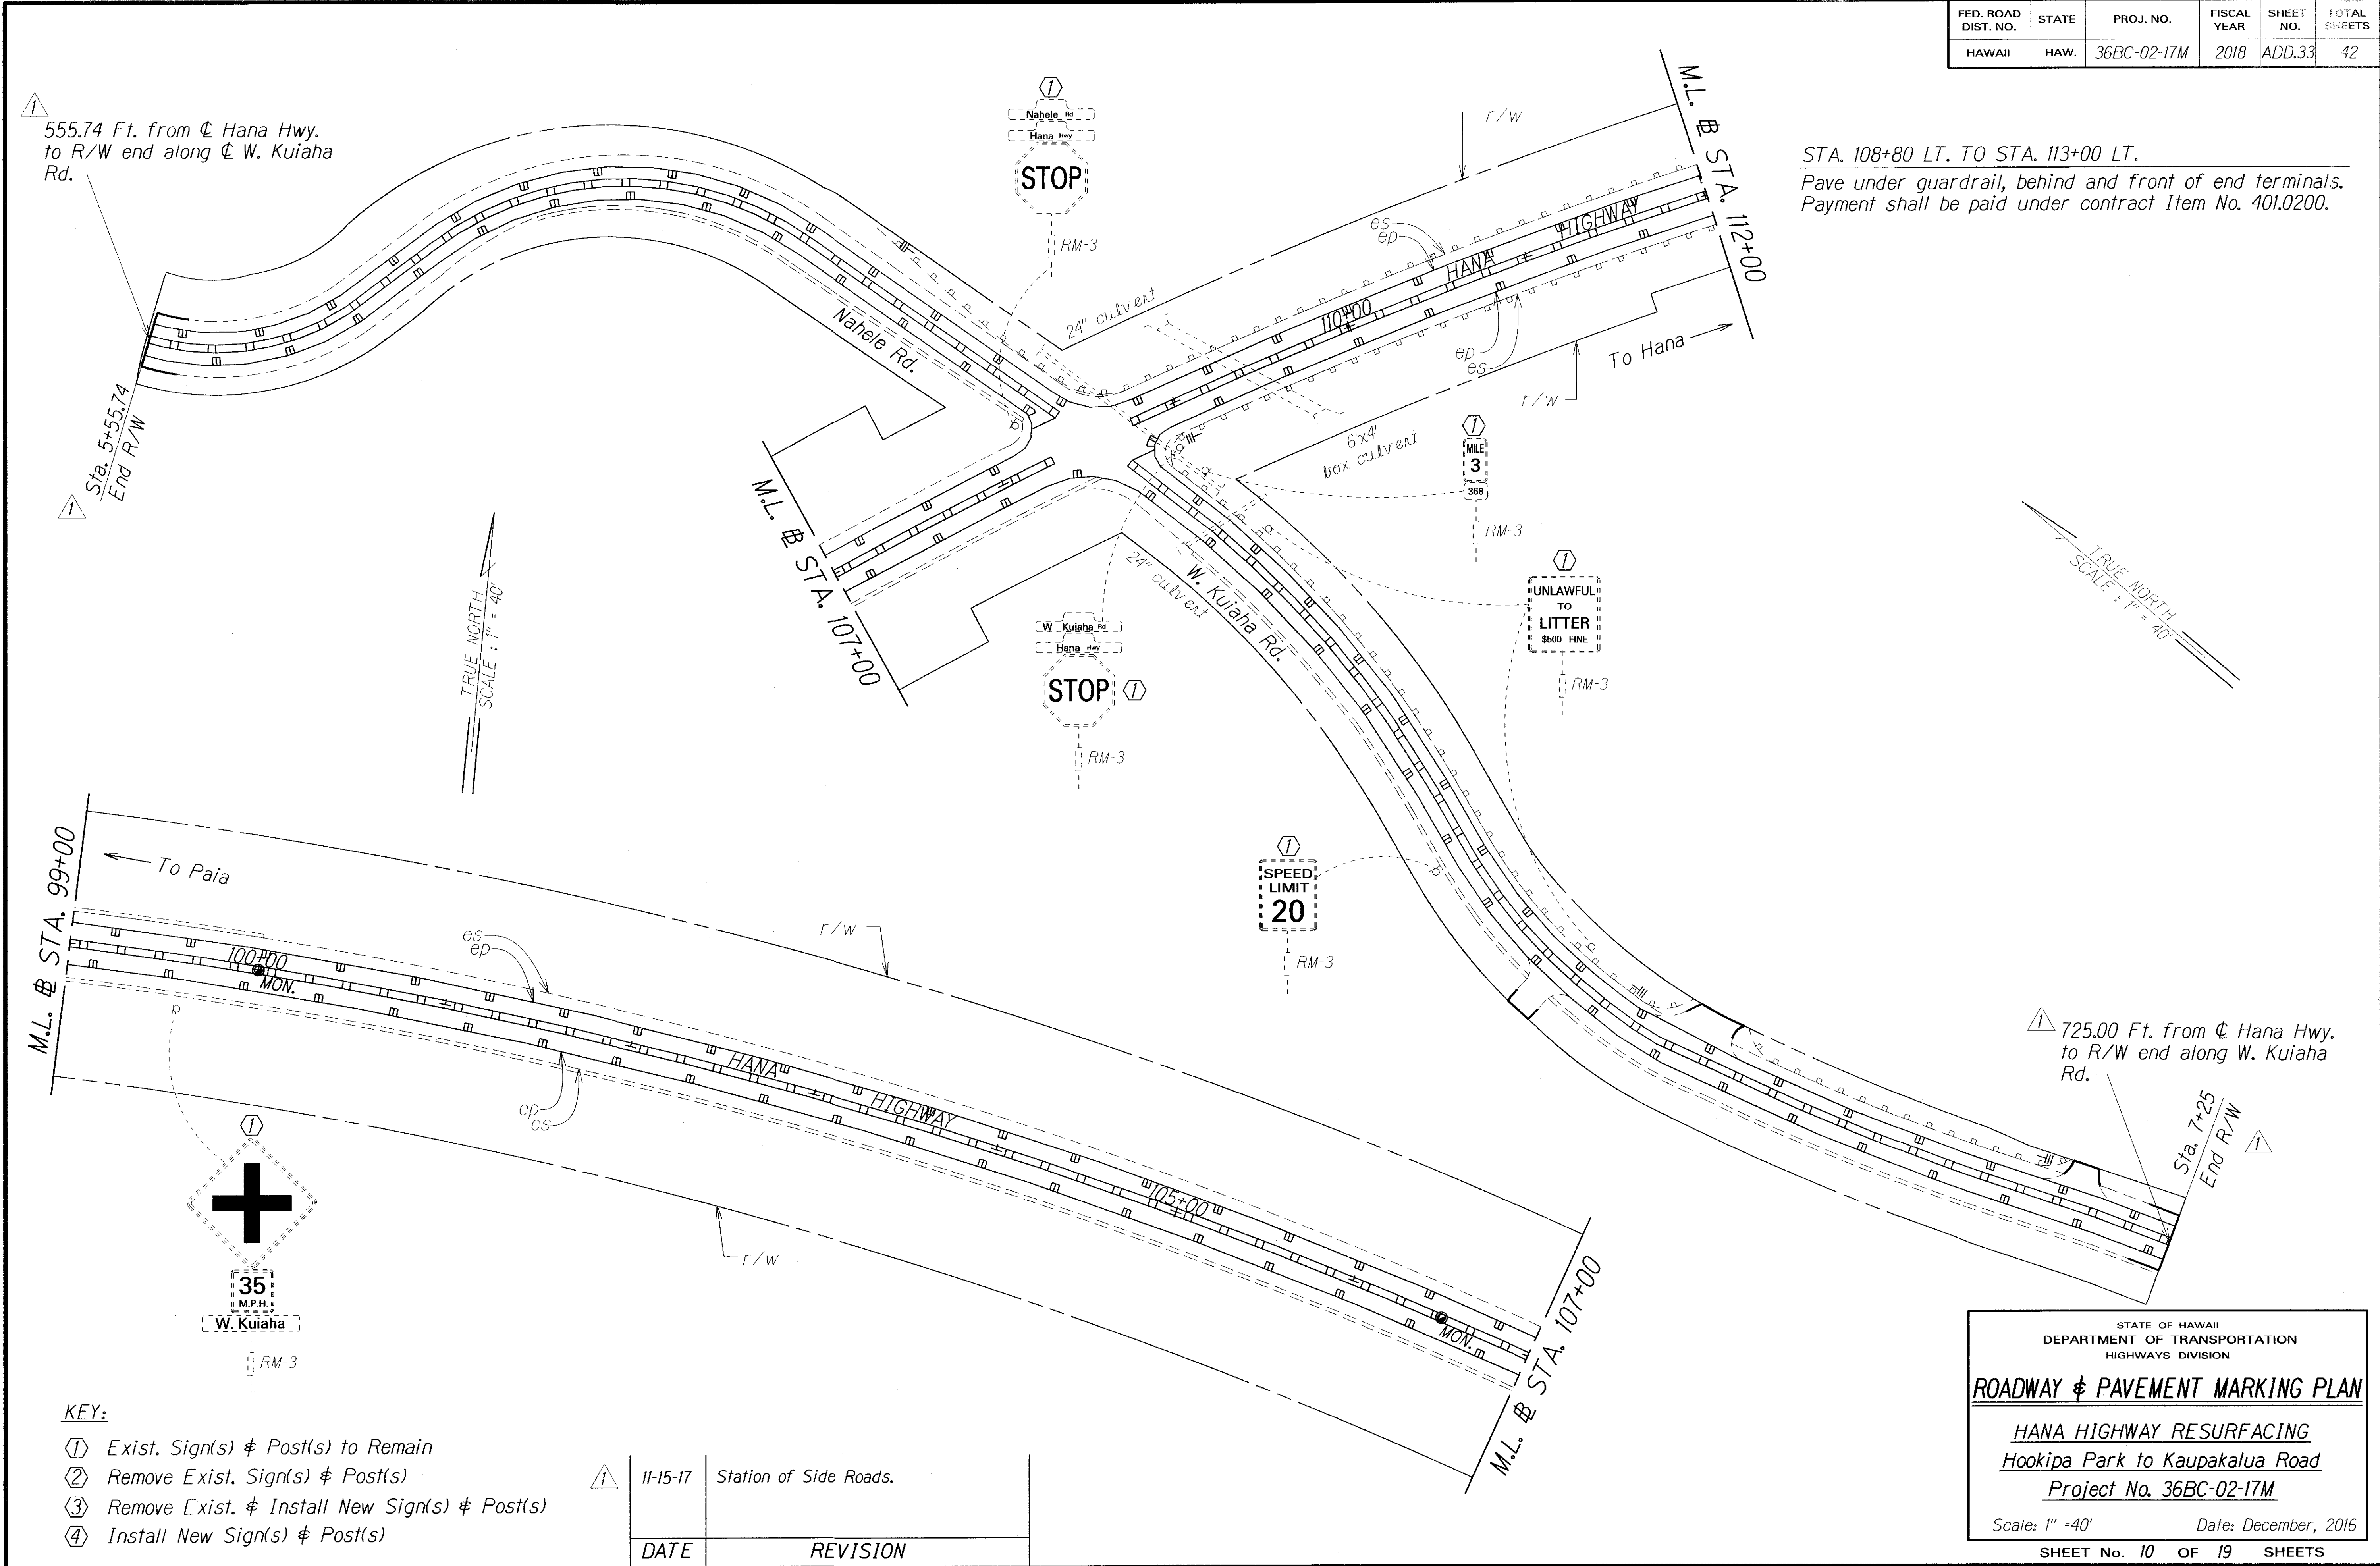

SURVEY PLOTTED BY	DATE
DRAWN BY	
DESIGNED BY	
QUANTITIES BY	
CHECKED BY	

- KEY:
- ① Exist. Sign(s) & Post(s) to Remain
 - ② Remove Exist. Sign(s) & Post(s)
 - ③ Remove Exist. & Install New Sign(s) & Post(s)
 - ④ Install New Sign(s) & Post(s)

①	11-15-17	Station of Side Roads.
DATE	REVISION	

STATE OF HAWAII
DEPARTMENT OF TRANSPORTATION
HIGHWAYS DIVISION


ROADWAY & PAVEMENT MARKING PLAN

HANA HIGHWAY RESURFACING
Hookipa Park to Kaupakalua Road
Project No. 36BC-02-17M

Scale: 1" = 40'
Date: December, 2016

SHEET No. 10 OF 19 SHEETS

FED. ROAD DIST. NO.	STATE	PROJ. NO.	FISCAL YEAR	SHEET NO.	TOTAL SHEETS
HAWAII	HAW.	36BC-02-17M	2018	ADD.36	42

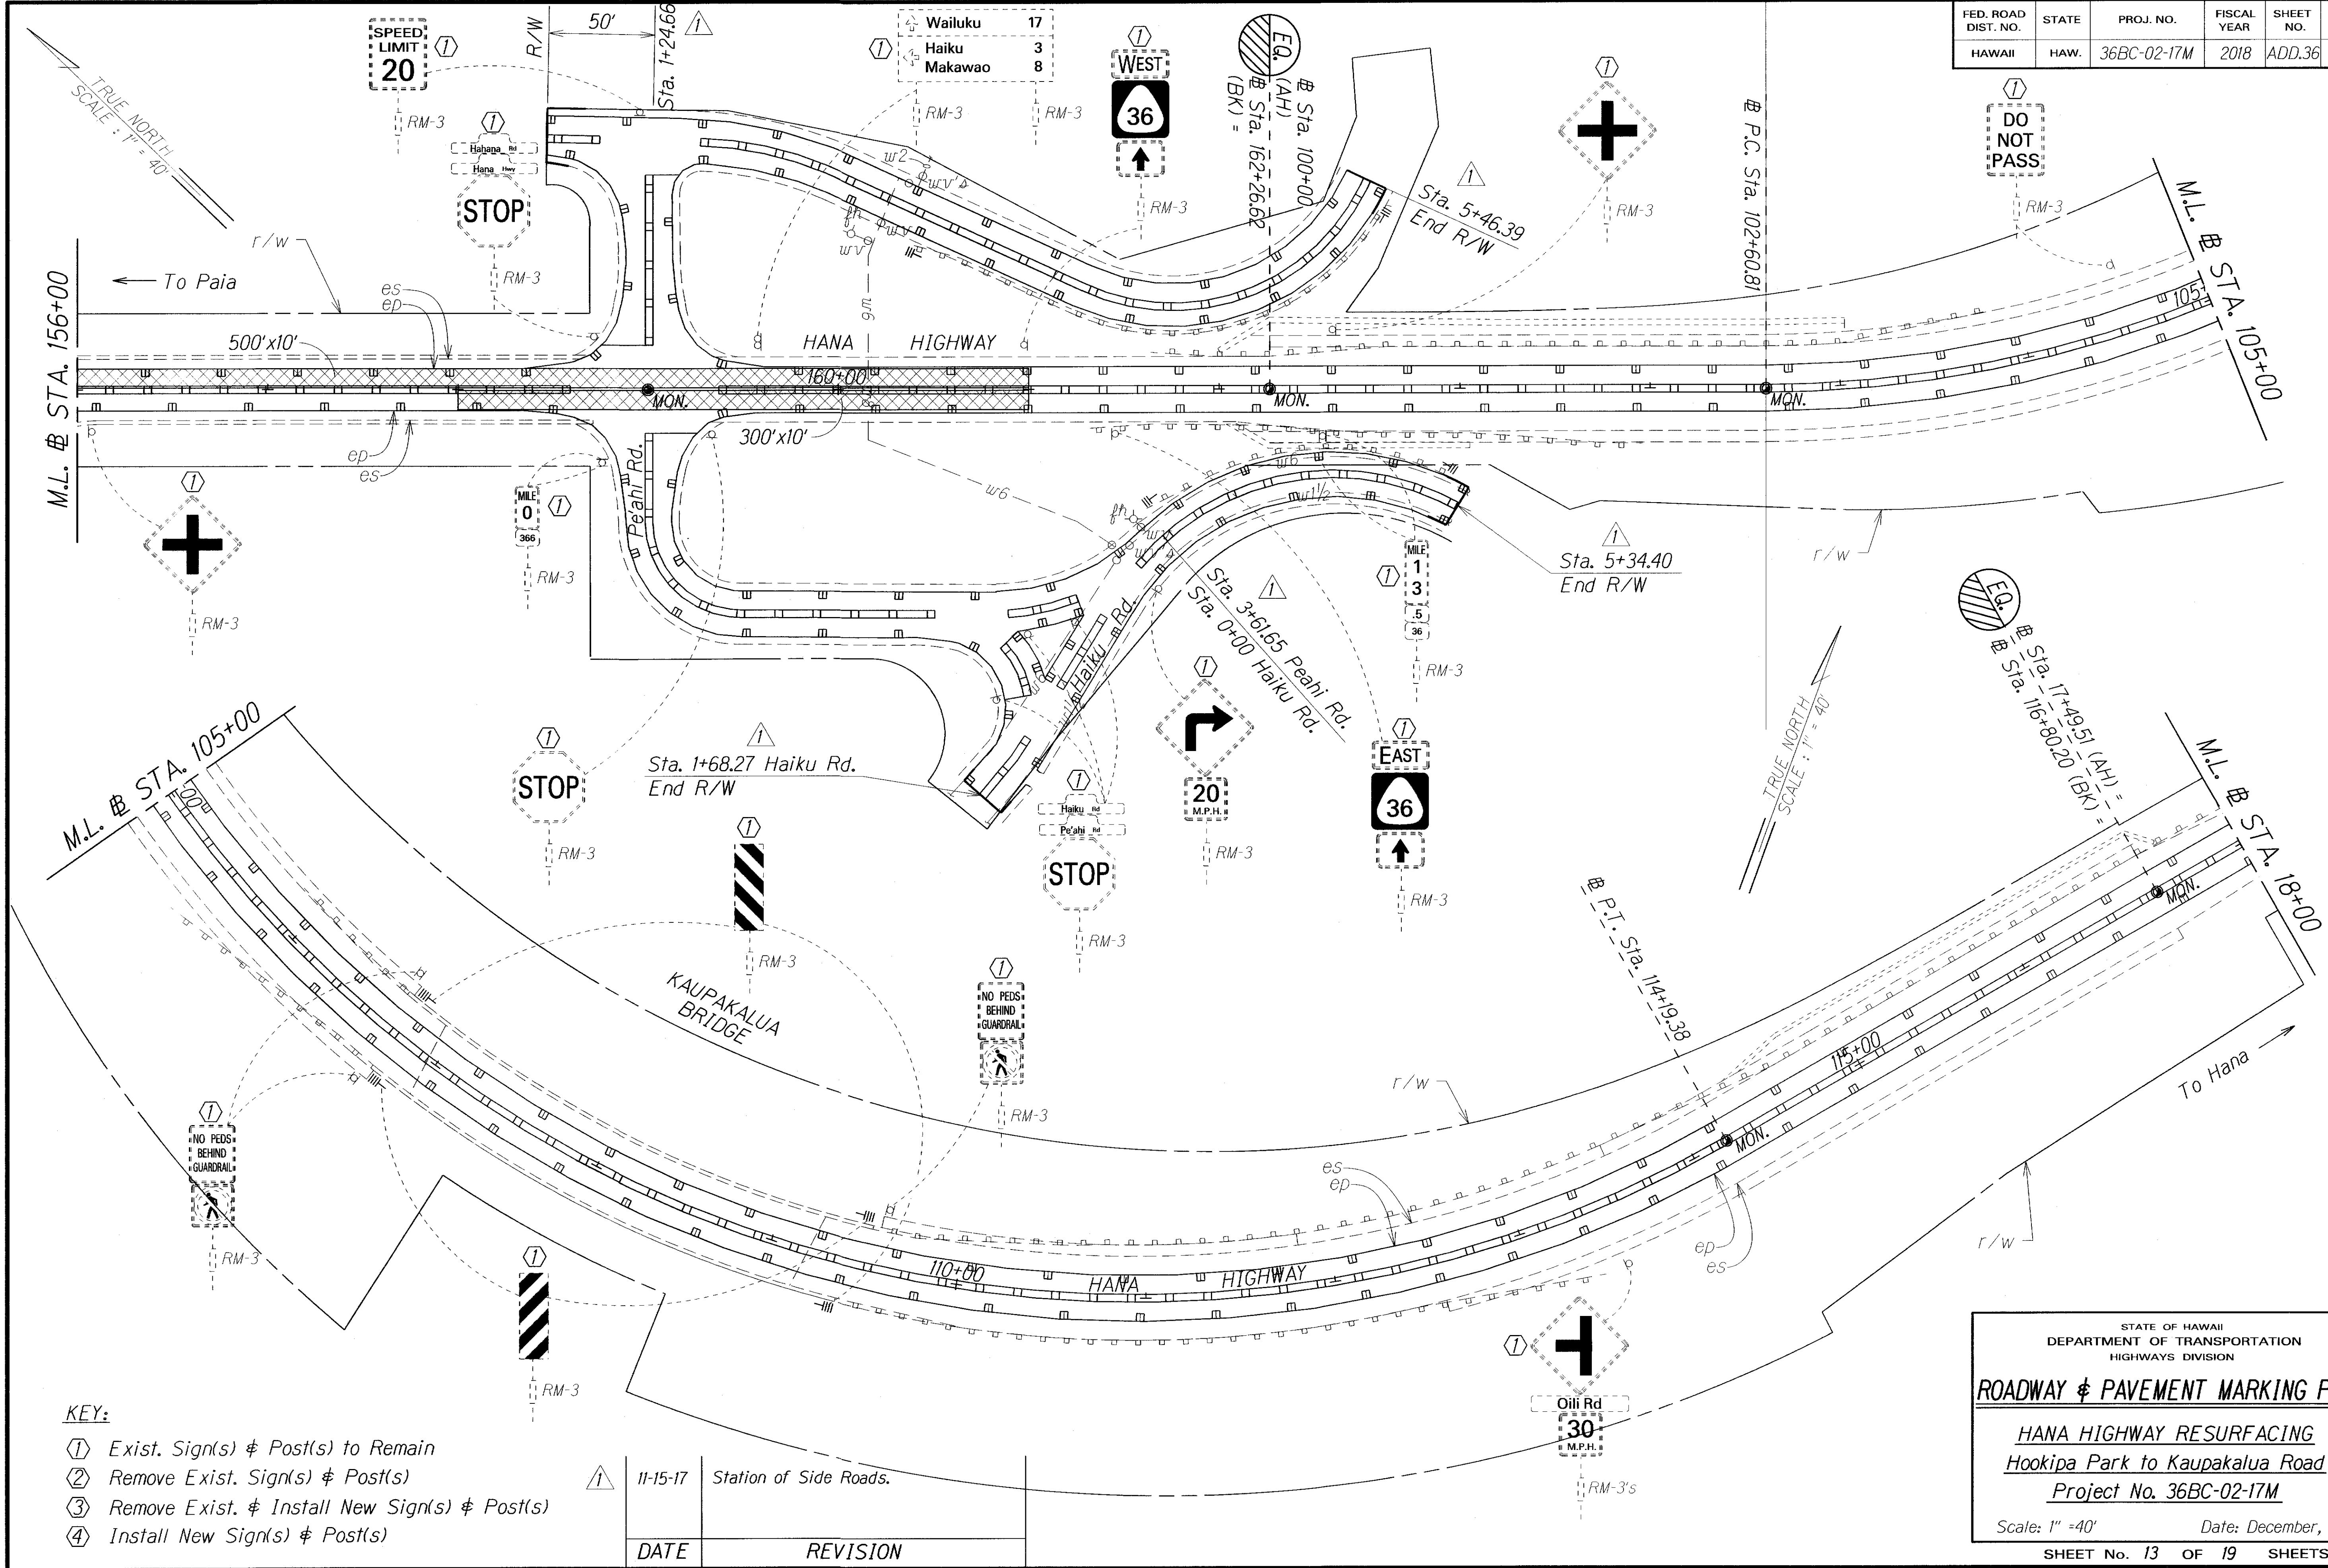

ORIGINAL PLAN	DATE
DESIGNED BY	
TRACED BY	
QUANTITIES BY	
CHECKED BY	

KEY:

- ① Exist. Sign(s) & Post(s) to Remain
- ② Remove Exist. Sign(s) & Post(s)
- ③ Remove Exist. & Install New Sign(s) & Post(s)
- ④ Install New Sign(s) & Post(s)

① 11-15-17 Station of Side Roads.

DATE	REVISION
------	----------

STATE OF HAWAII
DEPARTMENT OF TRANSPORTATION
HIGHWAYS DIVISION

ROADWAY & PAVEMENT MARKING PLAN

HANA HIGHWAY RESURFACING
Hookipa Park to Kaupakalua Road
Project No. 36BC-02-17M

Scale: 1" = 40' Date: December, 2016

SHEET No. 13 OF 19 SHEETS