
 FED. ROAD DIST. NO.	STATE	PROJ. NO.	FISCAL YEAR	SHEET NO.	TOTAL SHEETS
HAWAII	HAW.	HWY-M-01-08	2010	4	17

			Material List		
Pole	Base Type	Standard Type	Mounting Typ	De .	PPB Assembly
Α	Α	I-10	(1) TP-1W	(Type I)	
В	Α	IA-10	(1) TP-1W	(Type I)	
С	C	II- 50 A	(1) MA-1W (I)	(Type VI)	
		40	(2) Opticom (Horiz.)		
			(3) MA-1W (I)	(Type VI)	
			(4) B-₩2W	(Type IV)	
D	Α	IA-10	(1) TP-1W	(Type I)	
Ε	Α	IA-10	(1) TP-₩ 2W	(Type I)	
			(2) Opticom (Vert.)		
F	С	II- 50 B	(1) MA-1W (I)	(Type VI)	
		40	(2) Opticom (Horiz.)		
			(3) MA-1W (I)	(Type VI)	
			(4) B-1W	(Type IV)	
G	Α	I-10	(1) TP-1W	(Type I)	
					:

				it Schedu	116	
Run	Conduit Size	Type 1 Signal Control 26C#14	Type 2 PPB/ Loops 2C#14	Type 6 Power 3C#6	Type 7 Opticom 3C#20	Interconne <i>Other</i> 12C#19
1	2"	1				
	2"		2			
, · · · · · · · · · · · · · · · · · · ·	2"				1	
	2"			Spare		
2	2"	1				
1 0 0 0 W	2"		2			
	2"				1	
	2"			Spare		
3	2"	1				
	2"		2			
	2"			Spare	,	
4	2"		2			
5	2"		1			
6	2"	1				
	2"			Spare		
7	2"	1				
	2"				1	
	2"			Spare		
8	2"	1				
	2"		2			
	2"				1	
	2"			Spare		
9	2"		1			
10	2"	1				
	2"		3			
	2"				1	
	2"			Spare		
11	2"	1				
	2"		3			
	2"		·		1	
	2"			Spare		
12	2"		1			
13	2-2"	2				
	2"		7			
	2-2"			3		
	2"				1	
	2"			Spare		
14	2"			1		
15	2"					1
				·		·

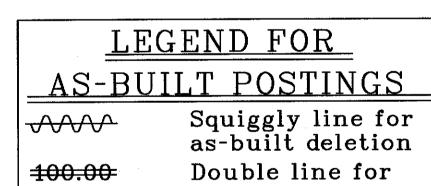


Double line for as-built deletion Text for as-built posting Roadway

STATE OF HAWAII DEPARTMENT OF TRANSPORTATION
HIGHWAYS DIVISION

<u>MATERIAL LIST AND</u> CABLE AND CONDUIT SCHEDULE

<u>HANA HIGHWAY</u> TRAFFIC OPERATIONAL IMPROVEMENTS AT WAKEA AVENUE PROJECT NO. HWY-M-01-08
Vone Date: May, 2010

SHEET No. TS-3 OF 12 SHEETS

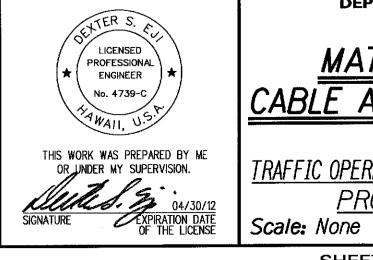

"AS-BUILT"