
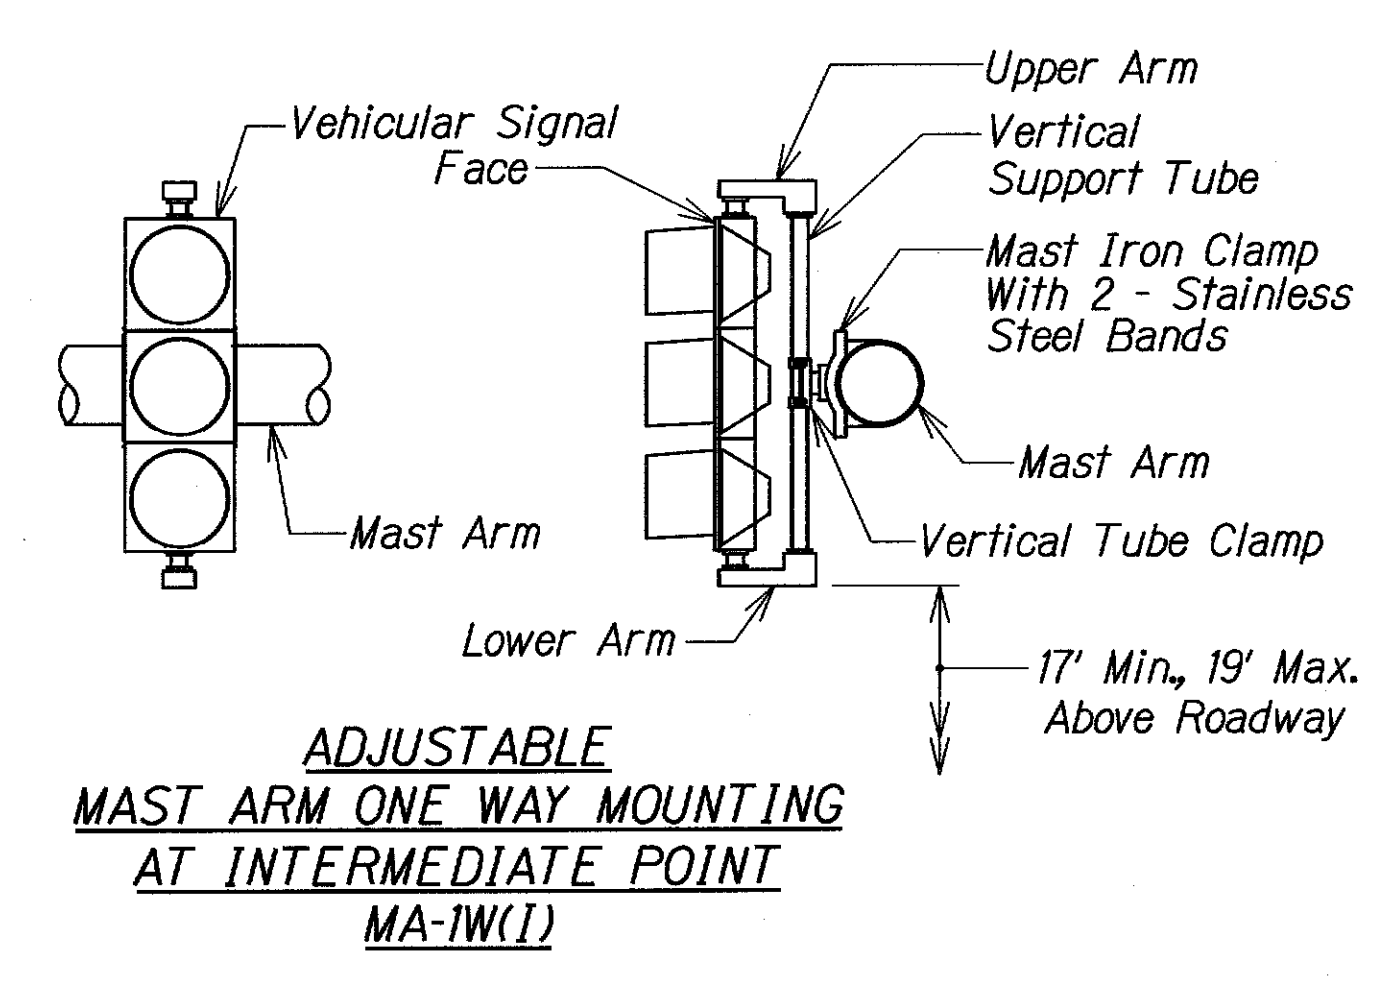
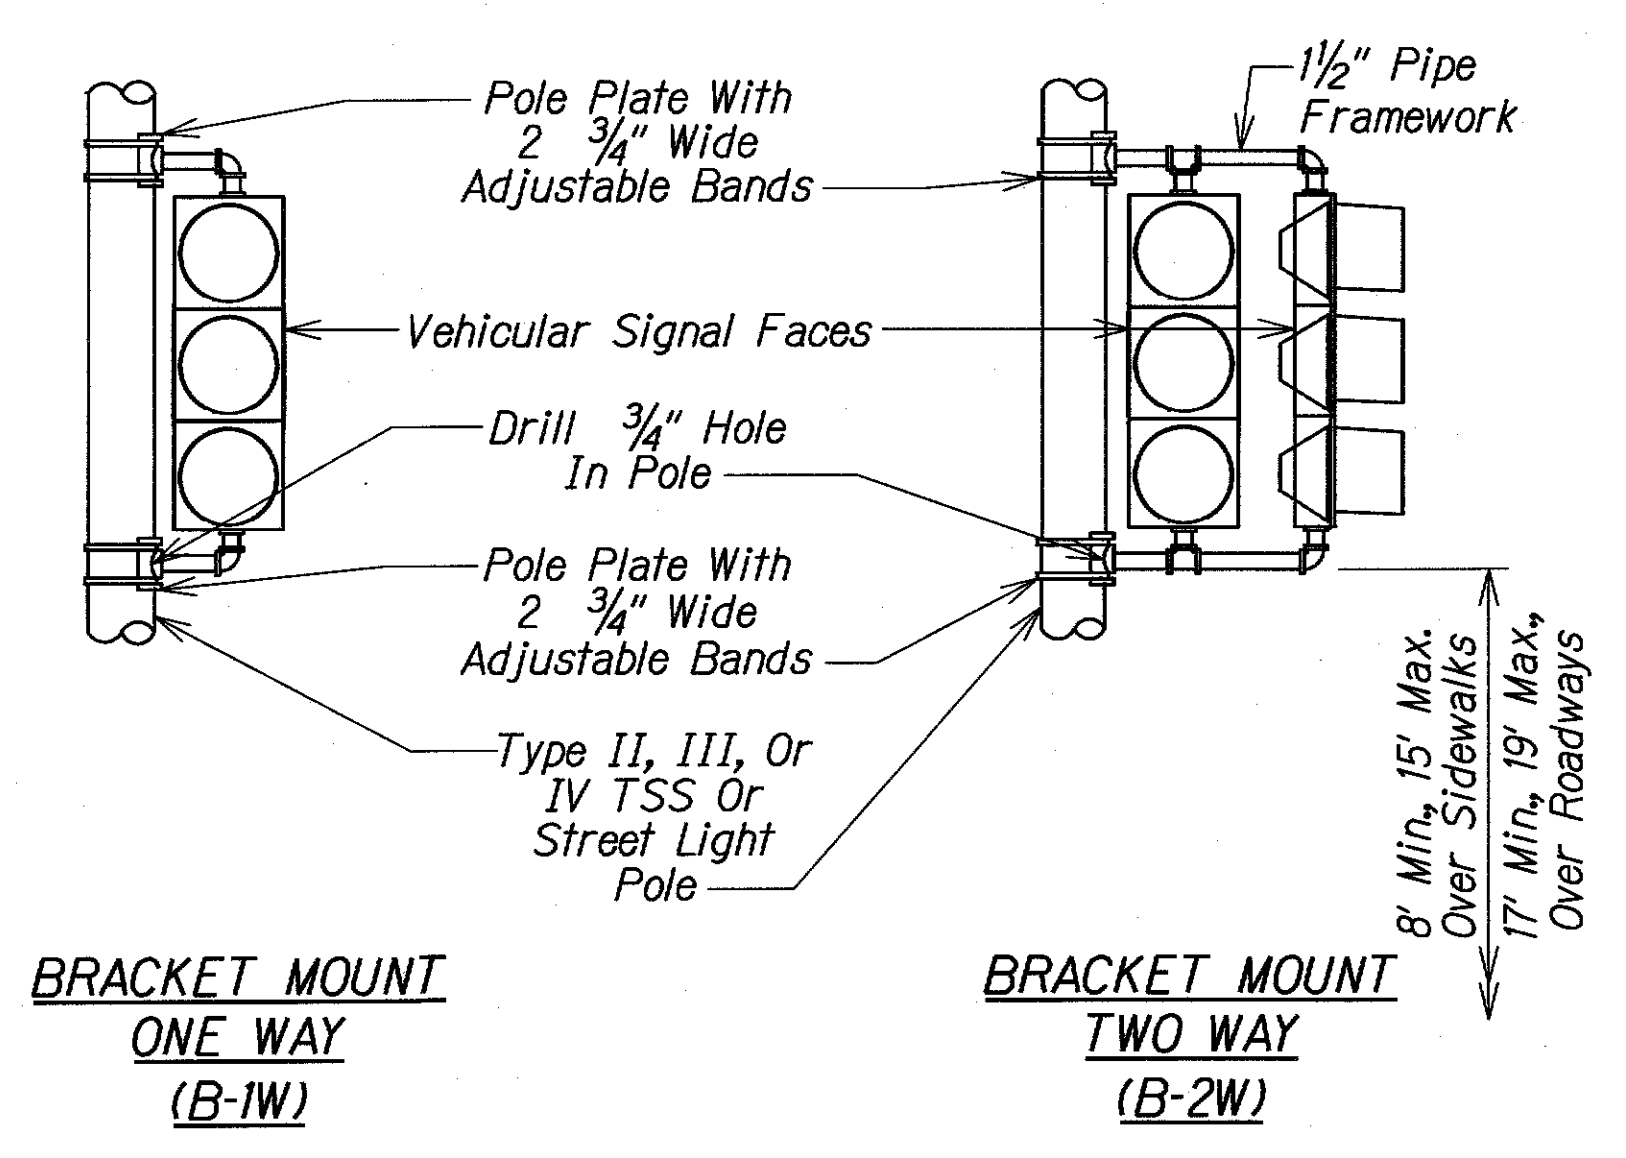
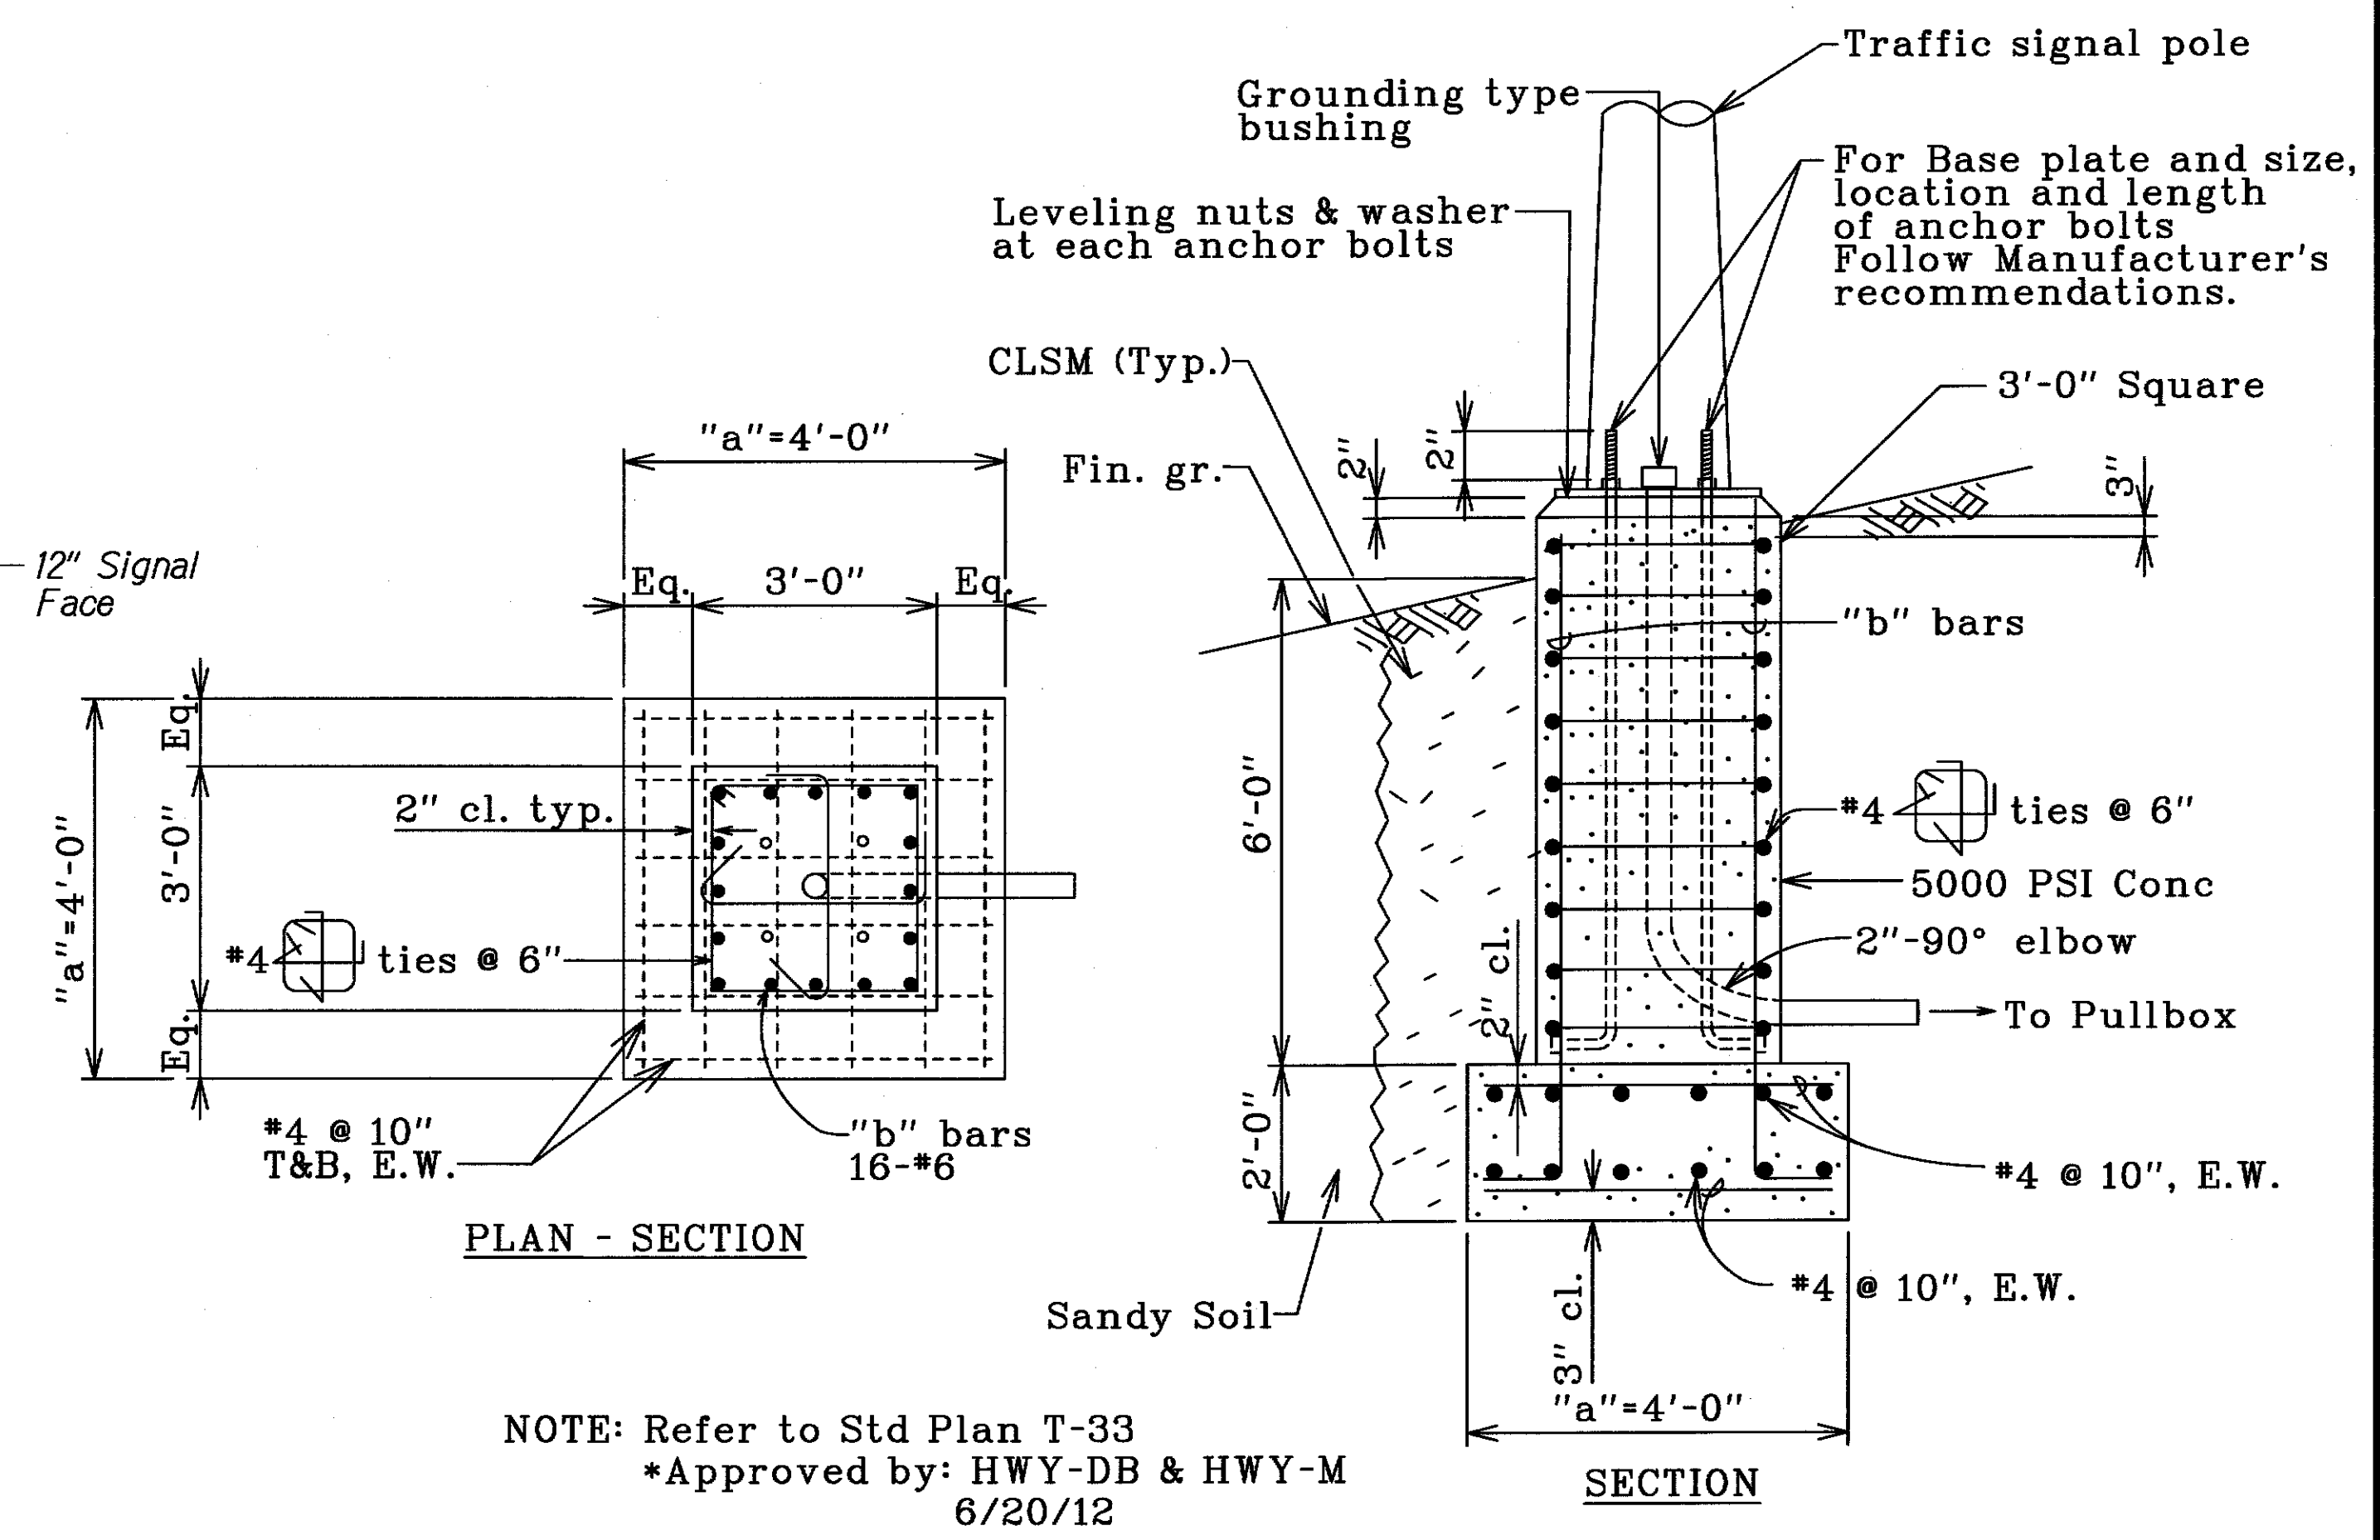
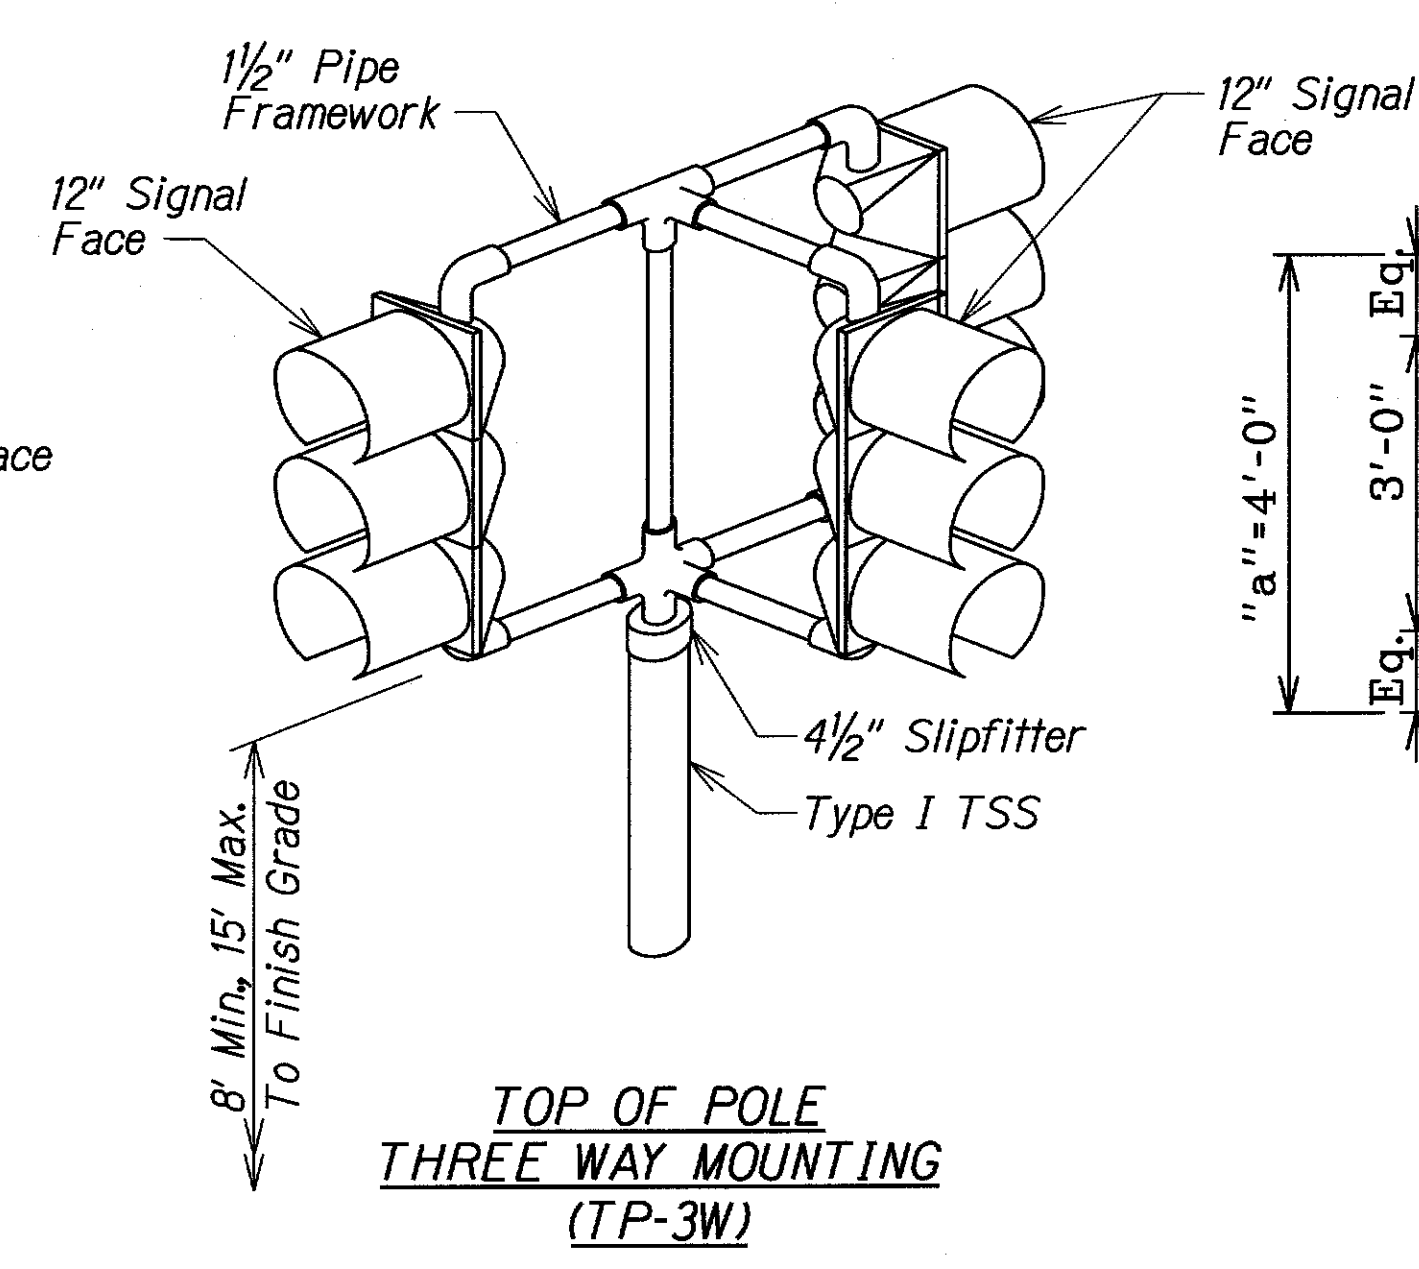


FED. ROAD DIST. NO.	STATE	PROJ. NO.	FISCAL YEAR	SHEET NO.	TOTAL SHEETS
HAWAII	HAW.	HWY-M-01-08	2010	8	17

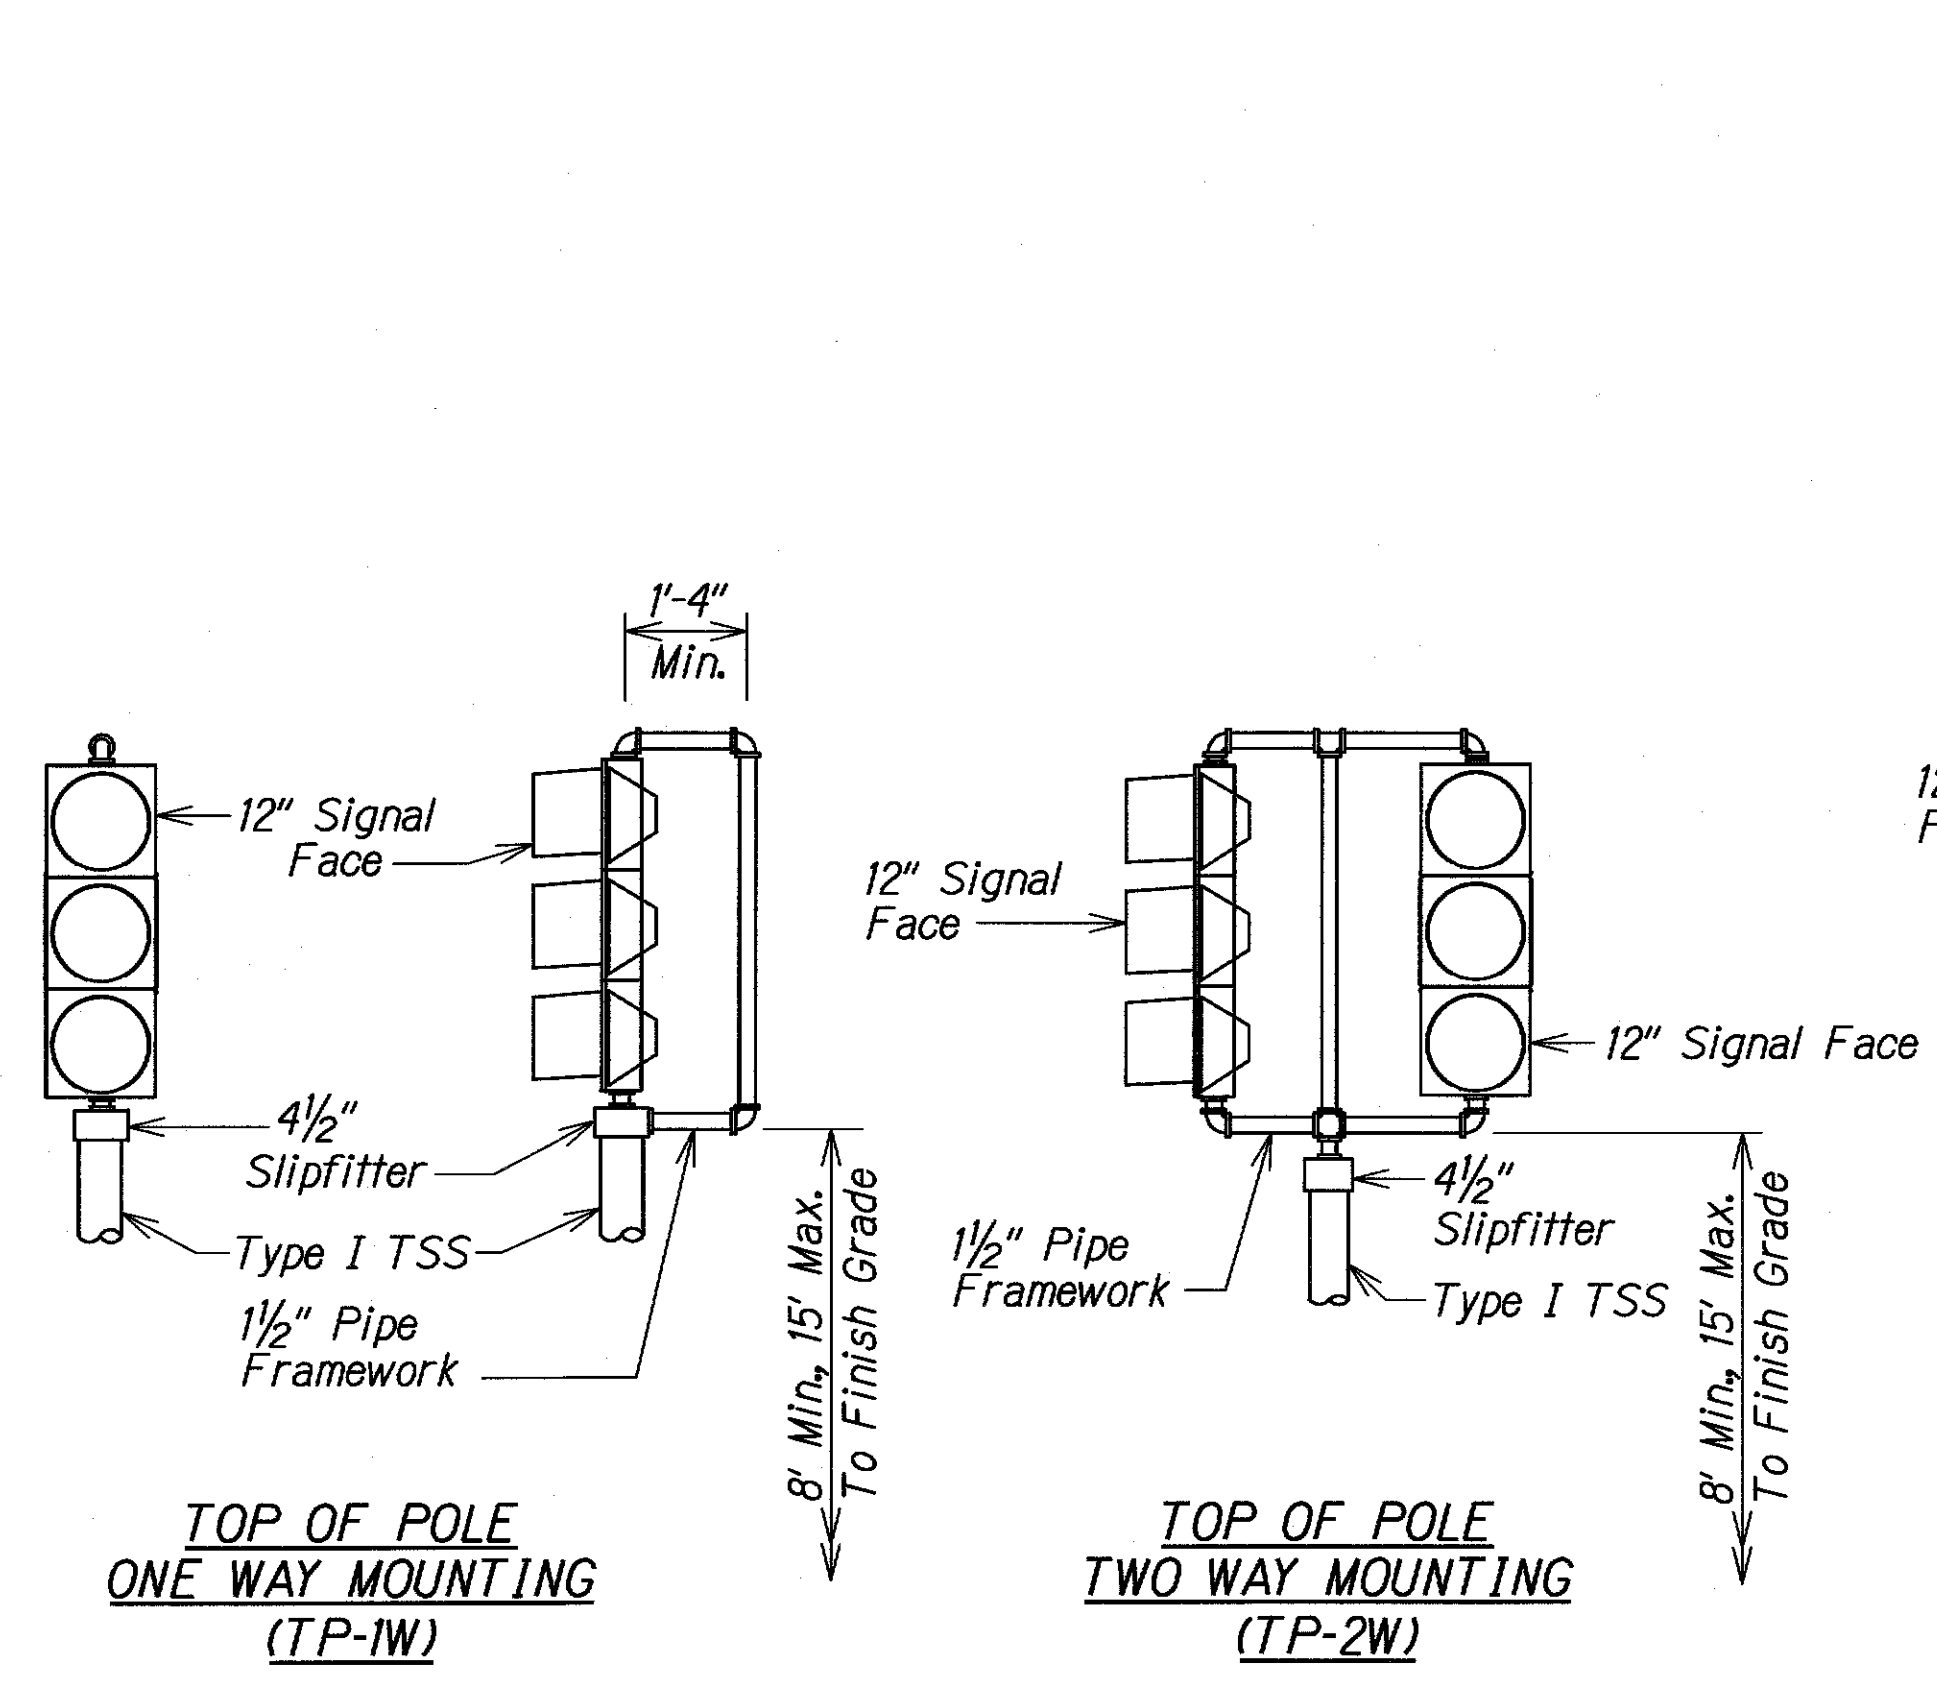

TYPE "C" CONCRETE BASE*
(PRECAST W/ FLOWABLE FILL-CLSM)
NTS

LEGEND FOR AS-BUILT POSTINGS

	Squiggly line for as-built deletion
	Double line for as-built deletion
Roadway	Text for as-built posting

DEXTER S. EJI
LICENSED PROFESSIONAL ENGINEER
No. 4739-C
HAWAII, U.S.A.

THIS WORK WAS PREPARED BY ME OR UNDER MY SUPERVISION.

SIGNATURE: *[Signature]* 04/30/12
EXPIRATION DATE OF THE LICENSE

STATE OF HAWAII
DEPARTMENT OF TRANSPORTATION
HIGHWAYS DIVISION

MOUNTING BRACKET DETAILS

HANA HIGHWAY
TRAFFIC OPERATIONAL IMPROVEMENTS AT WAKEA AVENUE
PROJECT NO. HWY-M-01-08
Scale: None Date: May, 2010

SHEET No. TS-7 OF 12 SHEETS