


| FED. ROAD DIST. NO. | STATE | PROJ. NO. | FISCAL YEAR | SHEET NO. | TOTAL SHEETS |
|---------------------|-------|-------------|-------------|-----------|--------------|
| HAWAII | HAW. | HWY-M-01-08 | 2010 | 11 | 17 |

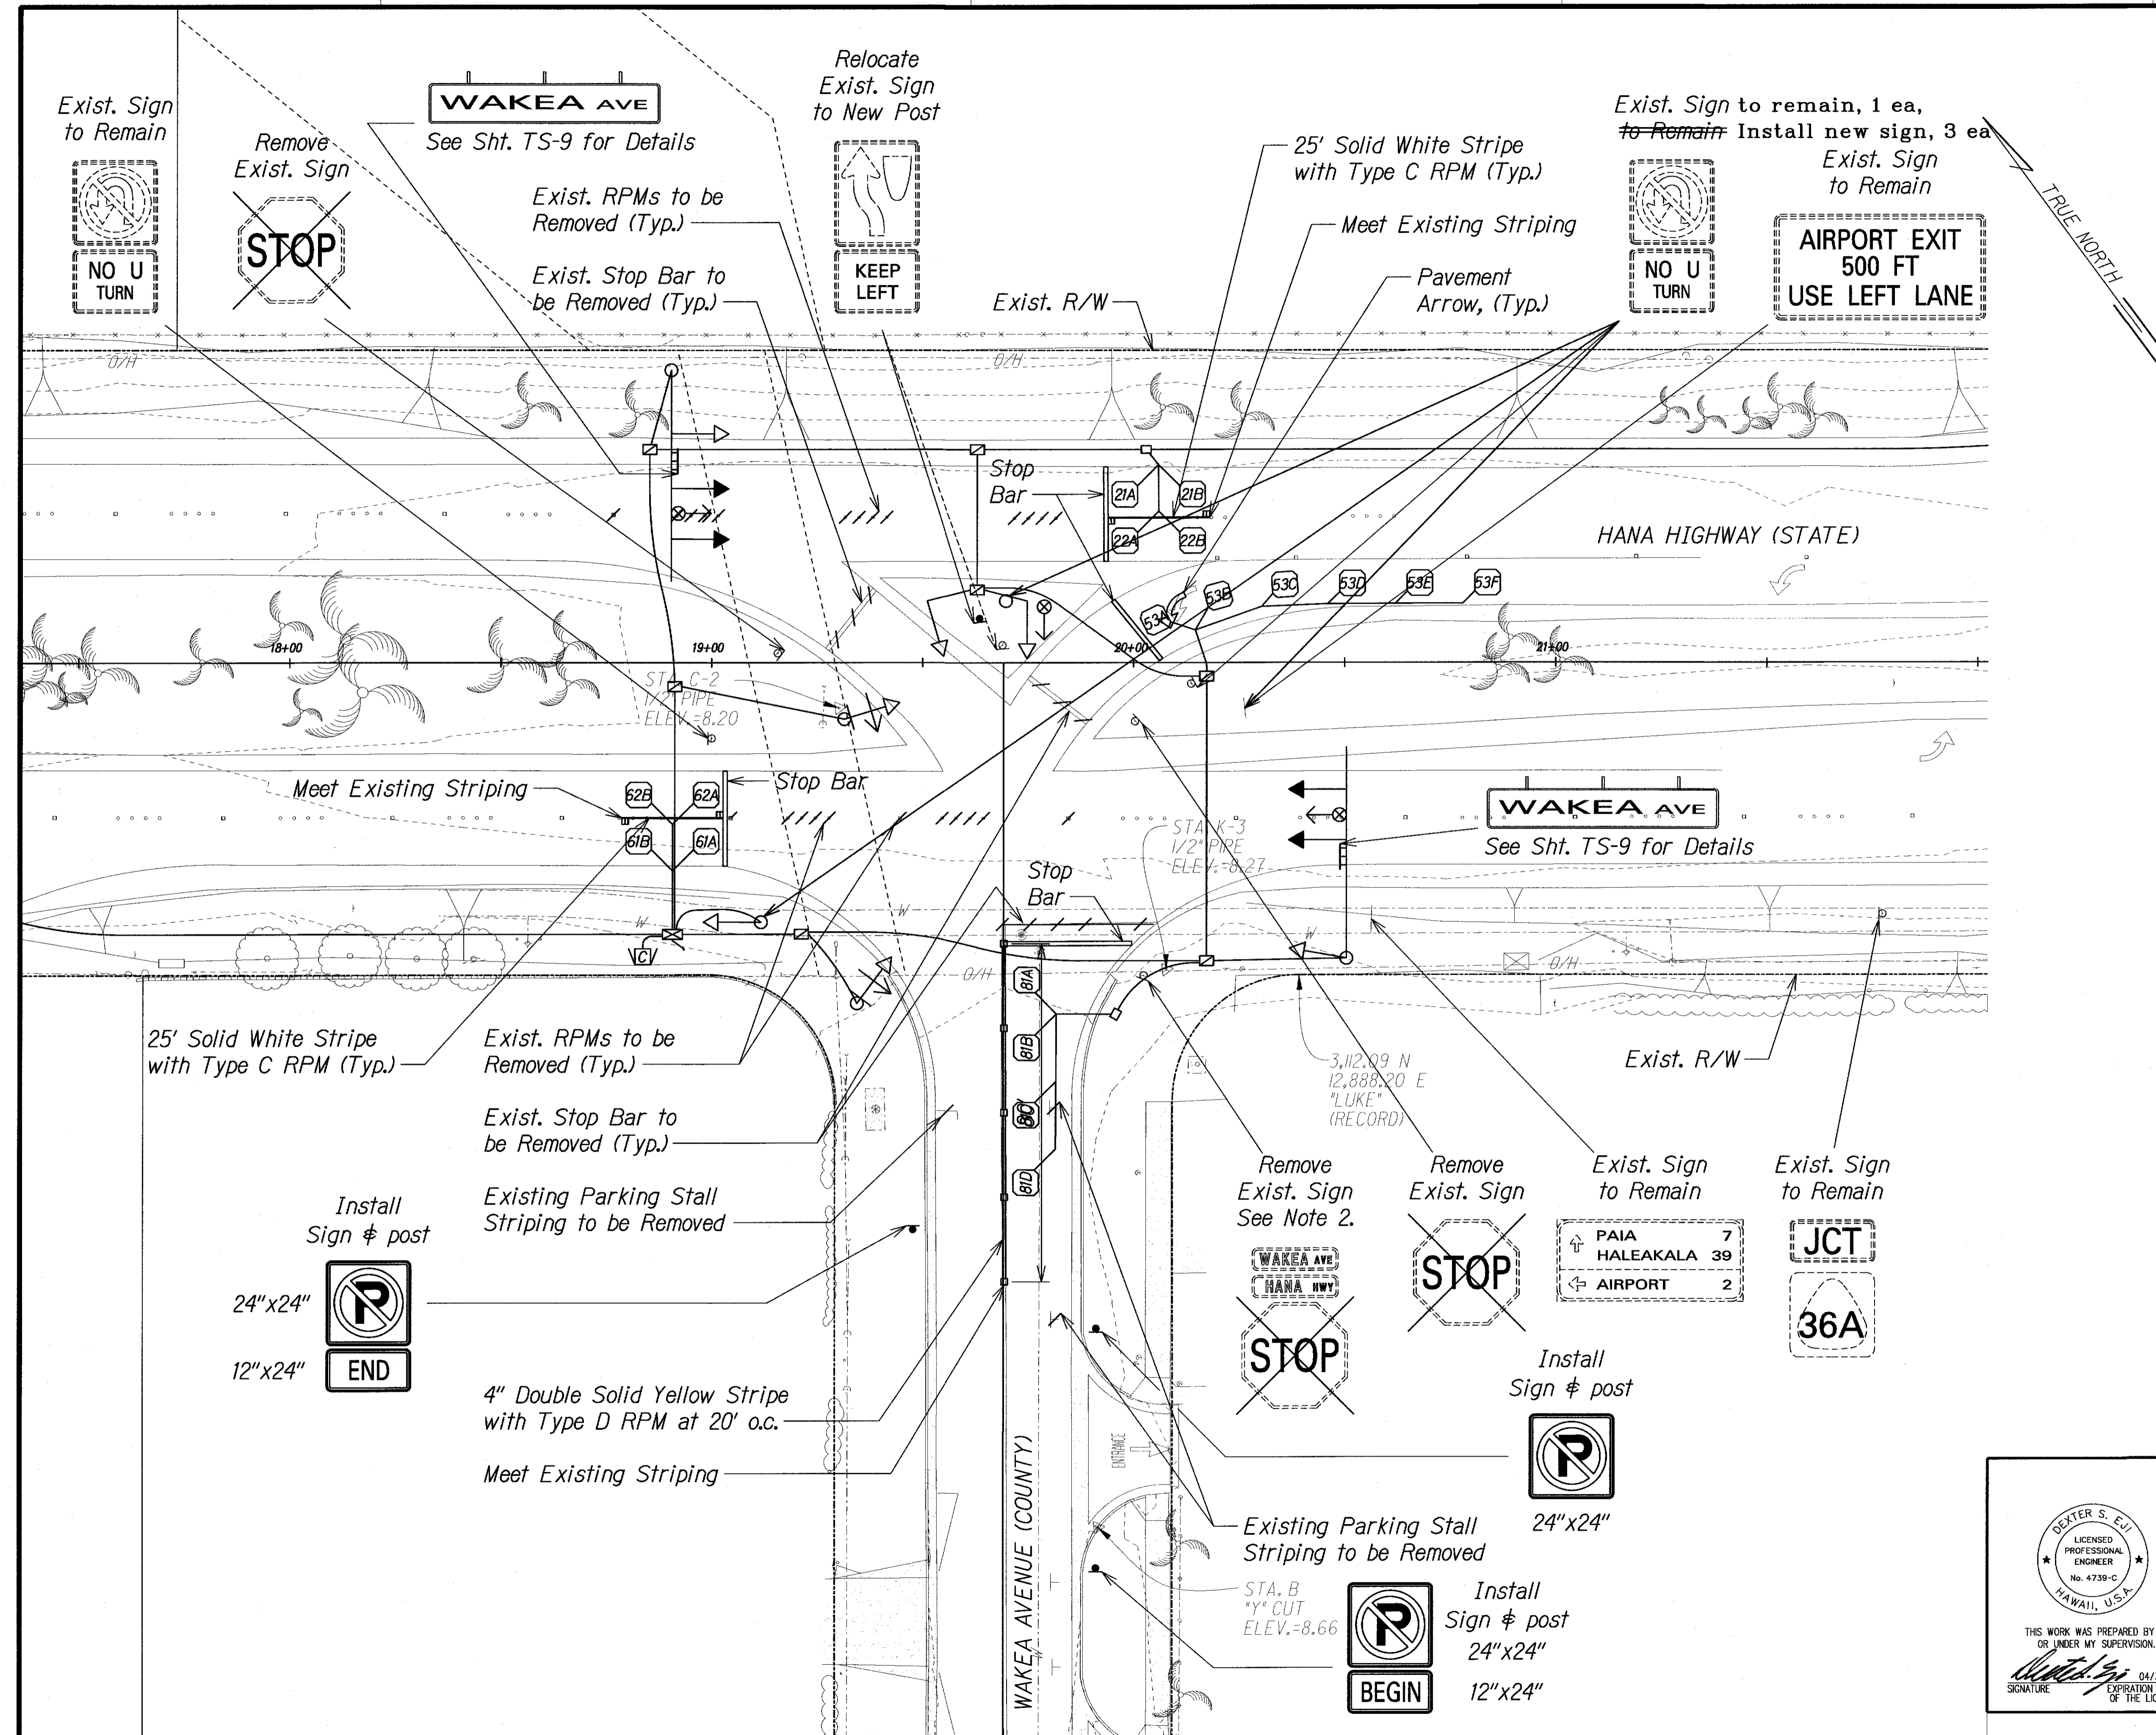

LEGEND FOR AS-BUILT POSTINGS

| | |
|---------|-------------------------------------|
| | Squiggly line for as-built deletion |
| | Double line for as-built deletion |
| Roadway | Text for as-built posting |

LEGEND:
 Existing Pavement Marking to be Removed

- NOTES:**
- Eradicate all pavement markings that conflict with the proposed pavement markings.
 - Remove Stop sign. Street Name signs and post to remain in place.

| | |
|-------------------|------|
| SURVEY PLOTTED BY | DATE |
| DRAWN BY | |
| DESIGNED BY | |
| QUANTITIES BY | |
| CHECKED BY | |
| ORIGINAL PLAN | |
| NOTE BOOK | |
| CHECKED BY | |
| | |

THIS WORK WAS PREPARED BY ME OR UNDER MY SUPERVISION.
Dexter S. Eji
 SIGNATURE 04/30/12
 EXPIRATION DATE OF THE LICENSE

STATE OF HAWAII
 DEPARTMENT OF TRANSPORTATION
 HIGHWAYS DIVISION

PAVEMENT AND SIGNING PLAN

HANA HIGHWAY
 TRAFFIC OPERATIONAL IMPROVEMENTS AT WAKEA AVENUE
 PROJECT NO. HWY-M-01-08
 Scale: 1"=20' Date: May, 2010

SHEET No. TS-10 OF 12 SHEETS

"AS-BUILT"