


FED. ROAD DIST. NO.	STATE	PROJ. NO.	FISCAL YEAR	SHEET NO.	TOTAL SHEETS
HAWAII	HAW.	HWY-M-01-08	2010	3	17

R Y G	R Y G	R Y G	R Y G
12" Signal Faces (R-Y-↑)	12" Signal Faces (R-Y-G)	12" Signal Faces (R-Y-←)	12" Signal Faces (←-←-←)
C-1 C-3 F-1 F-3	A-1 C-4 D-1 E-1 F-4	B-1 G-1 C-5	E-3

* Programmed Visibility Signals

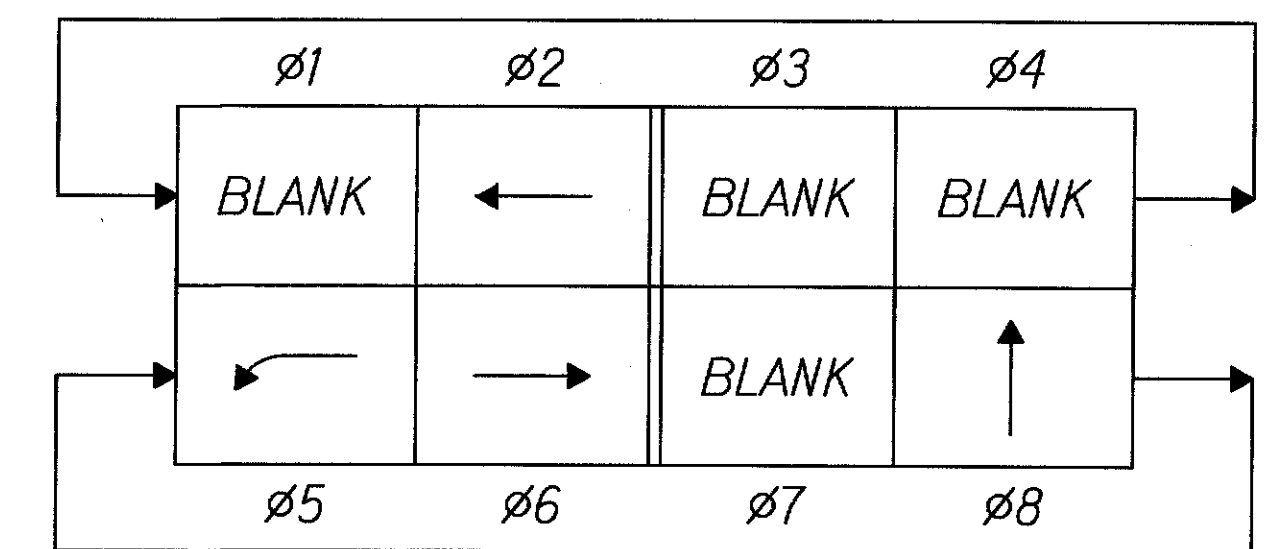

PHASE DIAGRAM

Model 170E Controller
Model 332A Cabinet

→ Vehicle Movement
← Pedestrian Movement



R173L
24"X30"
(Typical))

LEFT TURN SIGN 1
TS-2 | TS-2

LEGEND FOR AS-BUILT POSTINGS	
	Squiggly line for as-built deletion
	Double line for as-built deletion
Roadway	Text for as-built posting

THIS WORK WAS PREPARED BY ME OR UNDER MY SUPERVISION.
Signature: *Dexter S. Eui* Date: 04/30/12
EXPIRATION DATE OF THE LICENSE

STATE OF HAWAII
DEPARTMENT OF TRANSPORTATION
HIGHWAYS DIVISION

TRAFFIC SIGNAL PLAN

HANA HIGHWAY
TRAFFIC OPERATIONAL IMPROVEMENTS AT WAKEA AVENUE
PROJECT NO. HWY-M-01-08
Scale: 1"=20' Date: May, 2010

SHEET No. TS-2 OF 12 SHEETS

"AS-BUILT"