





FED. ROAD DIST. NO.	STATE	FED. AID PROJ. NO.	FISCAL YEAR	SHEET NO.	TOTAL SHEETS
HAW.	HAW.	5-D	1931	7	14

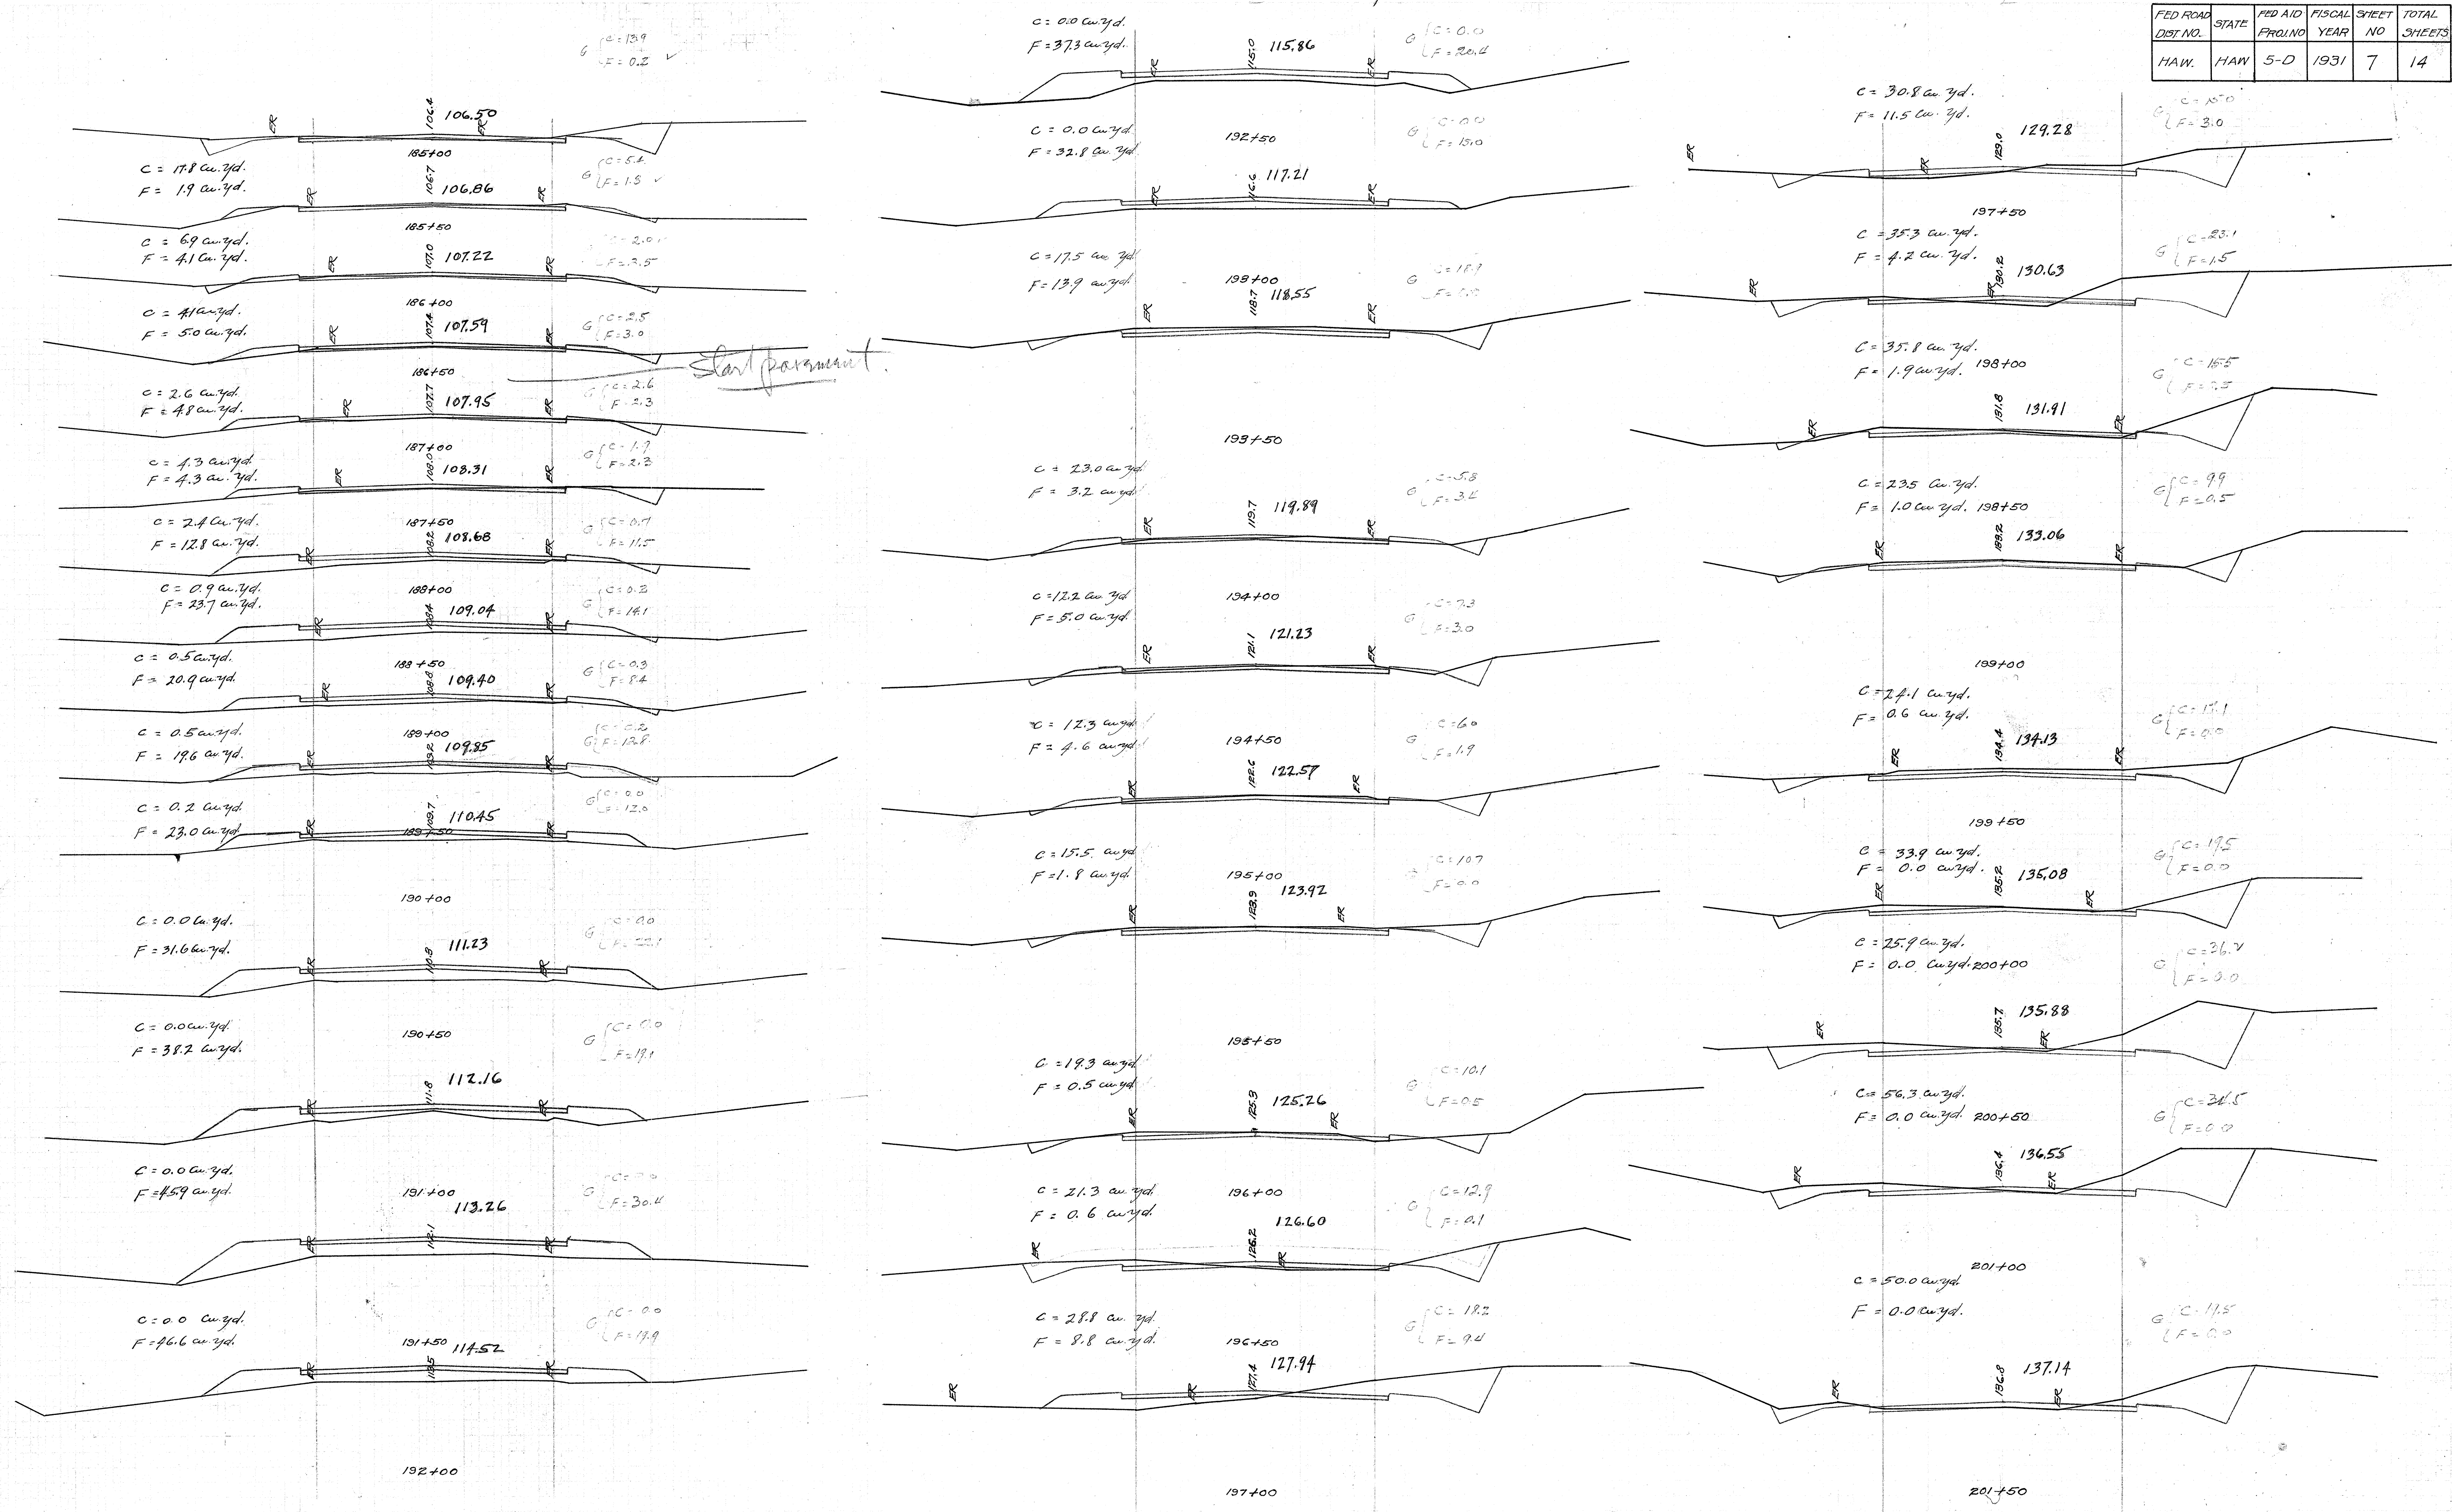

4188.7

Plan File No.	Project No.	Folder No.	Plan No.
6	16	2	



FED ROAD DIST NO	STATE	FED AID PROJ NO	FISCAL YEAR	SHEET NO	TOTAL SHEETS
HAW	HAW	5-D	1931	8	14

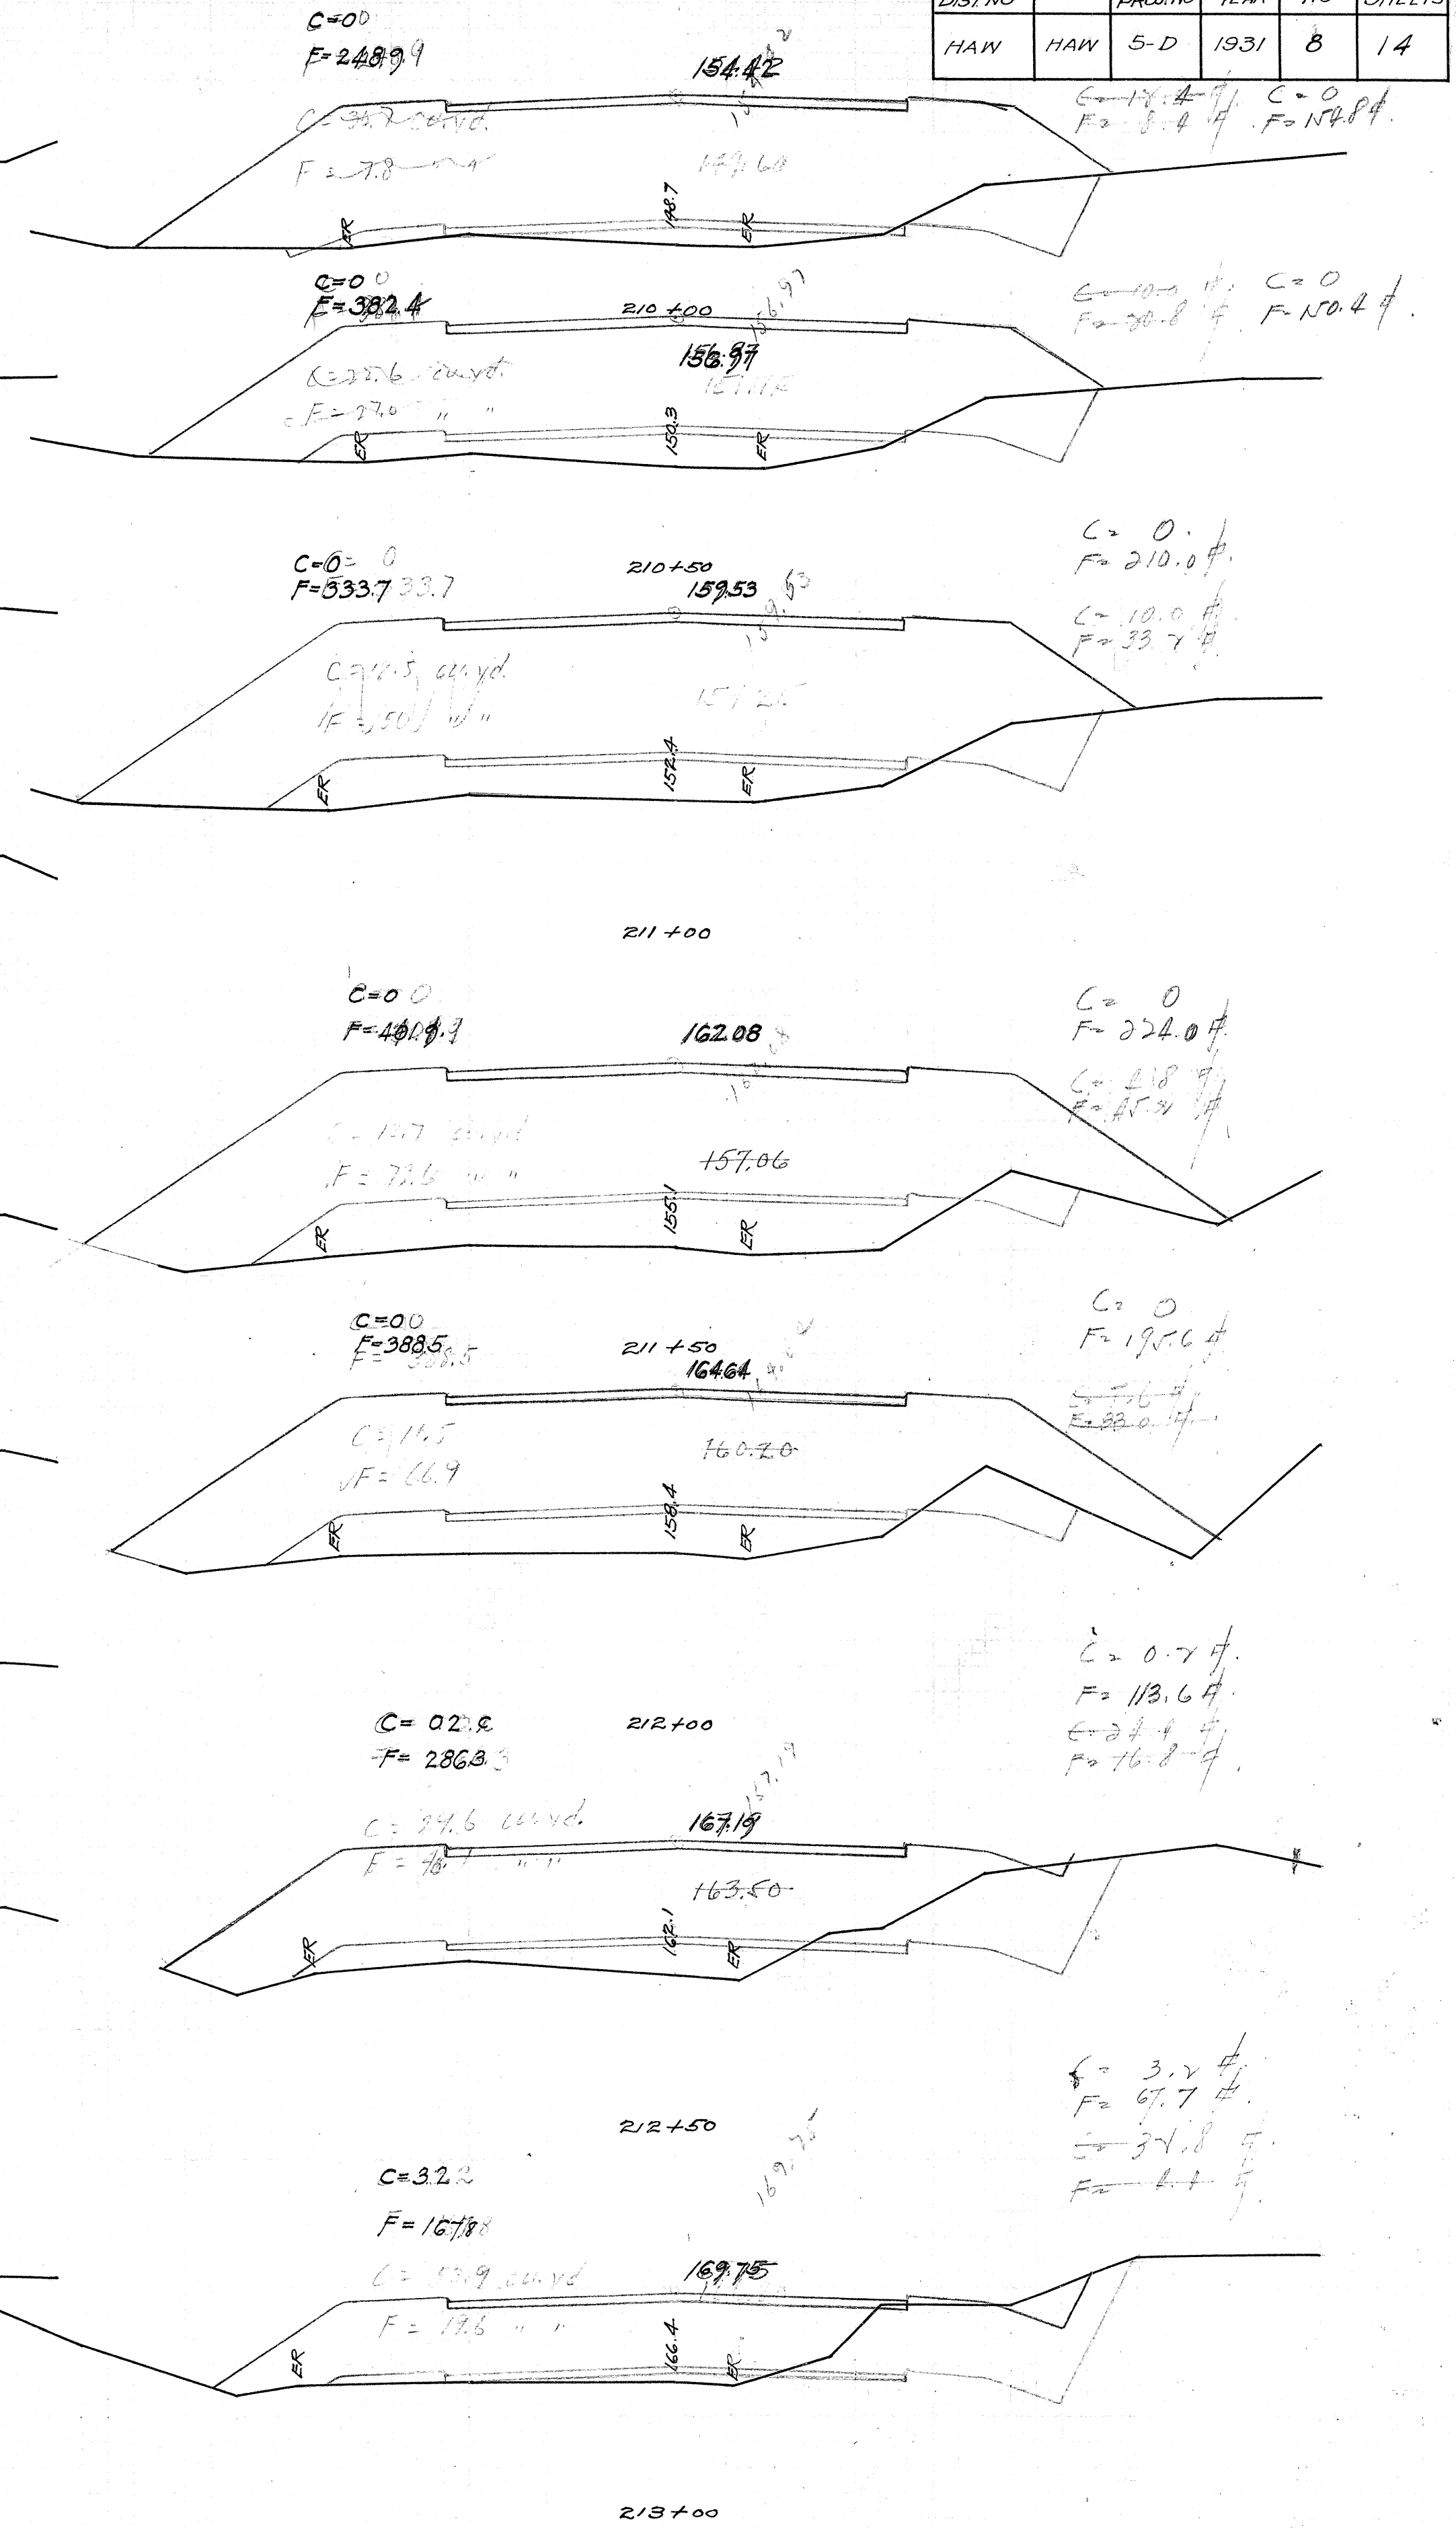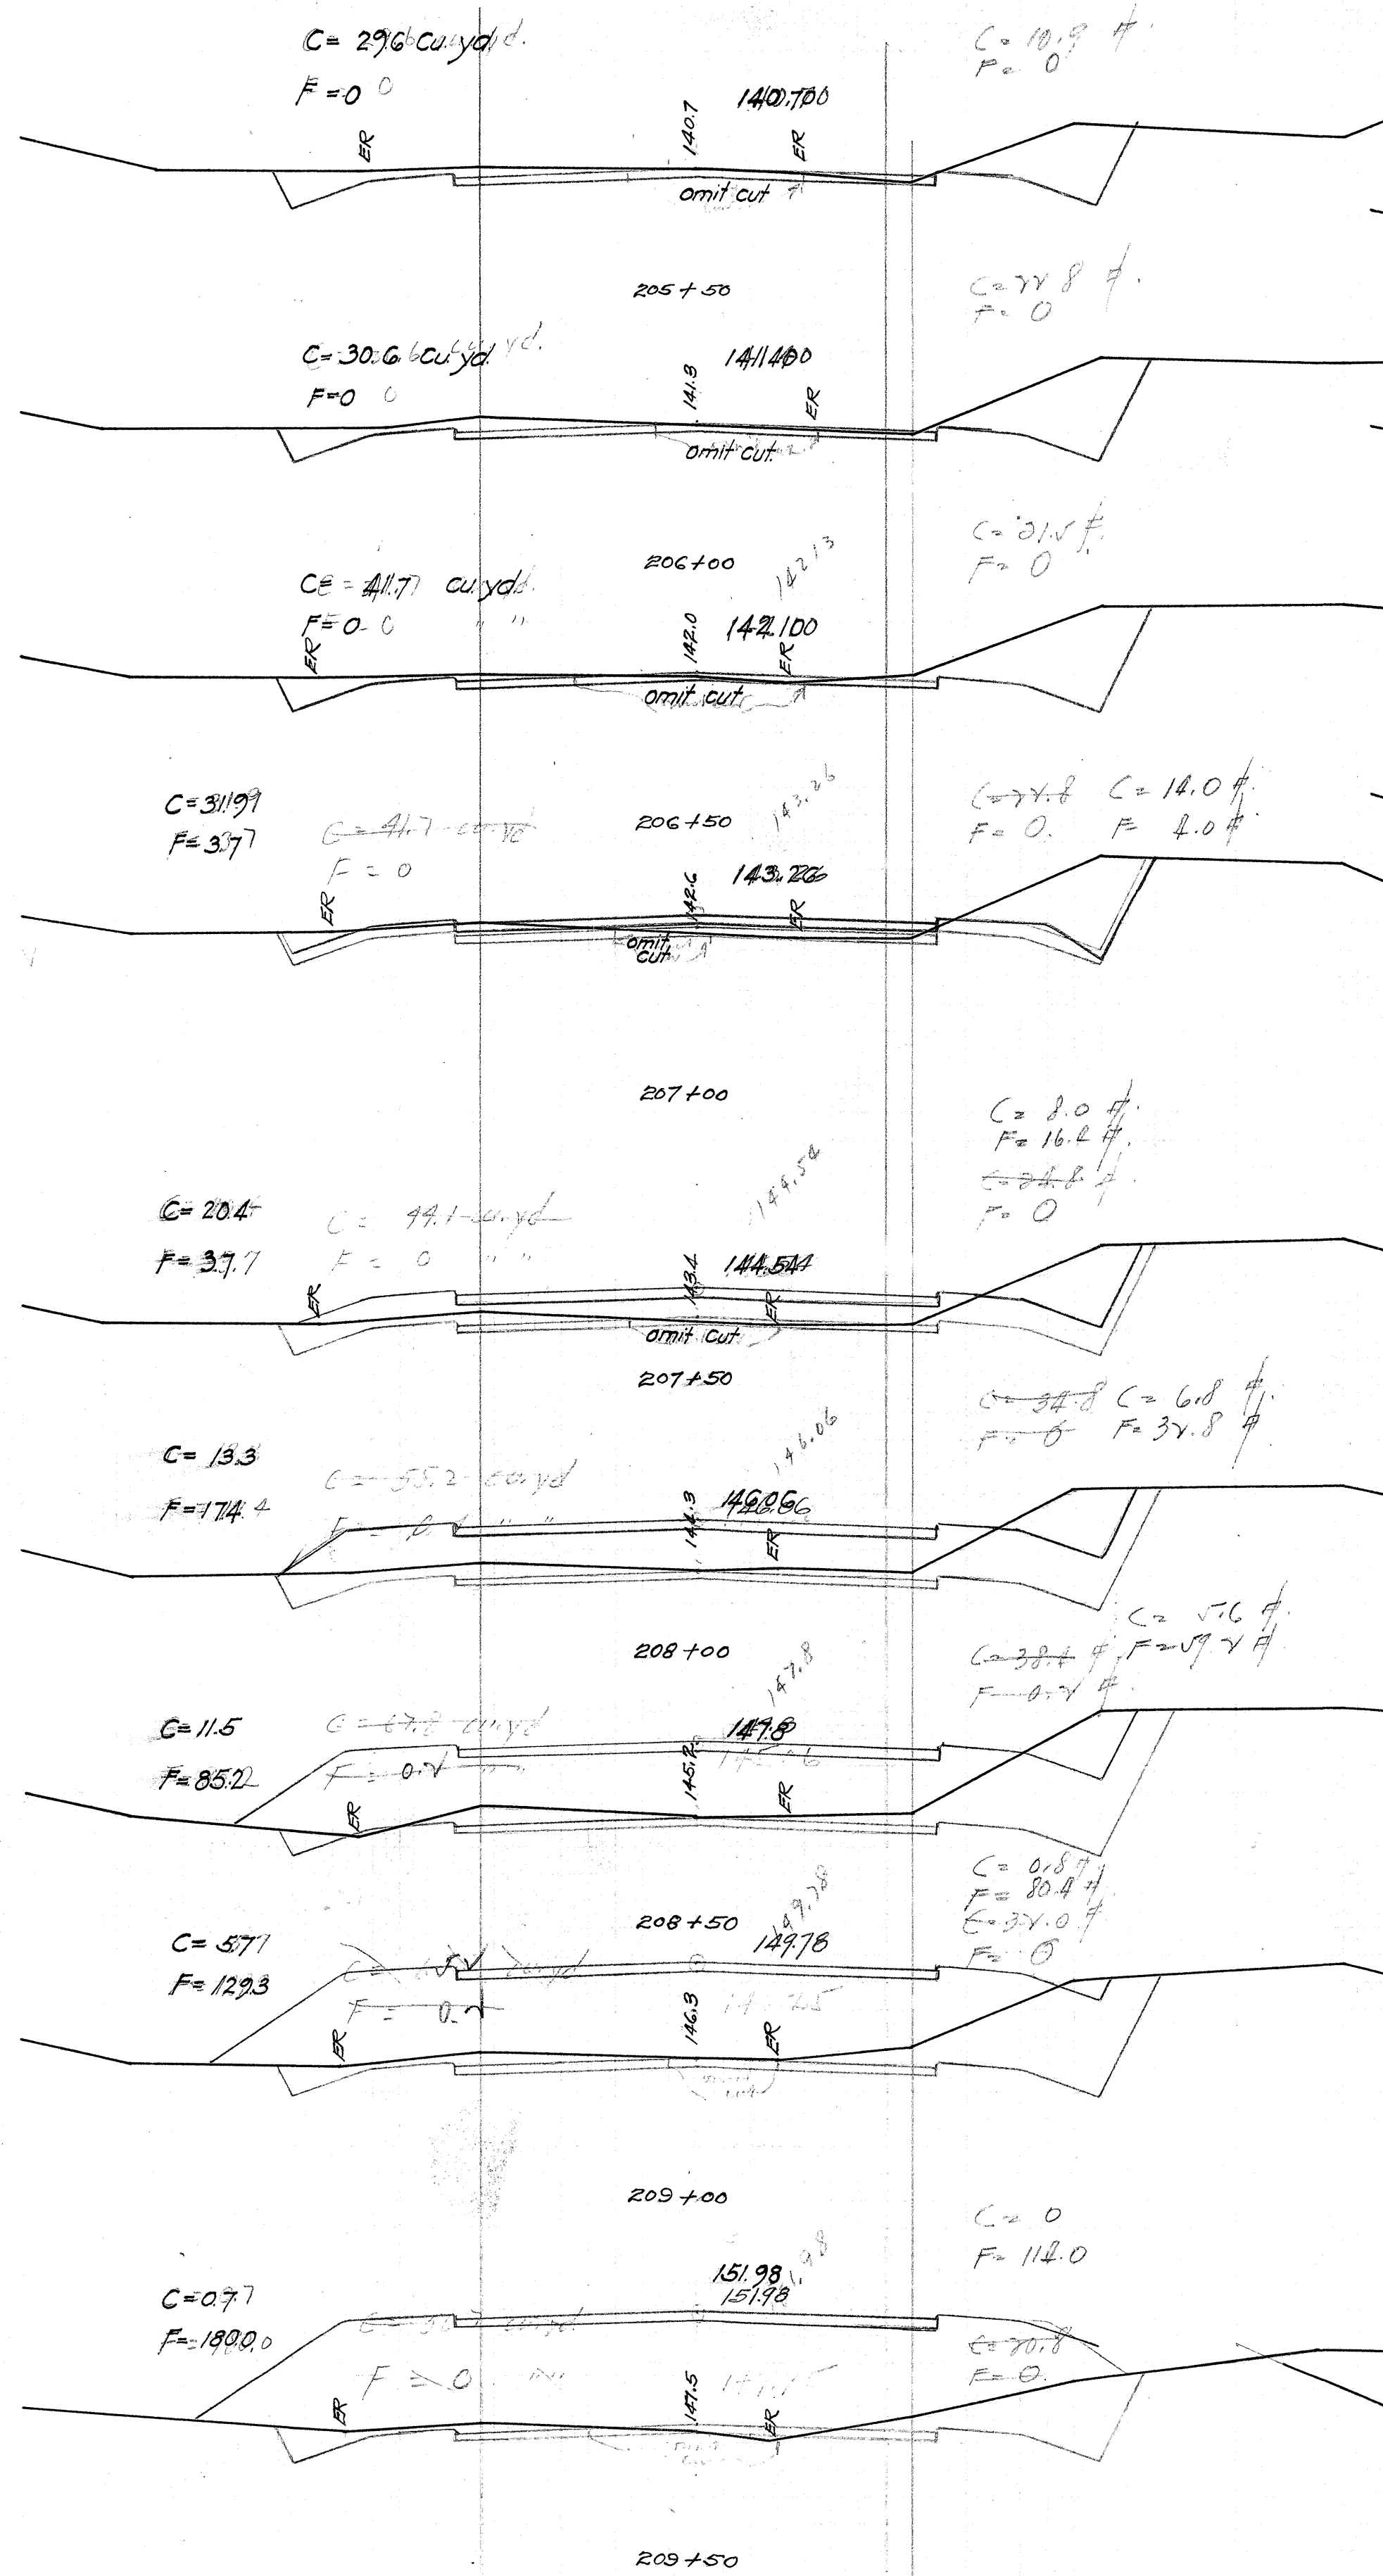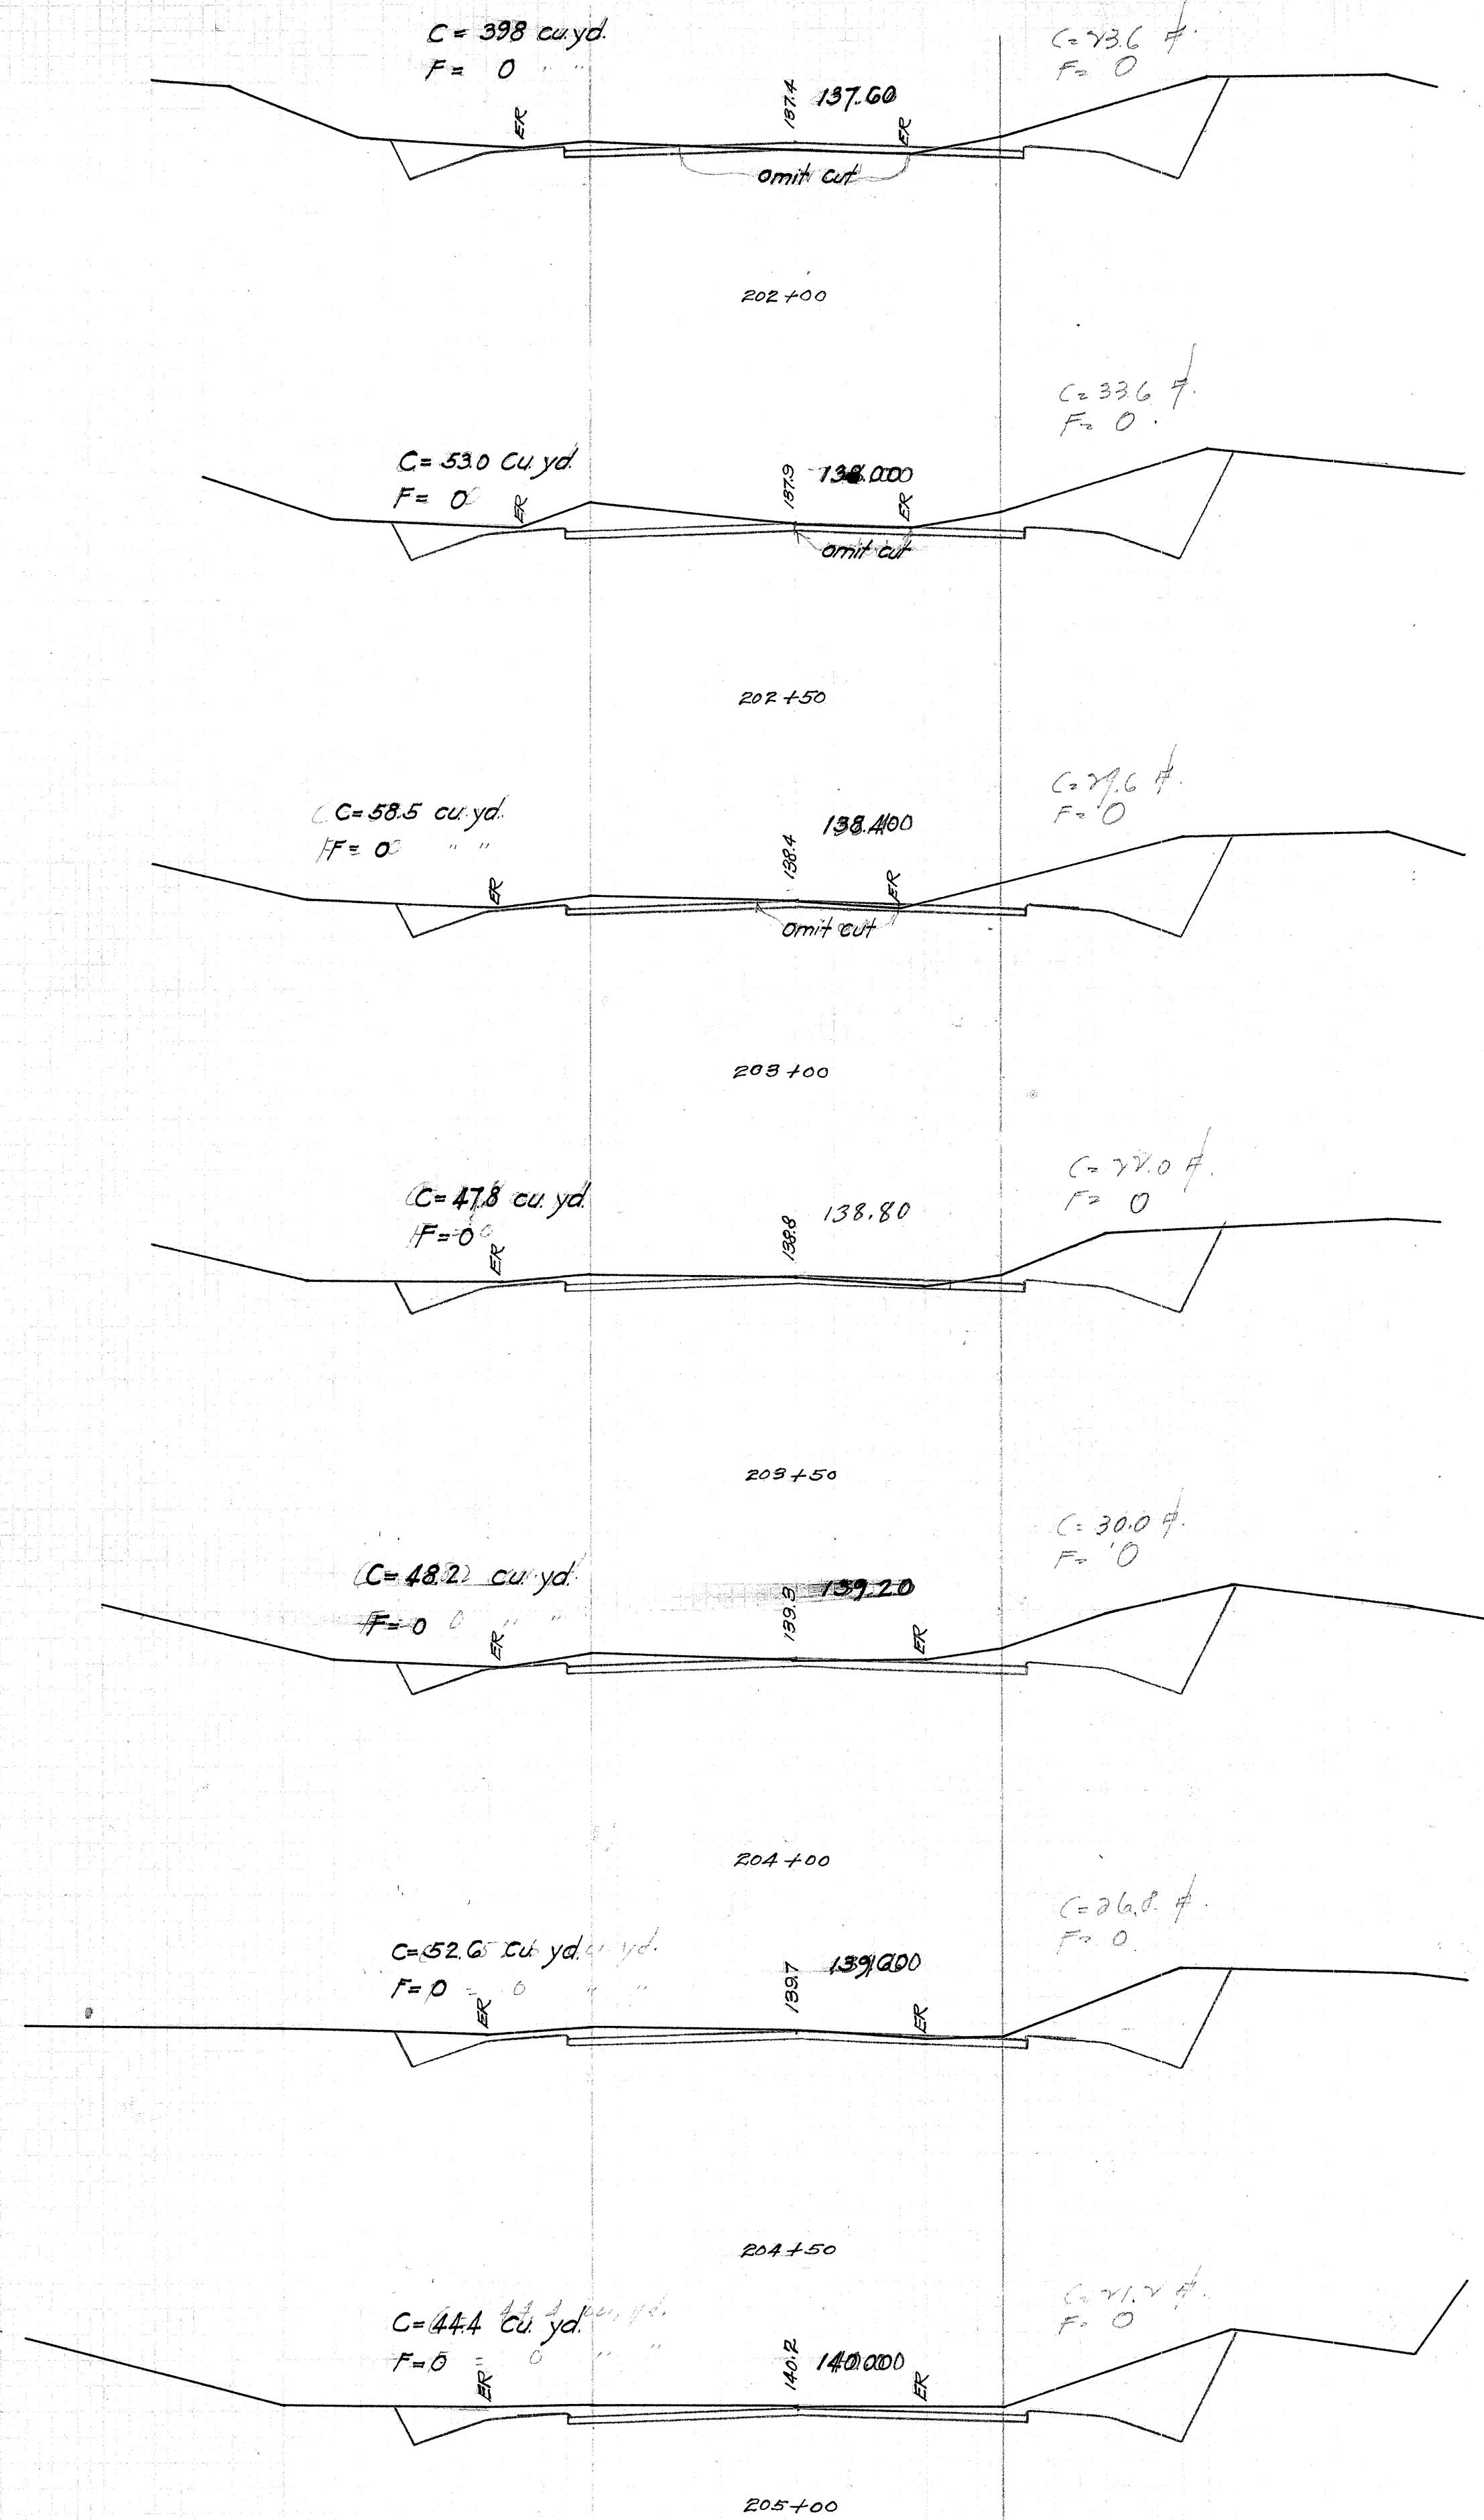

4188.8

Plan File No.	Project No.	Folder No.	Plan No.
6	15	2	




FED ROAD DIST NO.	STATE	FED AID PROJ NO.	FISCAL YEAR	SHEET NO.	TOTAL SHEETS
HAW	HAW	5-D	1991	9	14

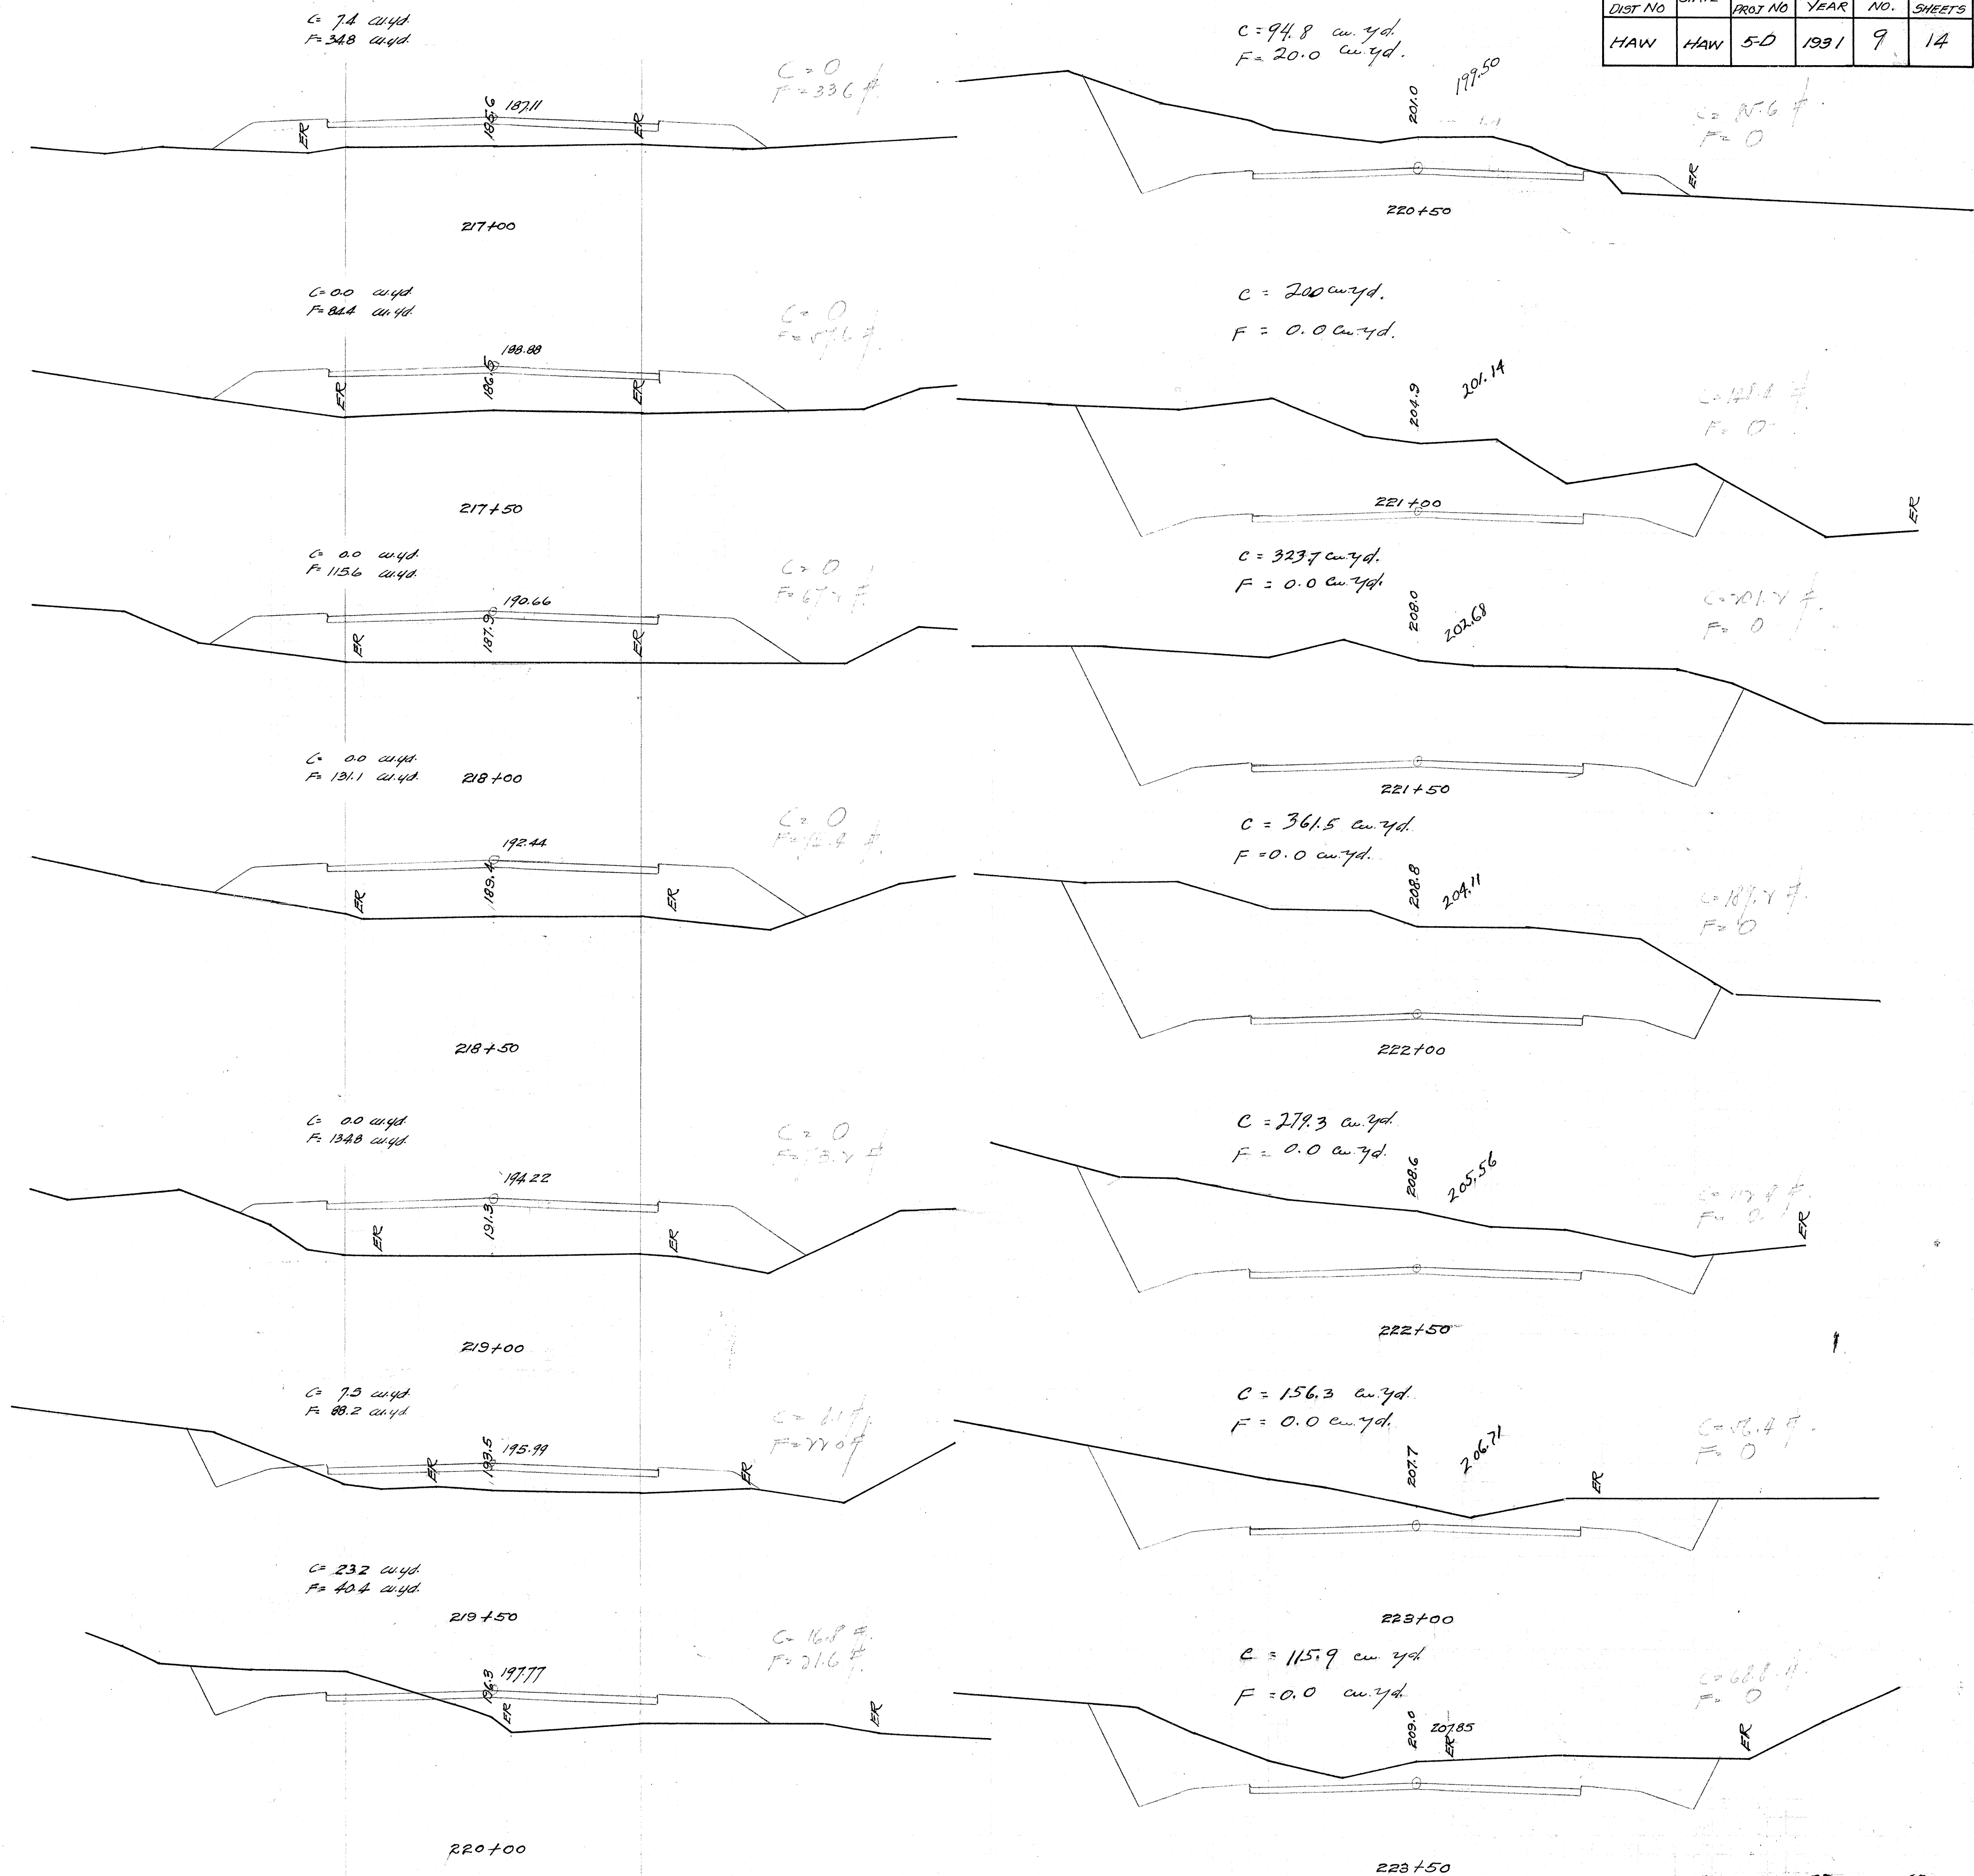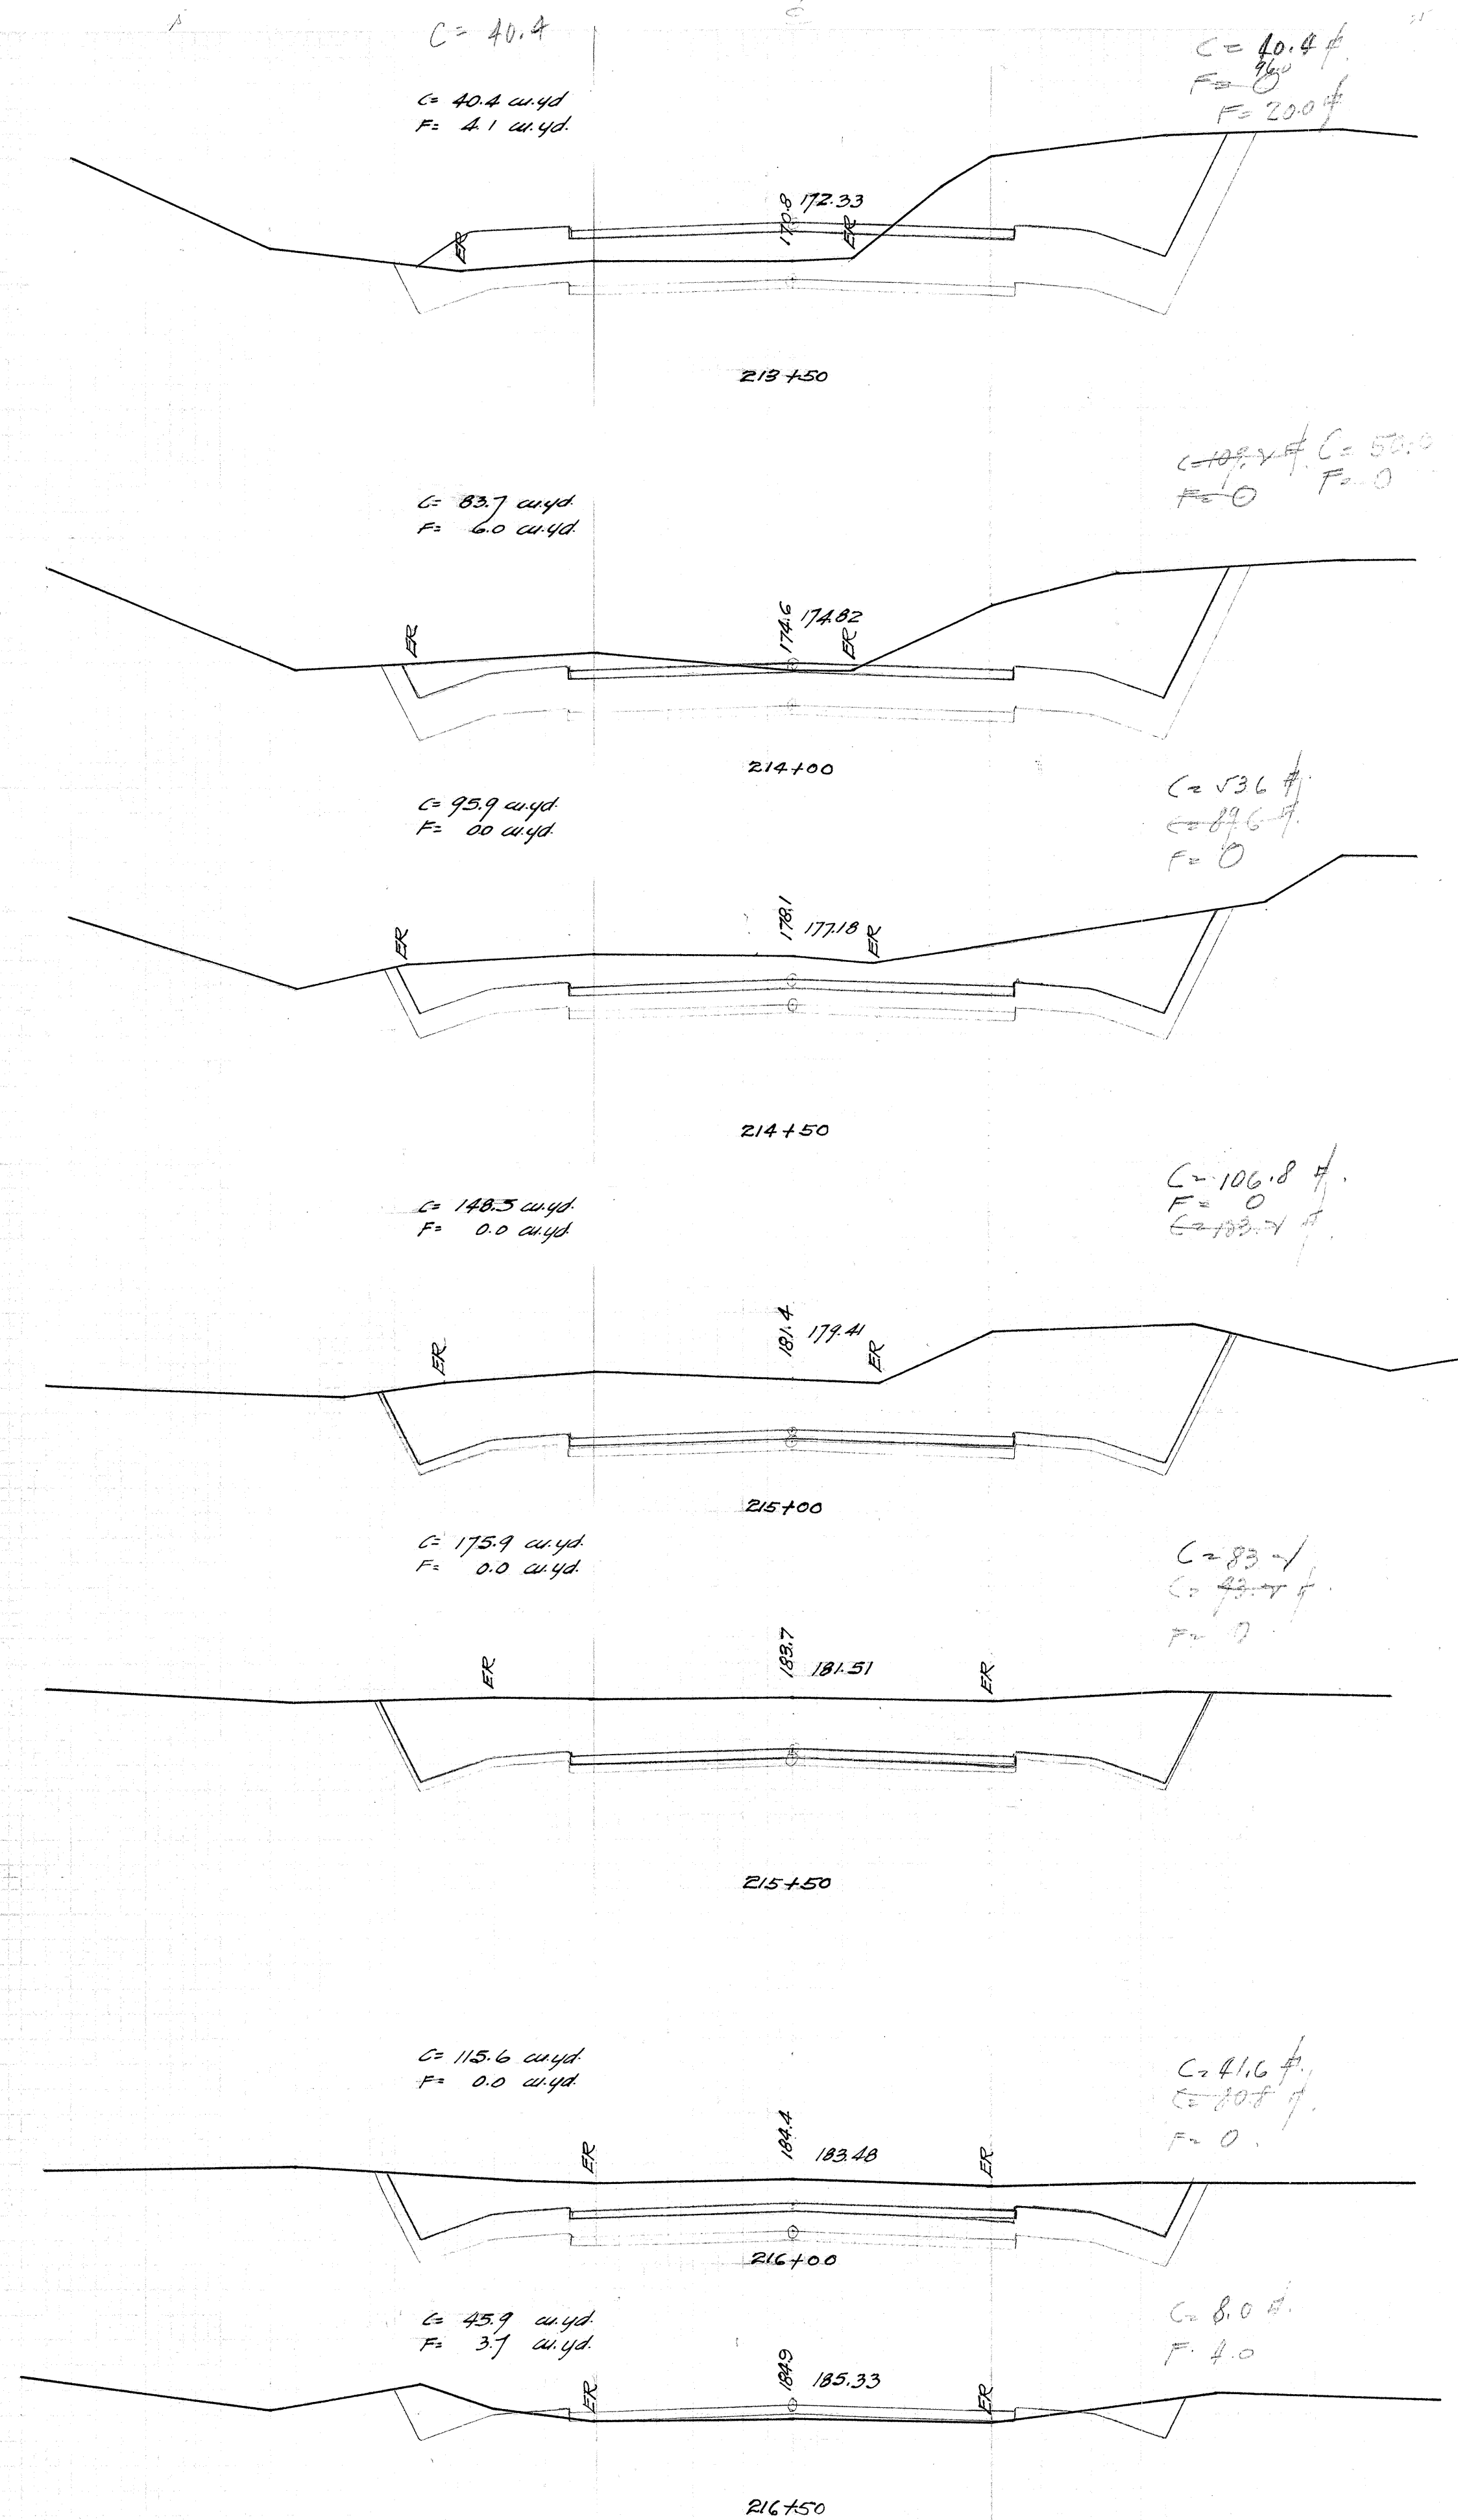

4188.9

Plan No.	Page No.	Folder No.	Plan No.
6	13	2	






















FED. ROAD DIST. NO.	STATE	FED. AID PROJ. NO.	FISCAL YEAR	SHEET NO.	TOTAL SHEETS
HAW	HAW	5-D	1931	10	14

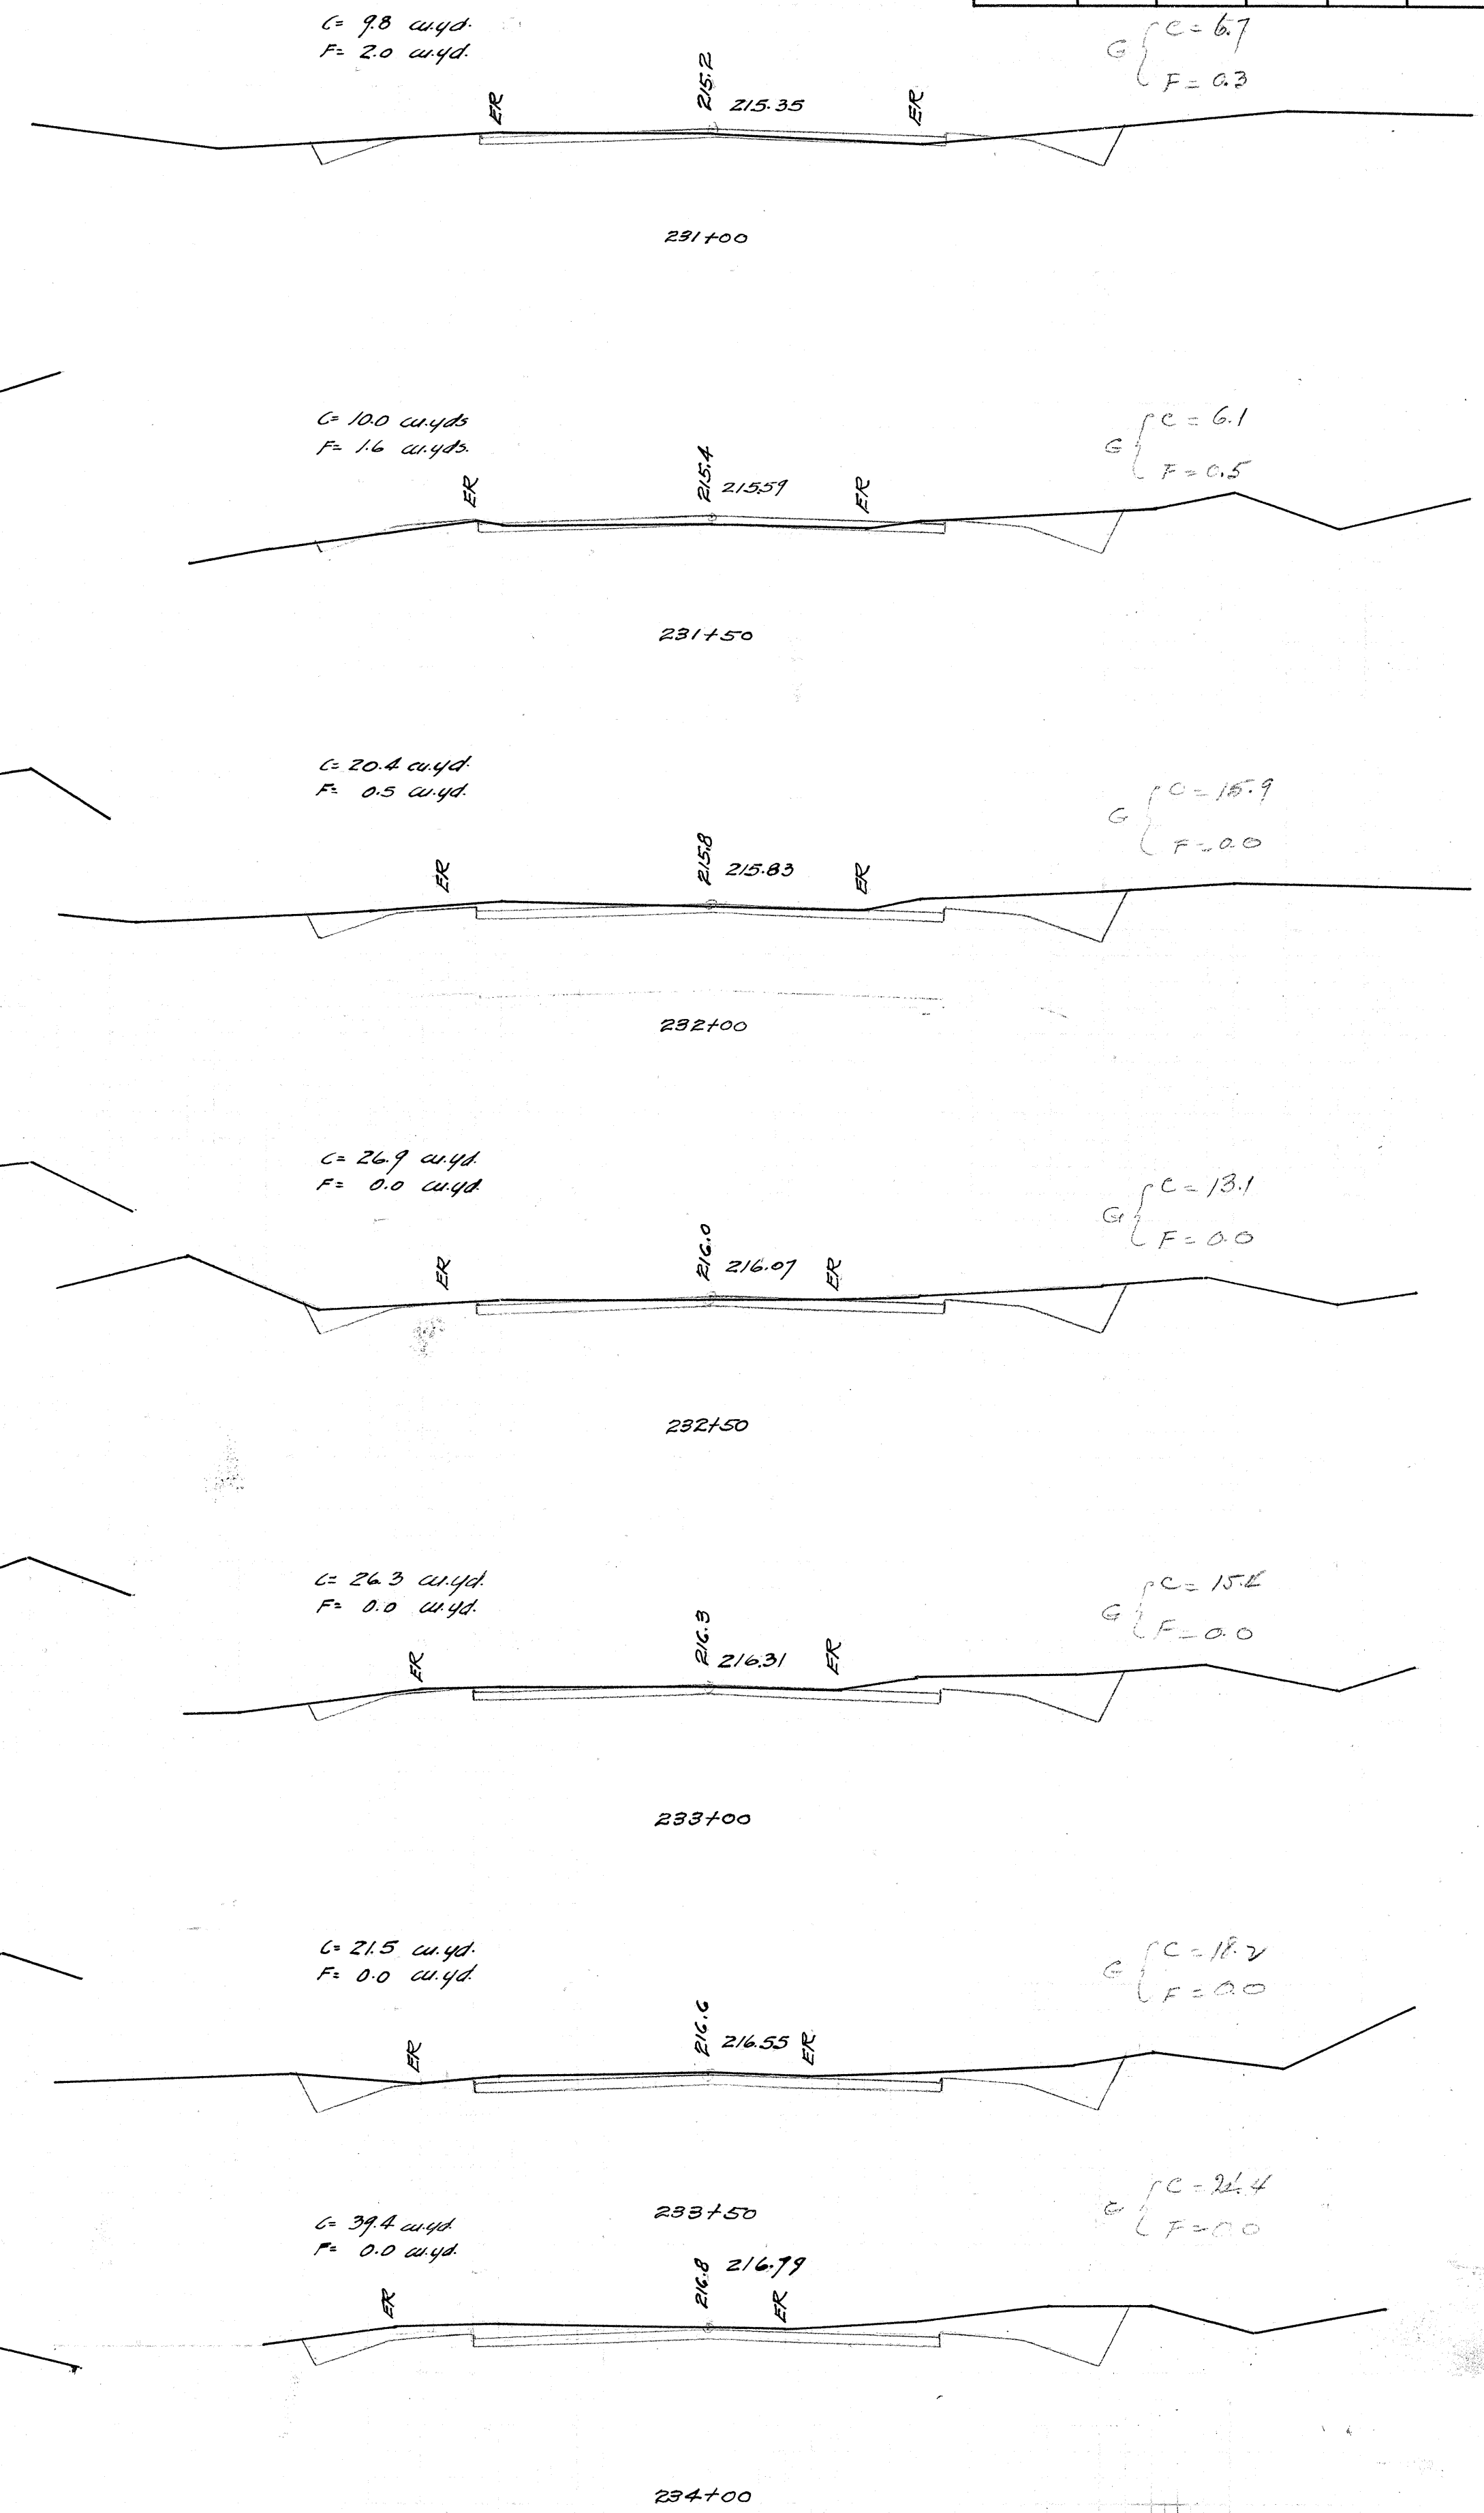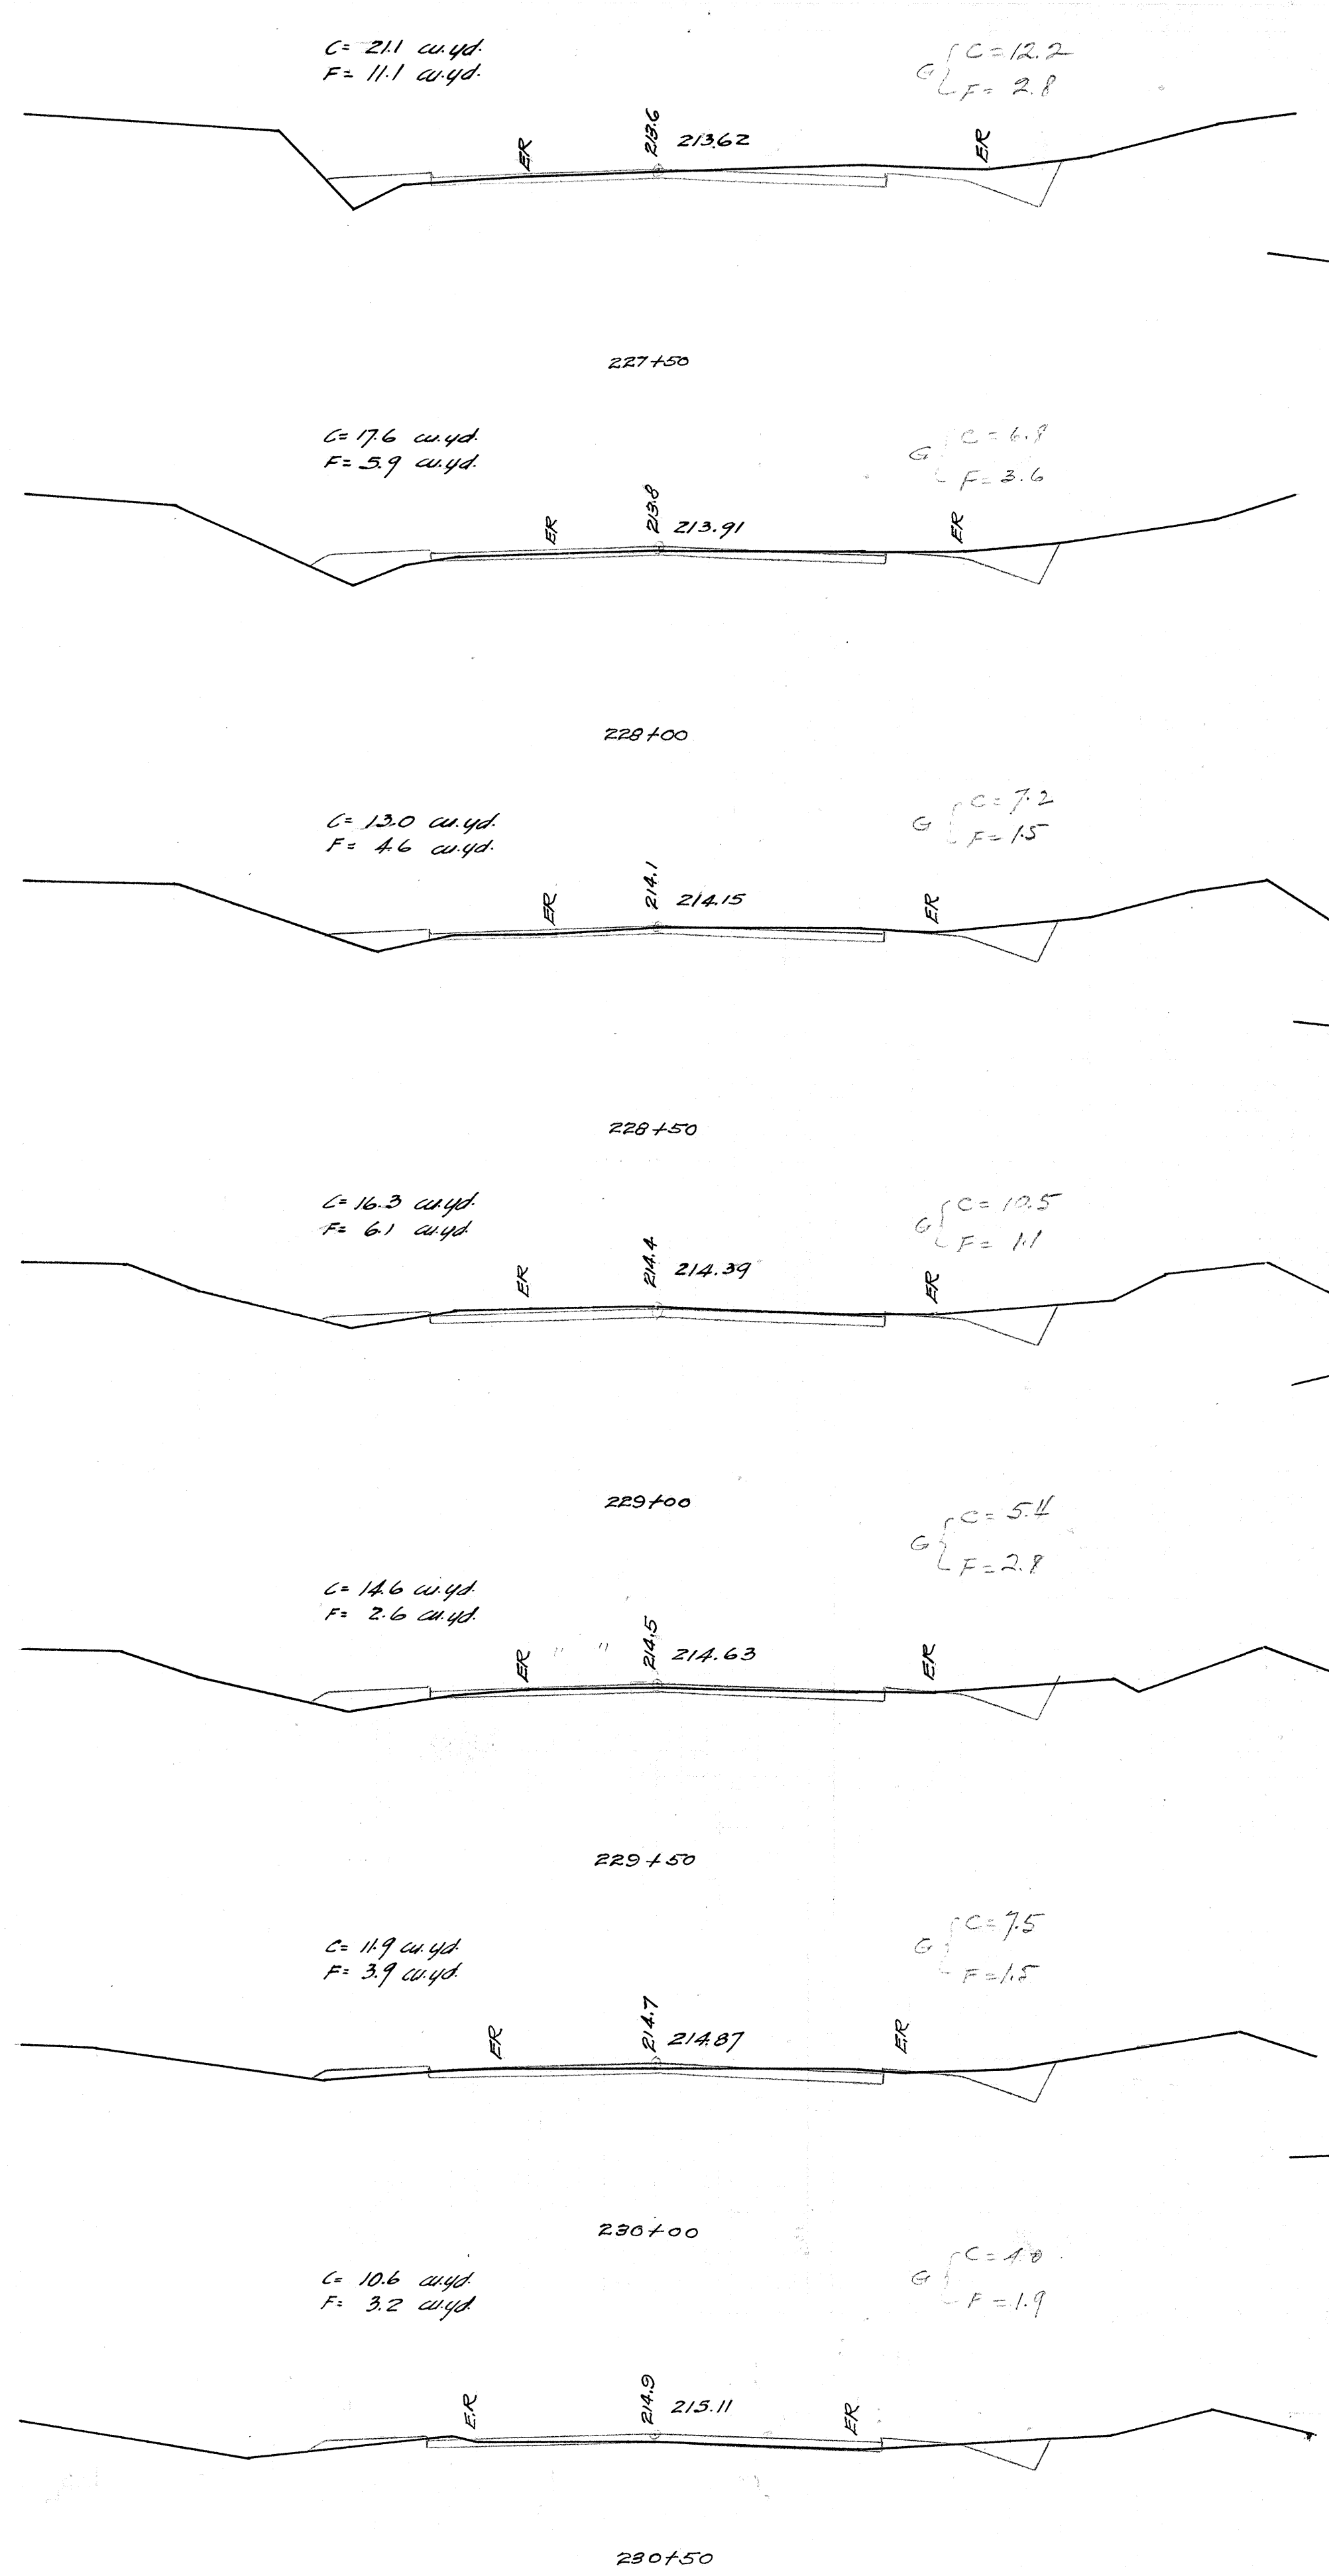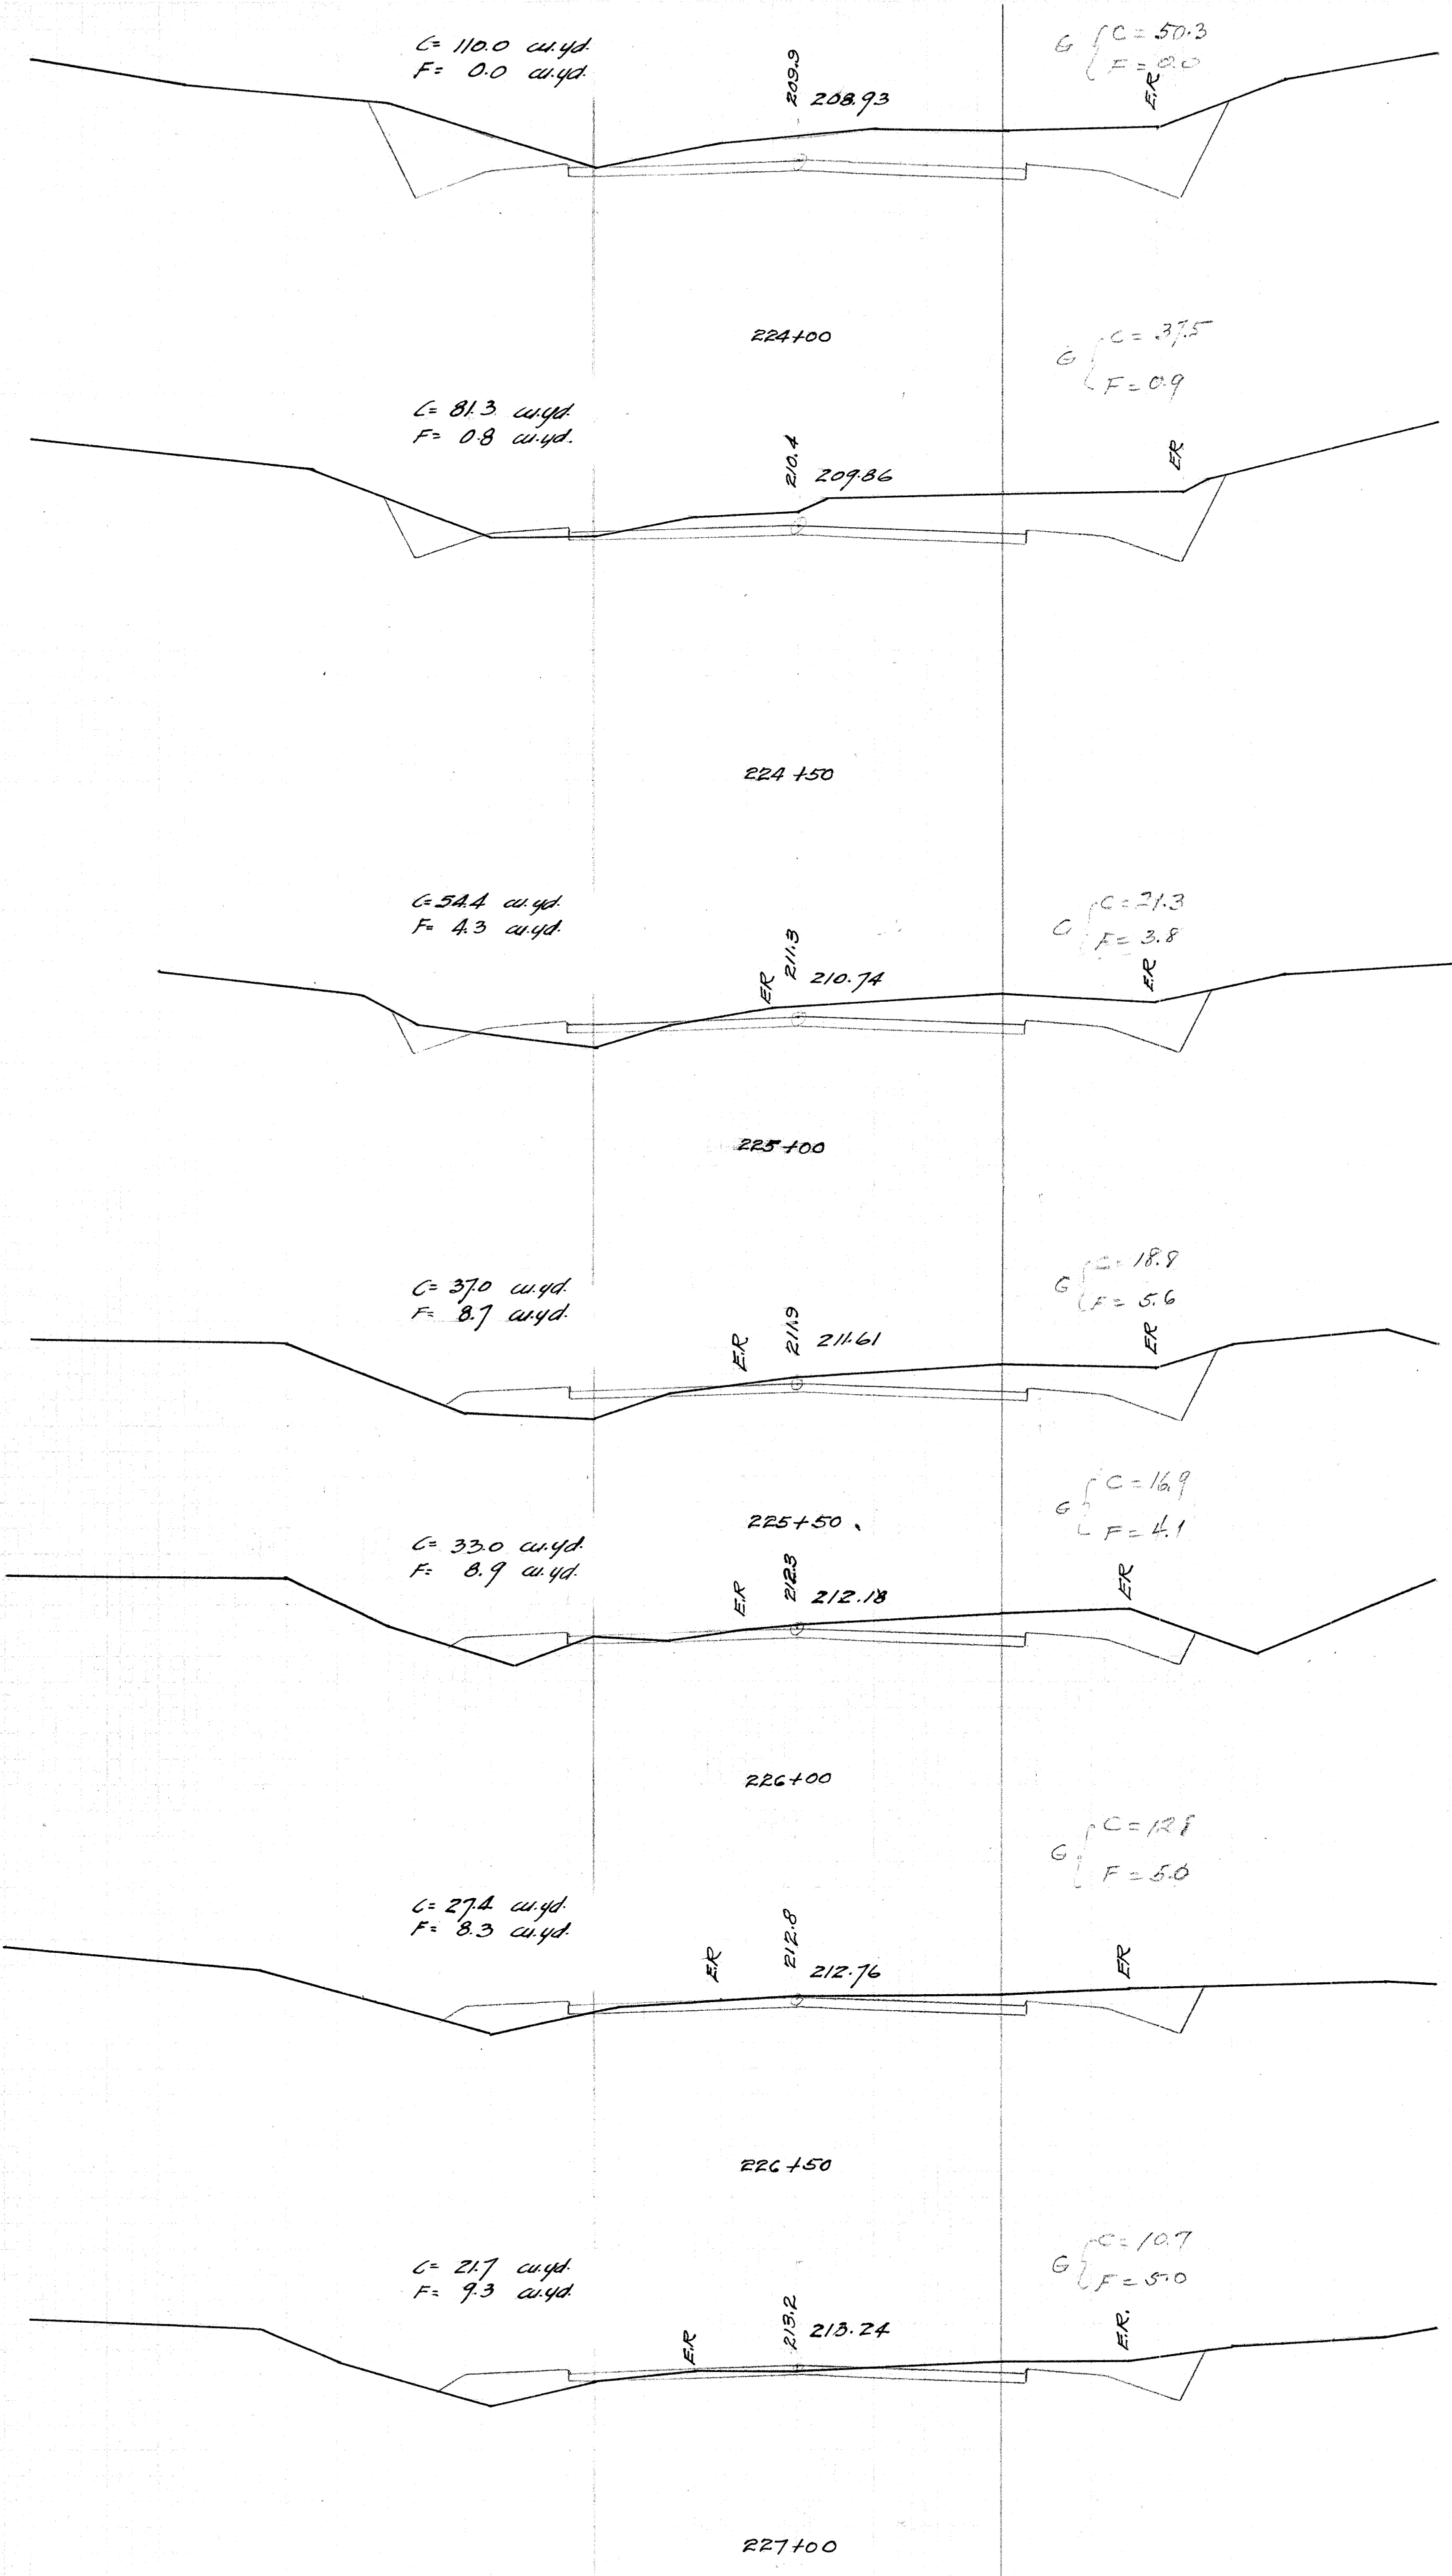

4188.10

Plan No.	Profile No.	Folder No.	Plan No.
6	15	2	7

FED. ROAD DIST. NO.	STATE	FED. AID PROJ. NO.	FISCAL YEAR	SHEET NO.	TOTAL SHEETS
HAW	HAW	5-D	1931	11	14

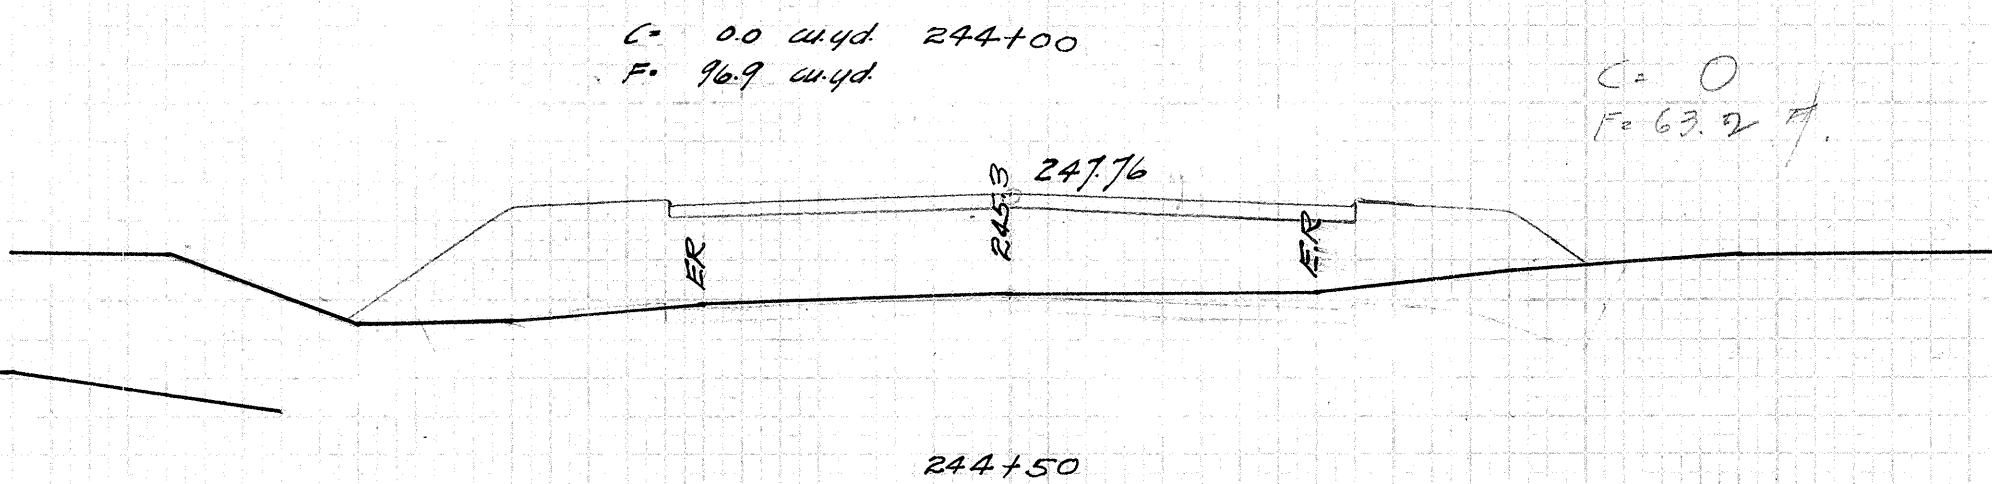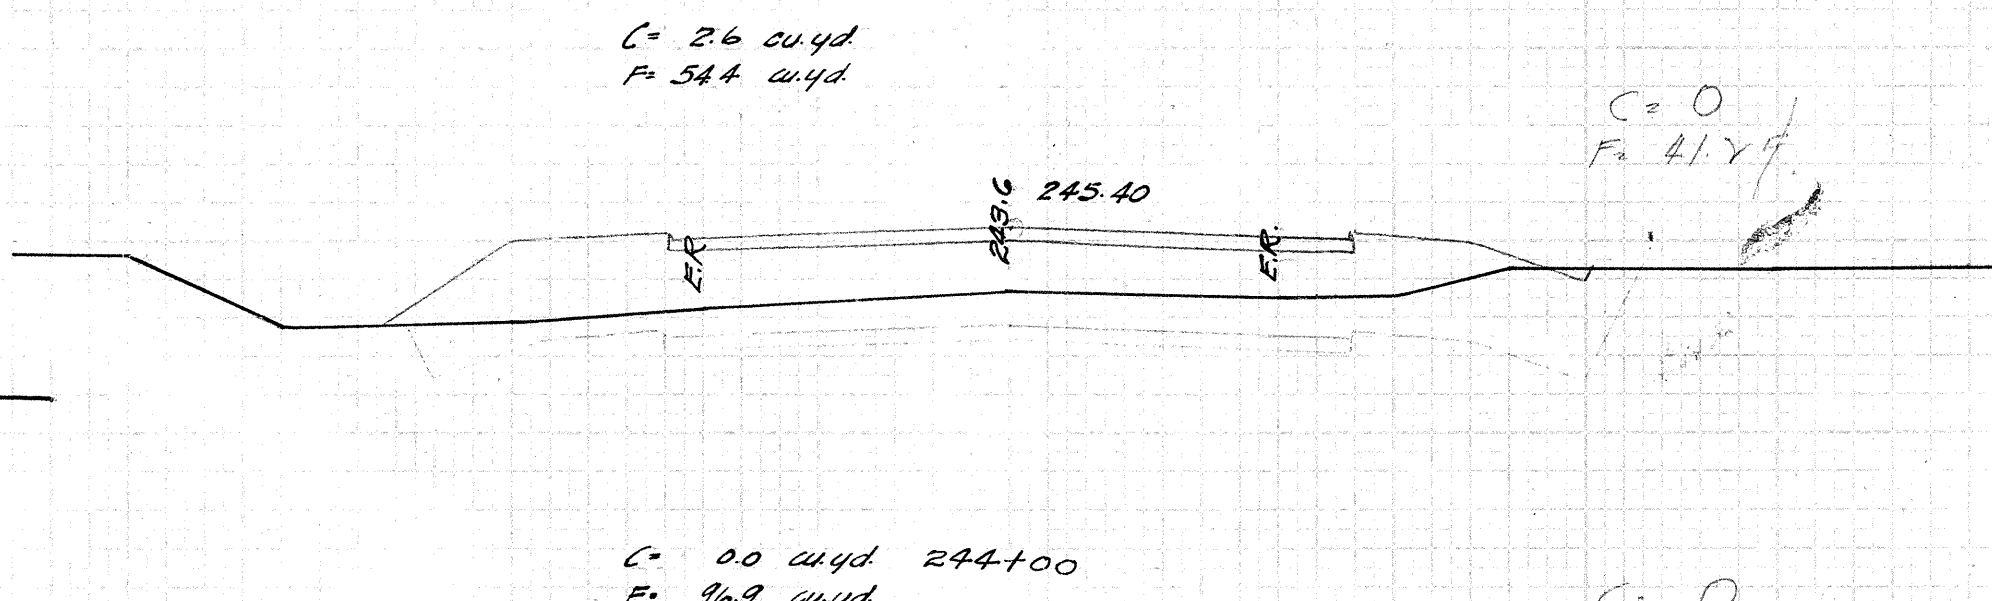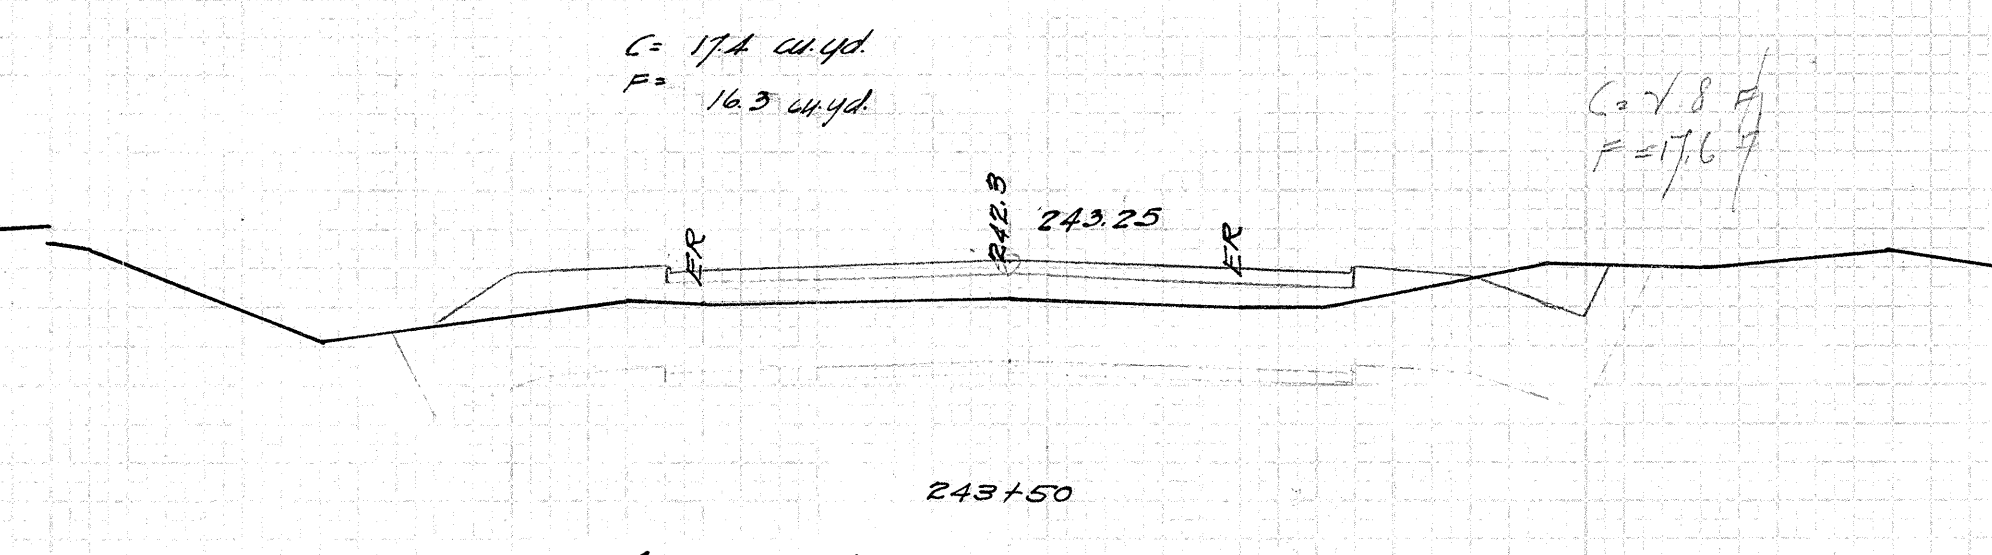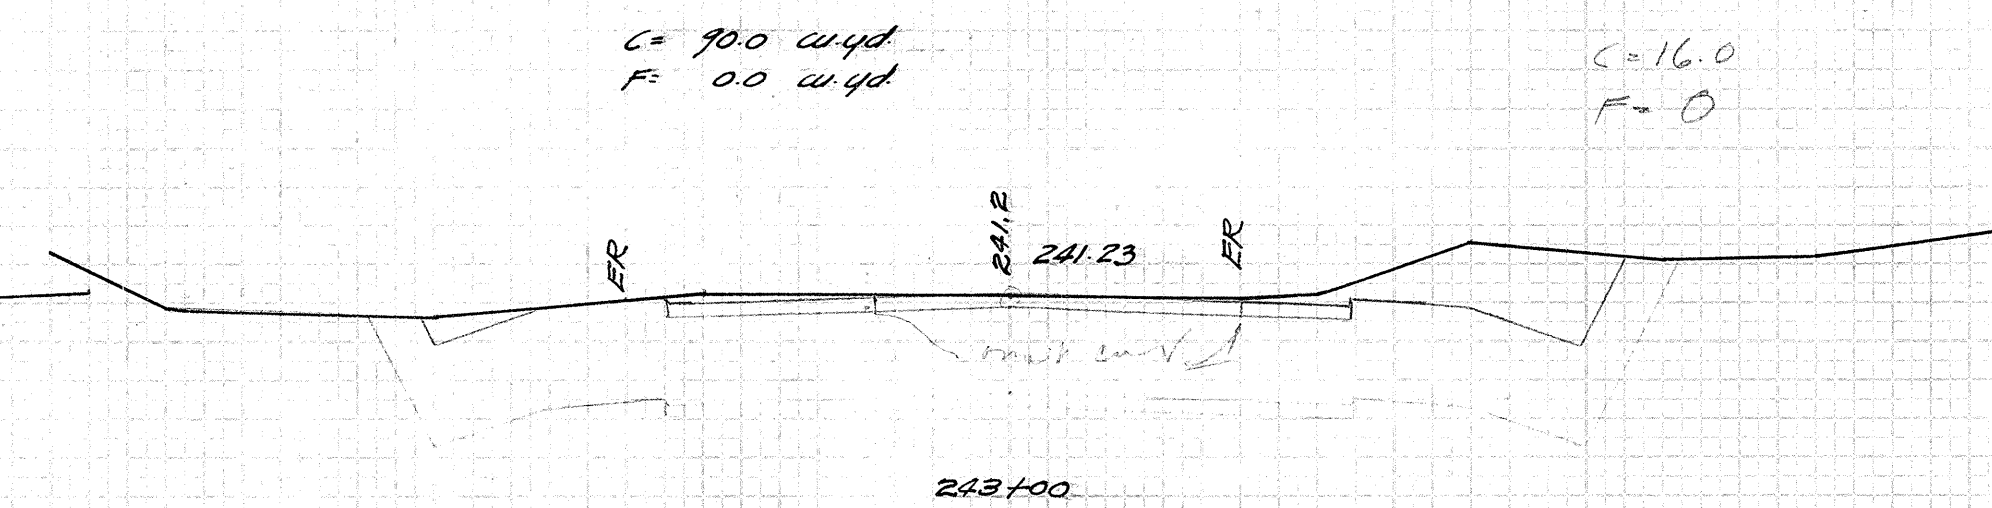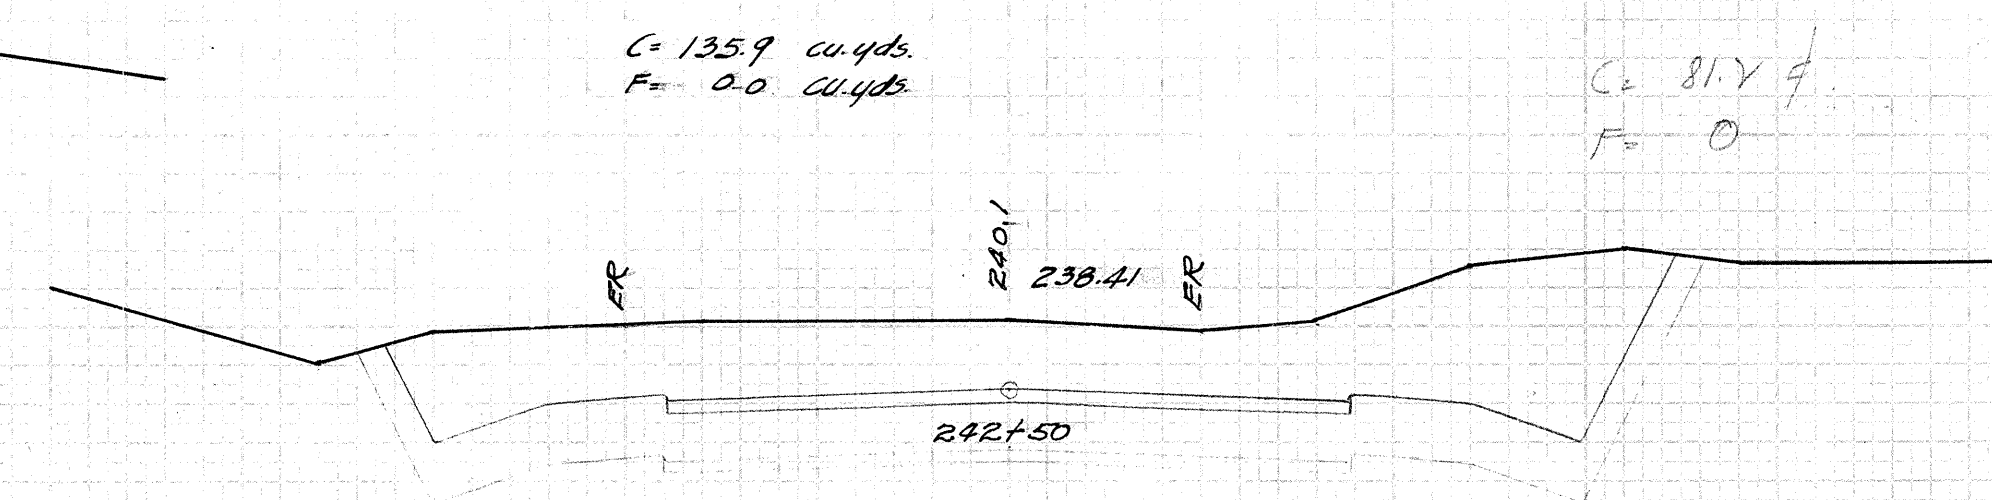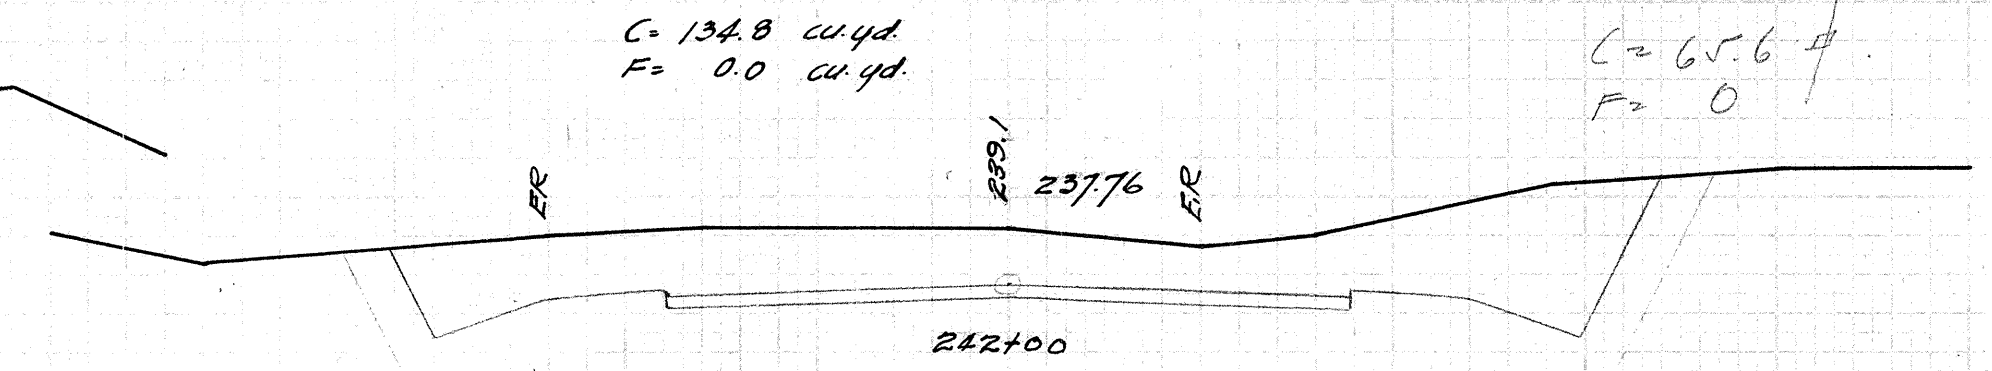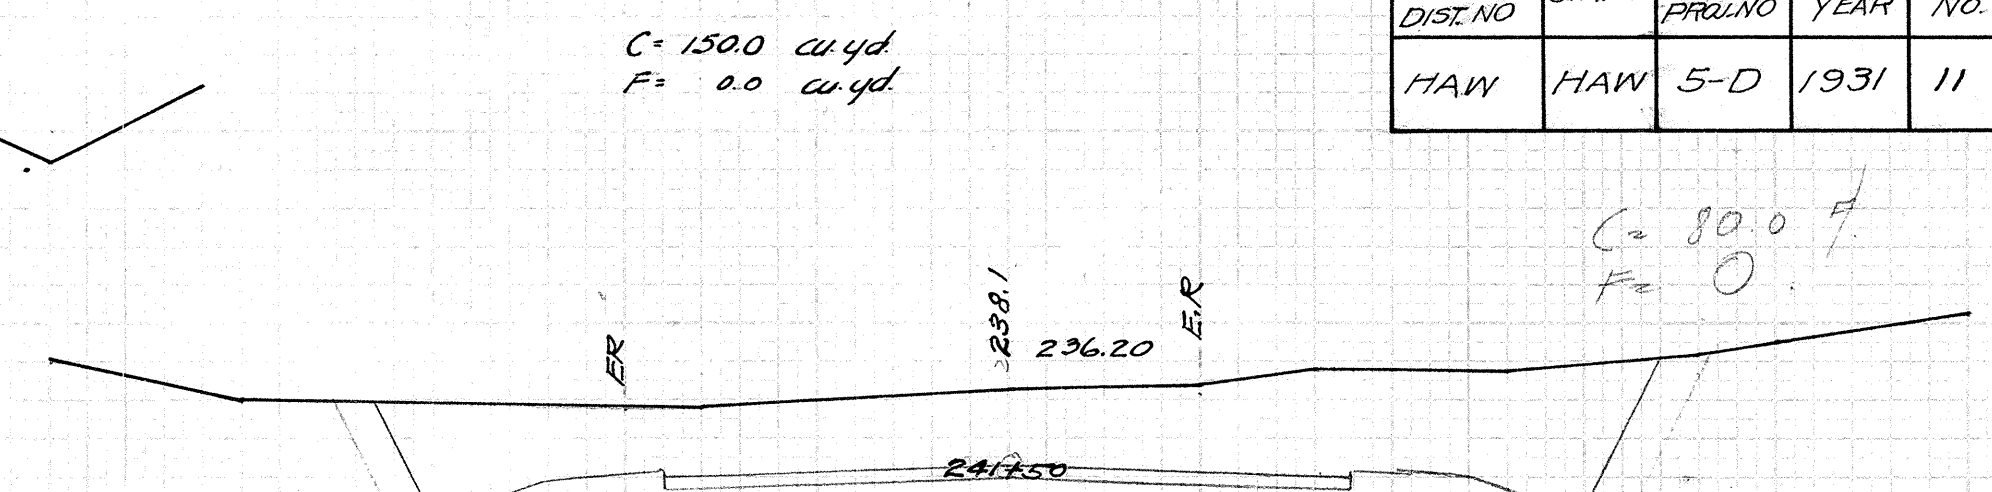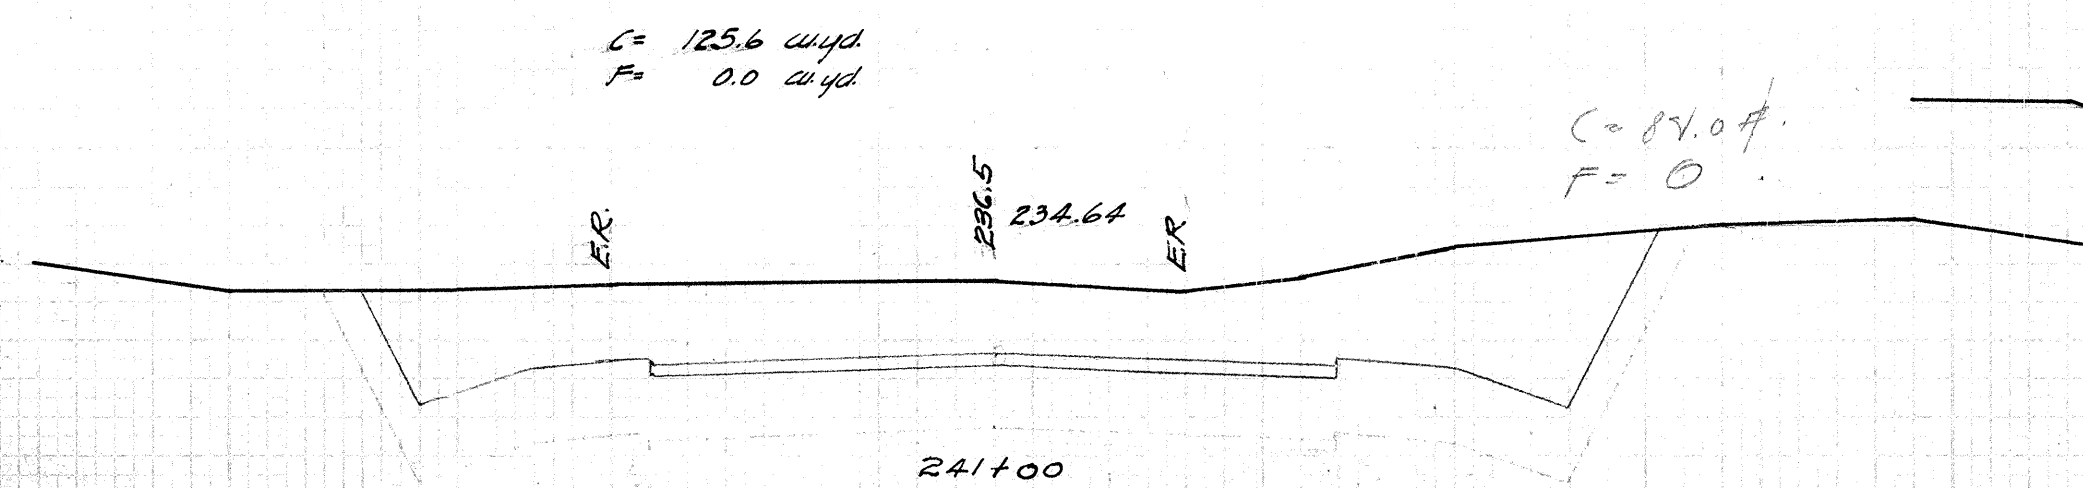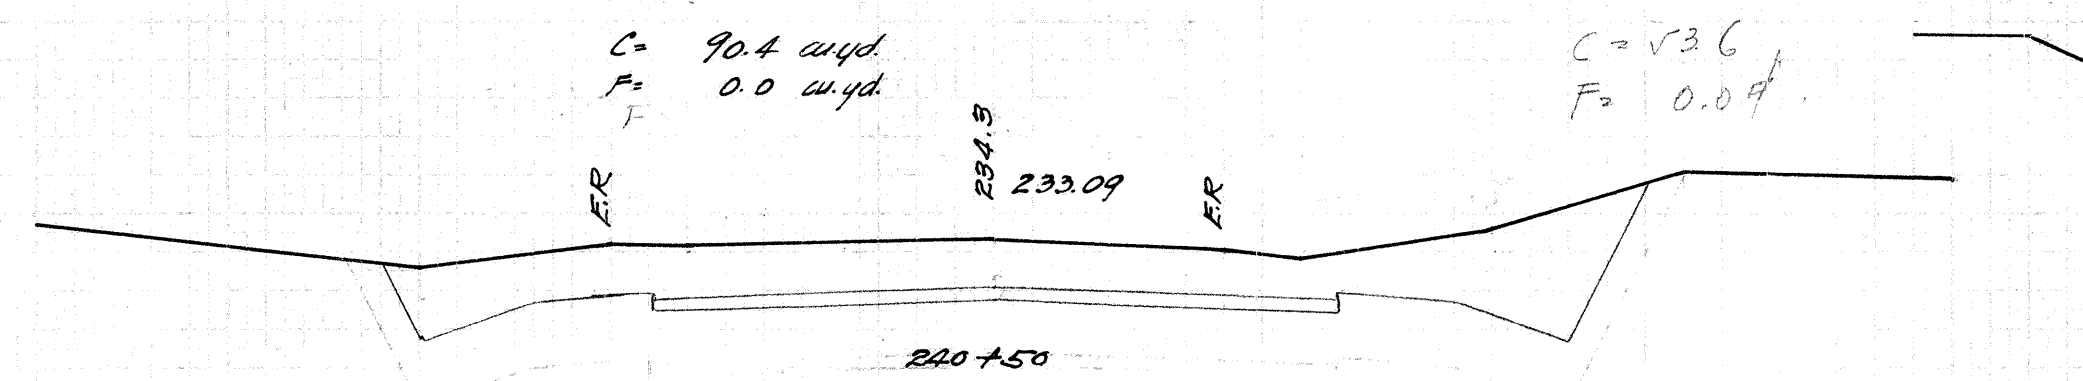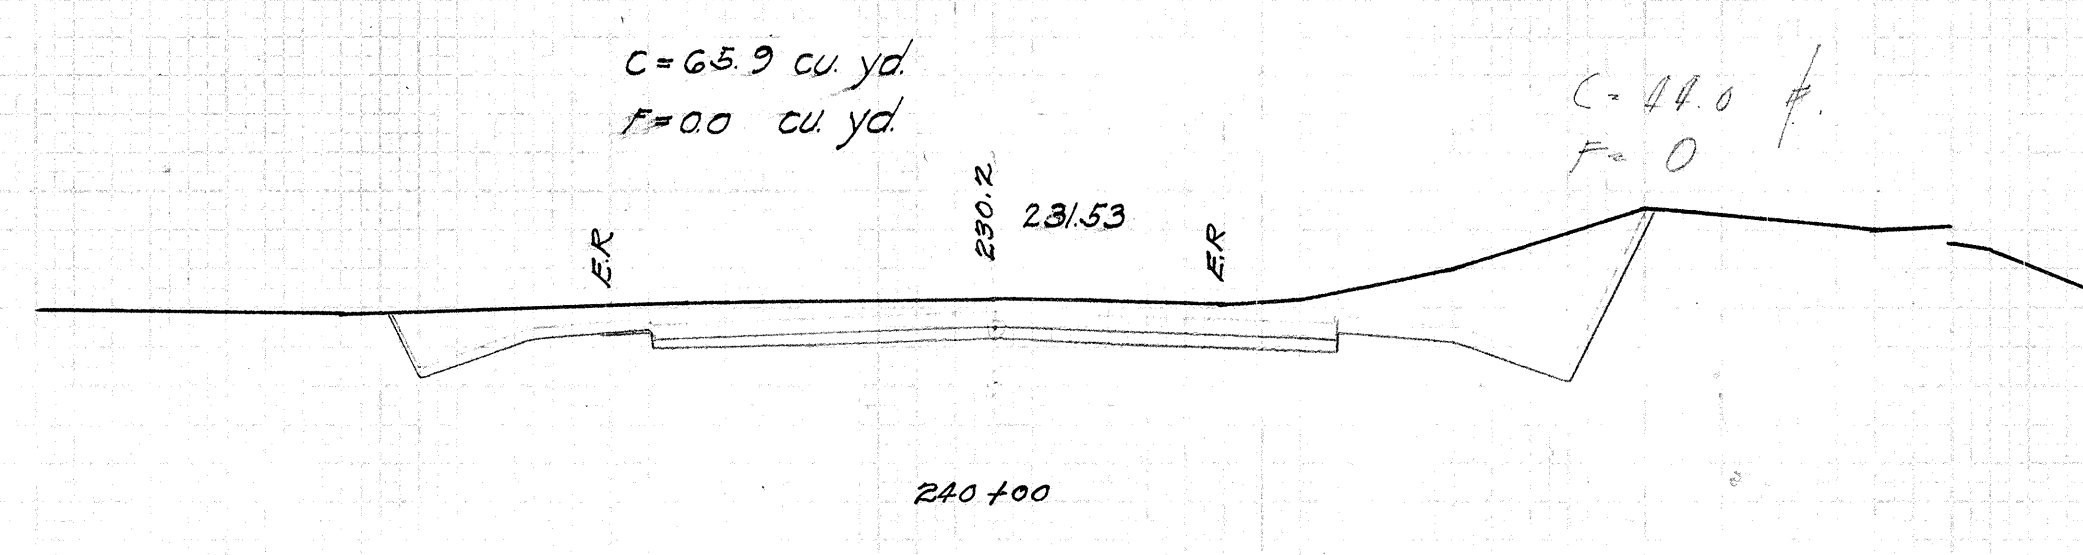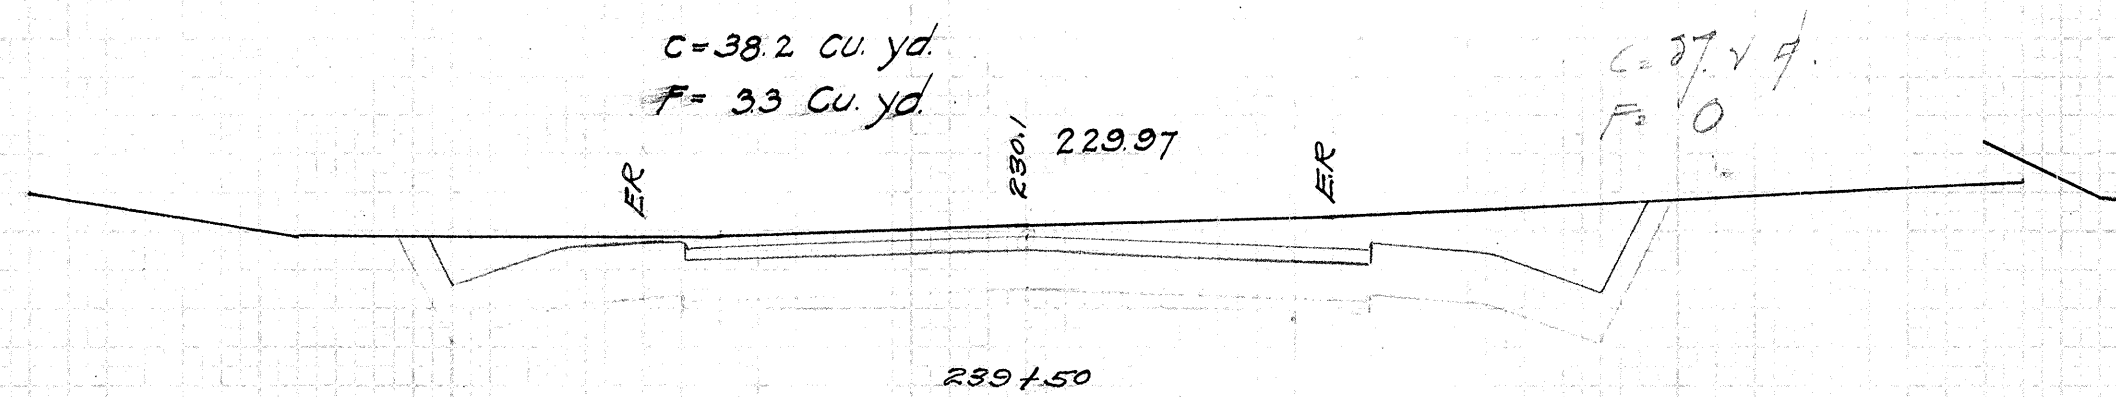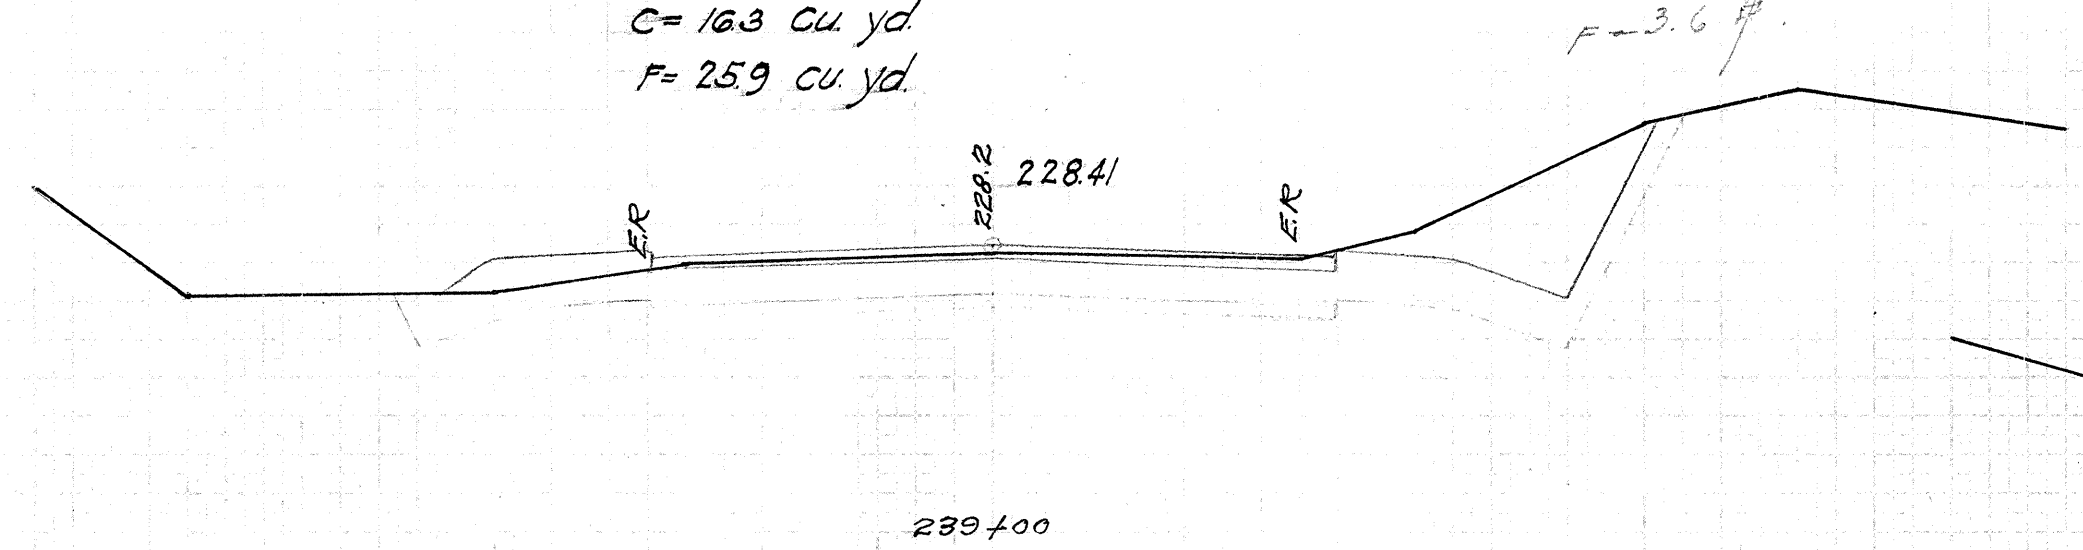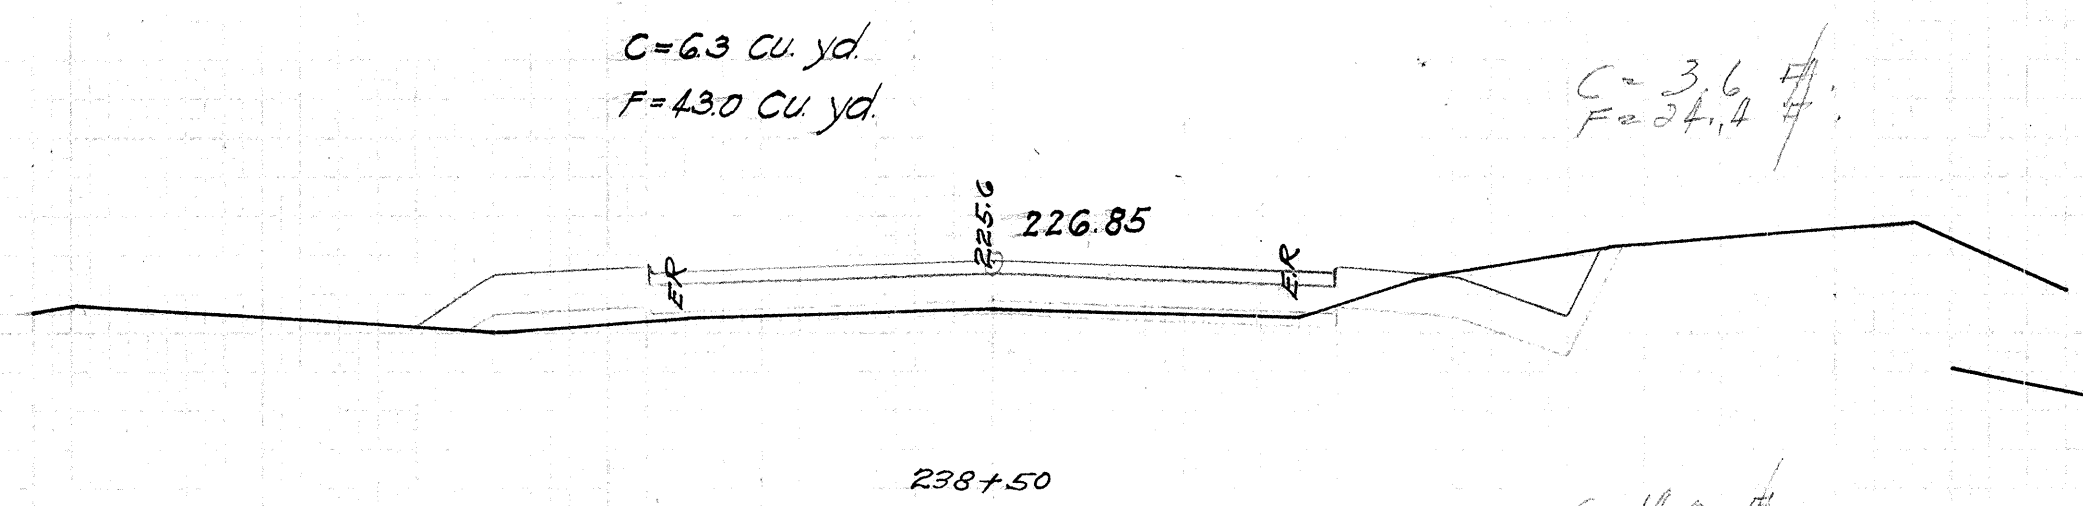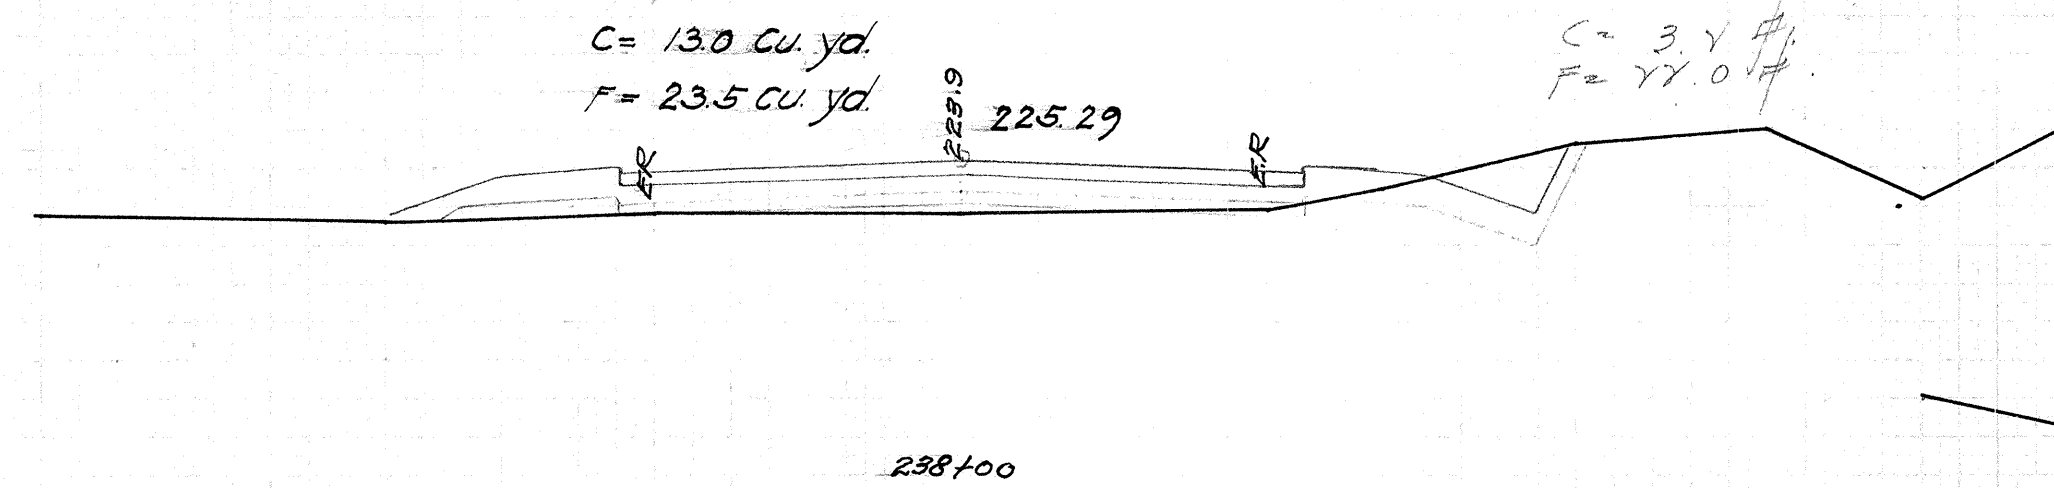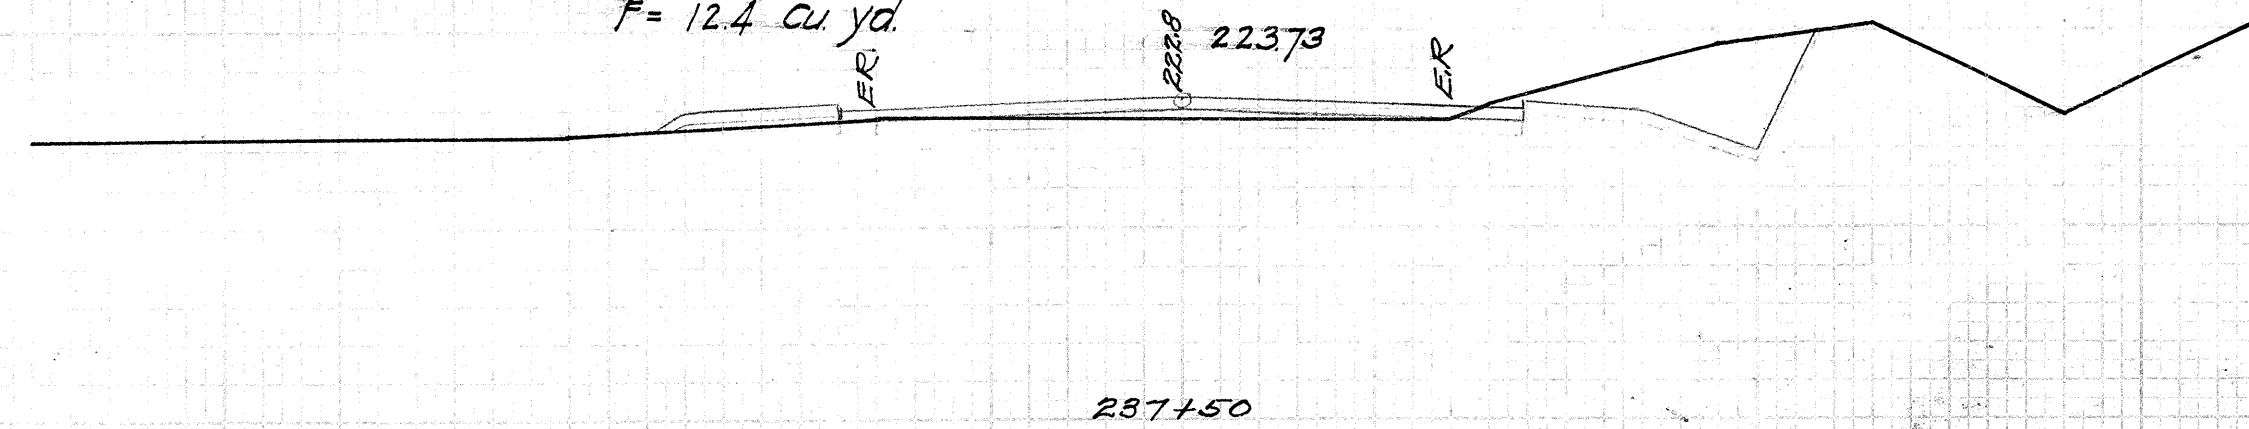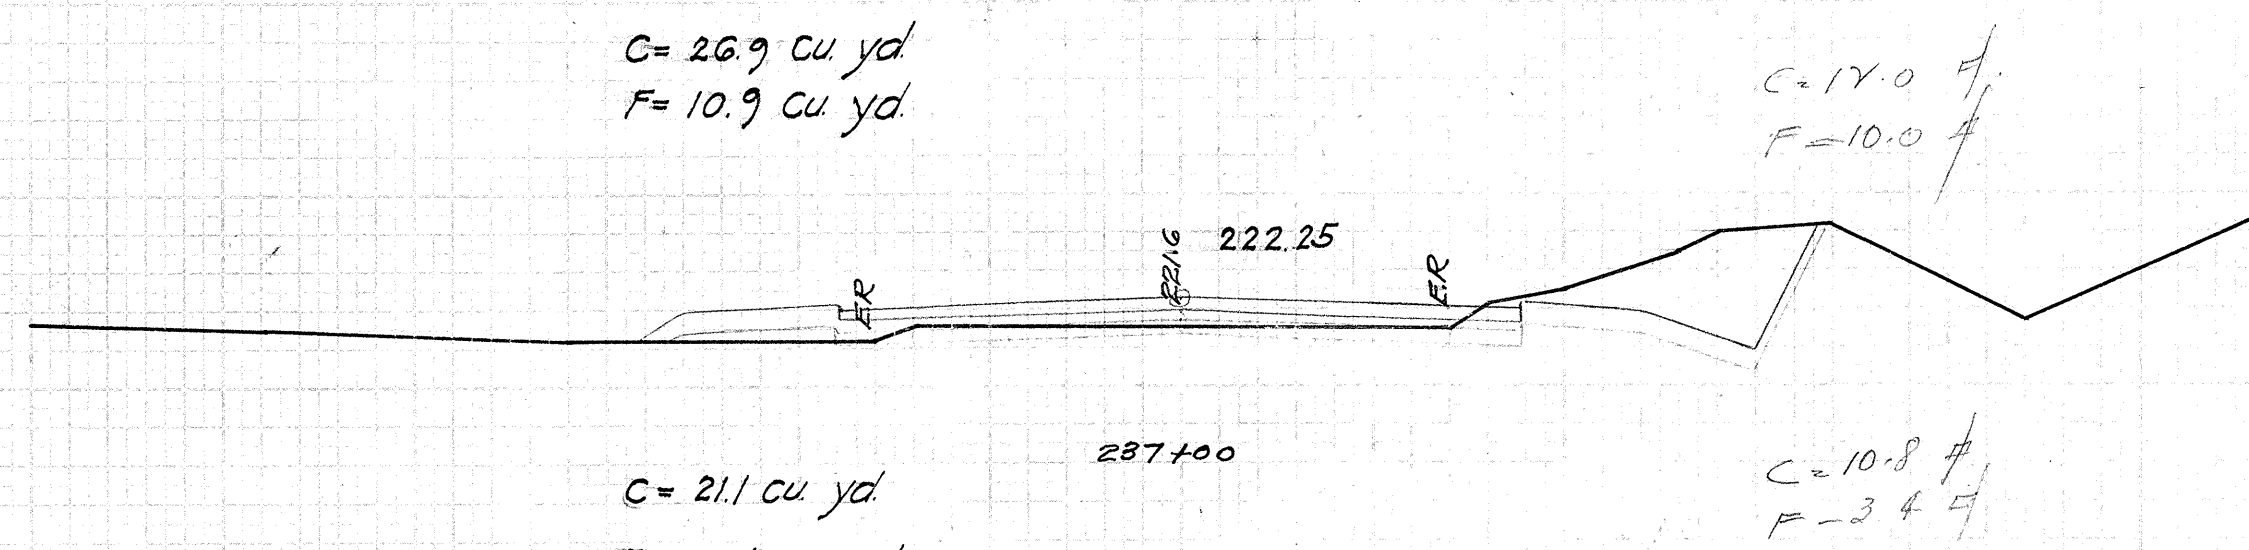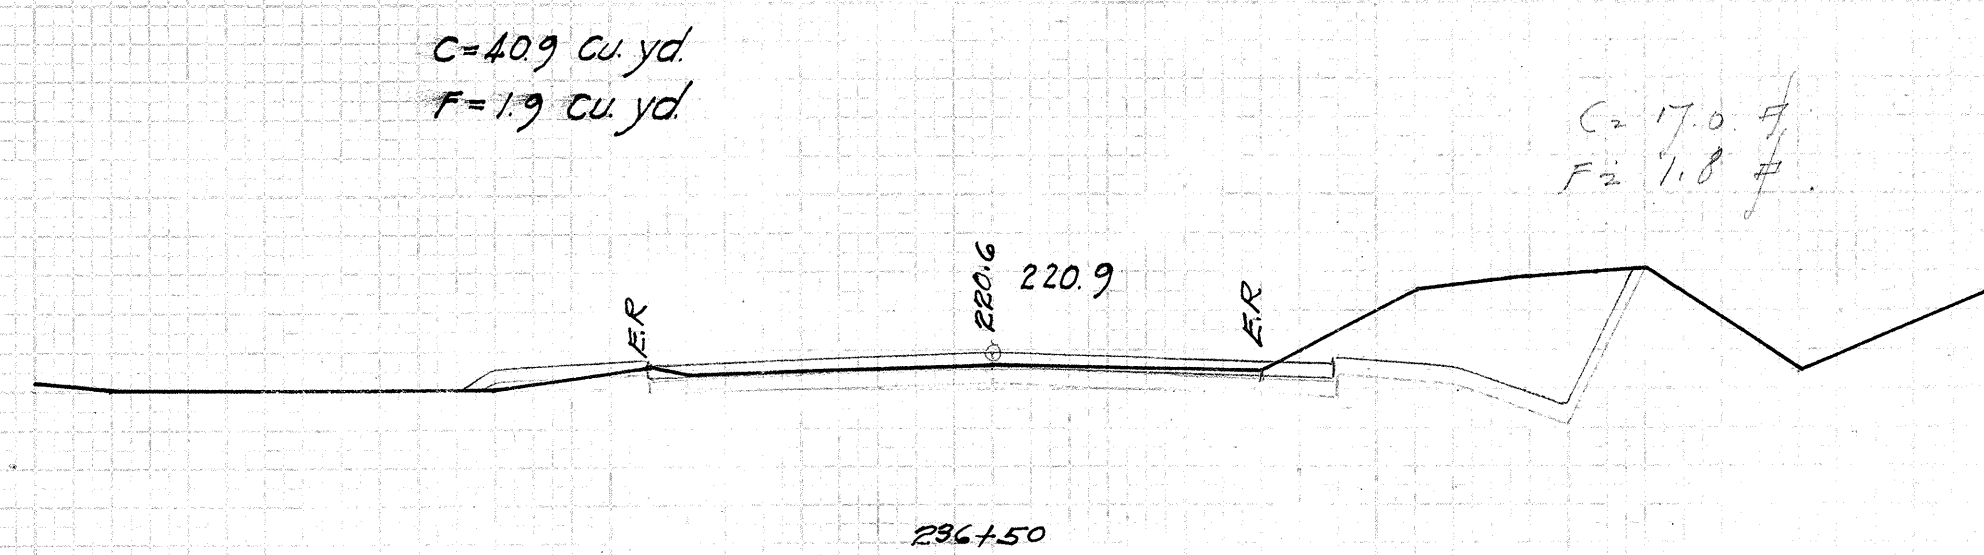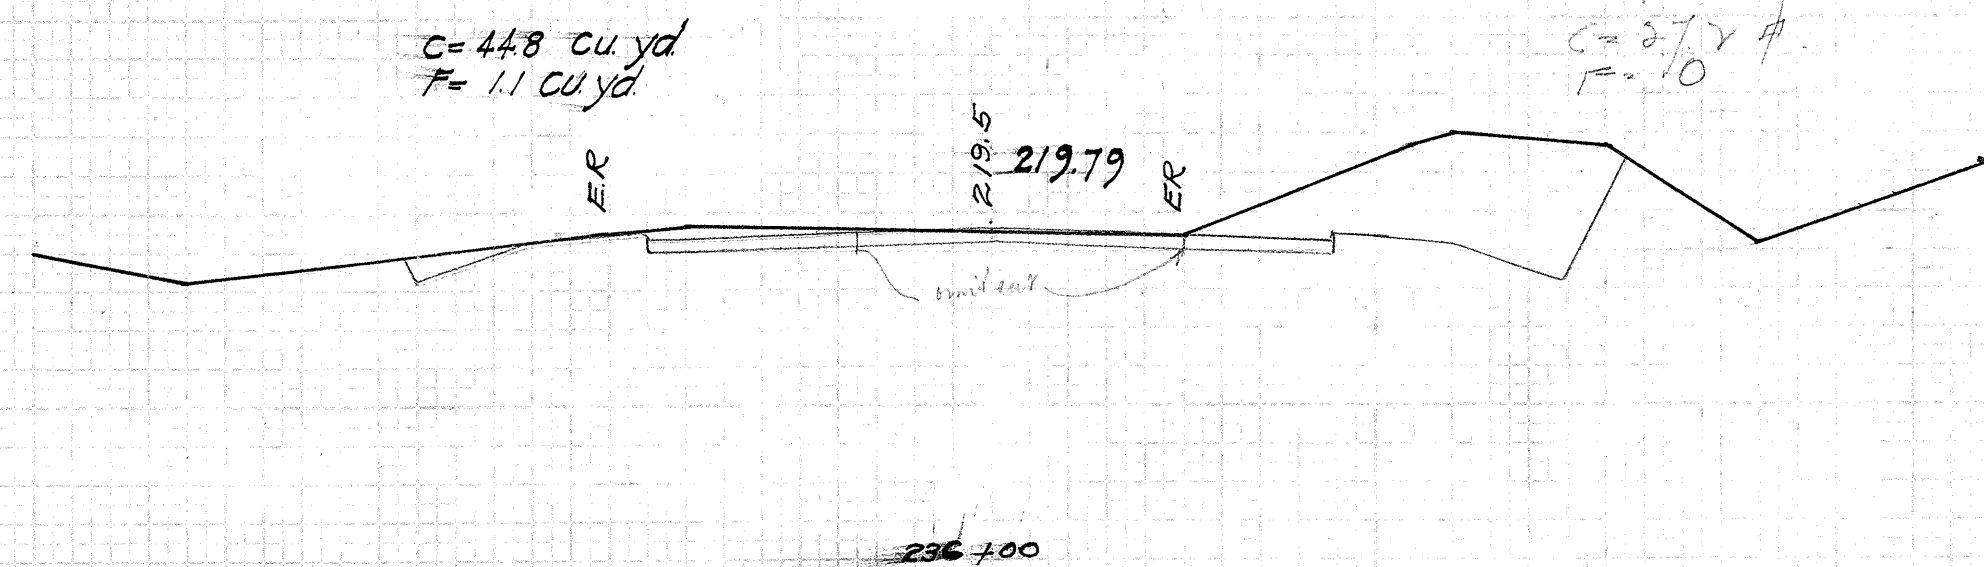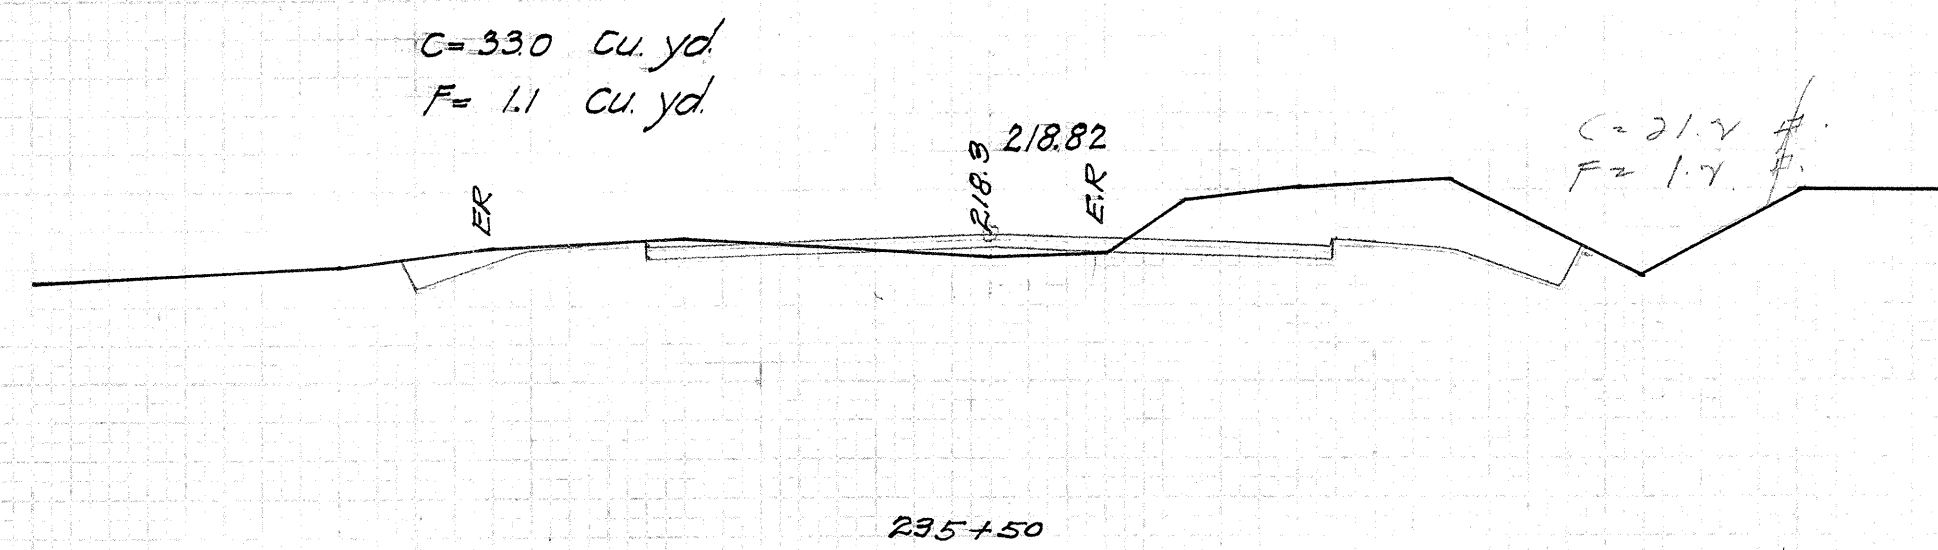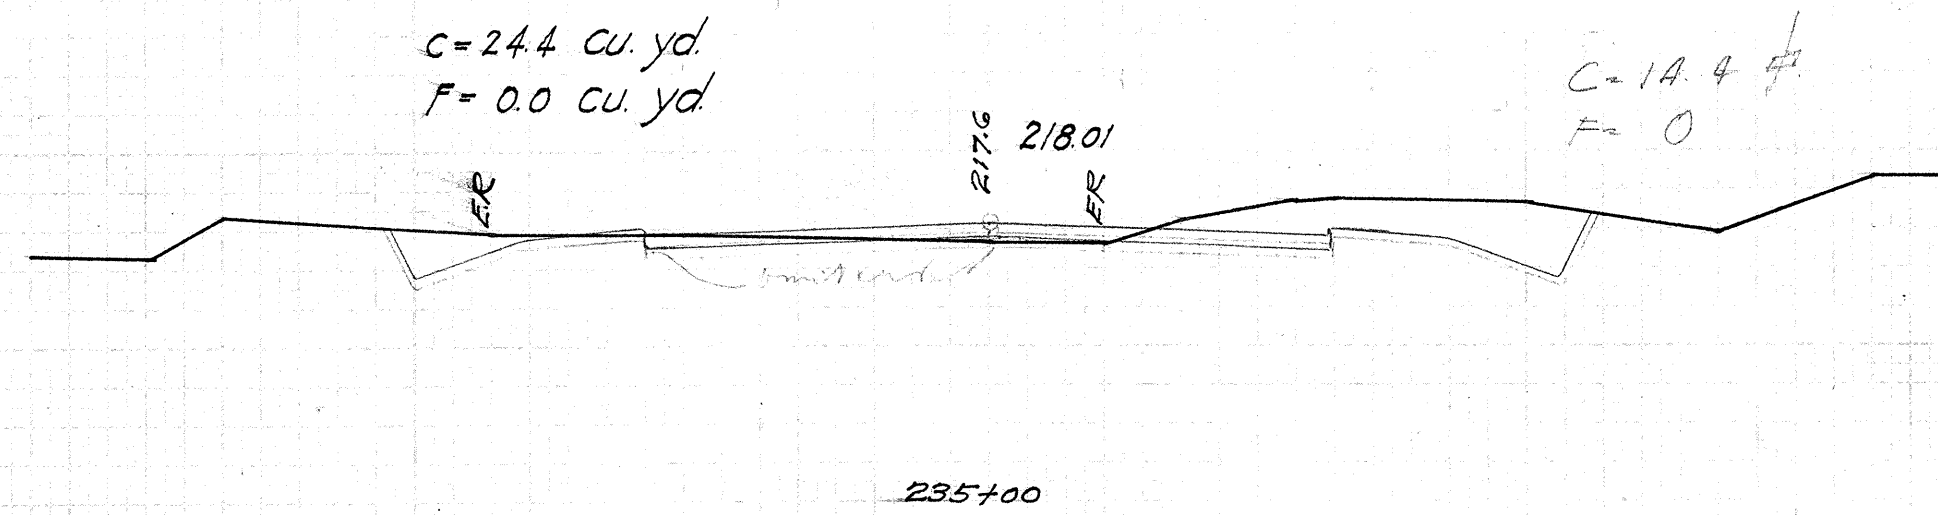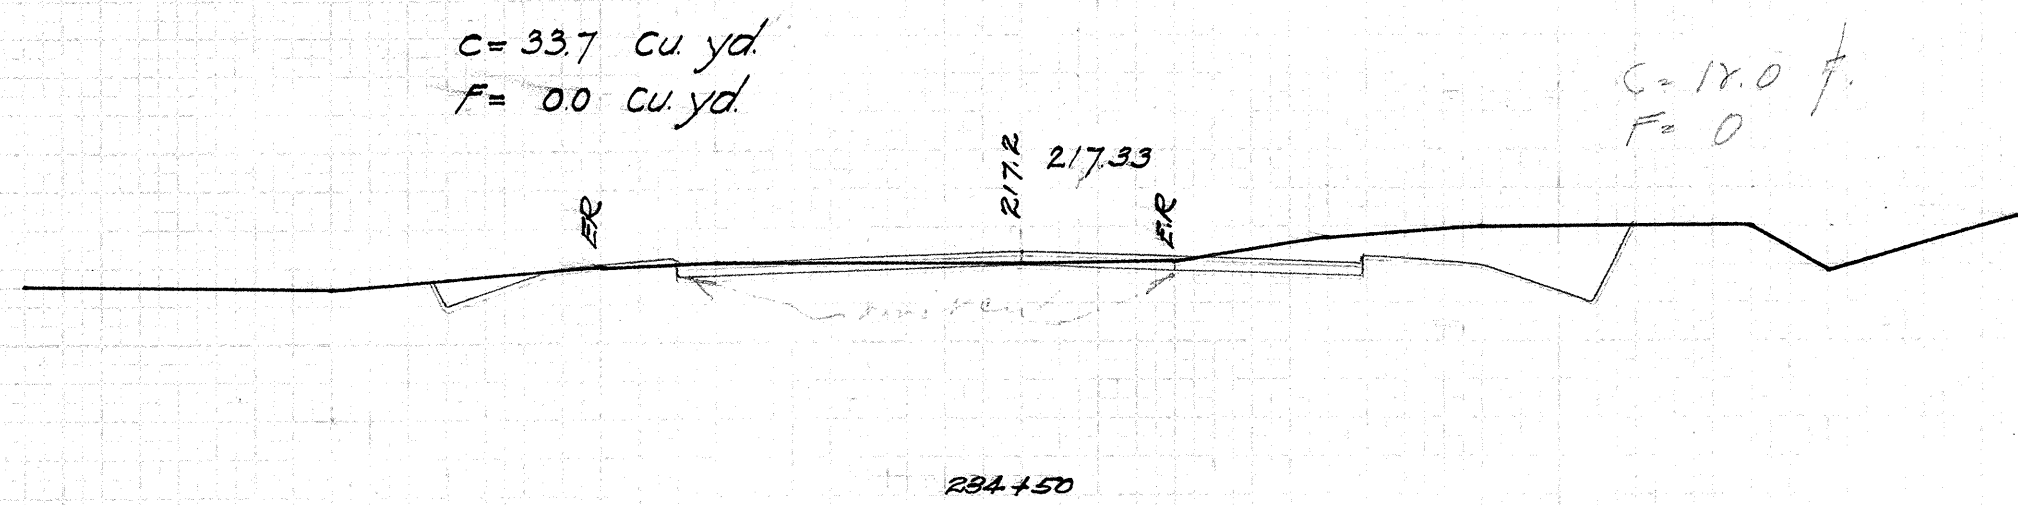

4188.11

Plan File	Pockets	Folders	Pictures
No. 6	No. 15	No. 2	No.

DATE	BY	NO.
FINAL SURVEY	QUANTITY	PLANNED
NOTE BOOK	PLANNED	PLANNED
NO.	NO.	NO.

DATE	BY	NO.
ORIGINAL SURVEY	QUANTITY	PLANNED
NOTE BOOK	PLANNED	PLANNED
NO.	NO.	NO.

FED ROAD DIST NO	STATE	FED AID PROJ NO	FISCAL YEAR	SHEET NO	TOTAL SHEETS
HAW	HAW	5-D	1931	12	14

C = 14.4
G
F = 0.0

C = 9.9
G
F = 0.7

C = 6.7
G
F = 1.9

C = 3.2
G
F = 2.3

C = 2.3
G
F = 0.3

C = 1.1
G
F = 6.6

C = 1.4
G
F = 2.15

4188.12

Plan File No. 6	Pocket No. 15	Folder No. 2	Plan No.
-----------------	---------------	--------------	----------

252+00

252+50

253+00

253+50

254+00

254+50

255+00

C = 27.8 cy
F = 0.1 cy

C = 22.4 cy
F = 0.5 cy

C = 15.4 cy
F = 2.4 cy

C = 9.1 cy
F = 3.9 cy

C = 5.6 cy
F = 2.2 cy

C = 3.5 cy
F = 6.3 cy

C = 2.2 cy
F = 13.7 cy

C = 103.3
G
F = 0.0

C = 105.4
G
F = 0.0

C = 77.4
G
F = 0.0

C = 34.9
G
F = 0.0

C = 50.1
G
F = 0.0

C = 25.5
G
F = 0.0

C = 15.6
G
F = 0.1

C = 170.6 cy
F = 0.0 cy

C = 193.2 cy
F = 0.0 cy

C = 169.1 cy
F = 0.0 cy

C = 103.9 cy
F = 0.0 cy

C = 78.7 cy
F = 0.0 cy

C = 38.5 cy
F = 0.0 cy

C = 38.0 cy
F = 0.1 cy

C = 0.0
G
F = 81.6

C = 0.0
G
F = 64.3

C = 0.0
G
F = 37.7

C = 0.0
G
F = 50.5

C = 18.2
G
F = 0.2

C = 49.7
G
F = 0.0

C = 90.8
G
F = 0.0

245+00

245+50

246+00

FED ROAD DIST NO	STATE	FED AID PROJ NO	FISCAL YEAR	SHEET NO	TOTAL SHEETS
HAW	HAW	5-D	1931	13	14

FINAL SURVEY
NOT FOR CONSTRUCTION

ORIGINAL SURVEY
NOT FOR CONSTRUCTION

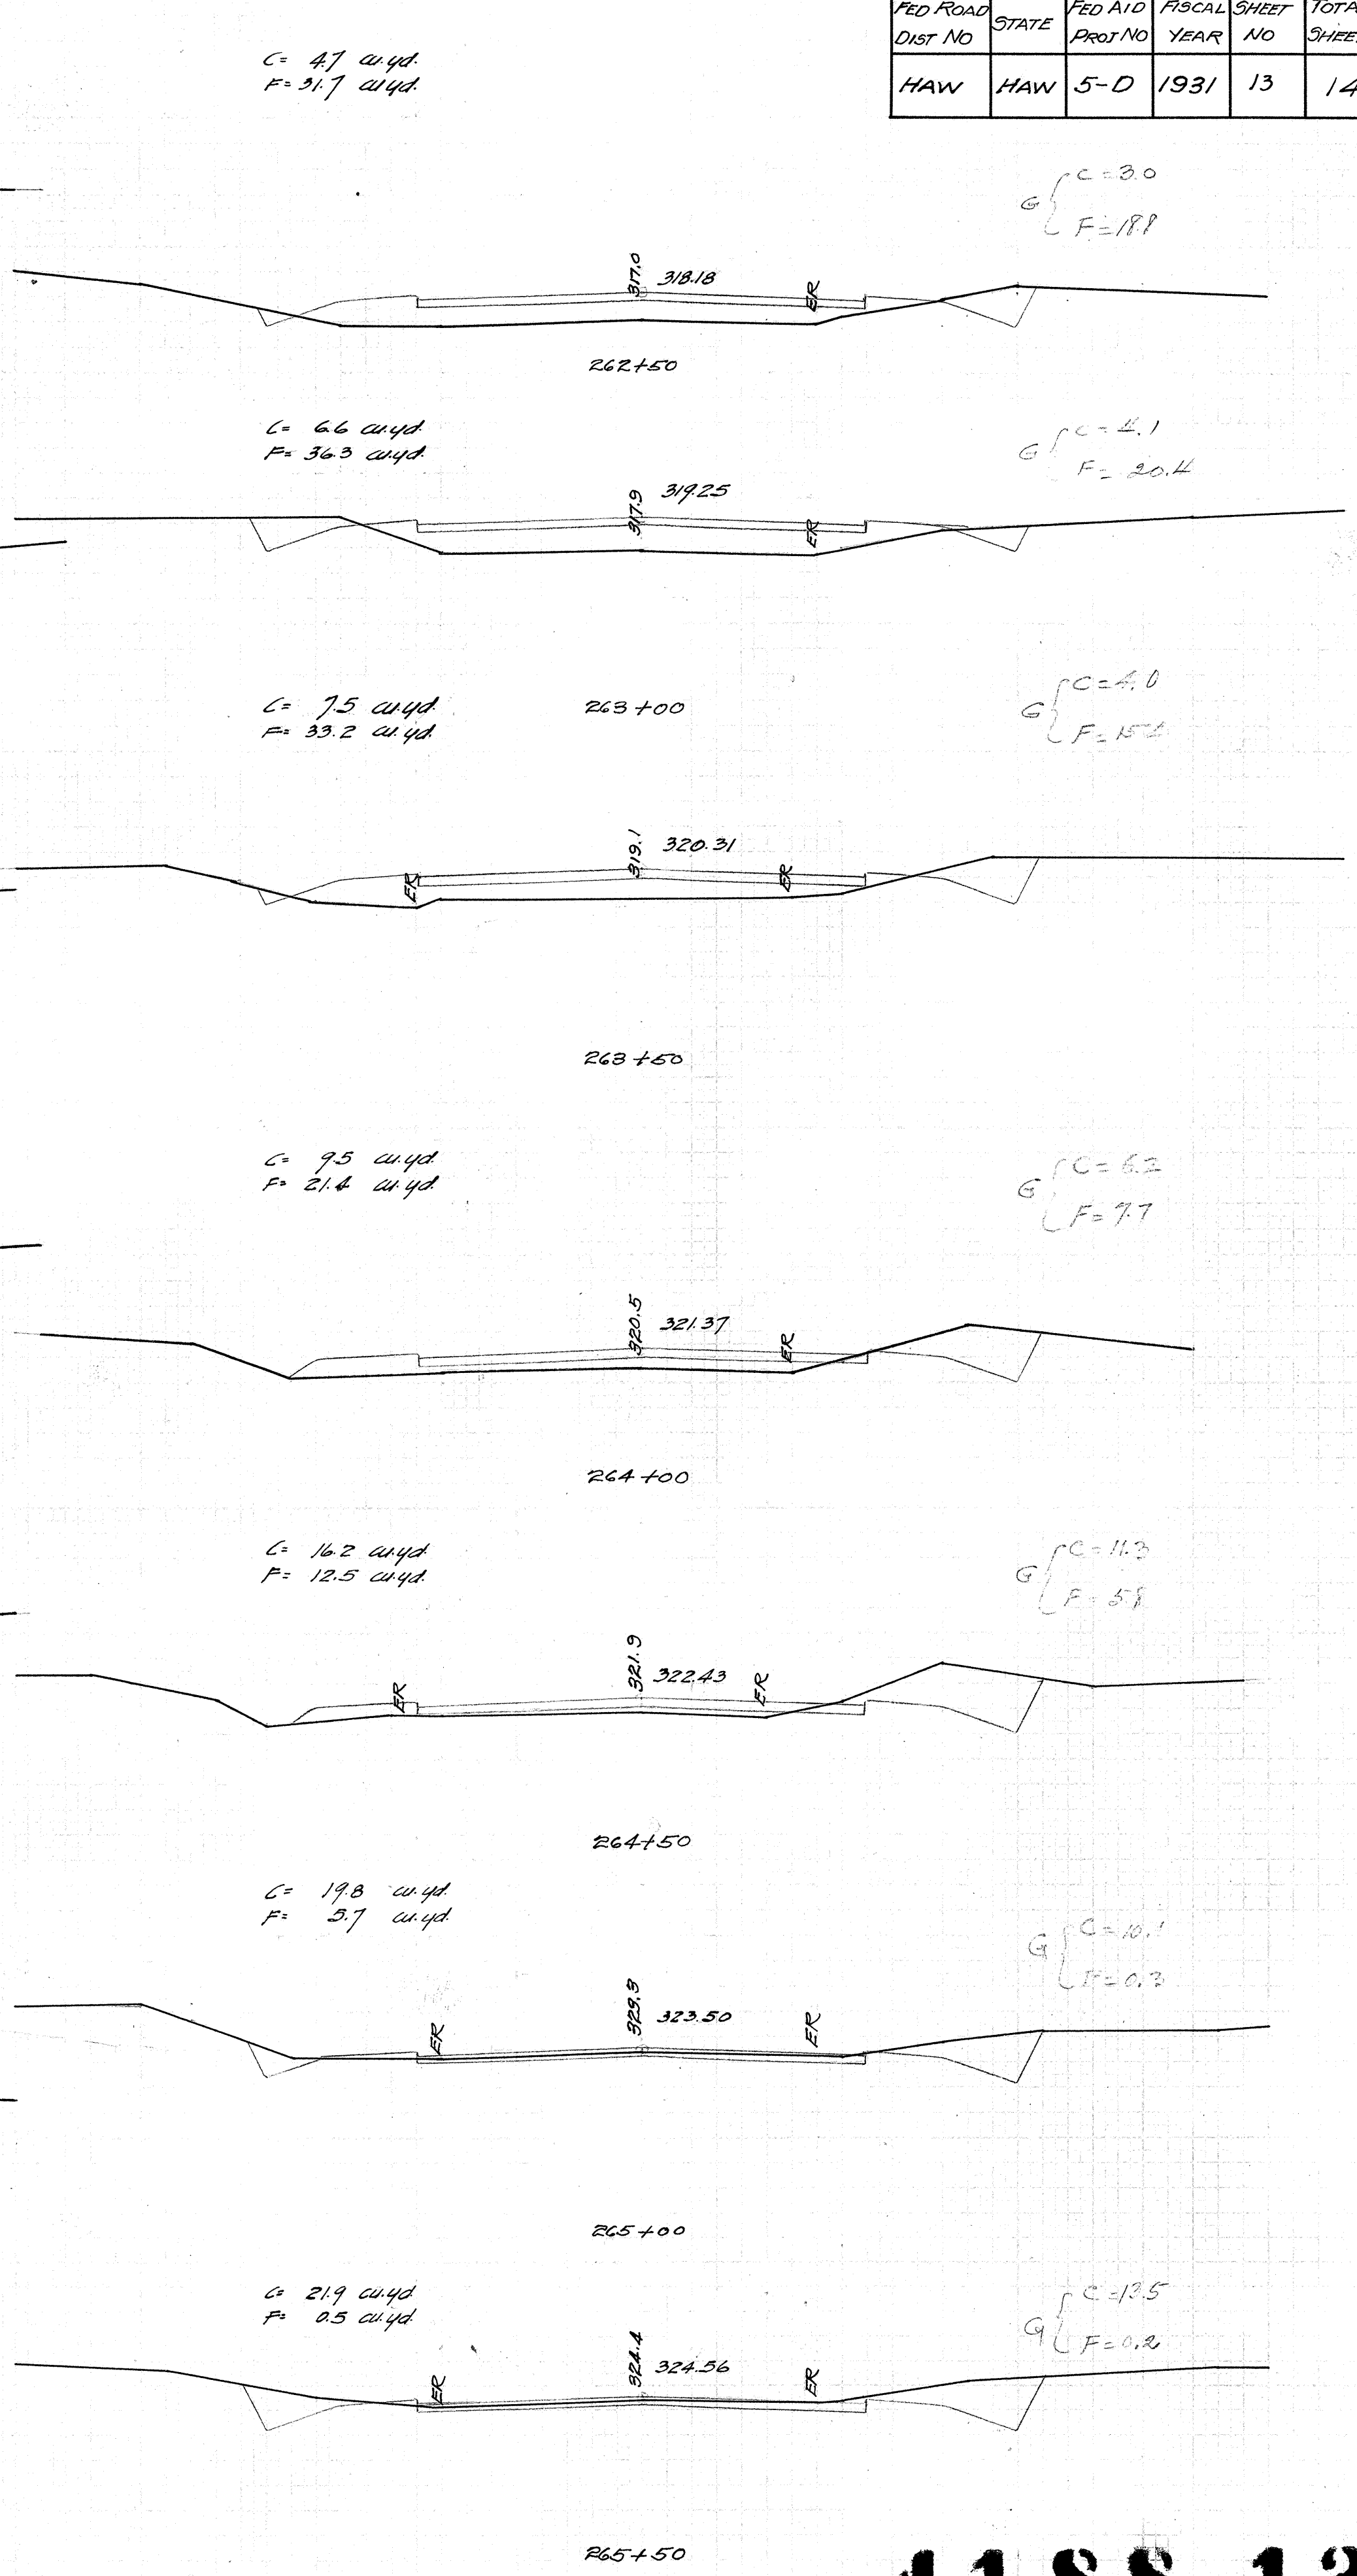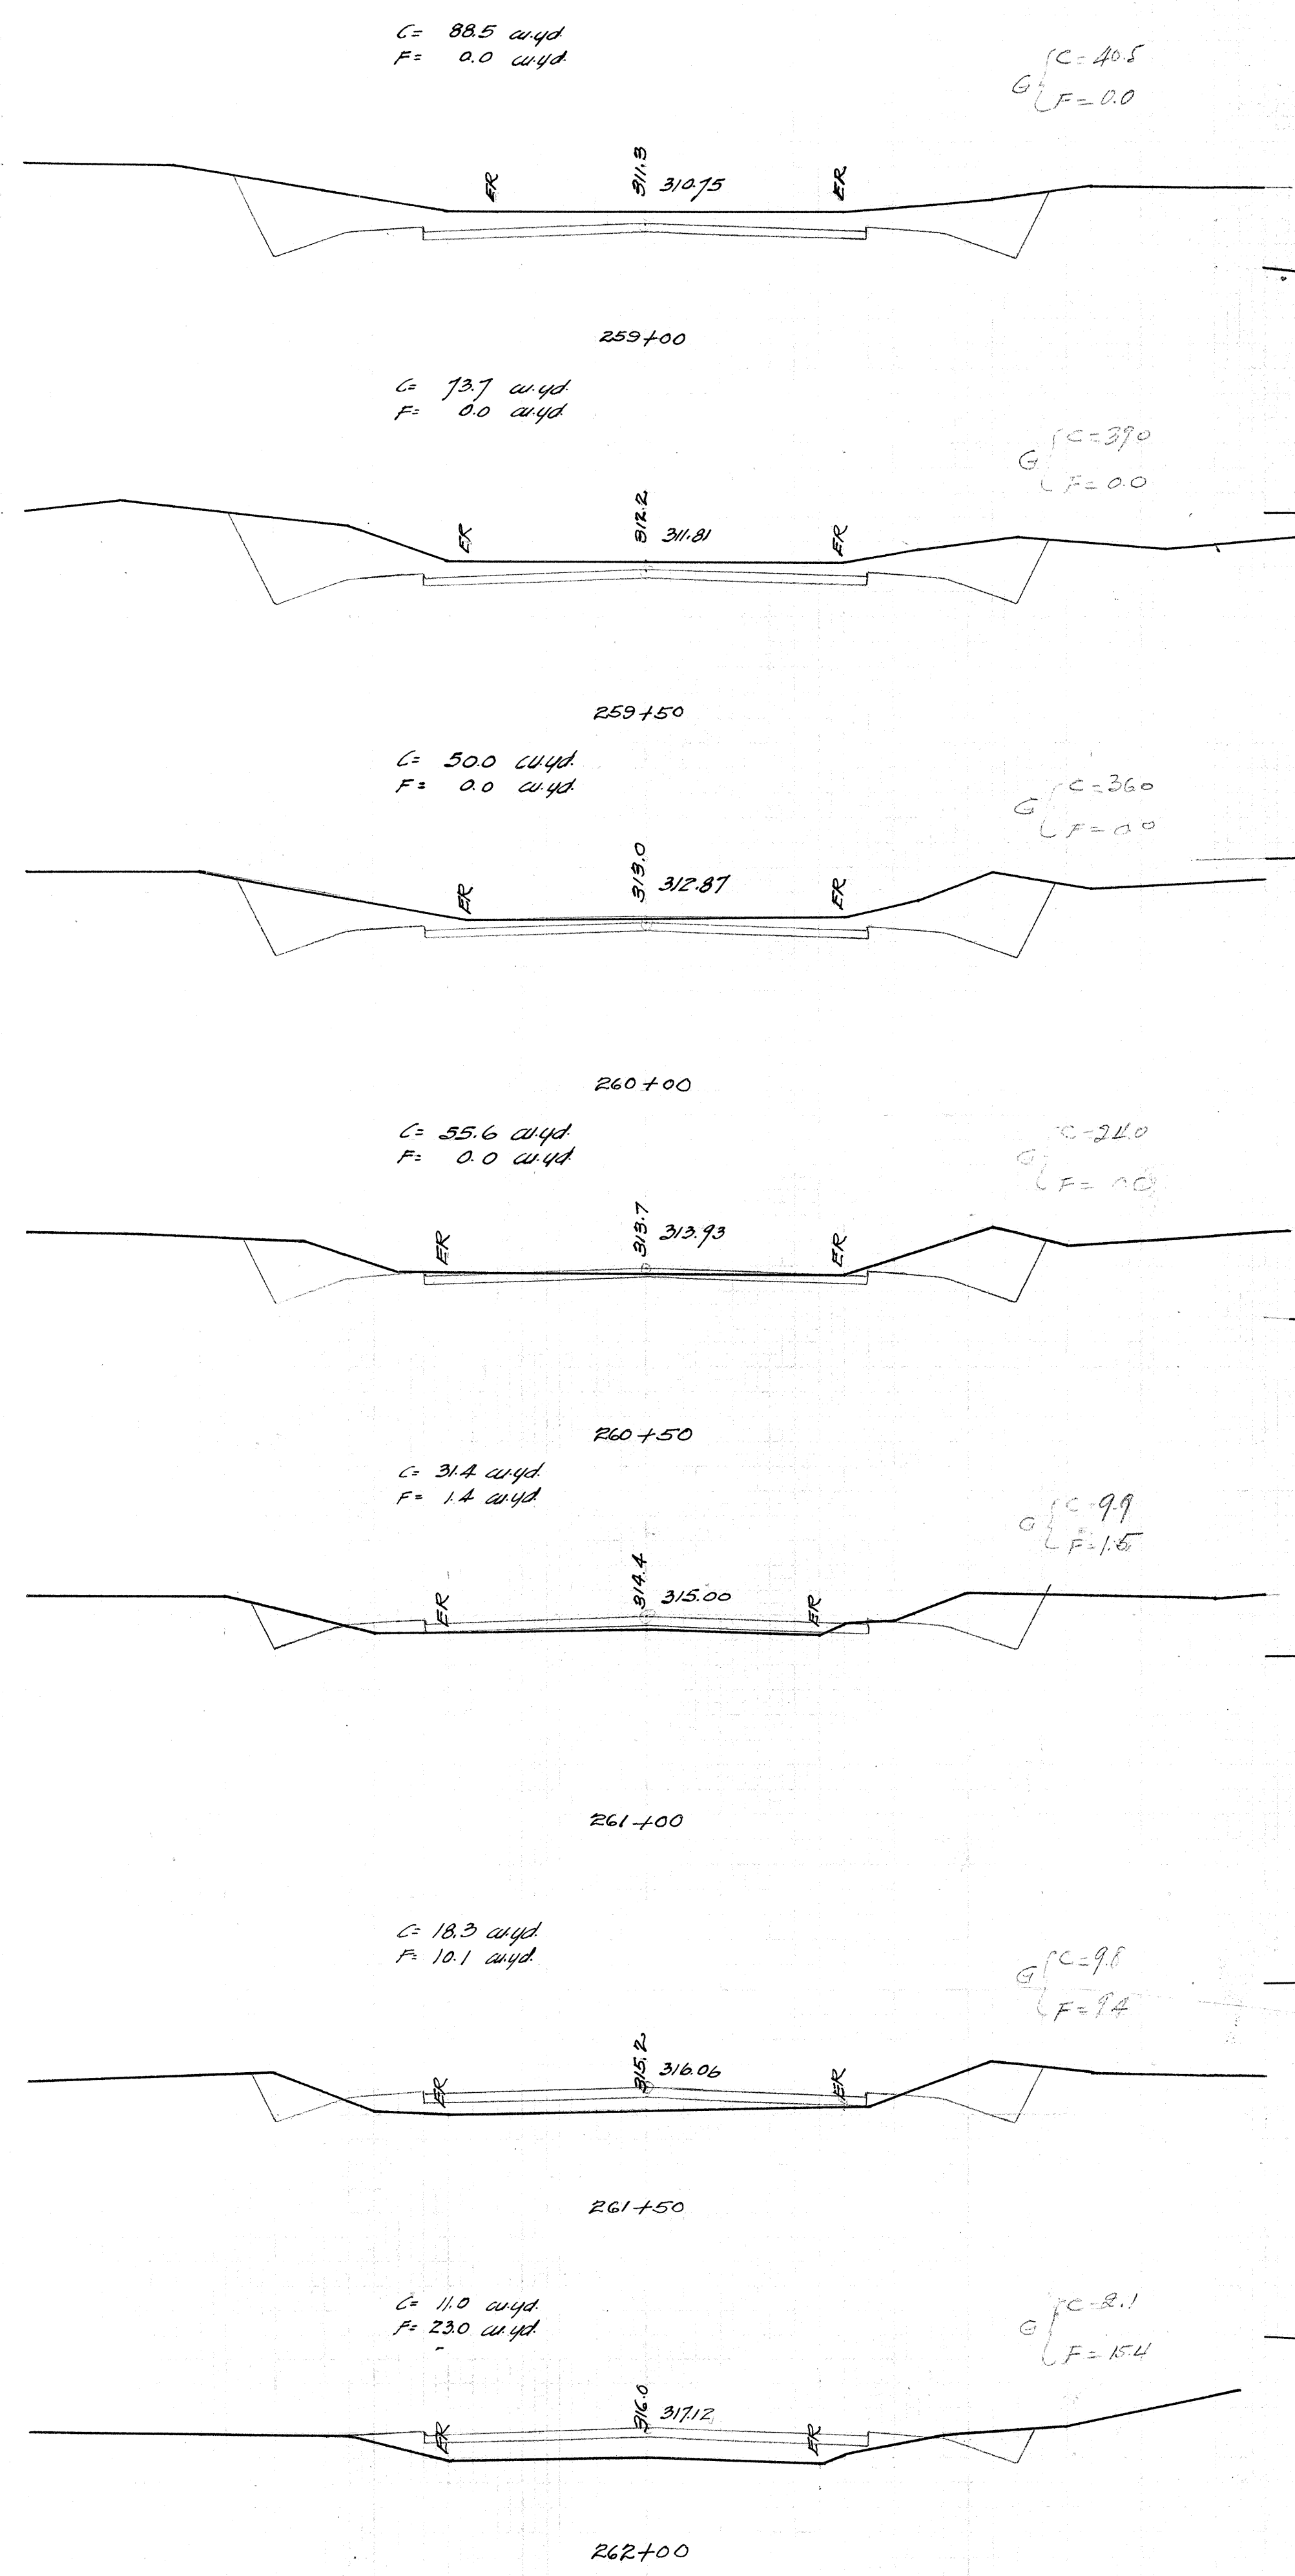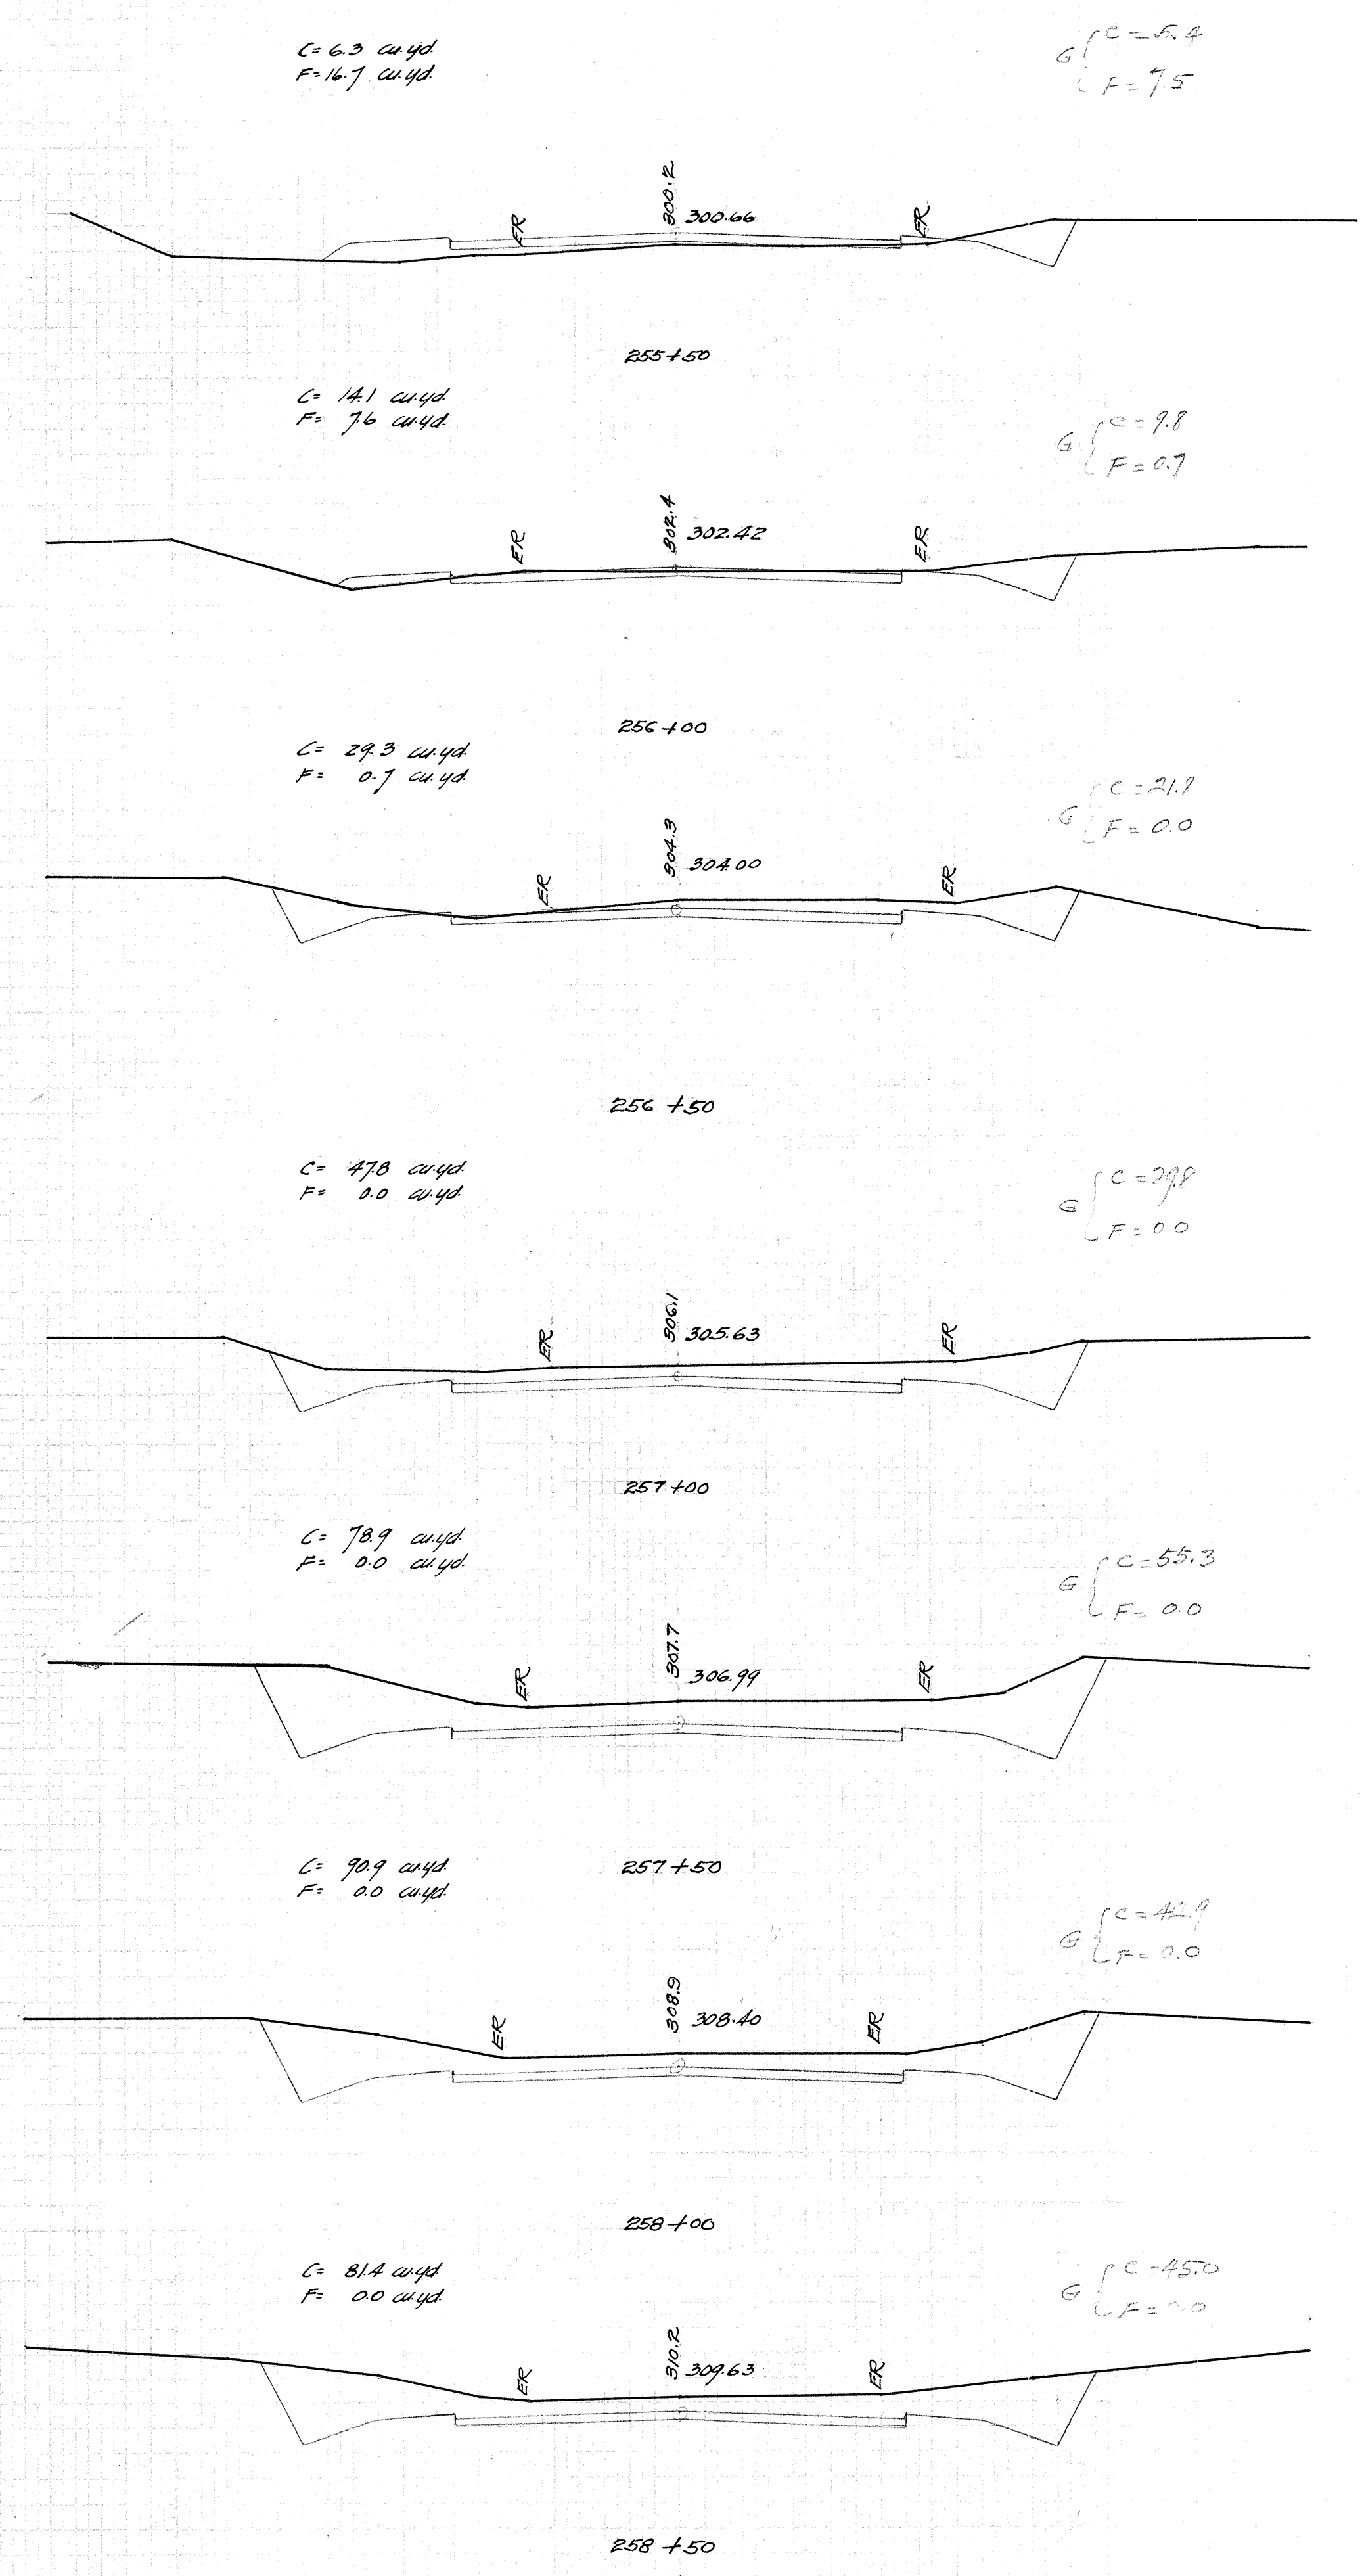

4188.13

Plan No	Sheet No	Folder No	Plan No
6	13	2	

