


FED. ROAD DIST. NO.	STATE	FED. AID PROJ. NO.	FISCAL YEAR	SHEET NO.	TOTAL SHEETS
HAW	HAW	5-D	1931	3	14

ALB, DL
11/14/31
12/1/31

Revised Mar-3-1931 to show Right of Way line


May 30

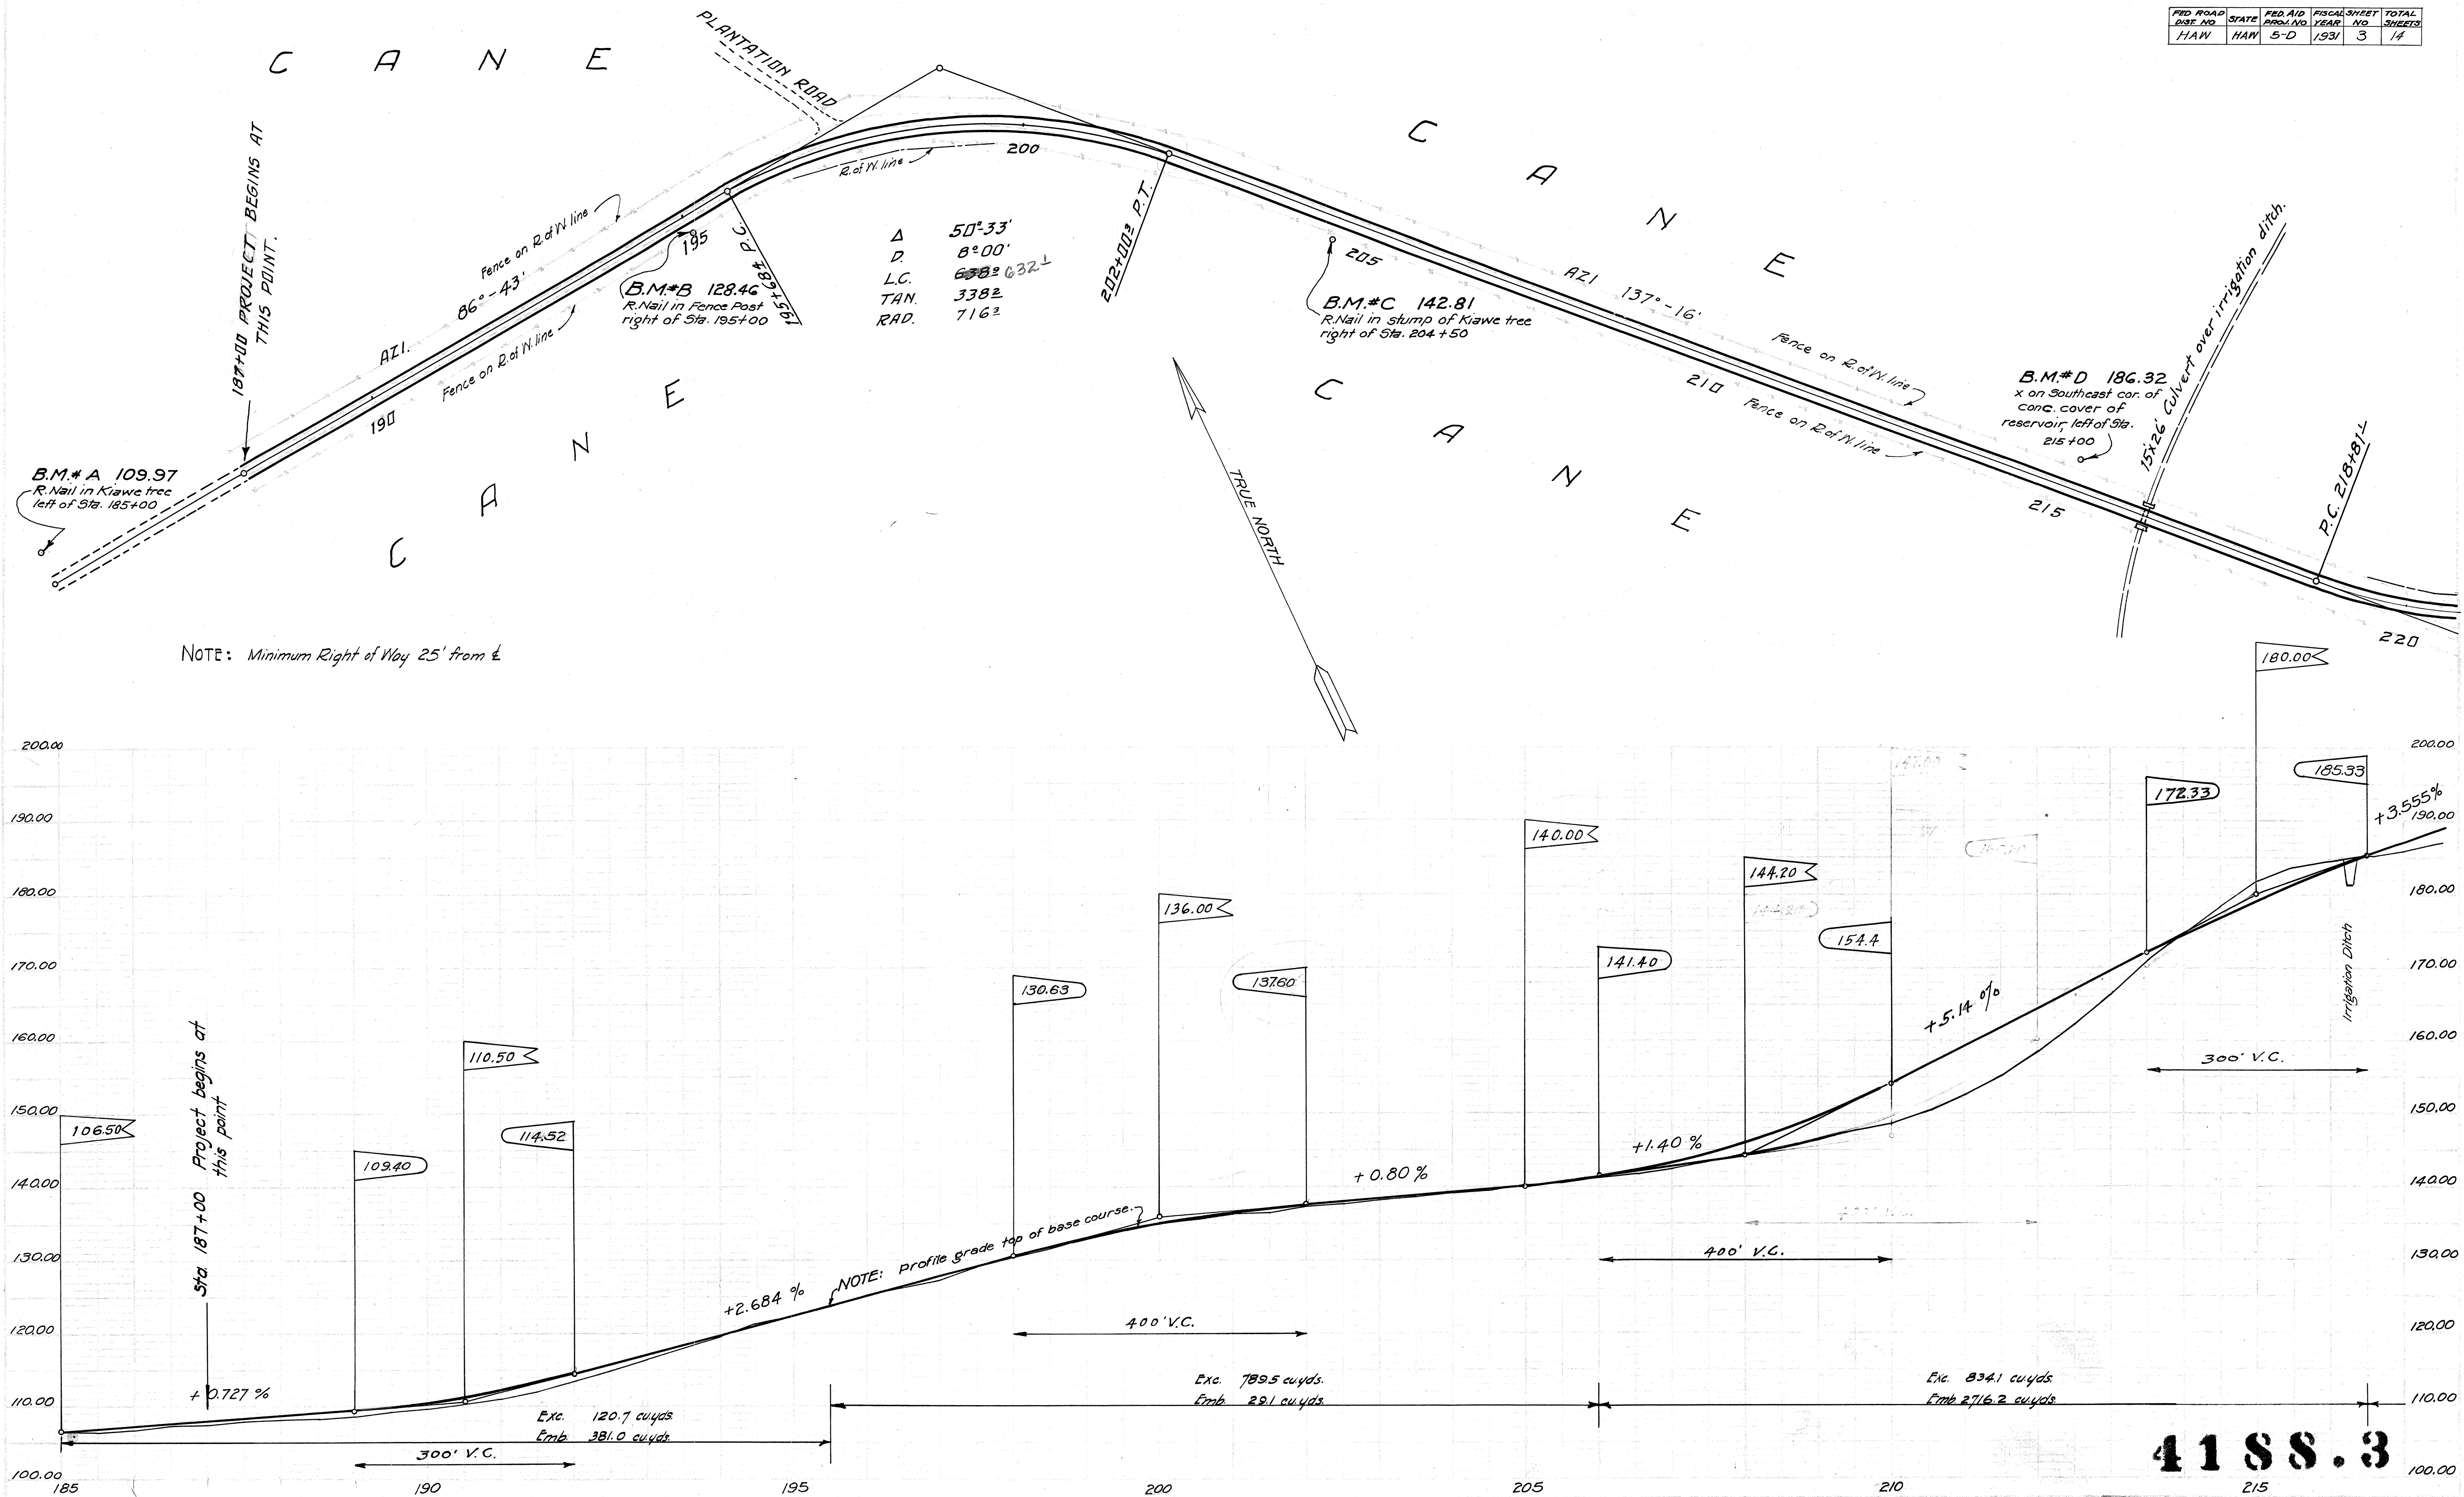


Plan File No.	Project No.	Folder No.	Sheet No.
6	15	2	

FED. ROAD DIST. NO.	STATE	FED. AID PROJ. NO.	FISCAL YEAR	SHEET NO.	TOTAL SHEETS
HAW	HAW	5-D	1931	4	14

ALB: D.L.
1/17/31
ALB.
May 80

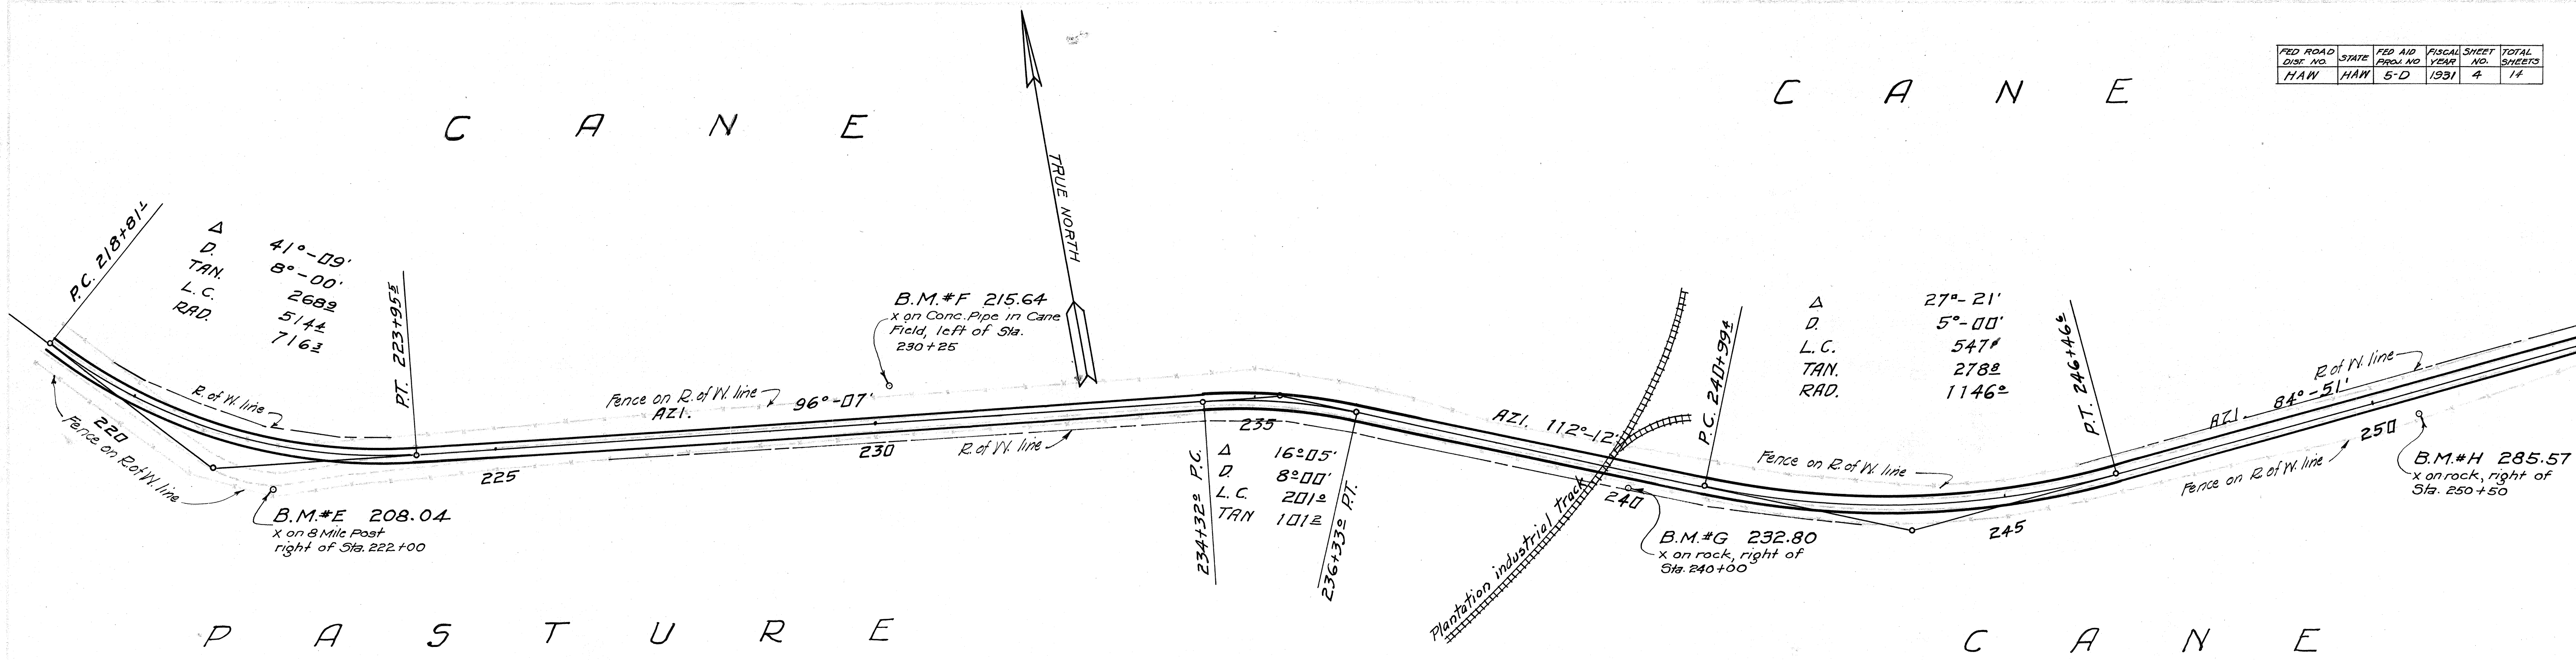

Revised Mar. 3, 1931 to show Right of Way line

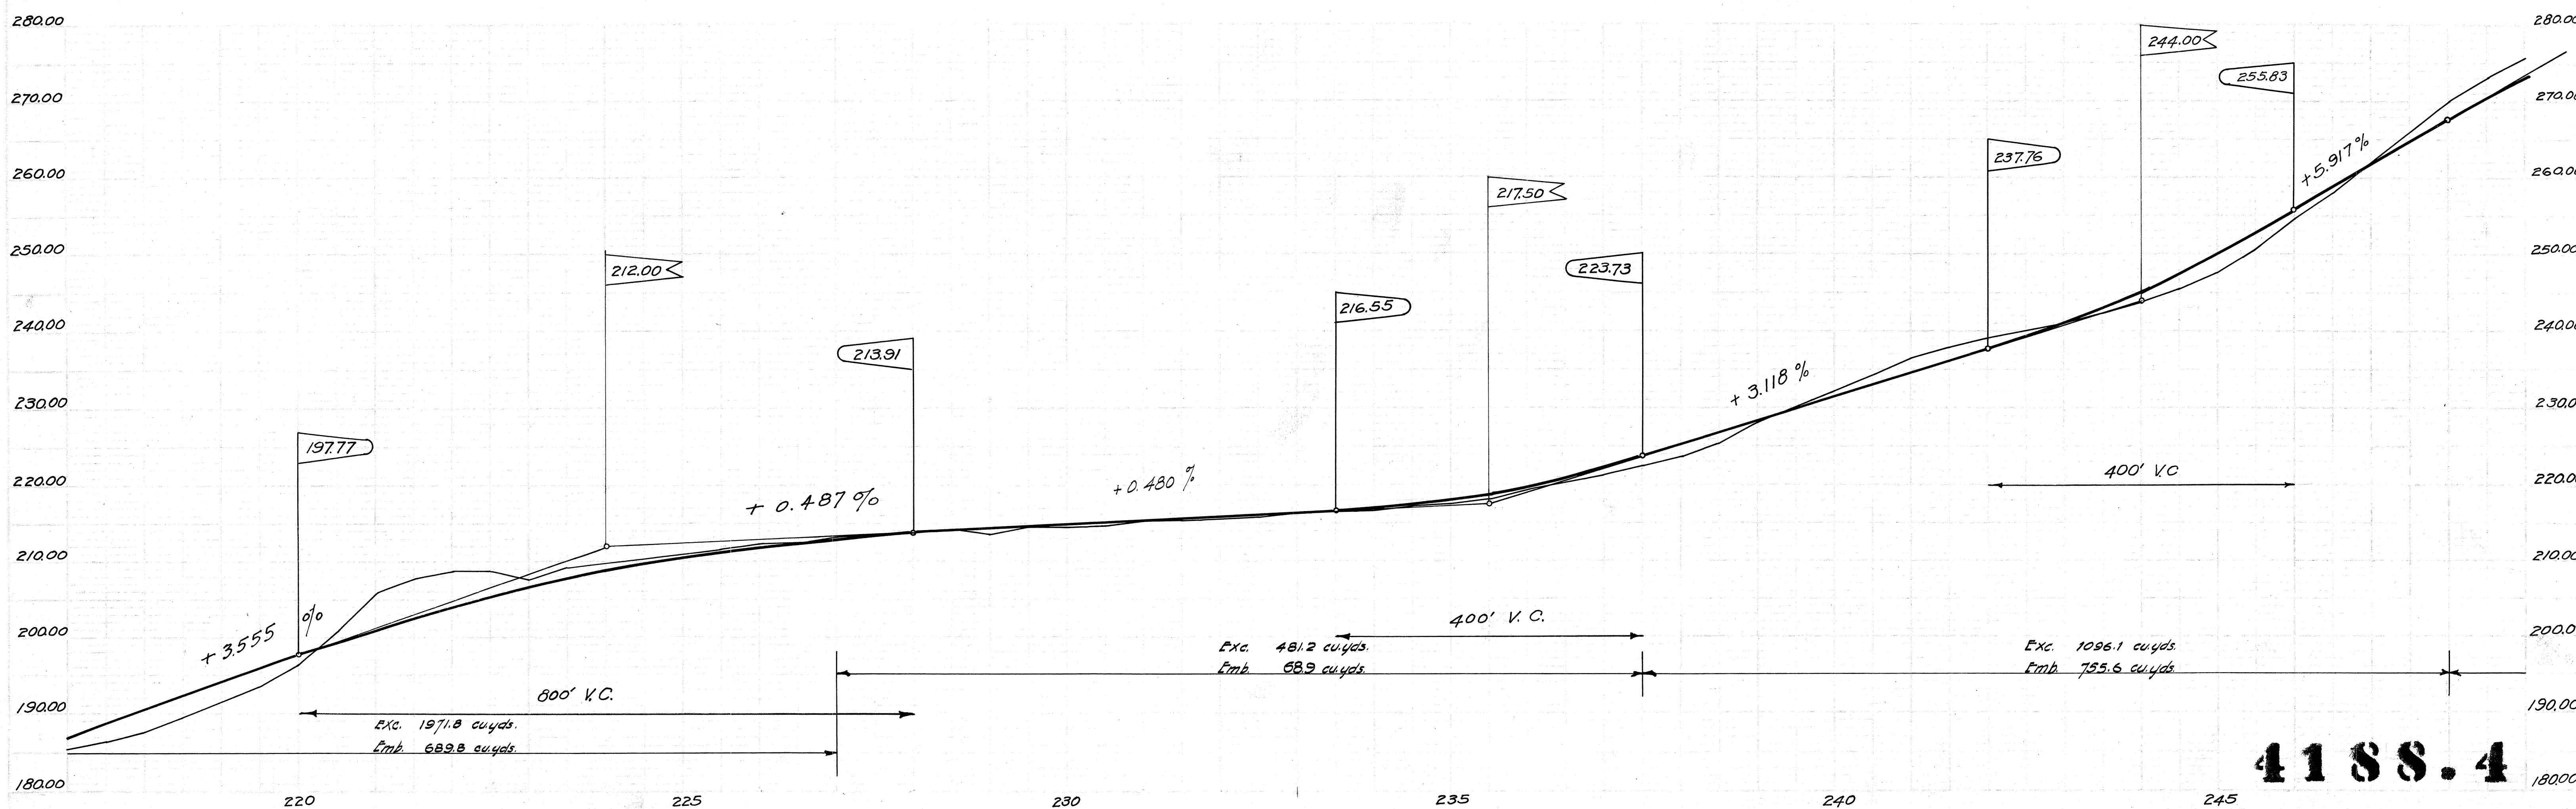

4188.4

Plan File No.	Profile No.	Folder No.	Sheet No.
6	15	2	

1/17/31
1/21/31

ALB:DL.
ALB

Revised Mar. 3, 1931 to show Right of Way line

4188.5

Plan File	Pocket	Folder	Plan
No. 6	No. 15	No. 2	No.