



FED. ROAD DIST. NO.	STATE	FED. AID PROJ. NO.	FISCAL YEAR	SHEET NO.	TOTAL SHEETS
HAWAII	HAW	E-5-E	1932	3	11

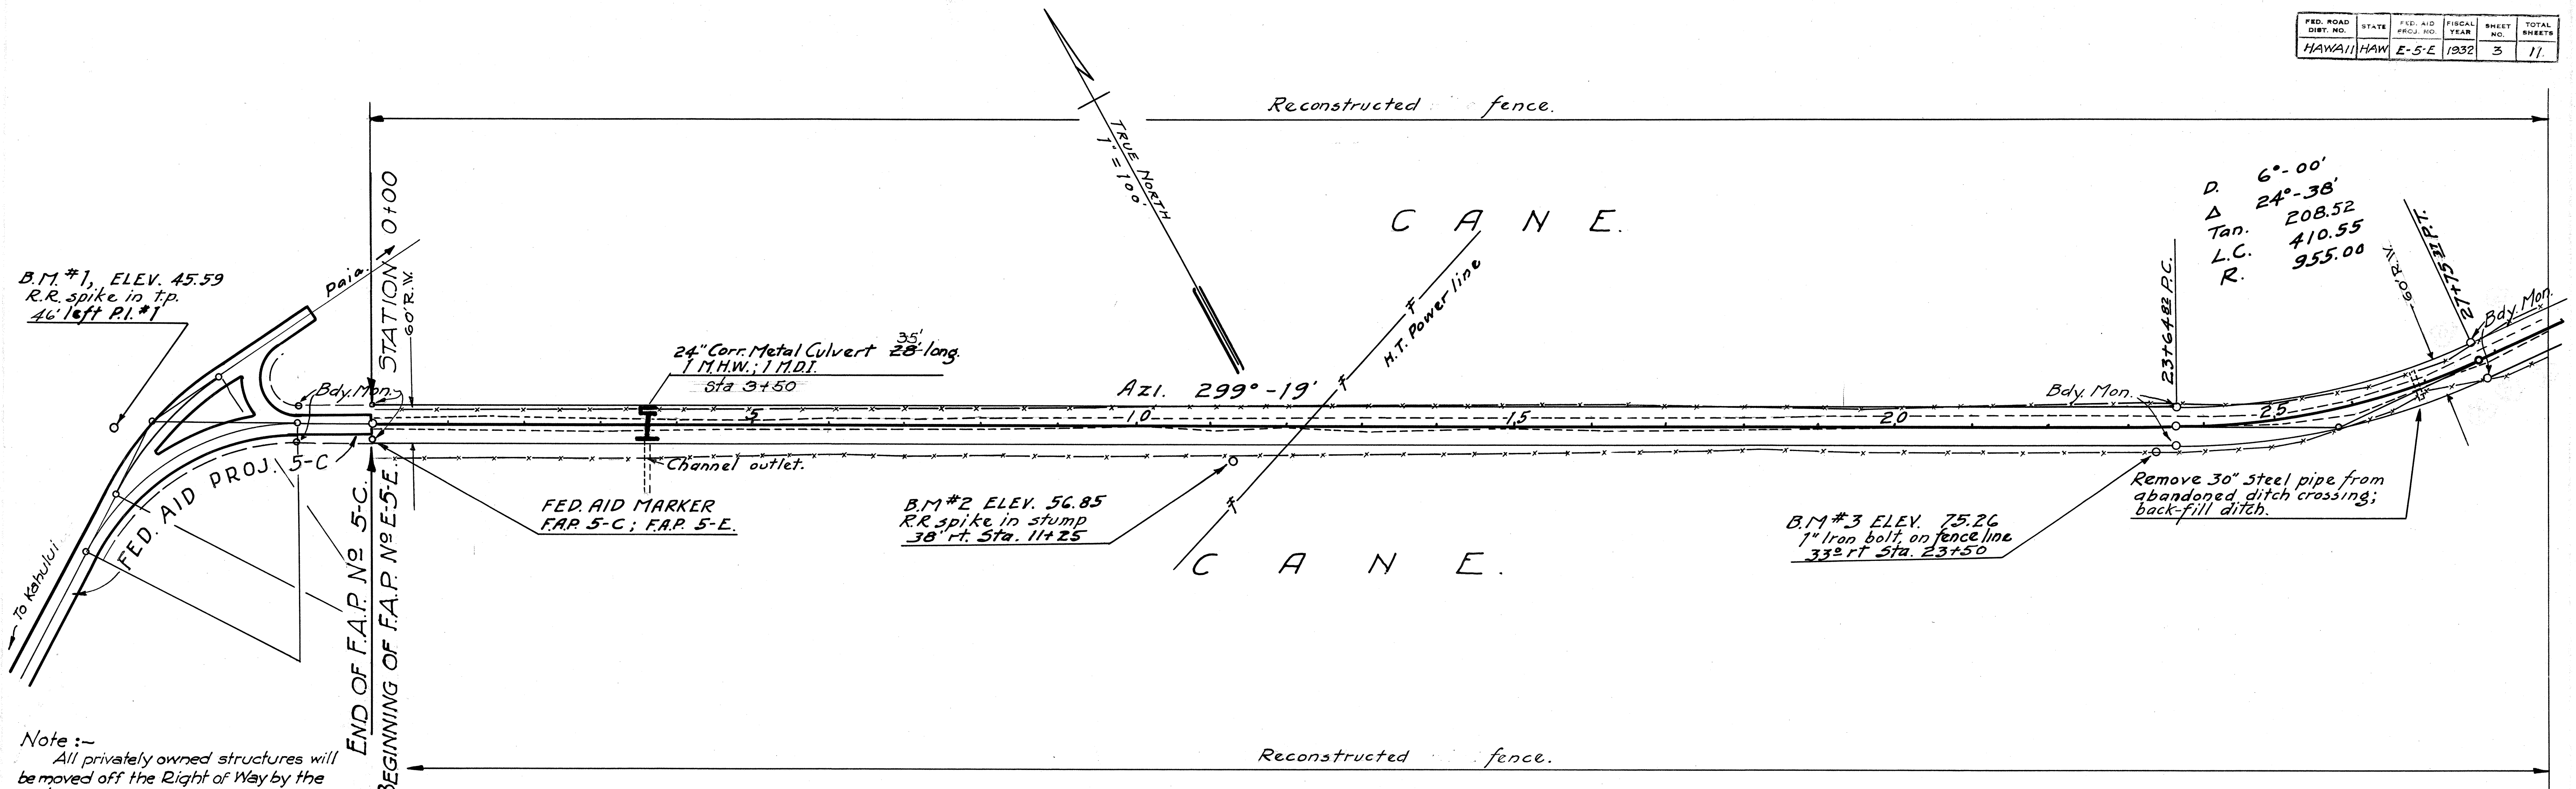

Note :-
All privately owned structures will be removed off the Right of Way by the Gov't. or under Extra Work Order.




Note :- Plans prepared with 50' R/W.
This revised to 60' and will be secured during construction. Final payment not to be made by U.S.B.P.R. until & unless 60' R/W. secured.
Plans worded 60' and scale 50'.

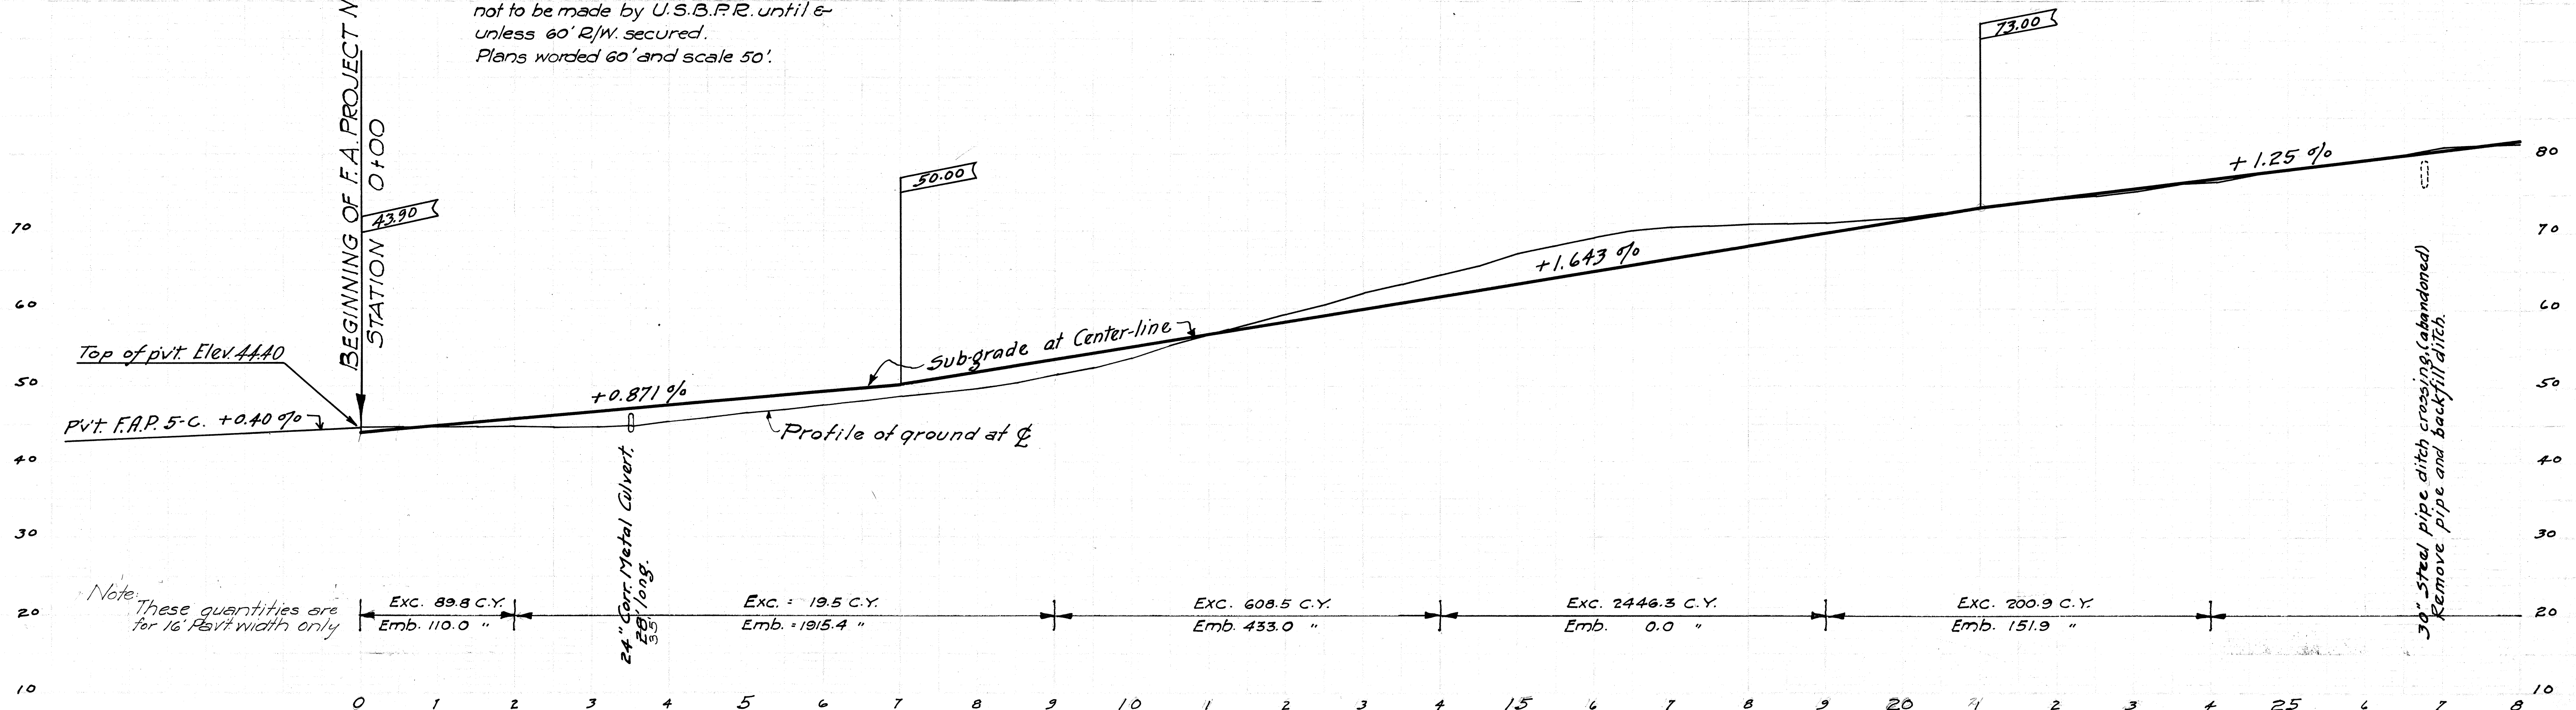

Revised 10-24-32 for 18' Pavement JCM

4272.3




FED. ROAD DIST. NO.	STATE	FED. AID PROJ. NO.	FISCAL YEAR	SHEET NO.	TOTAL SHEETS
HAWAII	HAW	E-5-E	1932	4	11

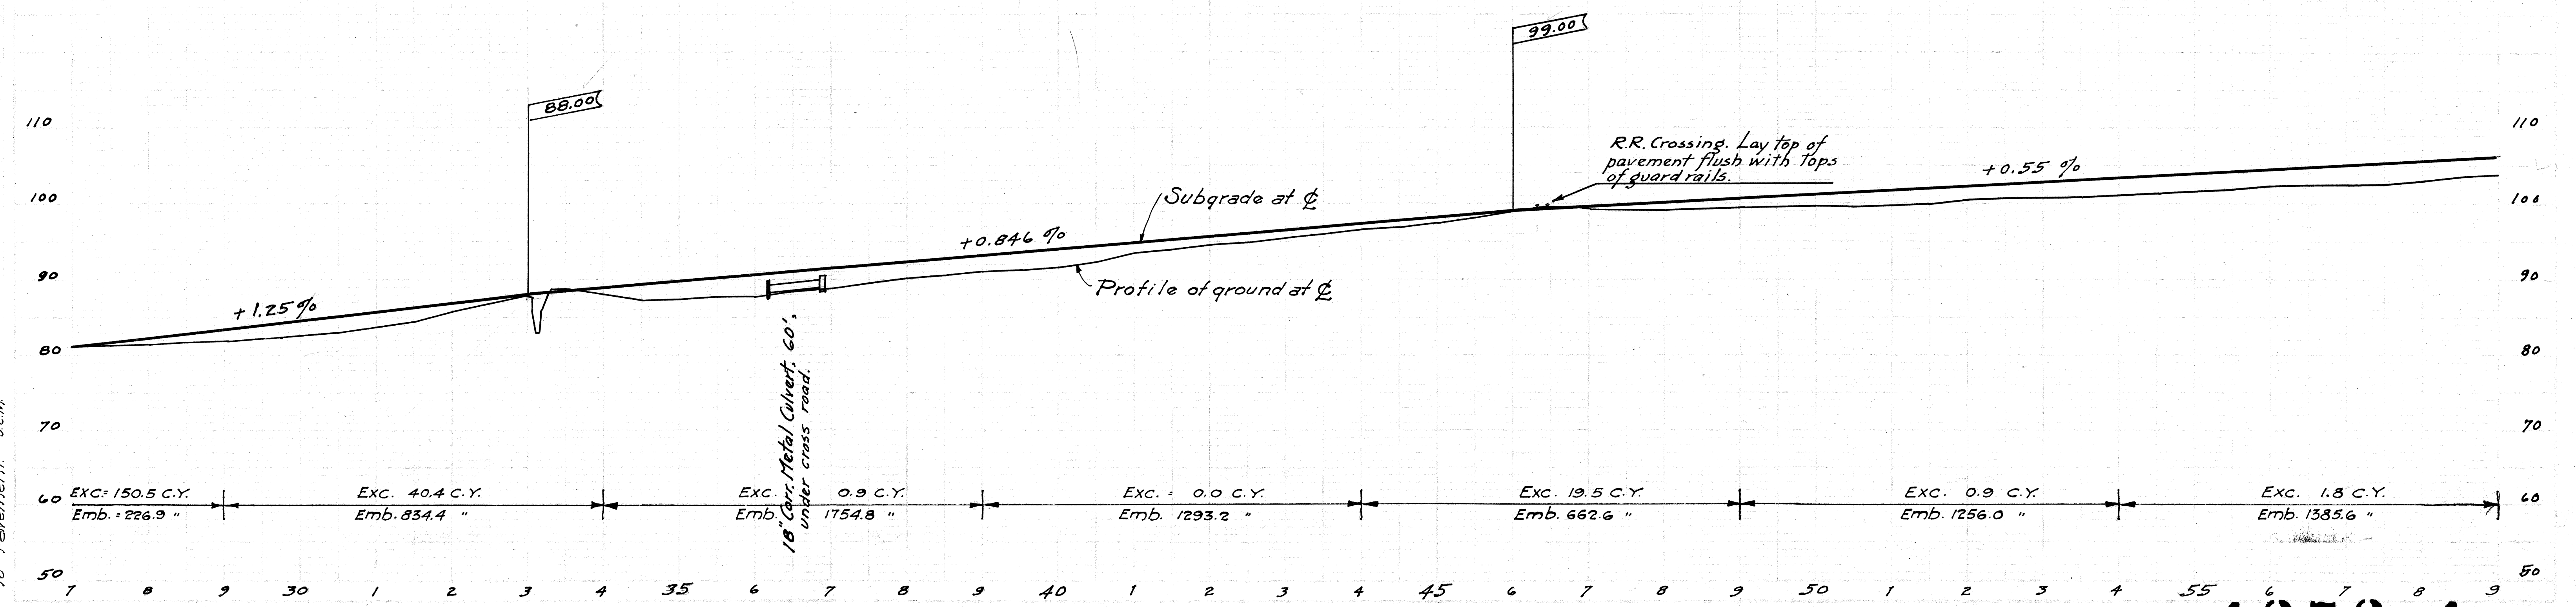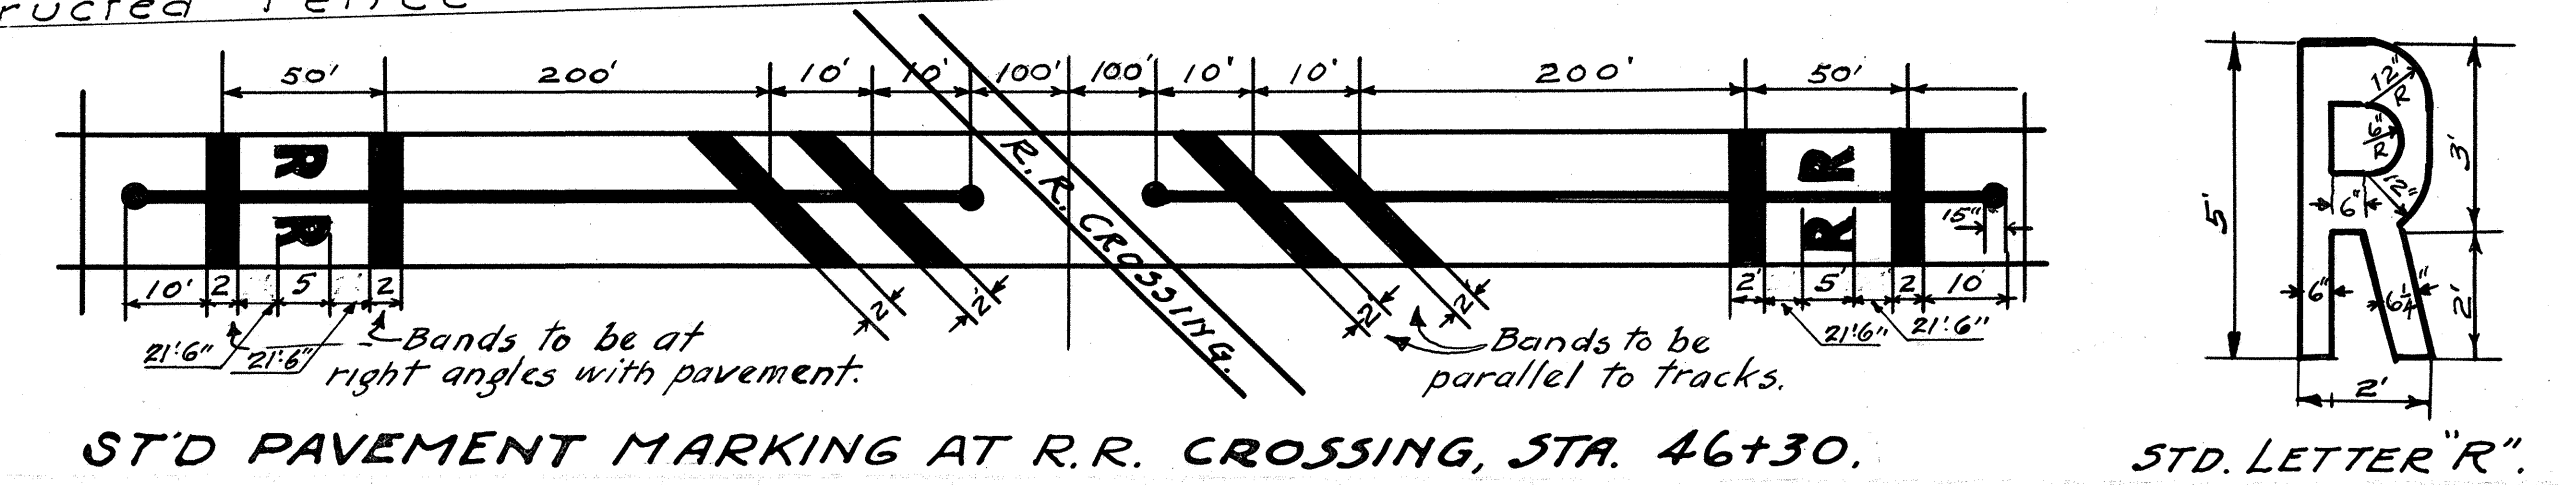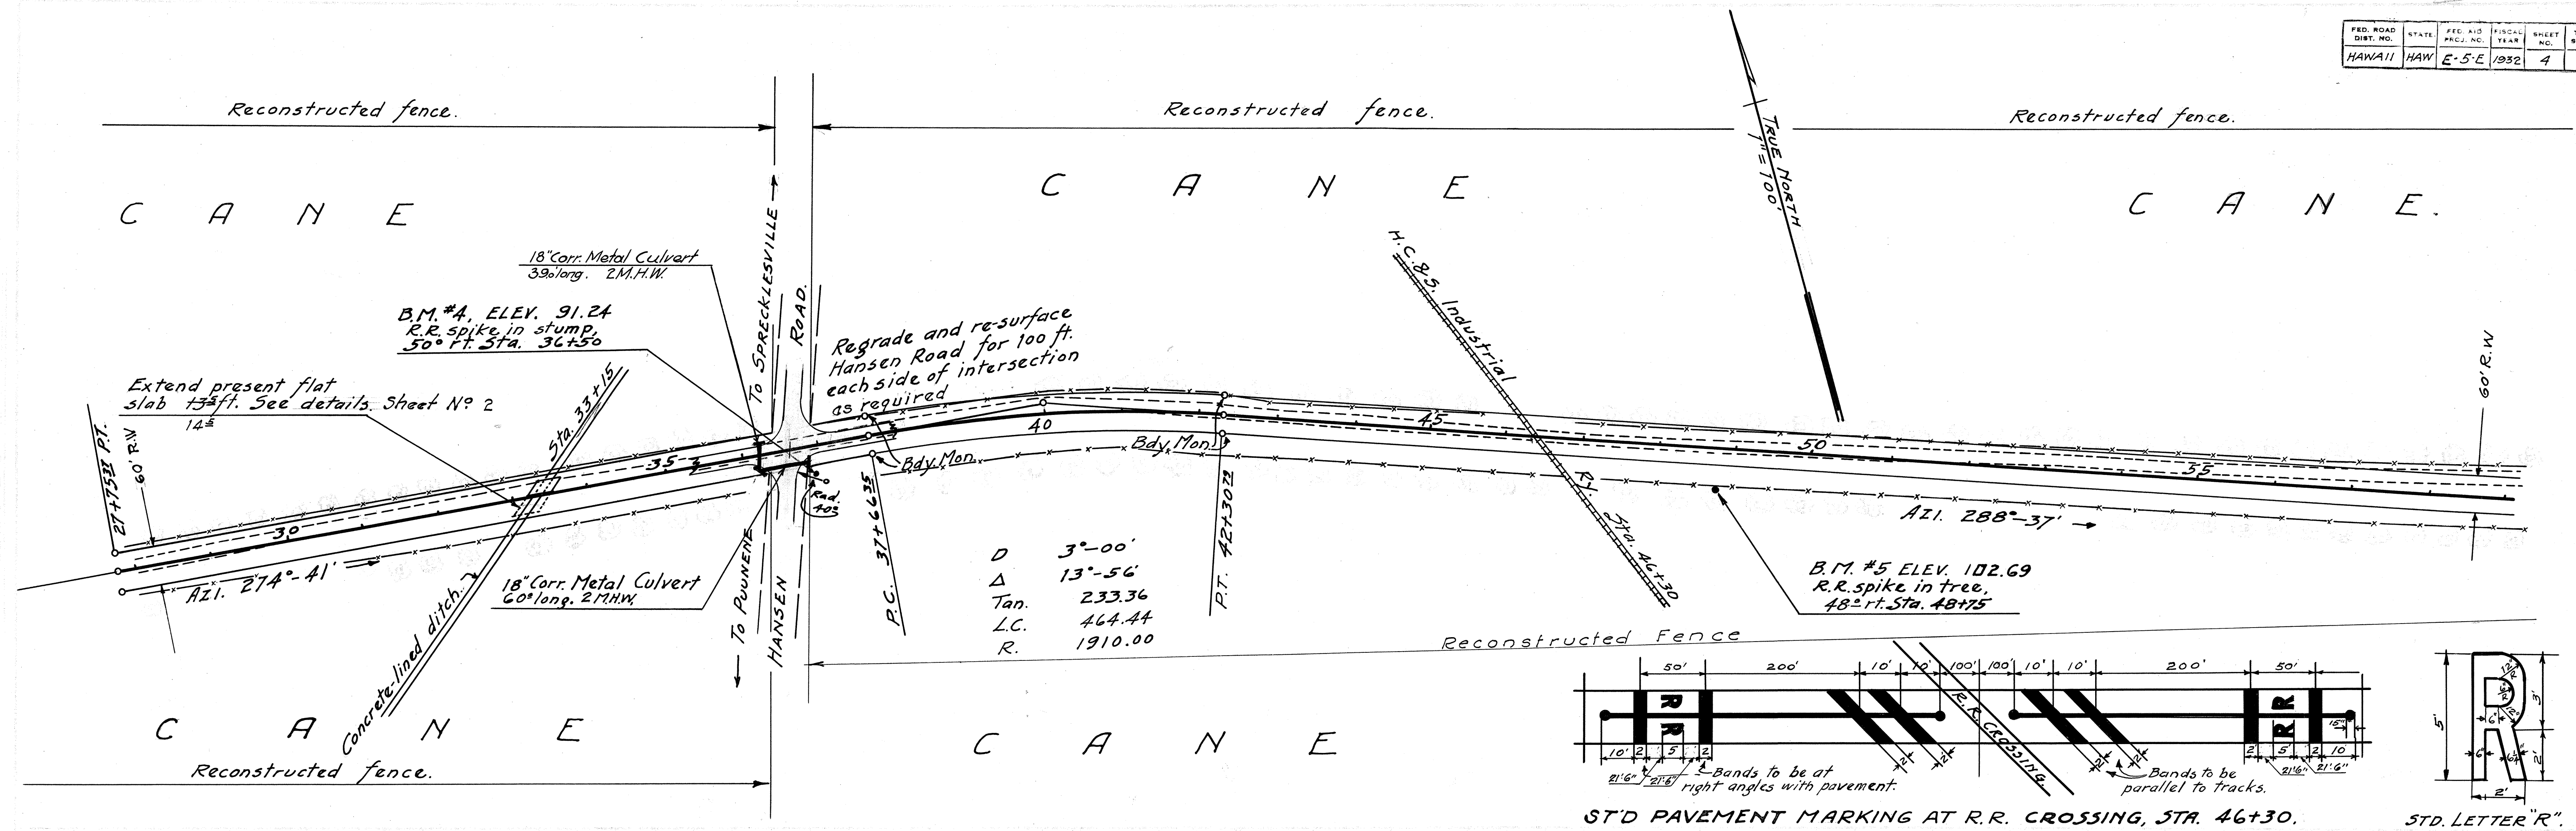

Revised 10-24-32 for 18' Element J.C.M.

4272.4

FED. ROAD DIST. NO.	STATE	FED. AID PRCJ. NO.	FISCAL YEAR	SHEET NO.	TOT. SHEET
HAWAII	HAW	E-5-E	1932	5	11

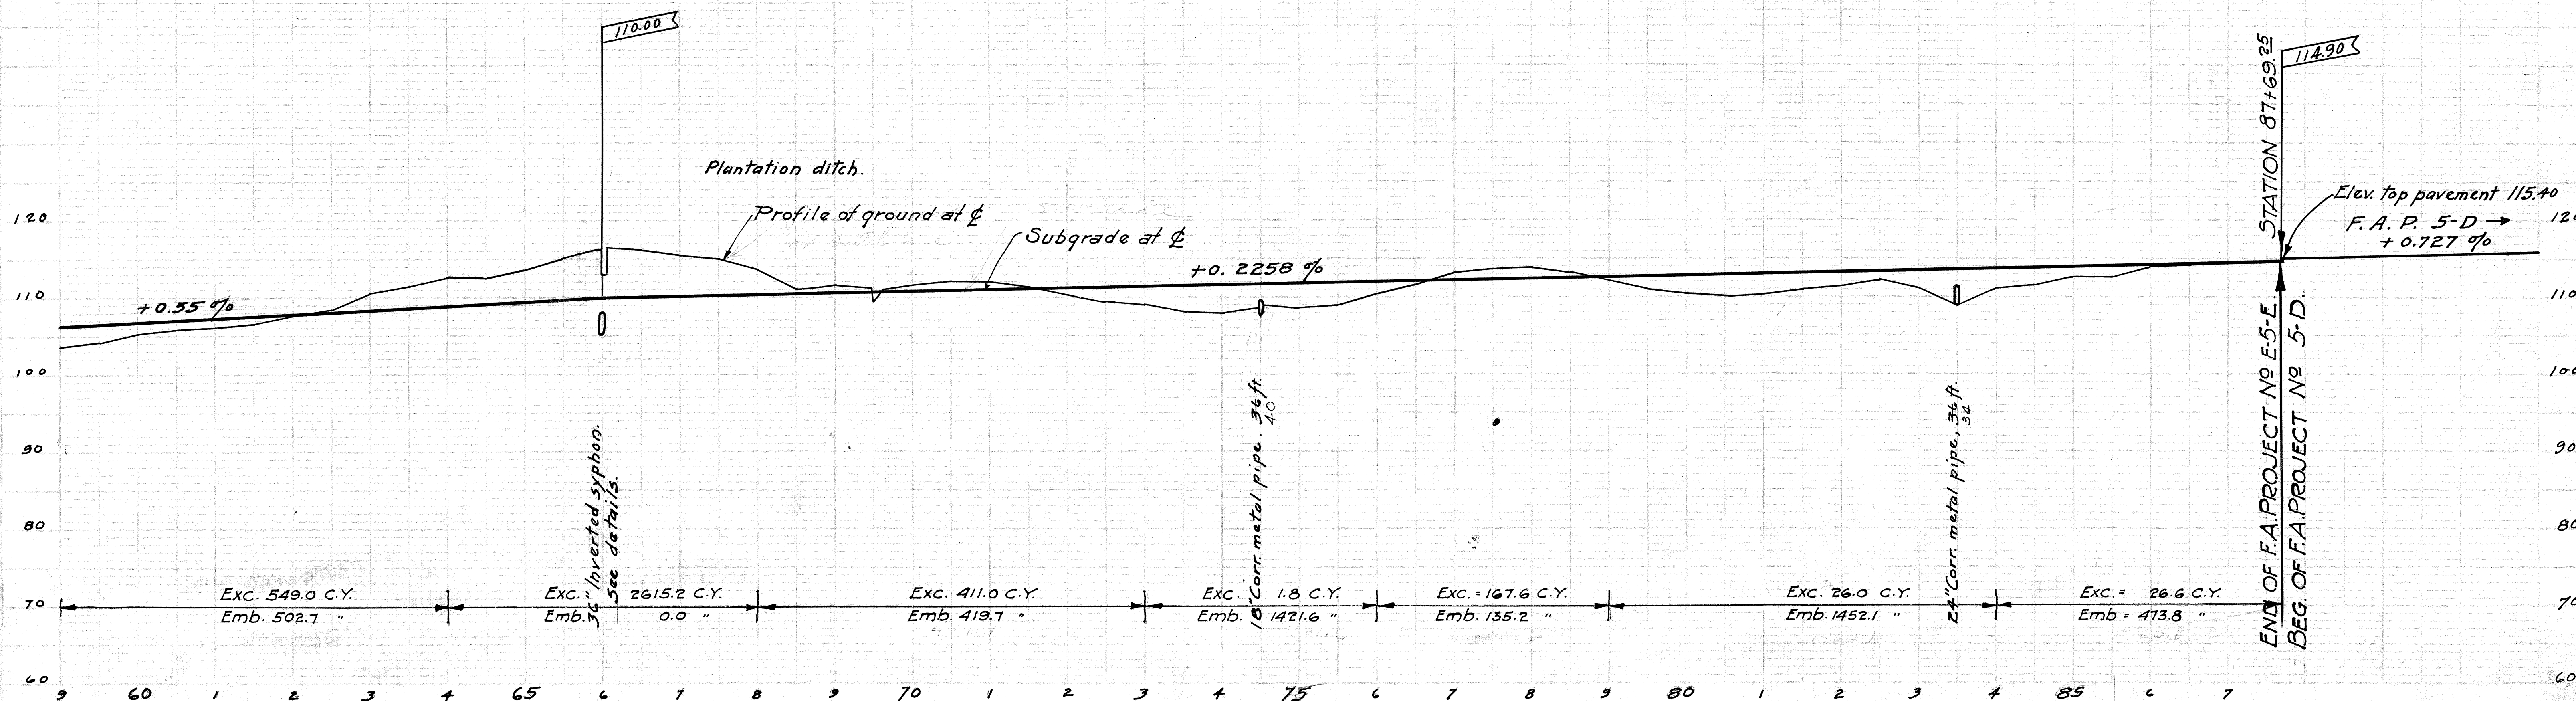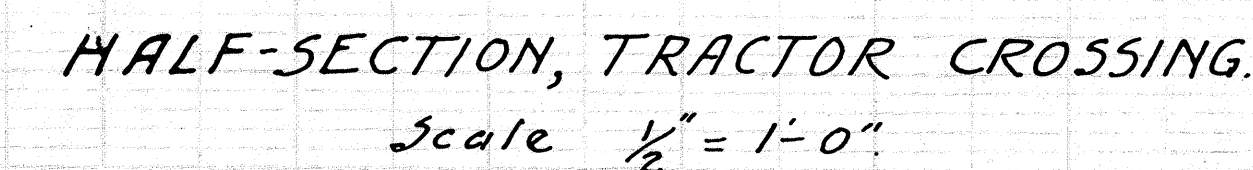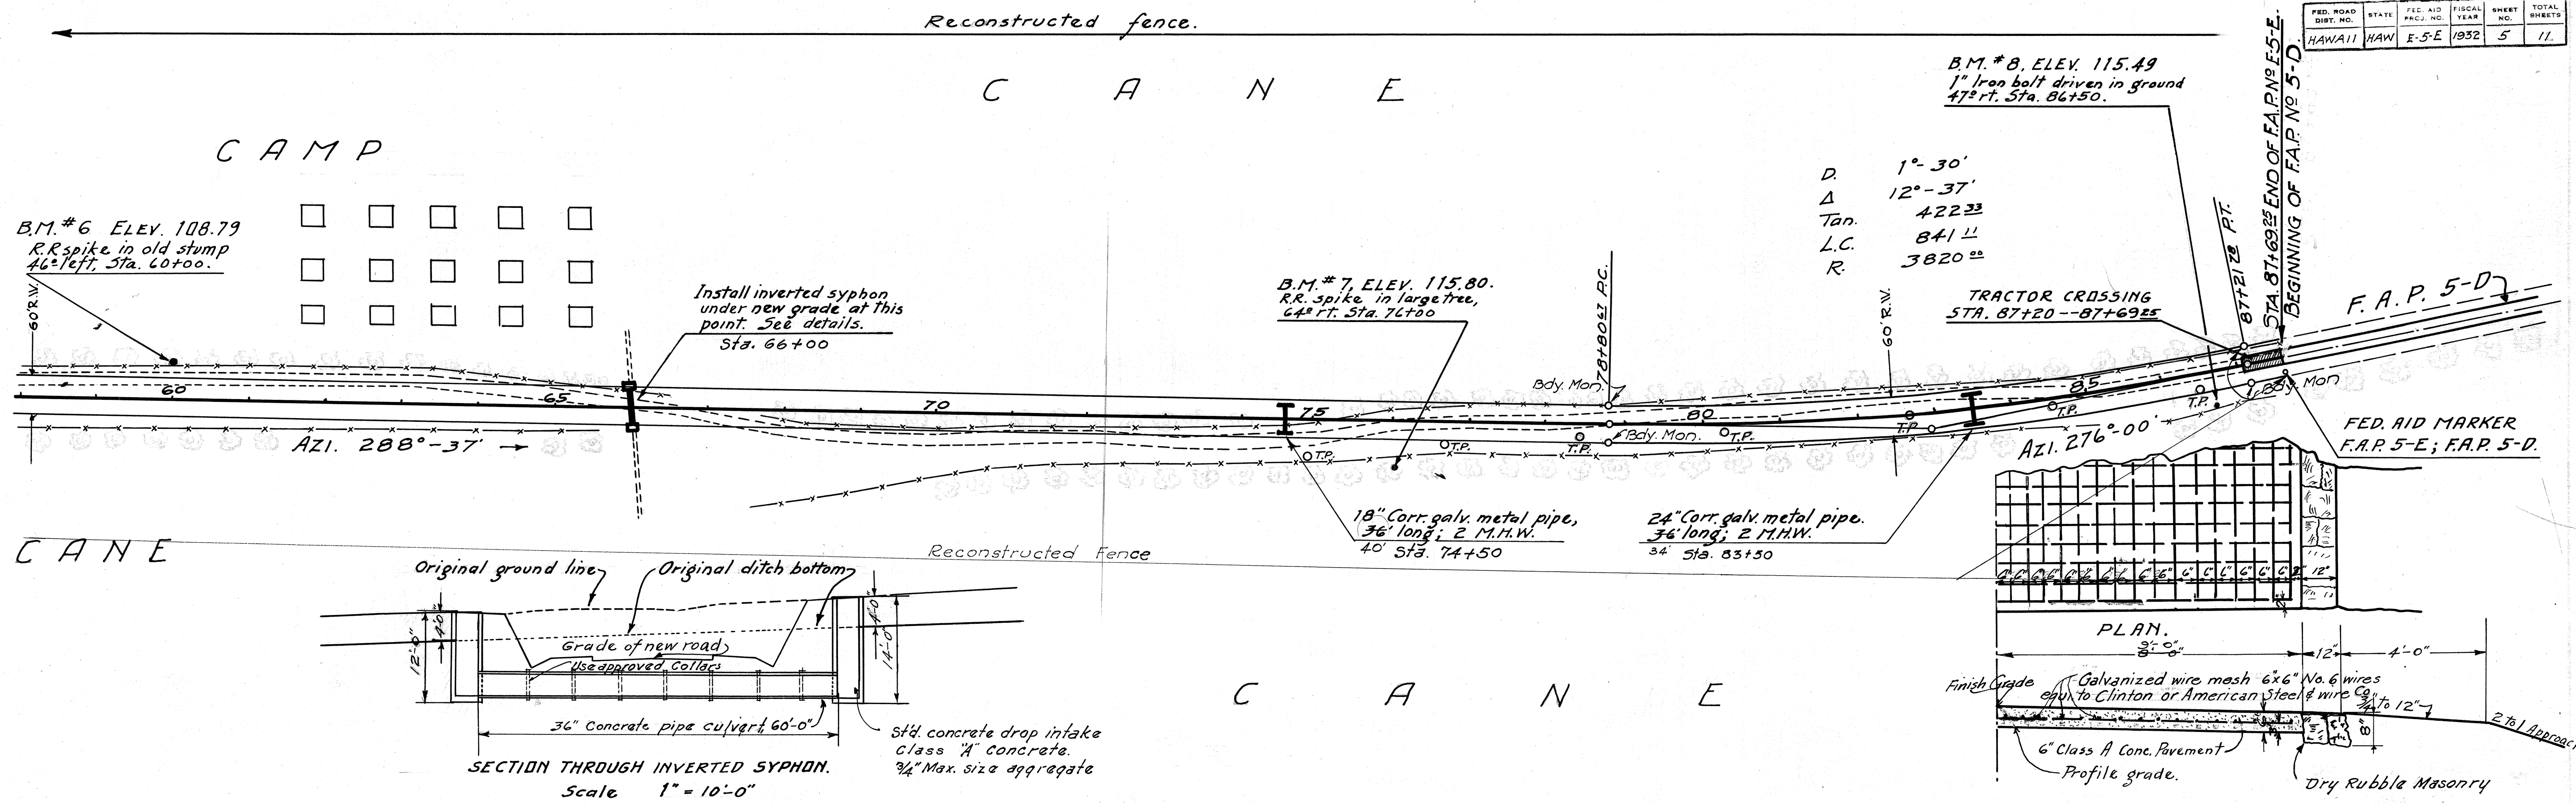

4272.5

Revised 10-24-32 for
18' Pavement J.C.M.