
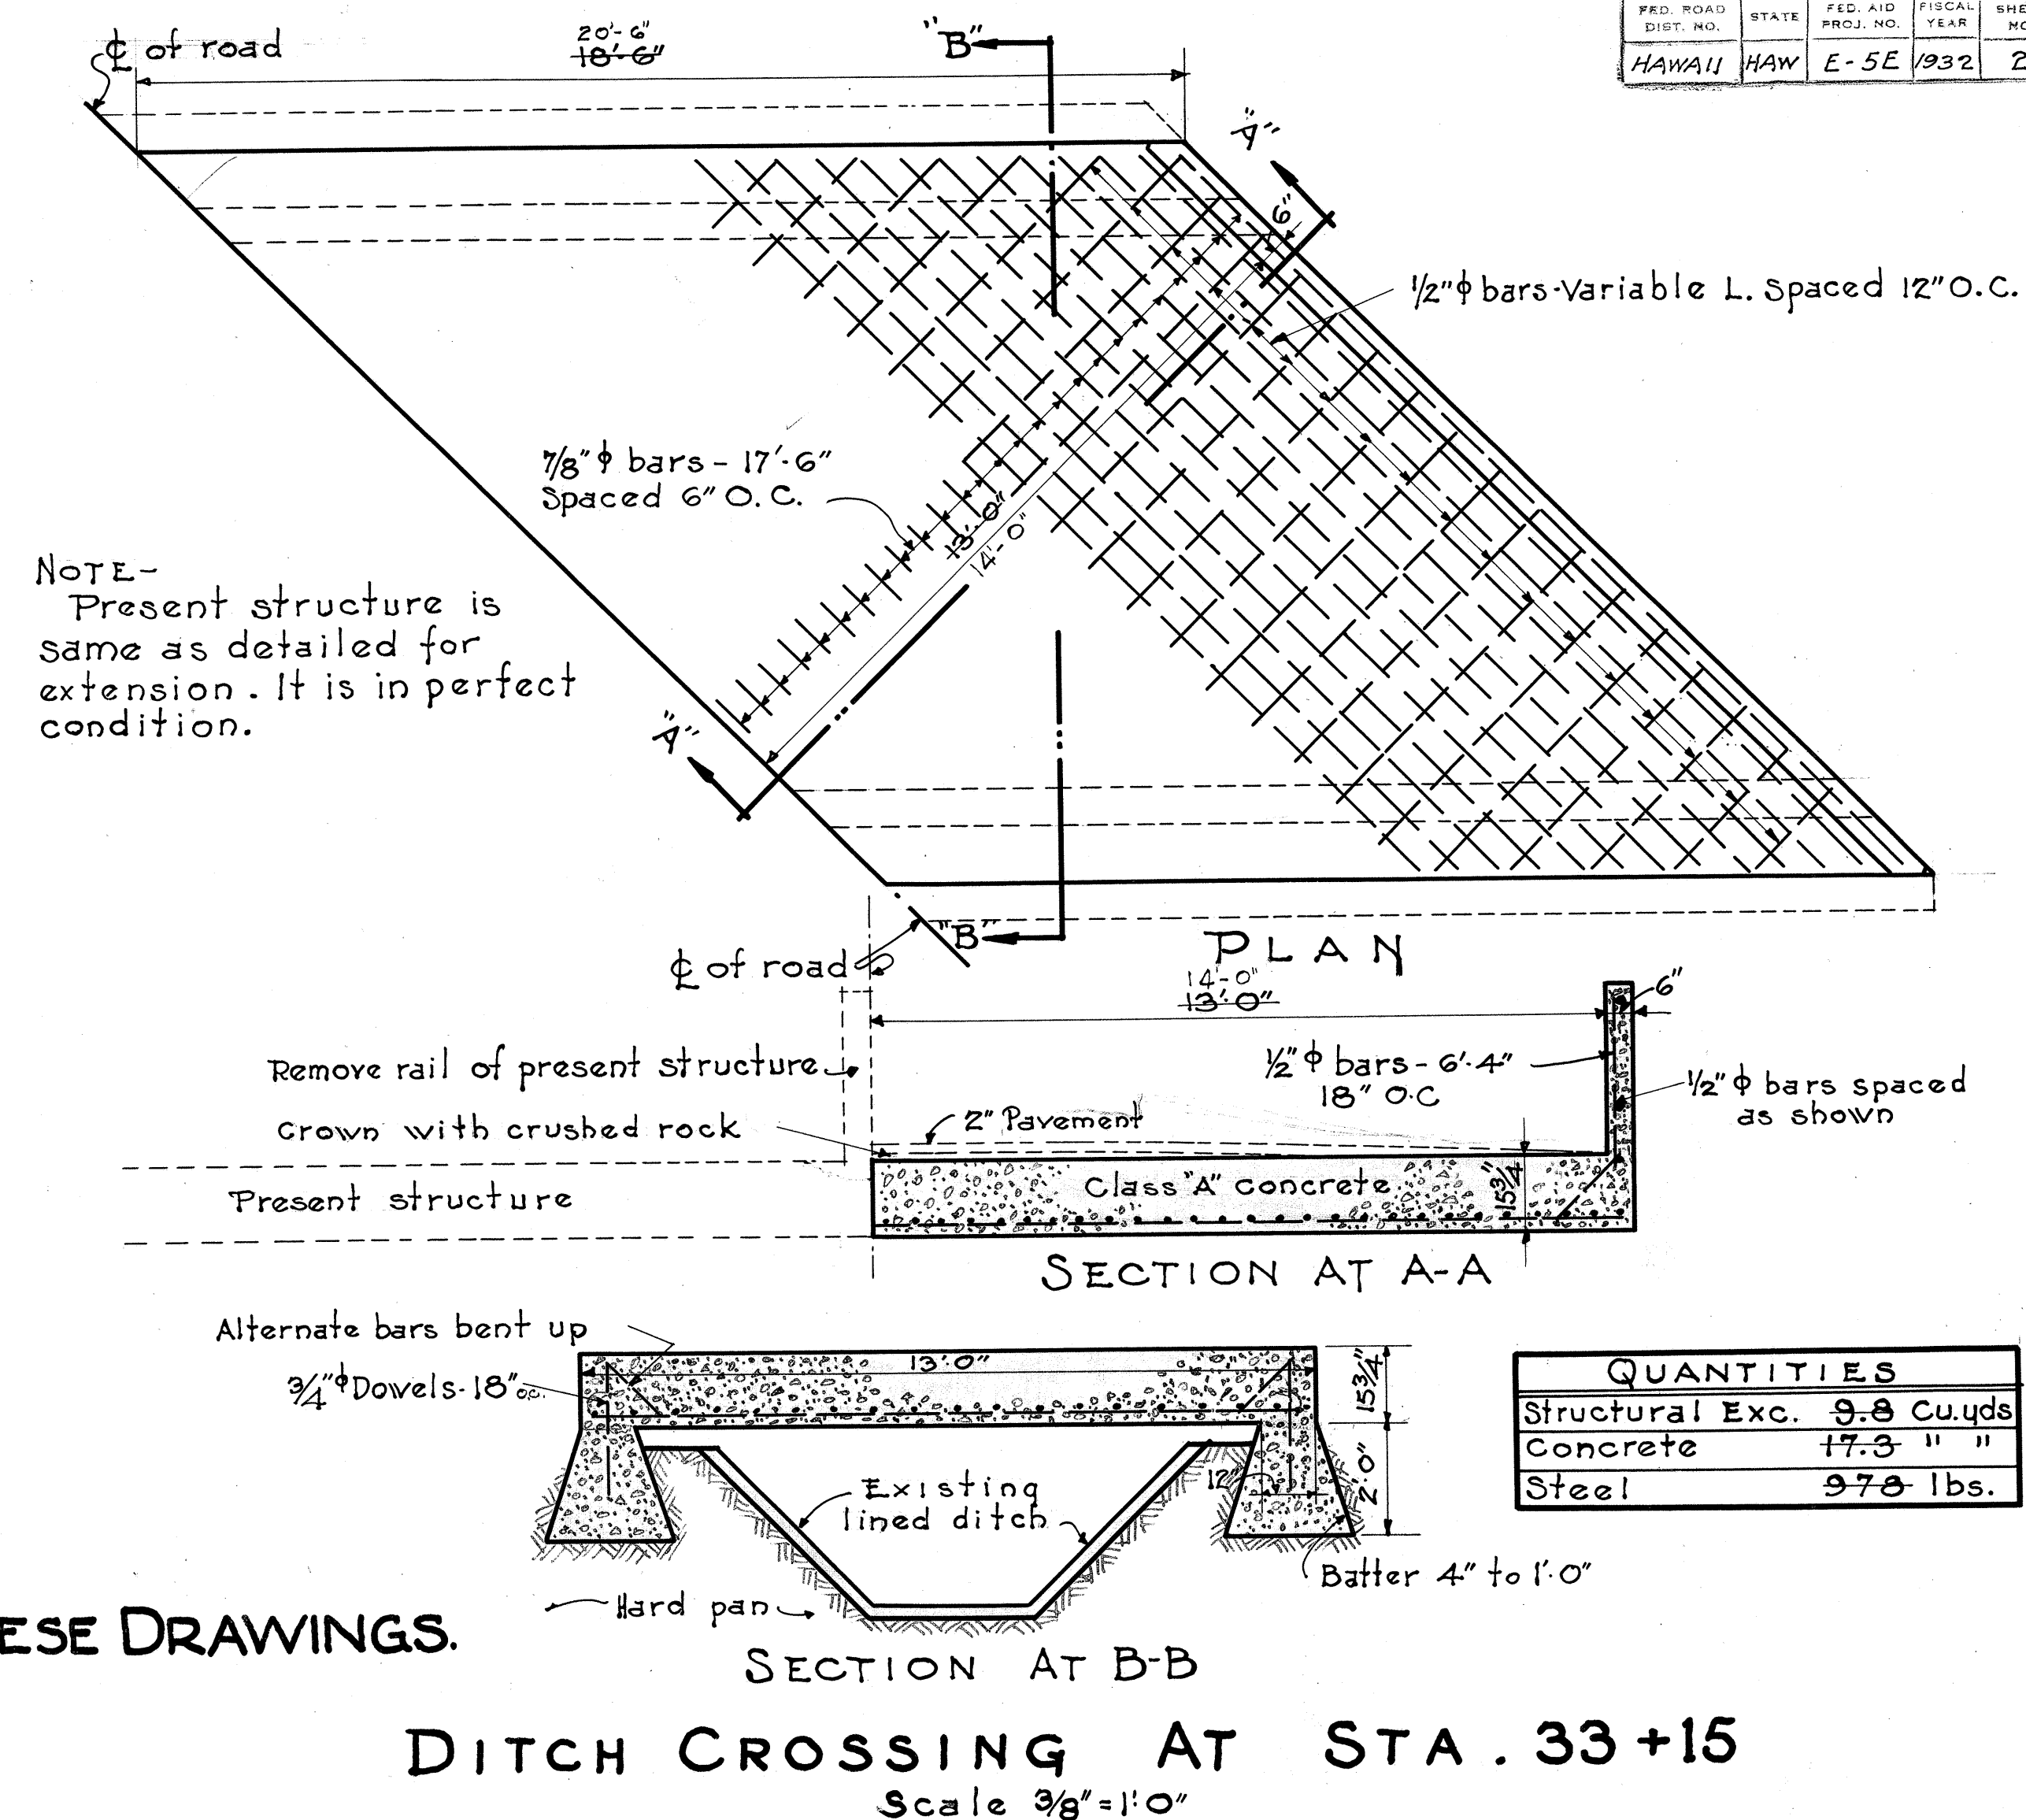


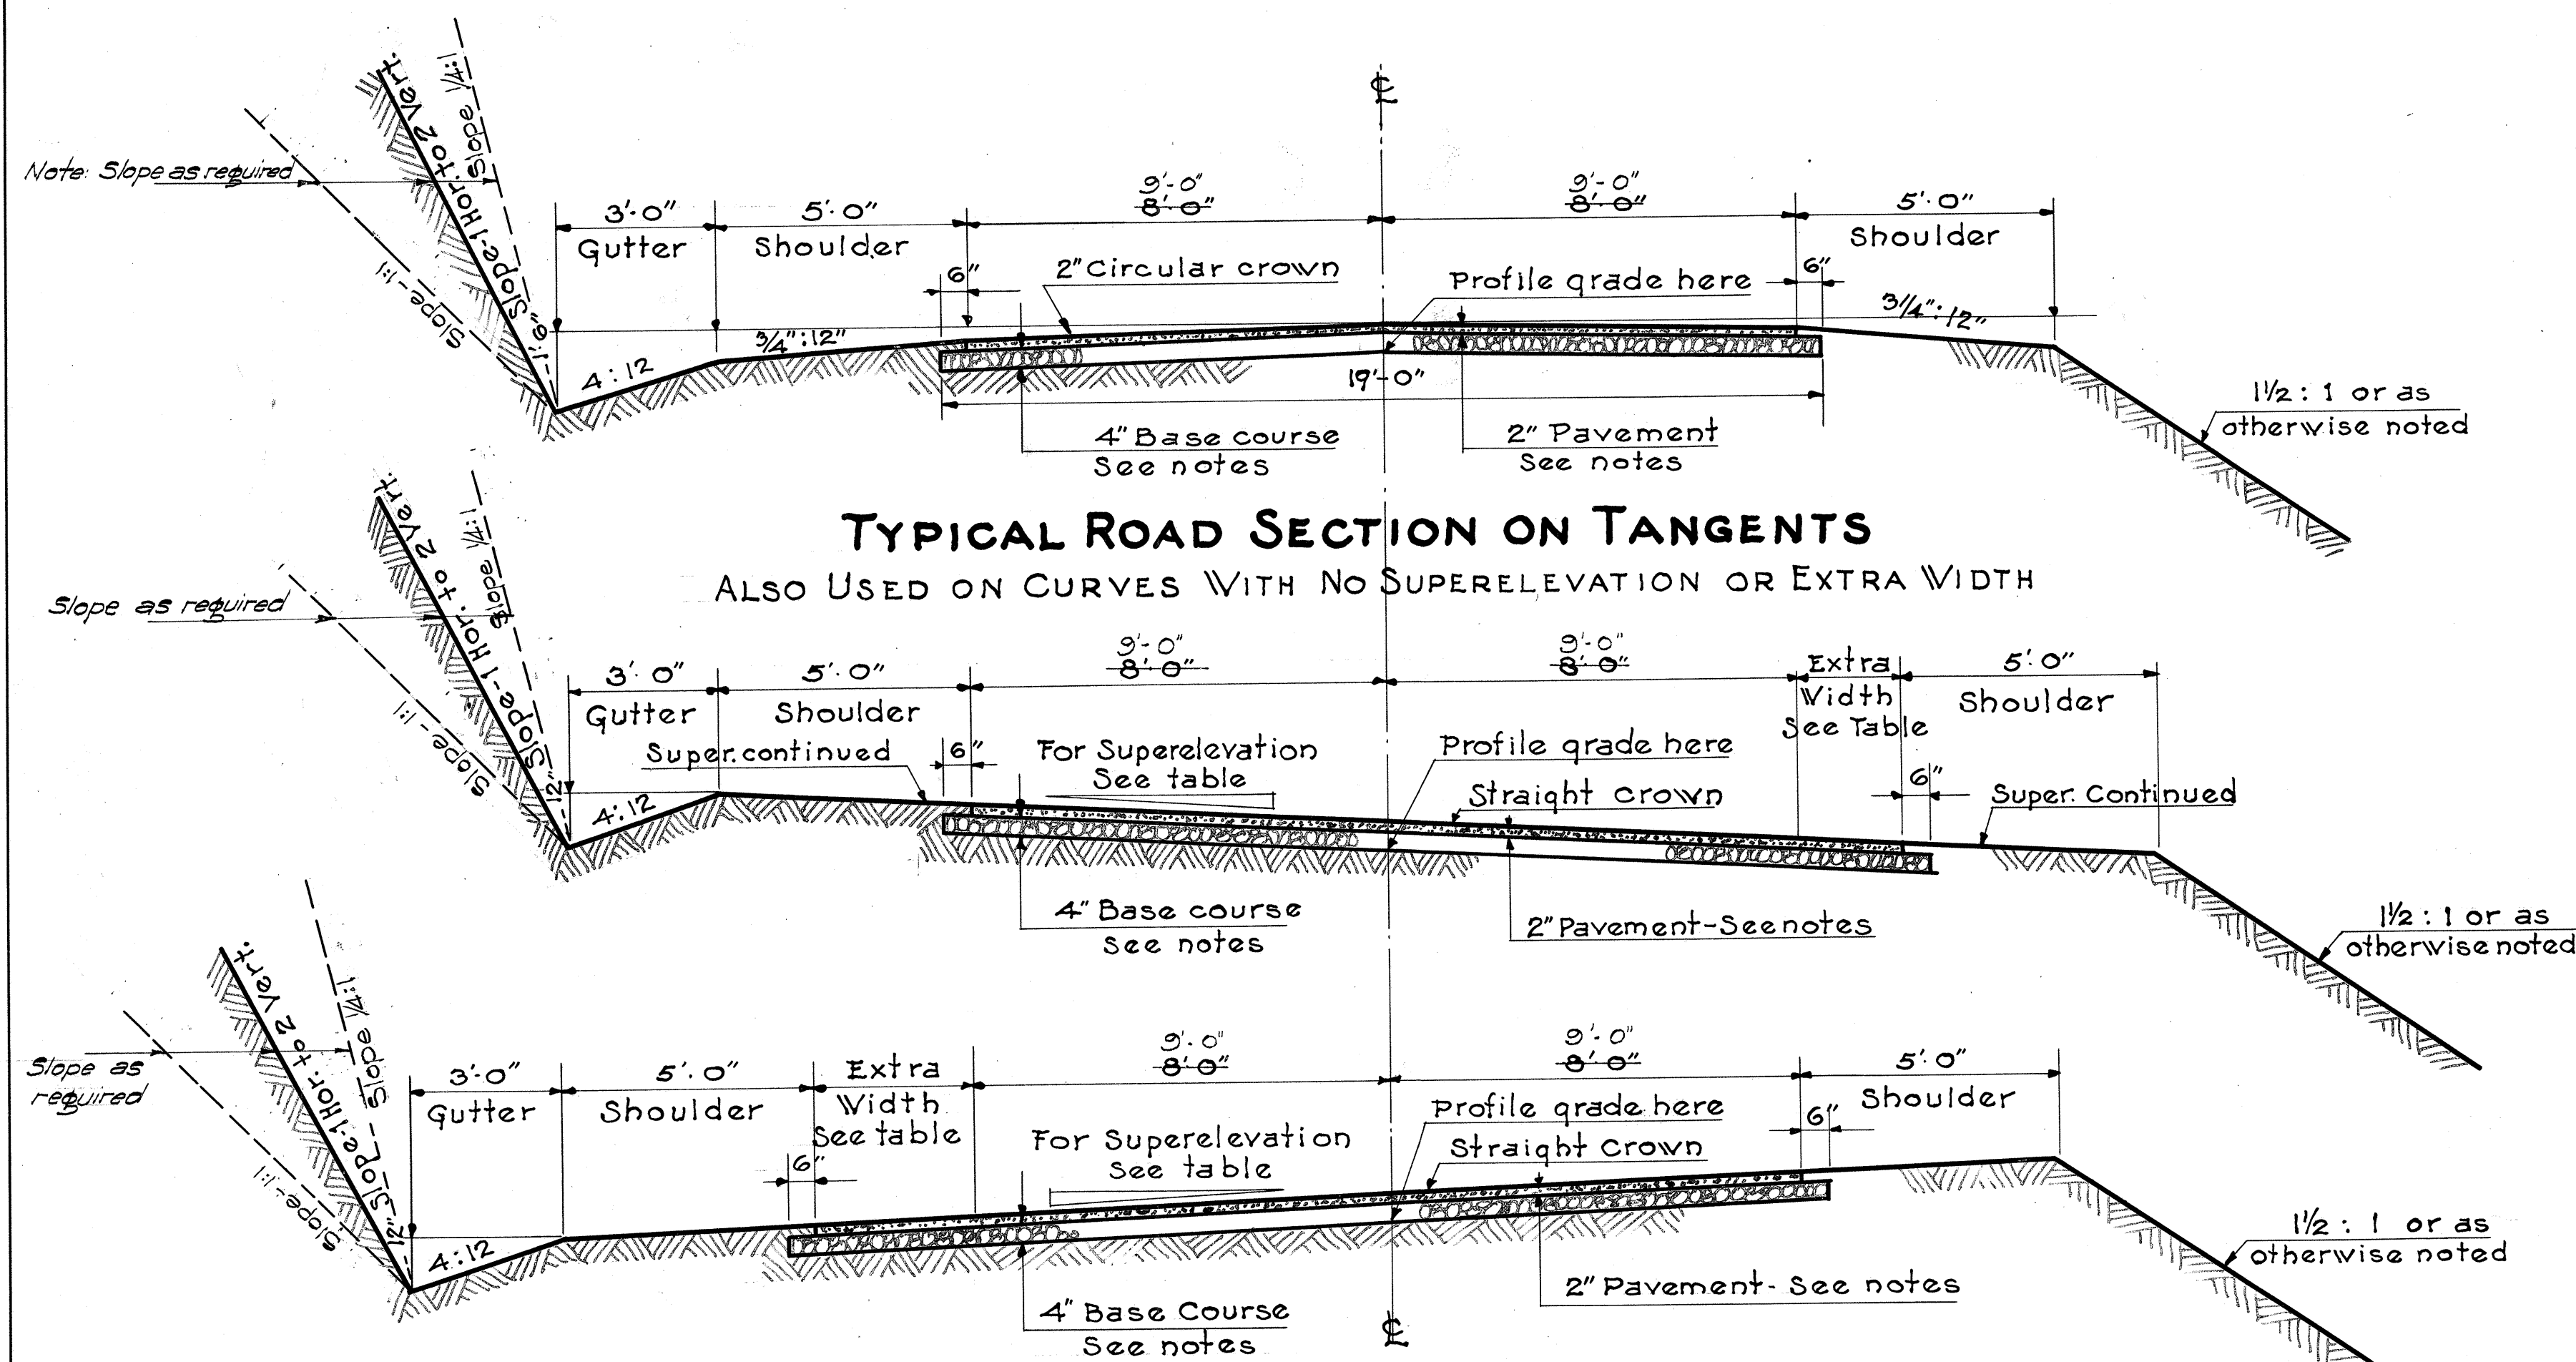

NOTES ON BASE COURSE AND PAVEMENT

BASE COURSE:

The 4" base course shall be either a "Crusher Run Base Course" or a "Macadam Base Course", these being as noted below.

CRUSHER RUN BASE COURSE: 4" (compacted or finished thickness) of crusher run material (20% wear).

MACADAM BASE COURSE: 4" (compacted or finished thickness) of No. 1 crushed rock ($3\frac{1}{2}$ " to $1\frac{1}{4}$ ") fully filled and bound together with No. 4s crushed rock ($\frac{3}{4}$ " to $\frac{1}{4}$ "). Rock to have not over 12% wear.

PAVEMENT:

The 2" pavement shall be either the "Asphaltic Macadam Surface Course" or "Seal Coat", or a "Cold Emulsified Asphalt Pavement", these being as noted below.

ASPHALT MACADAM SURFACE COURSE: 2" (Compacted thickness) No. 2 Crushed rock (2" to 1"); 10 lbs per sq. yd. Asphalt (85-100) & sufficient No. 3 Crushed Rock (1" to $\frac{5}{8}$ ") to cover. This to have "Seal Coat" of 3 to 4 lbs of asphalt & No. 6 Crushed Rock ($\frac{1}{4}$ " to $\frac{1}{8}$ ").

COLD EMULSIFIED ASPHALT PAVEMENT: 2" (Compacted thickness) No. 2 Crushed Rock (2" to 1") filled to within 1" of its top with No. 5 Crushed Rock ($\frac{3}{8}$ " to #10), $\frac{3}{4}$ to 1 gal per sq. yd. of Emulsion sufficient No. 4 Crushed Rock ($\frac{5}{8}$ " to #10) to key surface; $\frac{3}{4}$ to 1 gal per sq. yd. of Emulsion sufficient No. 5 Crushed Rock ($\frac{3}{8}$ " to #10) to complete surface keying; $\frac{3}{4}$ to $\frac{1}{2}$ gal per sq. yd. of Emulsion & sufficient No. 6 Crushed Rock ($\frac{1}{4}$ " to #20) to cover; total emulsion used to be 2 to 2 $\frac{1}{2}$ gals per sq. yd.

Note - Particular reference is made to the specifications covering these items of work.