


FED. ROAD DIST. NO.	STATE	FED. AID PROJ. NO.	FISCAL YEAR	SHEET NO.	TOTAL SHEETS
HAWAII	HAW.	F-037-1(7)	1972	15	113

FINAL SURVEY PLAT NO. 10000
DATE 10/1/71
BY J. L. HARRIS
CHECKED BY J. L. HARRIS
DATE 10/1/71

ORIGINAL SURVEY PLAT NO. 10000
DATE 10/1/71
BY J. L. HARRIS
CHECKED BY J. L. HARRIS
DATE 10/1/71

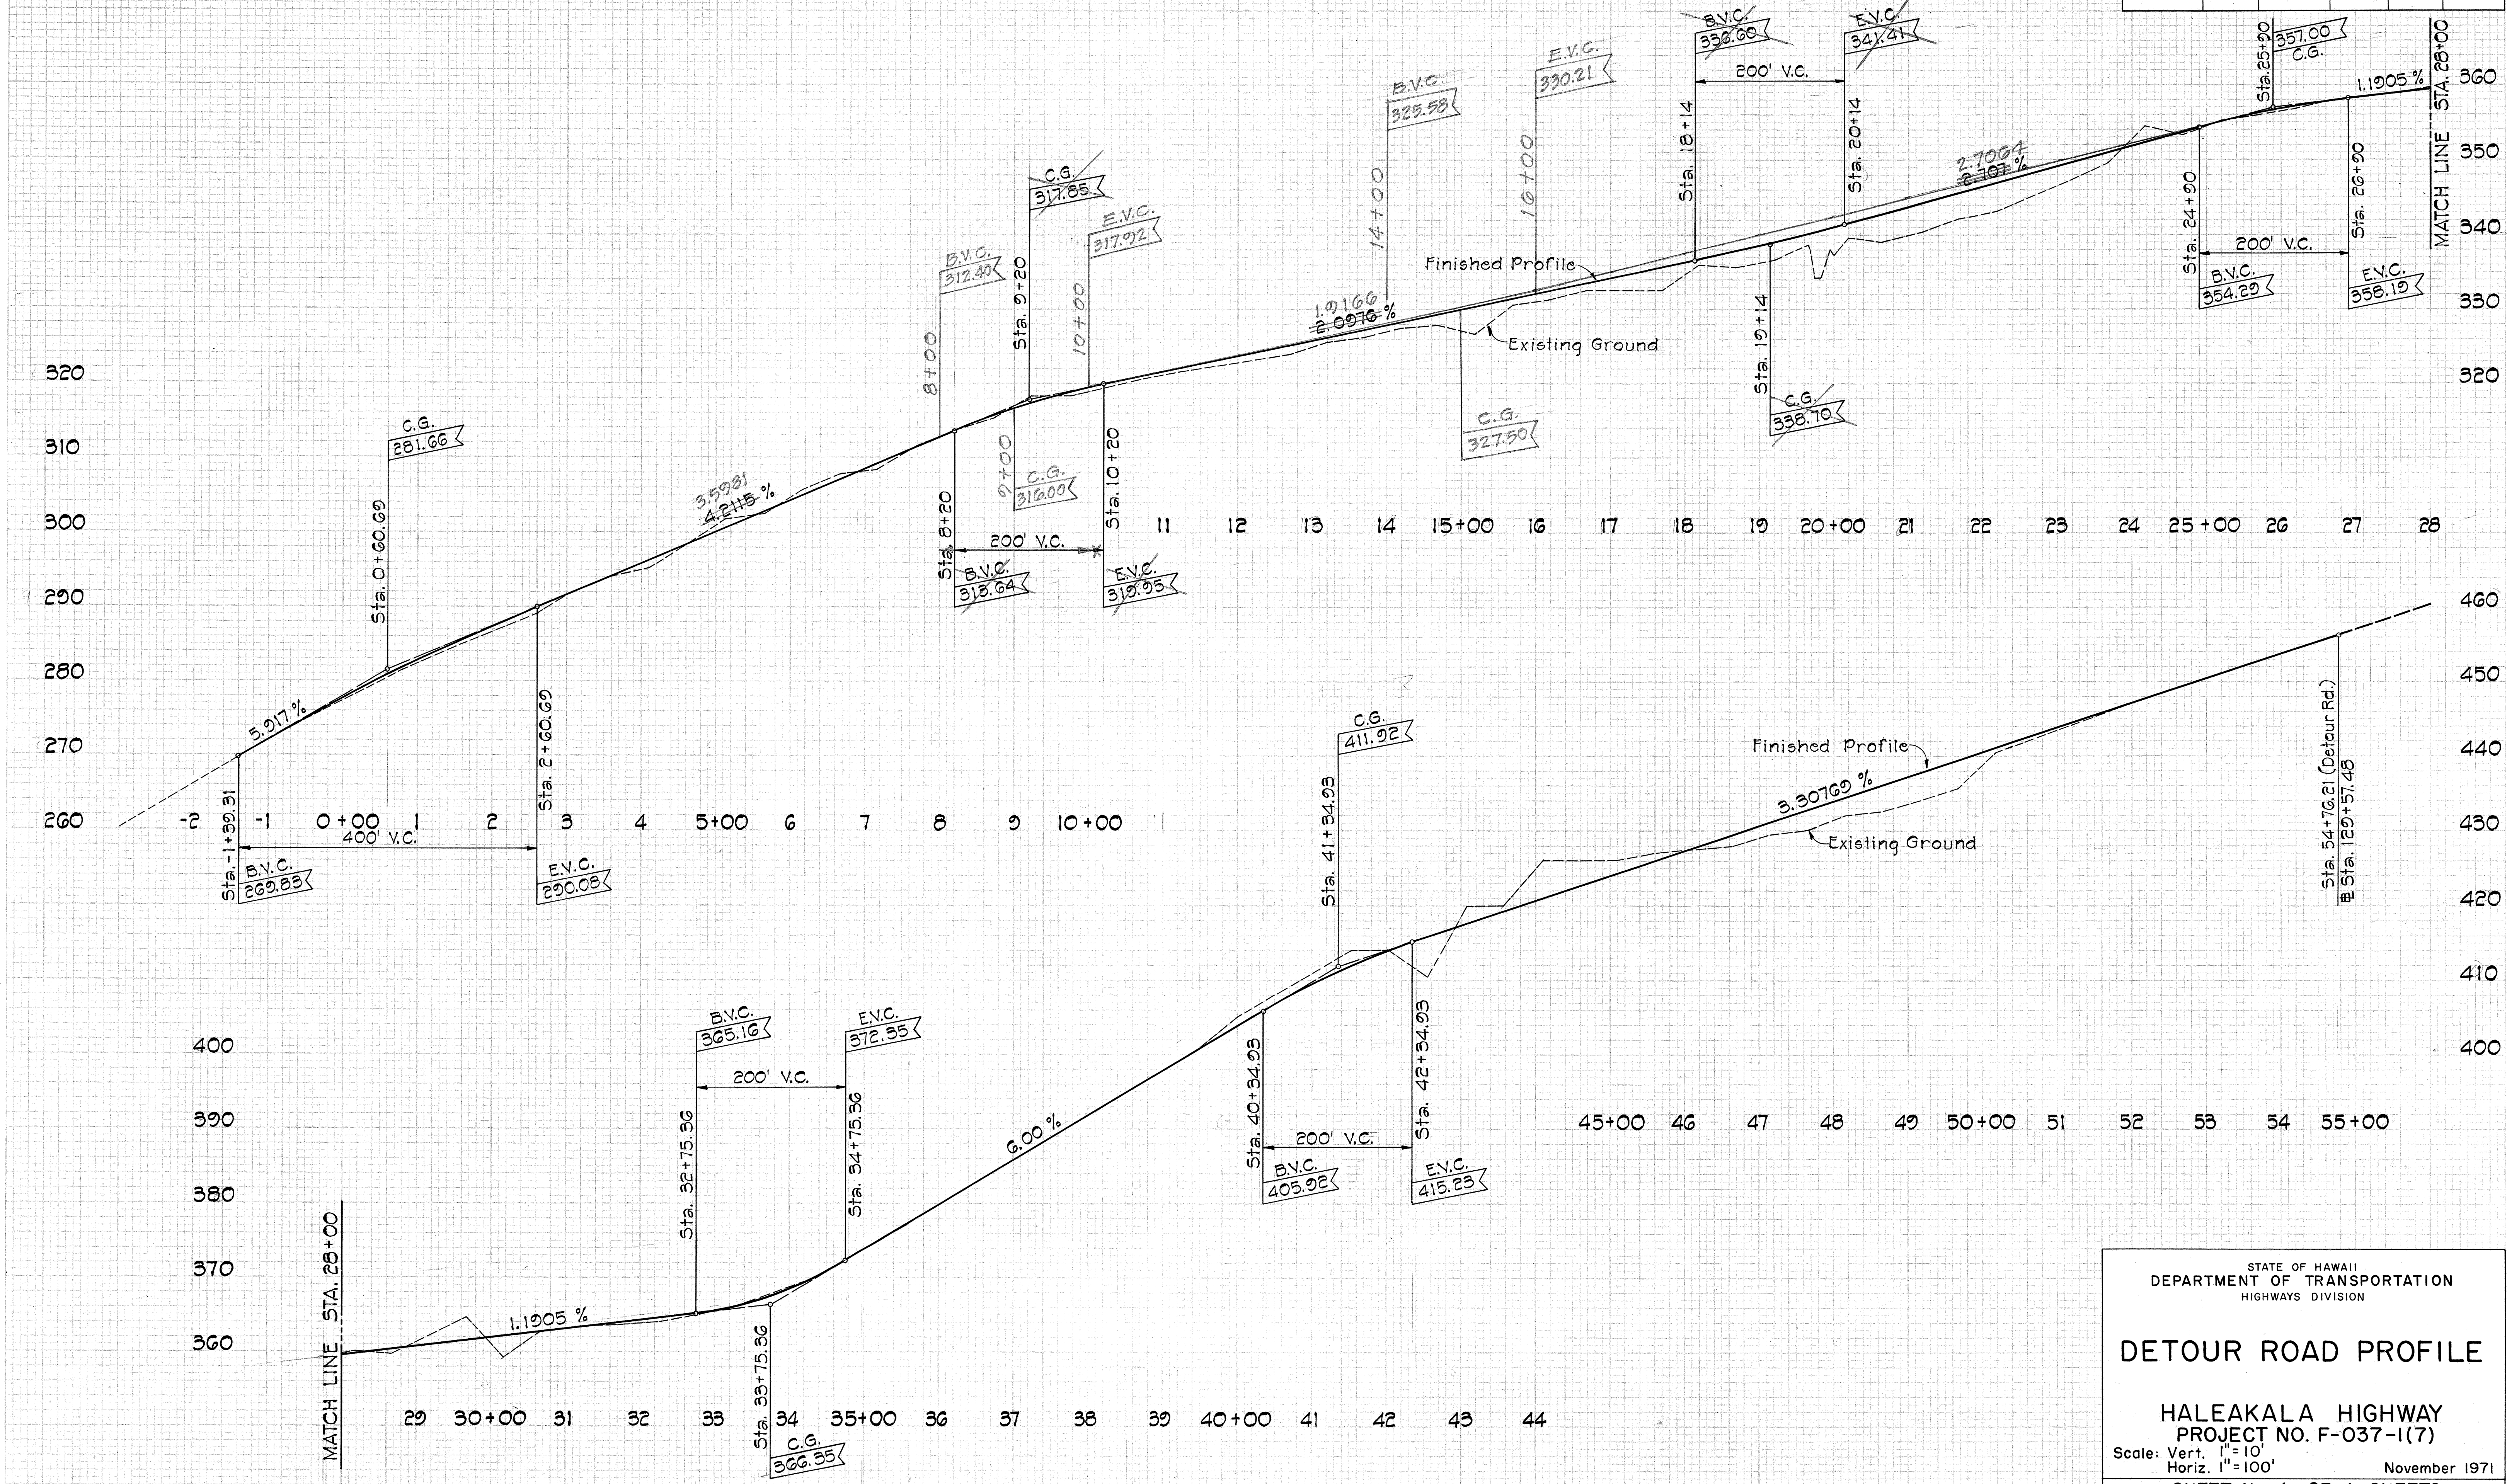

STATE OF HAWAII
DEPARTMENT OF TRANSPORTATION
HIGHWAYS DIVISION

DETOUR ROAD PROFILE

HALEAKALA HIGHWAY
PROJECT NO. F-037-1(7)

Scale: Vert. 1"=10'
Horiz. 1"=100'

November 1971

SHEET No. 1 OF 1 SHEETS