


FED. ROAD DIST. NO.	STATE	FED. AID PROJ. NO.	FISCAL YEAR	SHEET NO.	TOTAL SHEETS
HAWAII	HAW.	F-037-1(7)	1972	16	113

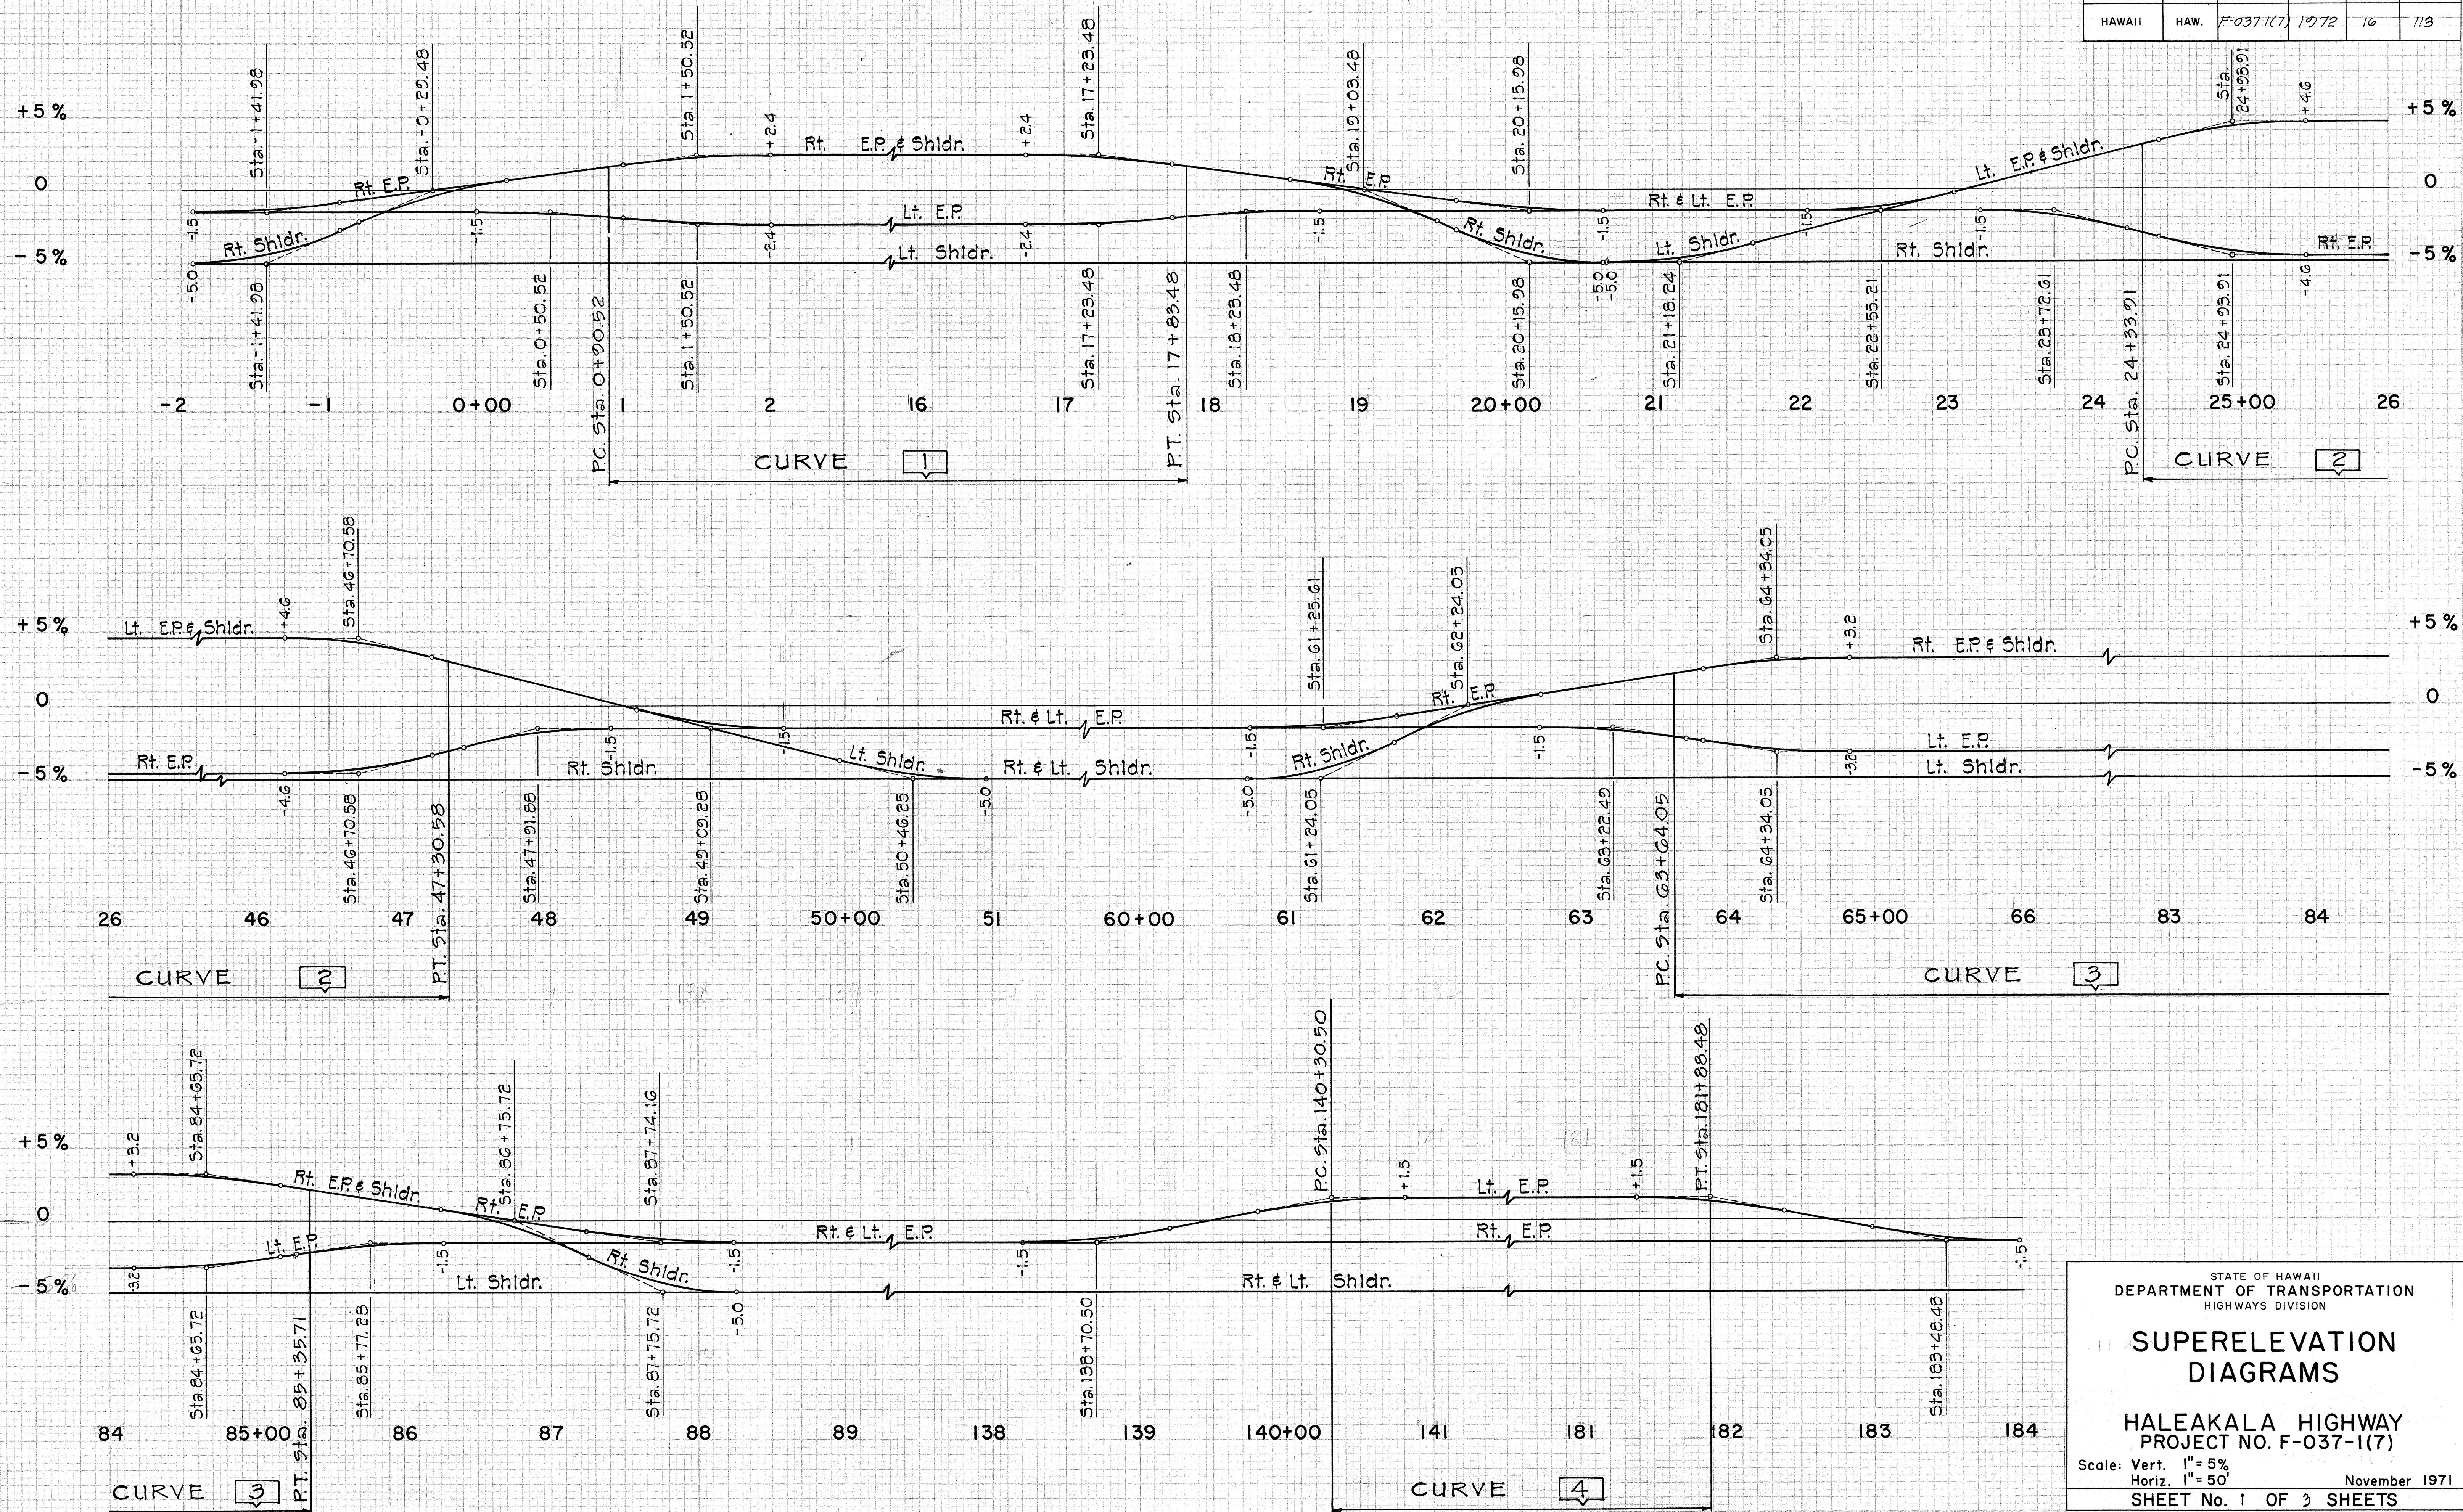

STATE OF HAWAII
DEPARTMENT OF TRANSPORTATION
HIGHWAYS DIVISION

**SUPERELEVATION
DIAGRAMS**

**HALEAKALA HIGHWAY
PROJECT NO. F-037-1(7)**

Scale: Vert. 1" = 5%
Horiz. 1" = 50'

November 1971

SHEET No. 1 OF 3 SHEETS

FINAL SURVEY			
SURVEY	SURVEYED	BY	DATE
NOTE BOOK	PLOTTED		
	TEMPLATE		
	AREAS		
NO	AREAS CHECKED		



TEMPORARY CONNECTION

Printed in U.S.A.
On IMPERIAL Tracing Cloth

PLATE 3 CROSS SECTION S P R STANDARD
EUGENE DIETZEN CO. CHICAGO - NEW YORK

17 Printed in U.S.A.
IMPERIAL Trading Cloth

NO	FINAL SURVEY	SURVEYED	BY	DATE
	NOTE BOOK	PLOTTED		
		TERMINATE		
		AREAS		
		AREAS CHECKED		

ORIGINAL	SURVEYED	DATE
SURVEY	BLOTTED	
NOTE BOOK	TEMPERATE	
	AREAS	
%	AREAS CHECKED	

