

PHONE : 548-2456


DESIGNED BY : MAUI DISTRICT OFFICE  
STATE HIGHWAYS DIVISION  
DATE : MARCH, 1973

PS & E. BY : Ronald F. Suzuki  
DATE : APRIL, 1973


INDEX TO DRAWINGS	
SHEET NO	DESCRIPTION
1	TITLE SHT., PLAN & TYPICAL SECT.
2	STD. DET.-RAISED PAV'T. MARKERS

GENERAL NOTES

- The existing paved roadway shall be cleaned according to Section 310 of the Standard Specifications. Payment incidental to A.C. Pavement.
- Dressing at the shoulder area shall be with material approved by the Engineer. The shoulders shall be cut or filled, graded, watered and rolled as directed by the Engineer. Payment incidental to A.C. Pavement.
- All chuck holes and large depressions, if any, shall be filled and compacted with A.C. Pavement prior to resurfacing. Payment incidental to A.C. Pavement.
- The Contractor's attention is directed to Subsection 106.10 - Ordering of Certain Materials of the Special Provisions.

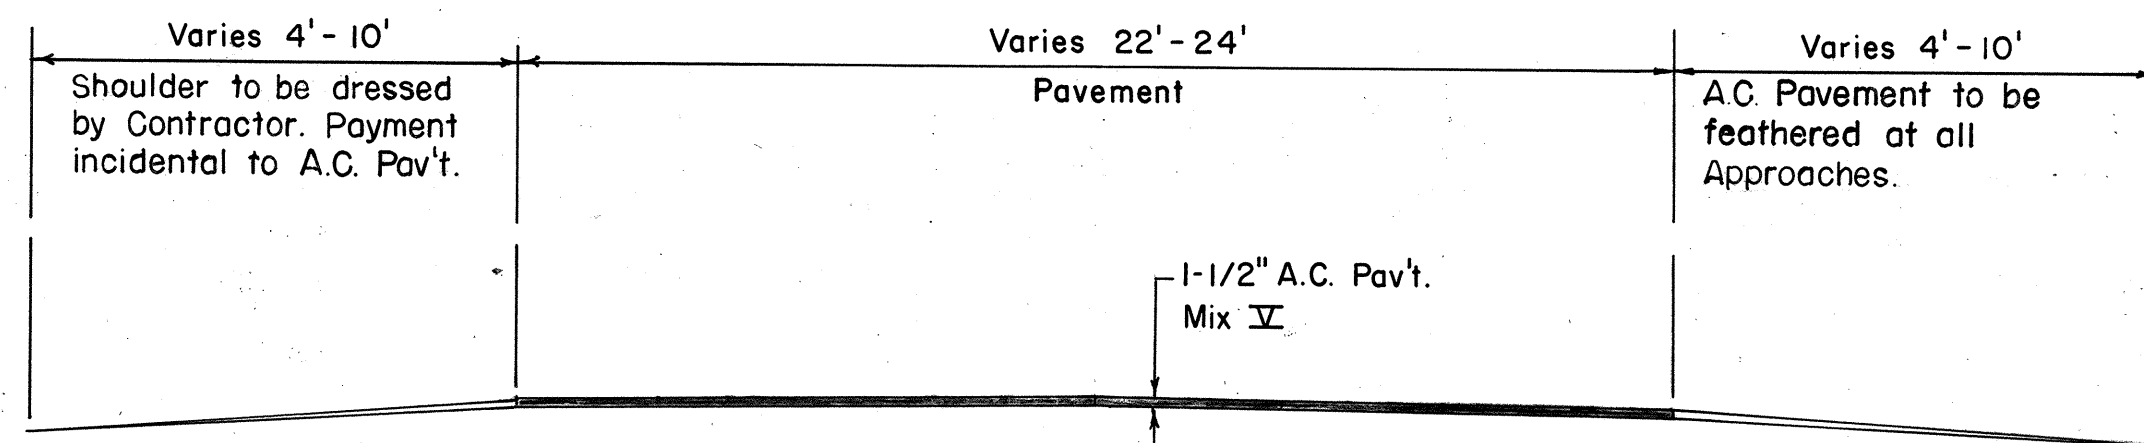

TYPICAL SECTION  
SCALE: 1/4" = 1'-0"

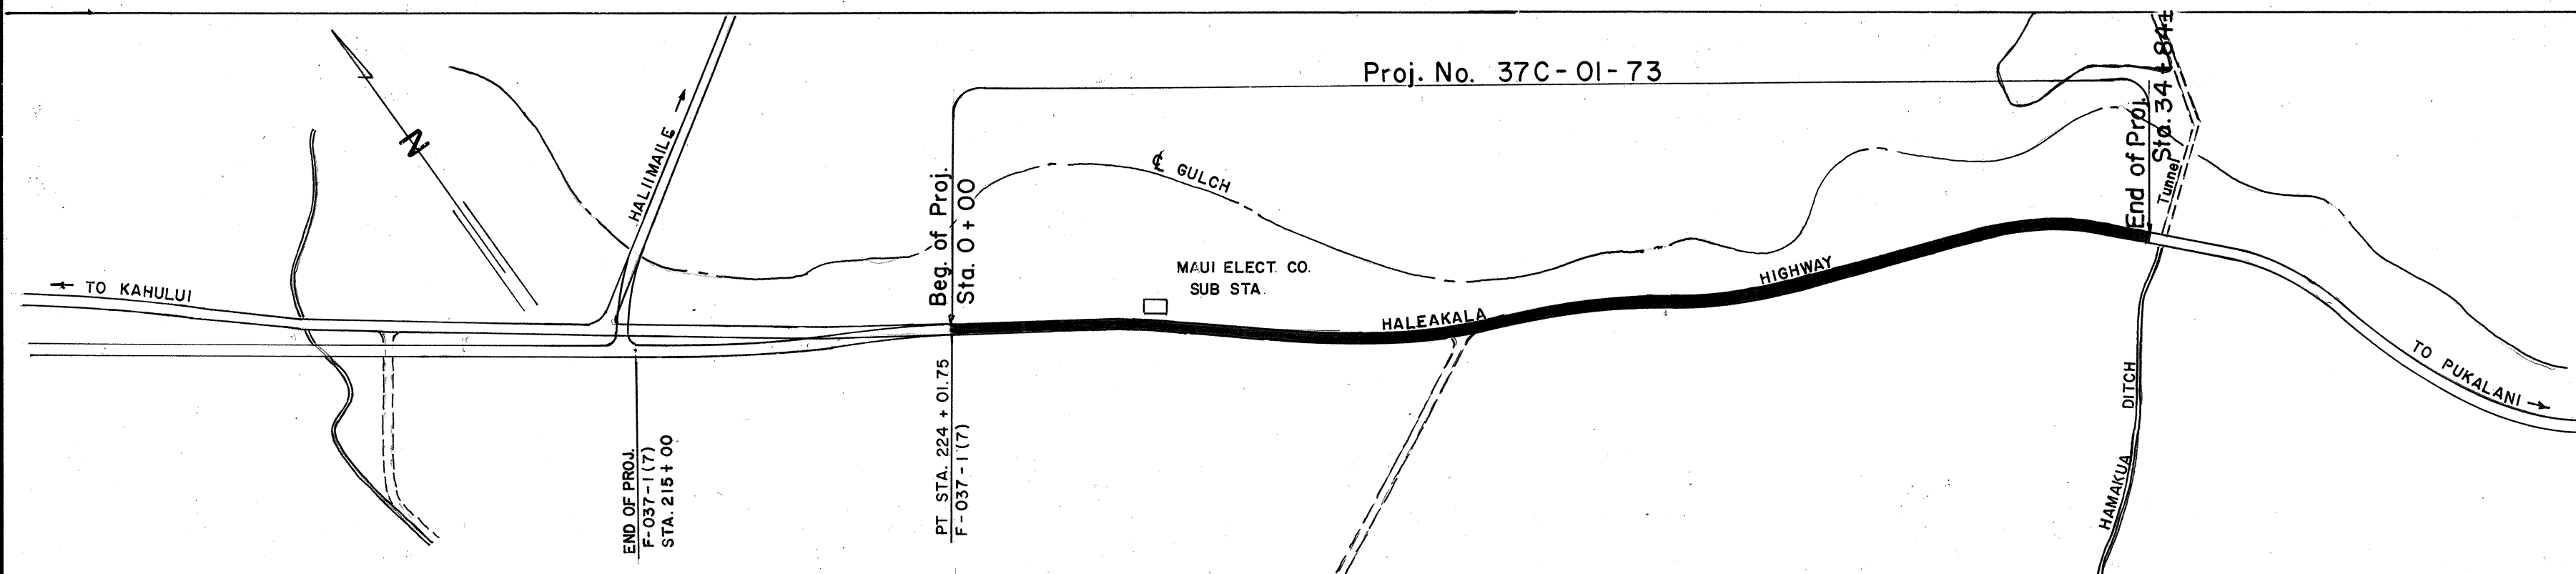


LAYOUT OF PROJECT  
SCALE 1" = 400'  
LENGTH OF PROJECT: .660 Mi.

STATE OF HAWAII  
DEPARTMENT OF TRANSPORTATION  
HIGHWAYS DIVISION  
HONOLULU, HAWAII

"AS - BUILT" PLANS OF  
RESURFACING A PORTION OF HALEAKALA HIGHWAY  
(VICINITY OF HALIIMAILE JUNCTION TOWARD PUKALANI)  
PROJECT NO. 37C-01-73

DISTRICT OF MAKAWAO  
ISLAND OF MAUI

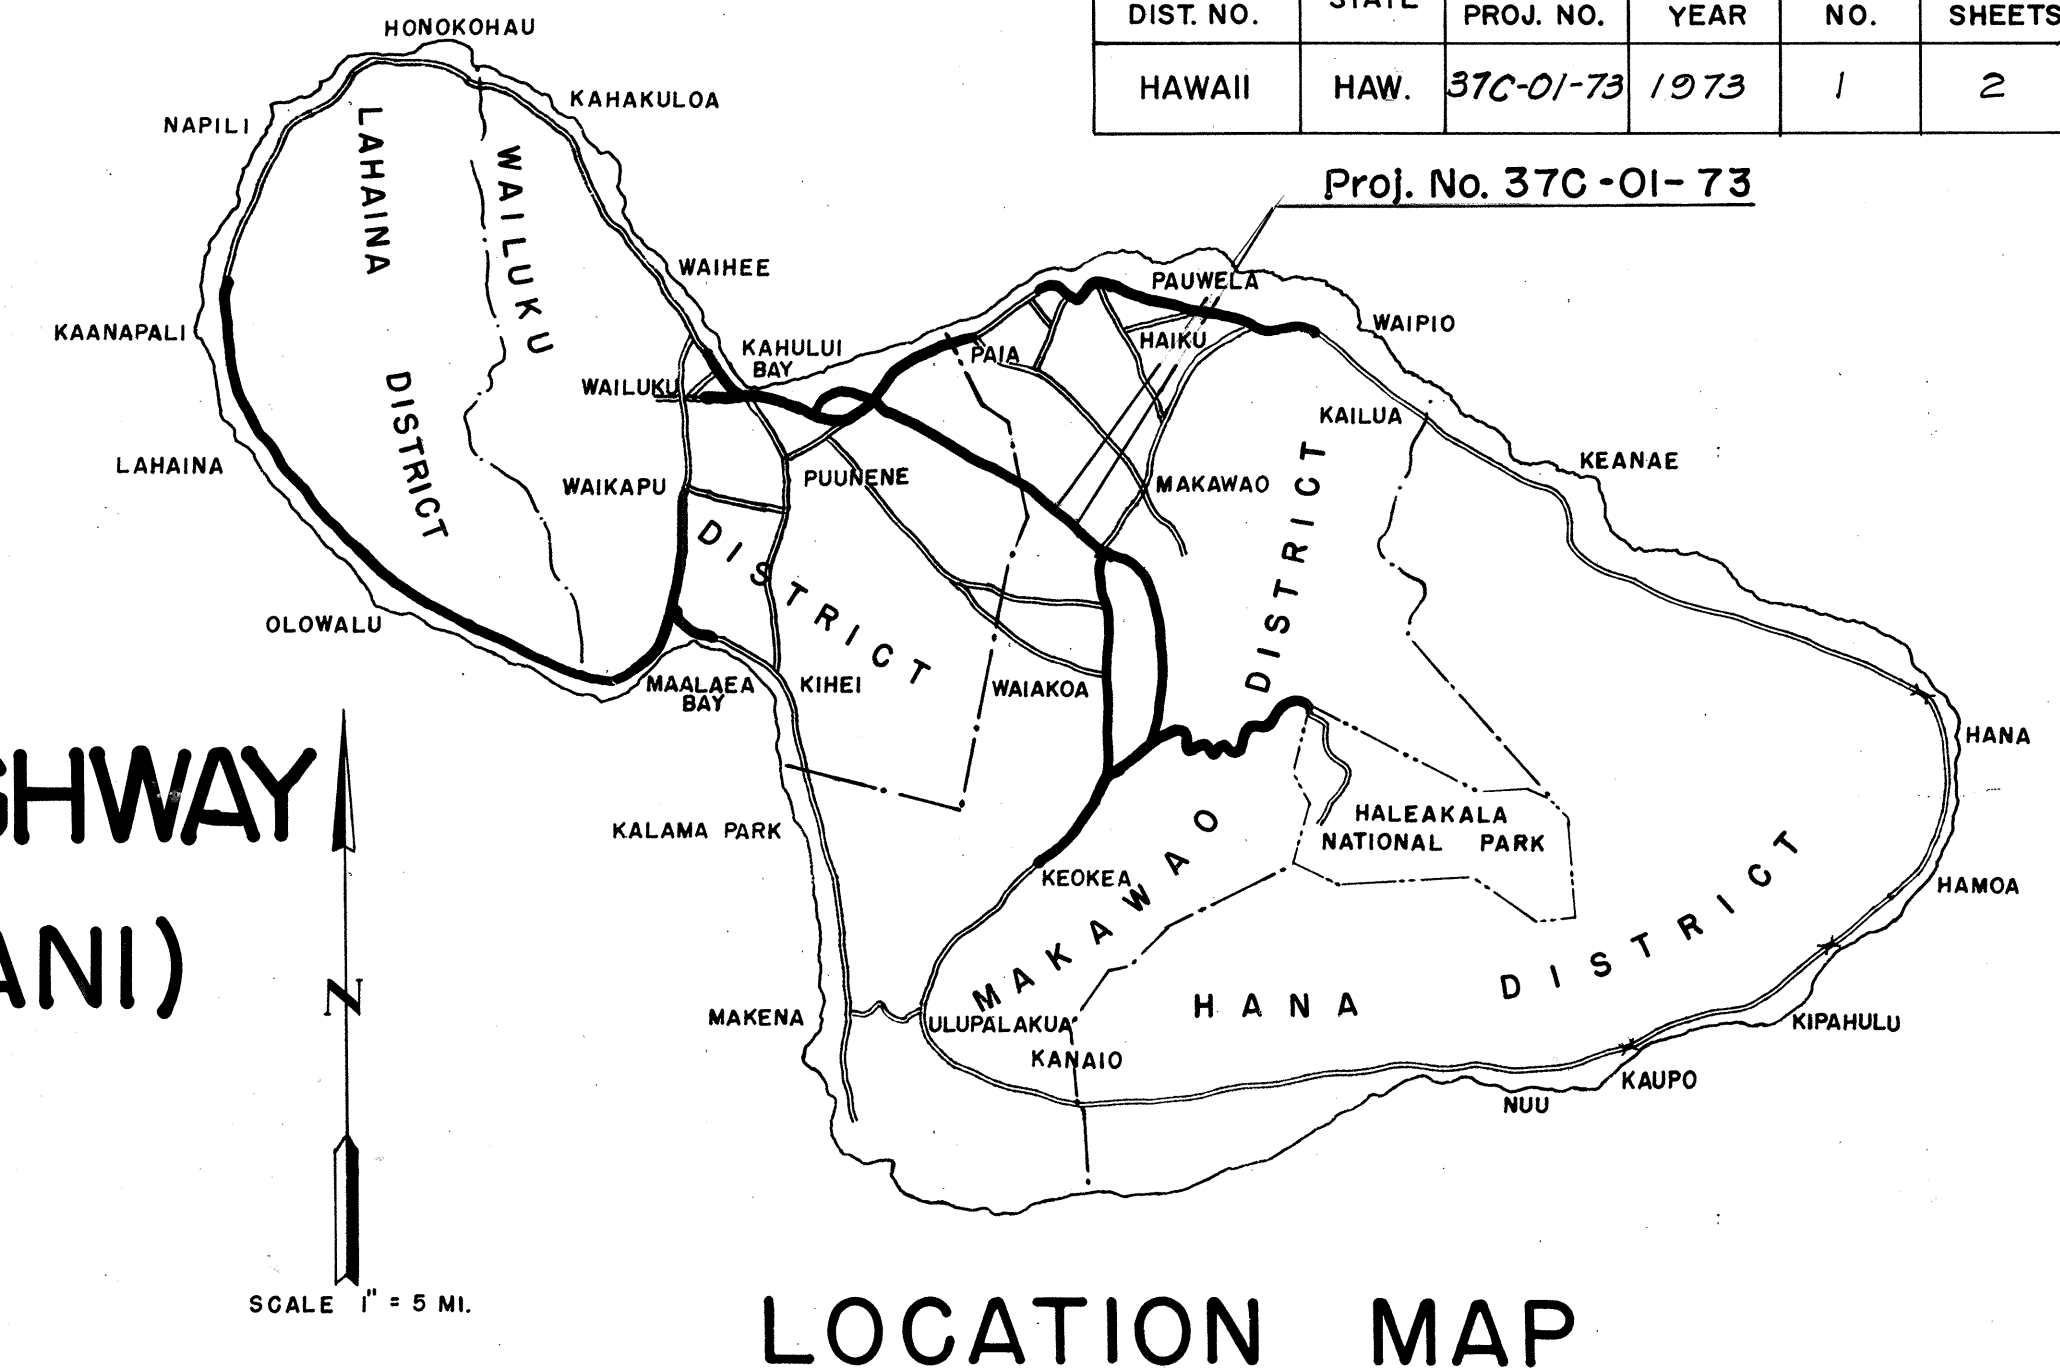

LOCATION MAP

— FEDERAL AID PROJECTS PREVIOUSLY CONSTRUCTED OR UNDER CONSTRUCTION

PAVEMENT MARKER SUMMARY			
STATIONS	J	D	H
0 + 00 to 27 + 00	402	34	
27 + 00 to 30 + 50	48	5	12
30 + 50 to 34 + 84		22	

NO CHANGES WERE MADE DURING CONSTRUCTION ON THESE PLANS EXCEPT CHANGES IN THE ORIGINAL THEORETICAL QUANTITIES. FOR ACTUAL QUANTITIES, REFER TO PROJECT LEDGER AND/OR COMPUTATION BOOK.

*Manuel J. Silva*  
RESIDENT ENGINEER

17 Sept 81  
DATE

APPROVED: DATE 6/29/73  
*Murray Lee*  
FOR DIRECTOR OF TRANSPORTATION