

INDEX TO DRAWINGS	
SHEET NO	DESCRIPTION
1	TITLE SHEET
2	PLAN AND PROFILE
3	DRAINAGE DETAILS
4-5	CROSS SECTIONS
6	STANDARD DETAILS



STATE OF HAWAII
DEPARTMENT OF TRANSPORTATION
HIGHWAYS DIVISION
HONOLULU, HAWAII

AS BUILT PLANS FOR

HALEAKALA HIGHWAY
DRAIN IMPROVEMENTS AT PUKALANI

PROJECT NO. 37C-01-75

DISTRICT OF MAKAWAO
ISLAND OF MAUI

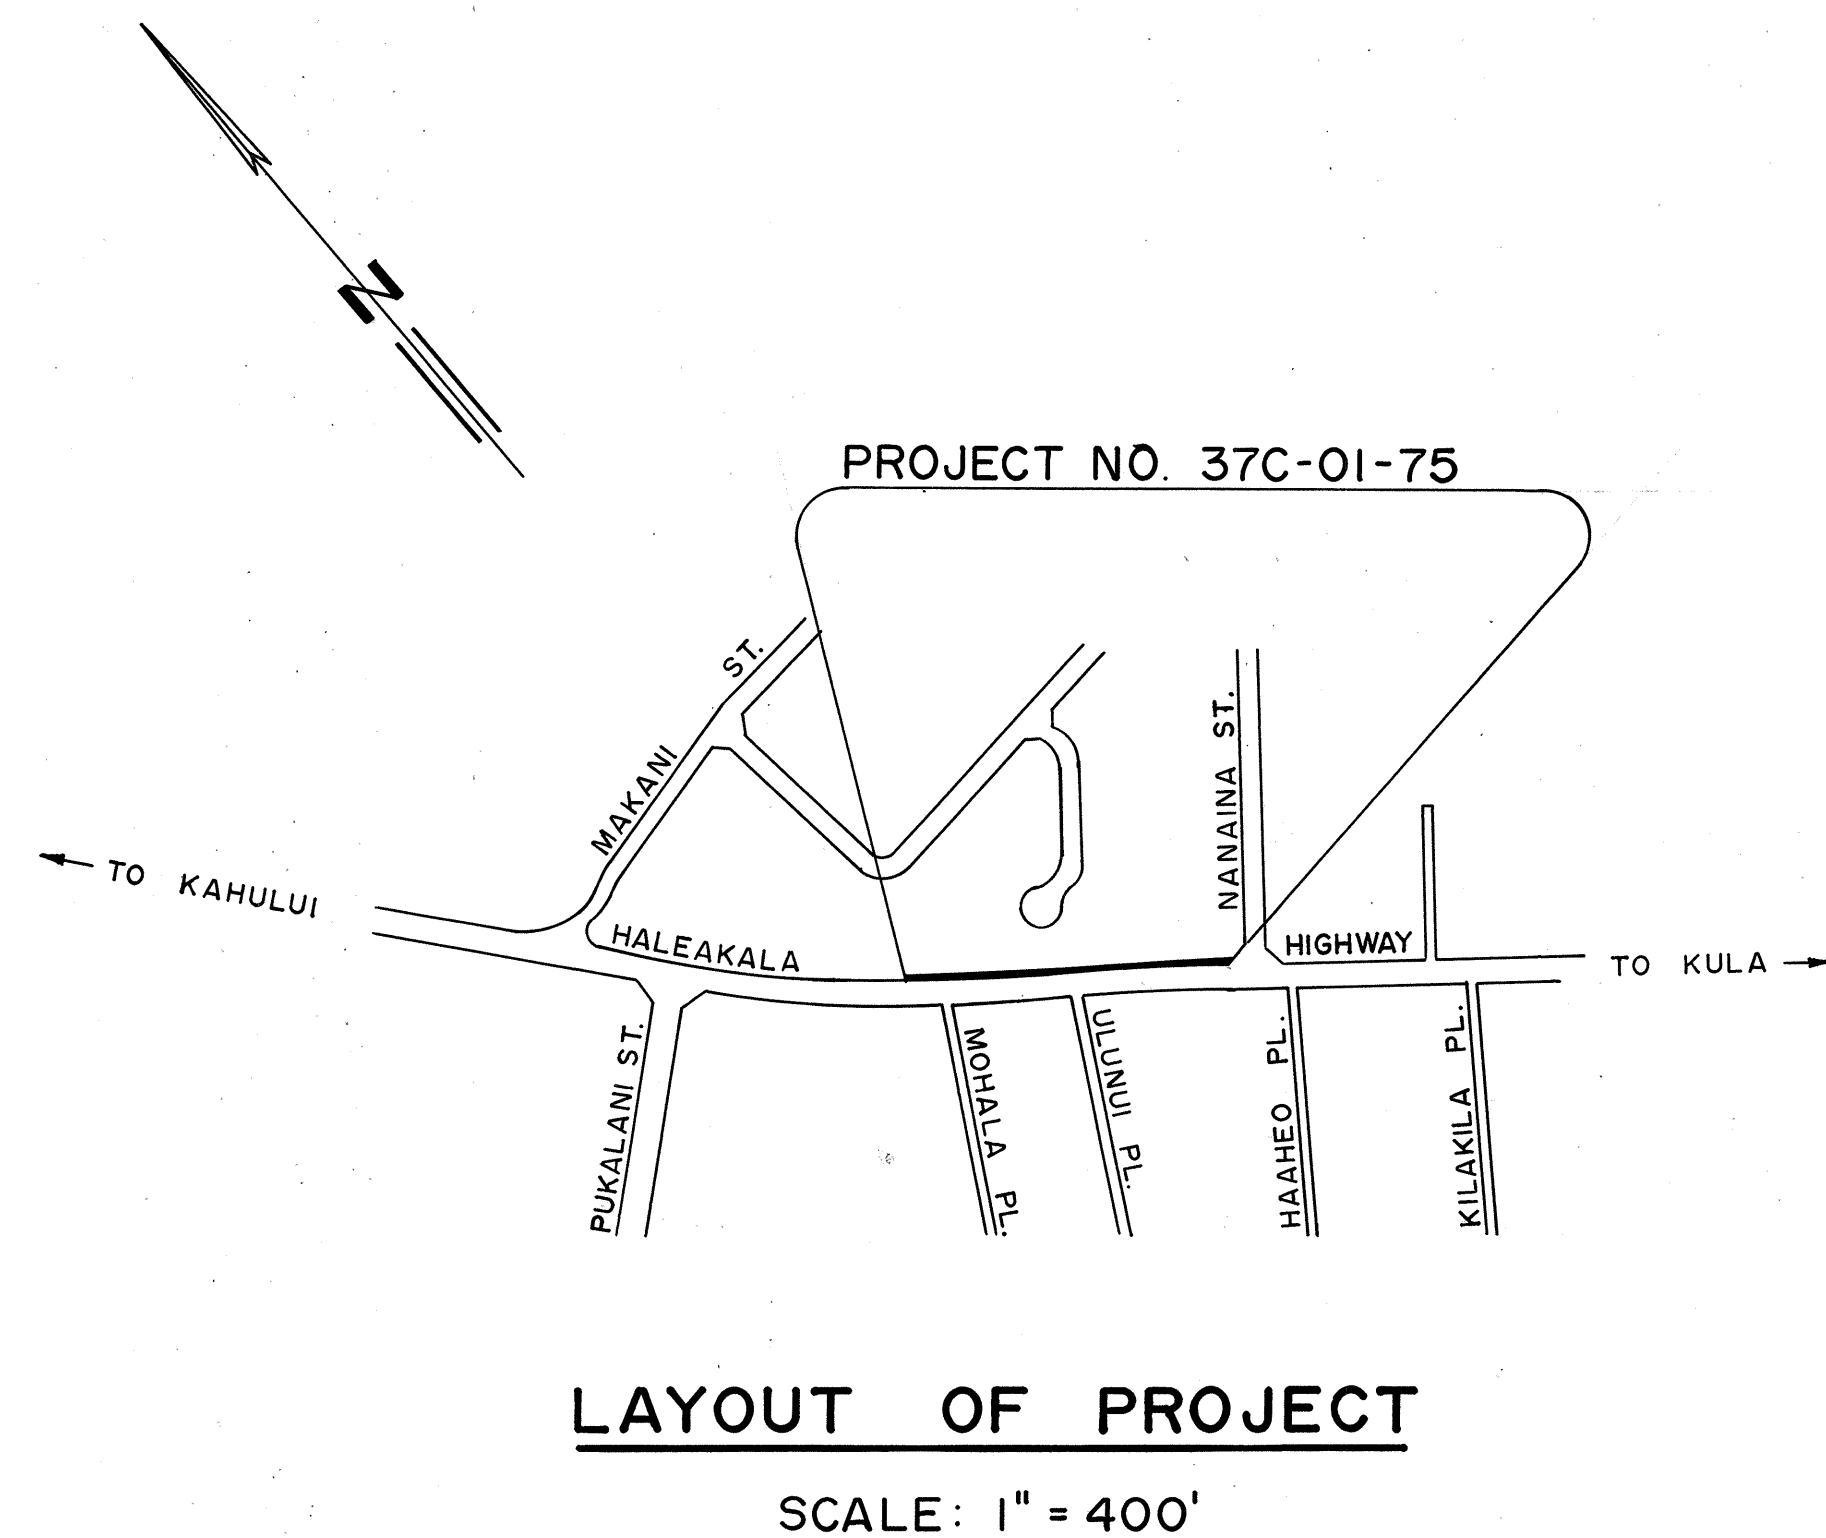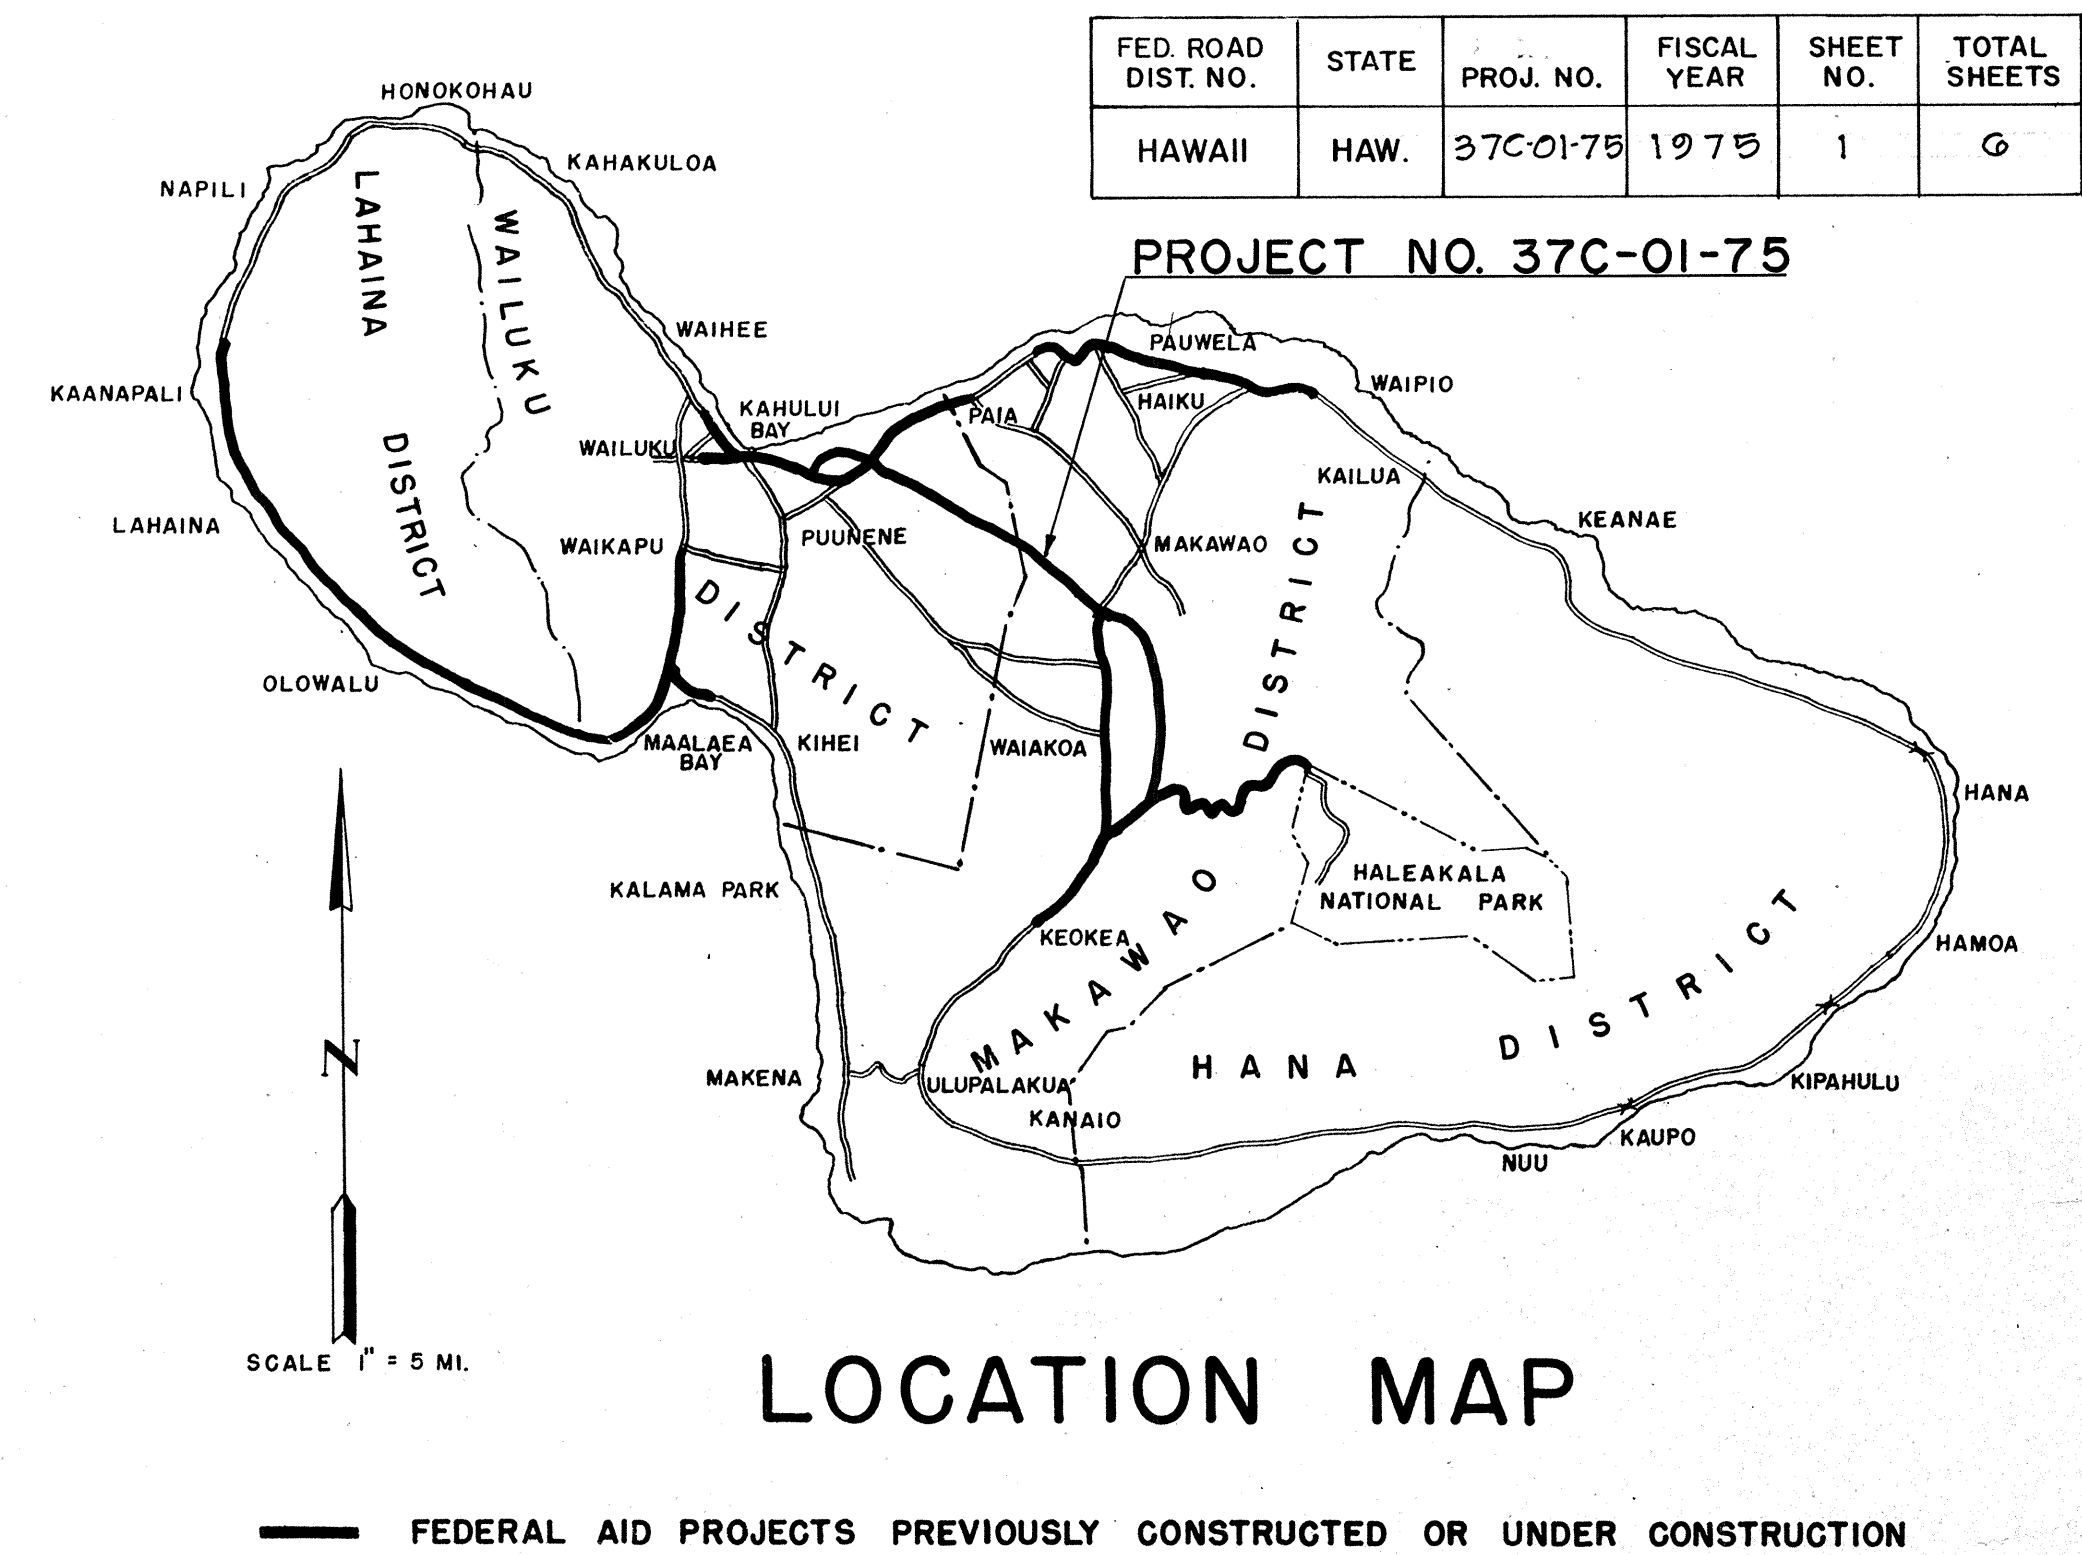

ALL CHANGES MADE DURING CONSTRUCTION
ARE SHOWN IN RED AND CHECKED BY:

K. Nakamoto

PROJECT ENGINEER

12/30/75

DATE

DEPARTMENT OF TRANSPORTATION
STATE OF HAWAII

APPROVED:

E. Alvey Knight

7/2/75

DIR. OF TRANSPORTATION

DATE

HWY - DH

DESIGNED BY

M. Miura - Unit "C" 548-7490 June 30, 1975

P. S. & E. BY

PHONE

DATE