


FED. ROAD DIST. NO.	STATE	PROJ. NO.	FISCAL YEAR	SHEET NO.	TOTAL SHEETS
HAWAII	HAW.	37D-01-75	1978	3	24

NOTE:
Clean All Culverts

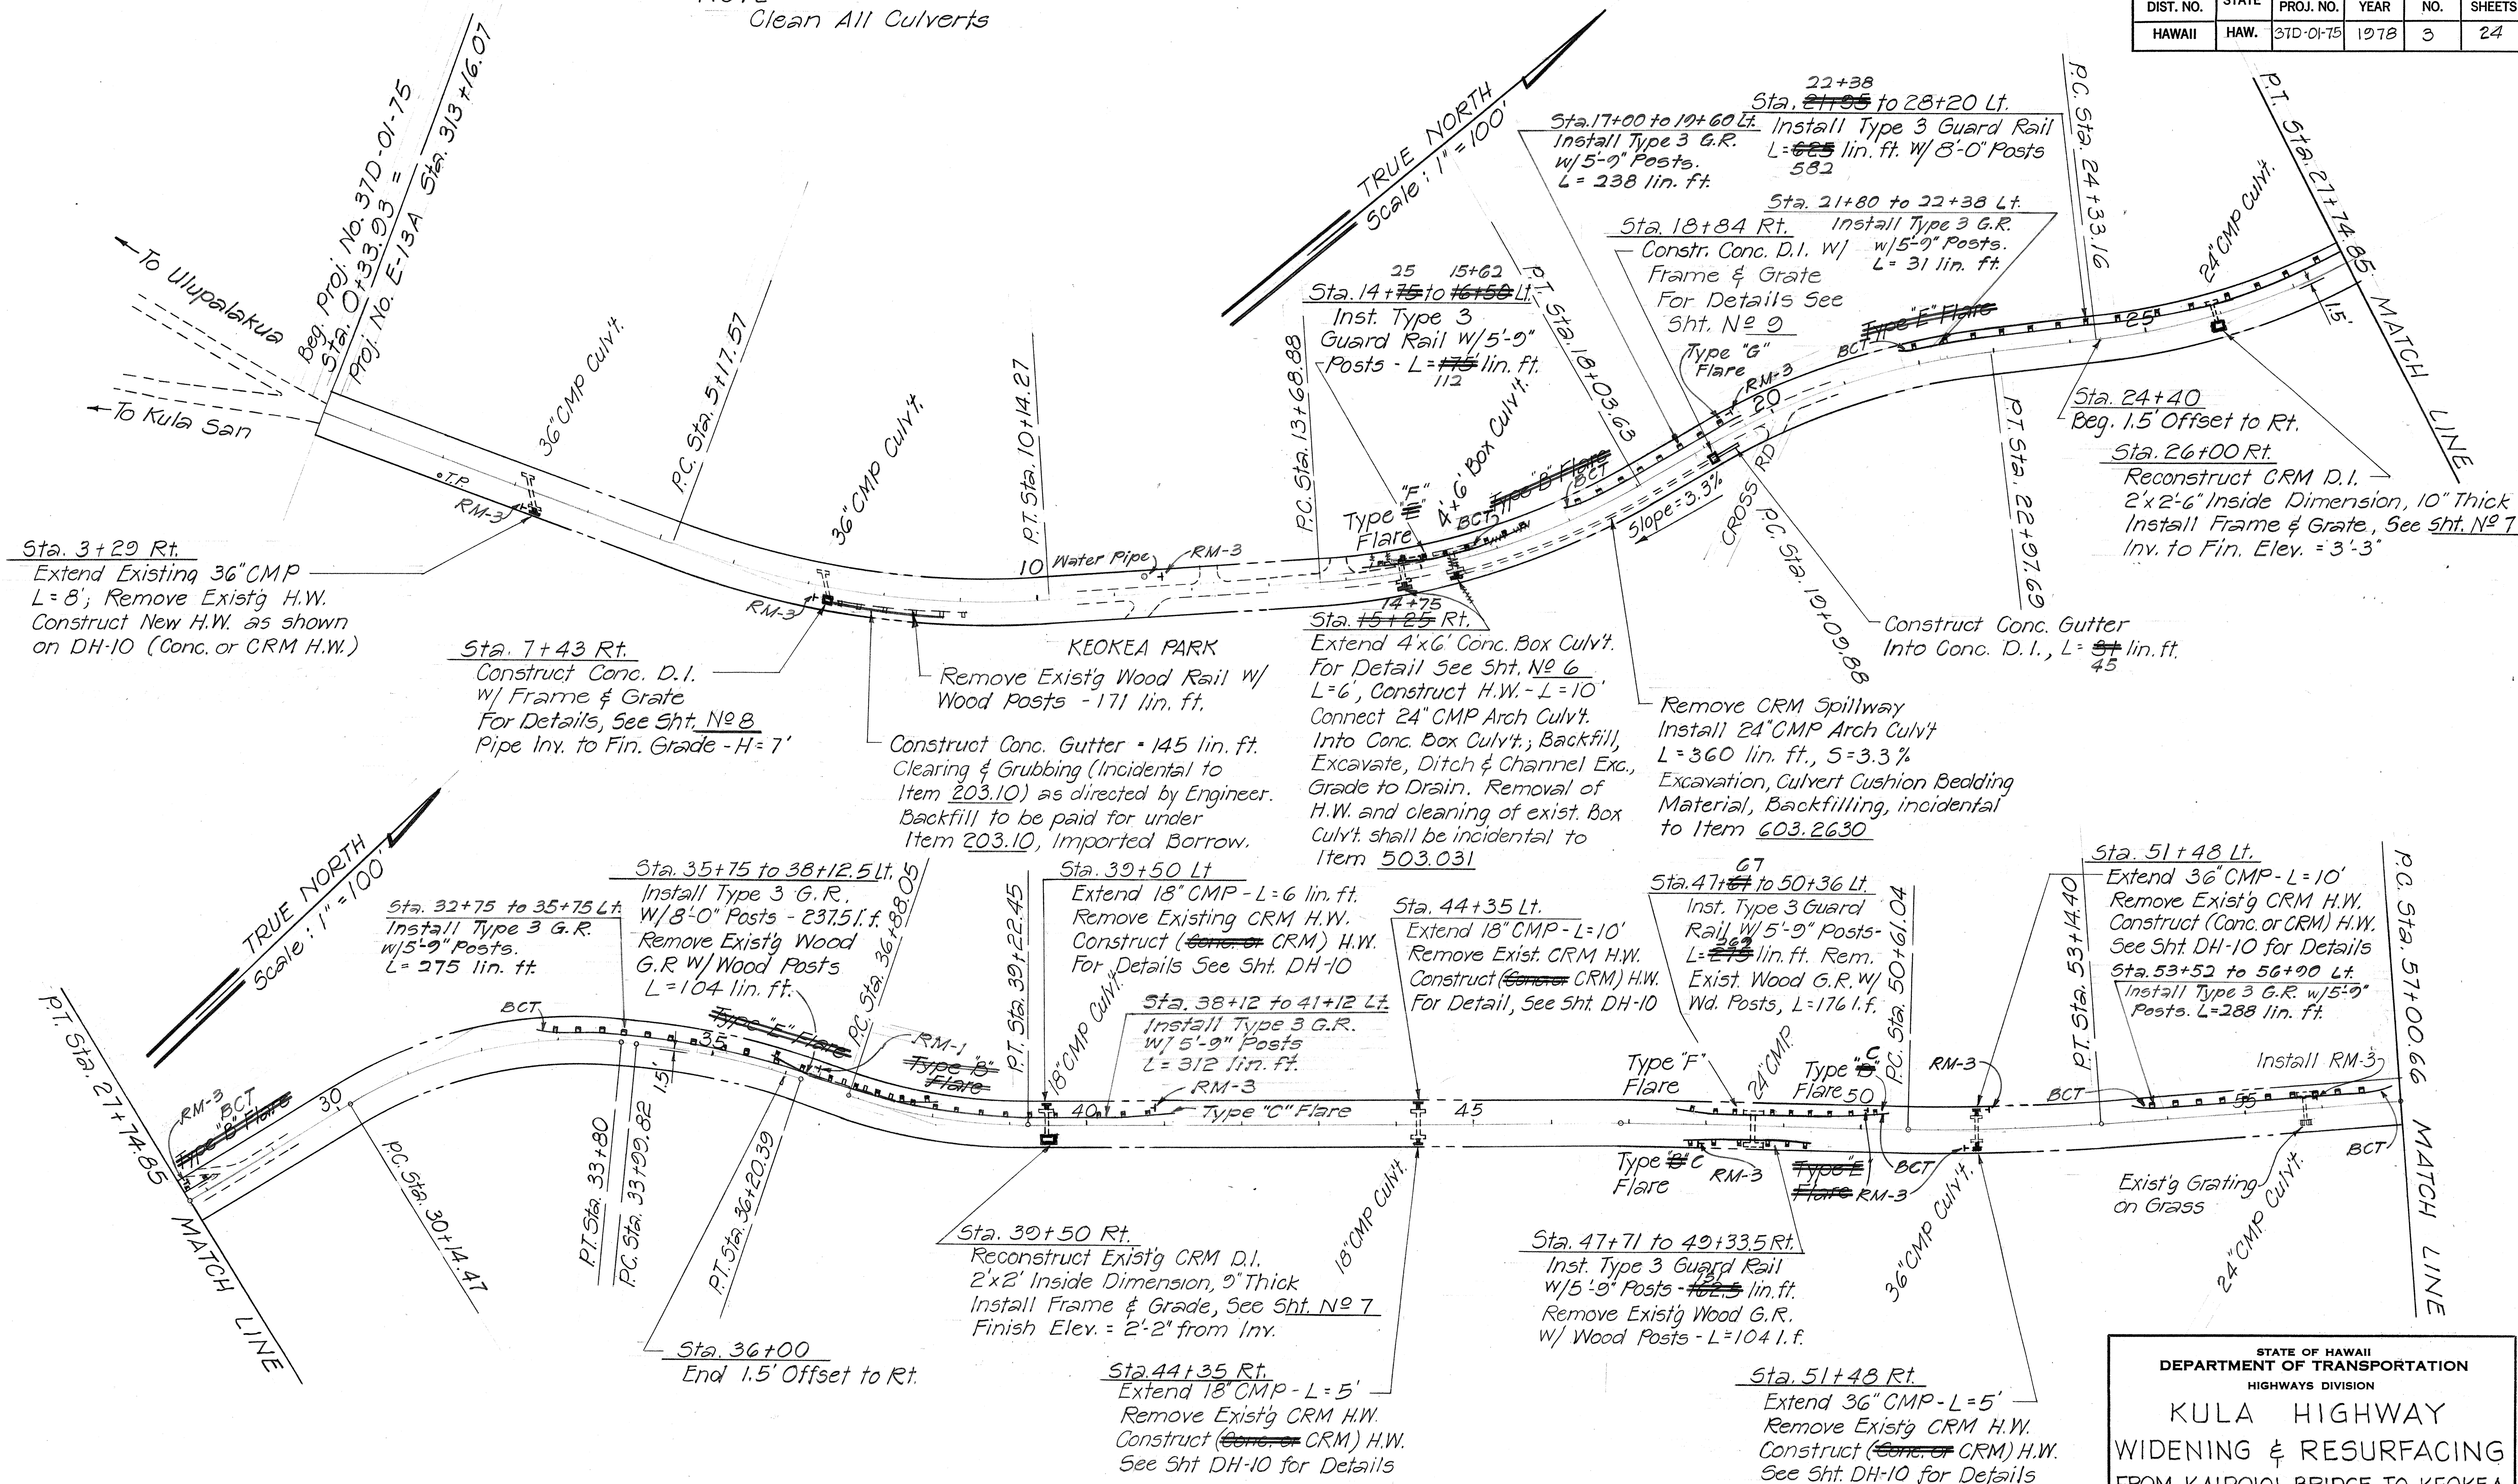


ORIGINAL	DATE
FLAN	
DESIGNED BY	
QUANTITIES BY	
CHECKED BY	

STATE OF HAWAII
DEPARTMENT OF TRANSPORTATION
HIGHWAYS DIVISION

KULA HIGHWAY
WIDENING & RESURFACING
FROM KAIPPIOI BRIDGE TO KEOKEA
PROJ. NO. 37D-01-75

SCALE: AS SHOWN JULY 1976
SHEET No. 1 OF 2 SHEETS

FED. ROAD DIST. NO.	STATE	PROJ. NO.	FISCAL YEAR	SHEET NO.	TOTAL SHEETS
HAWAII	HAW.	37D-01-75	1978	4	24

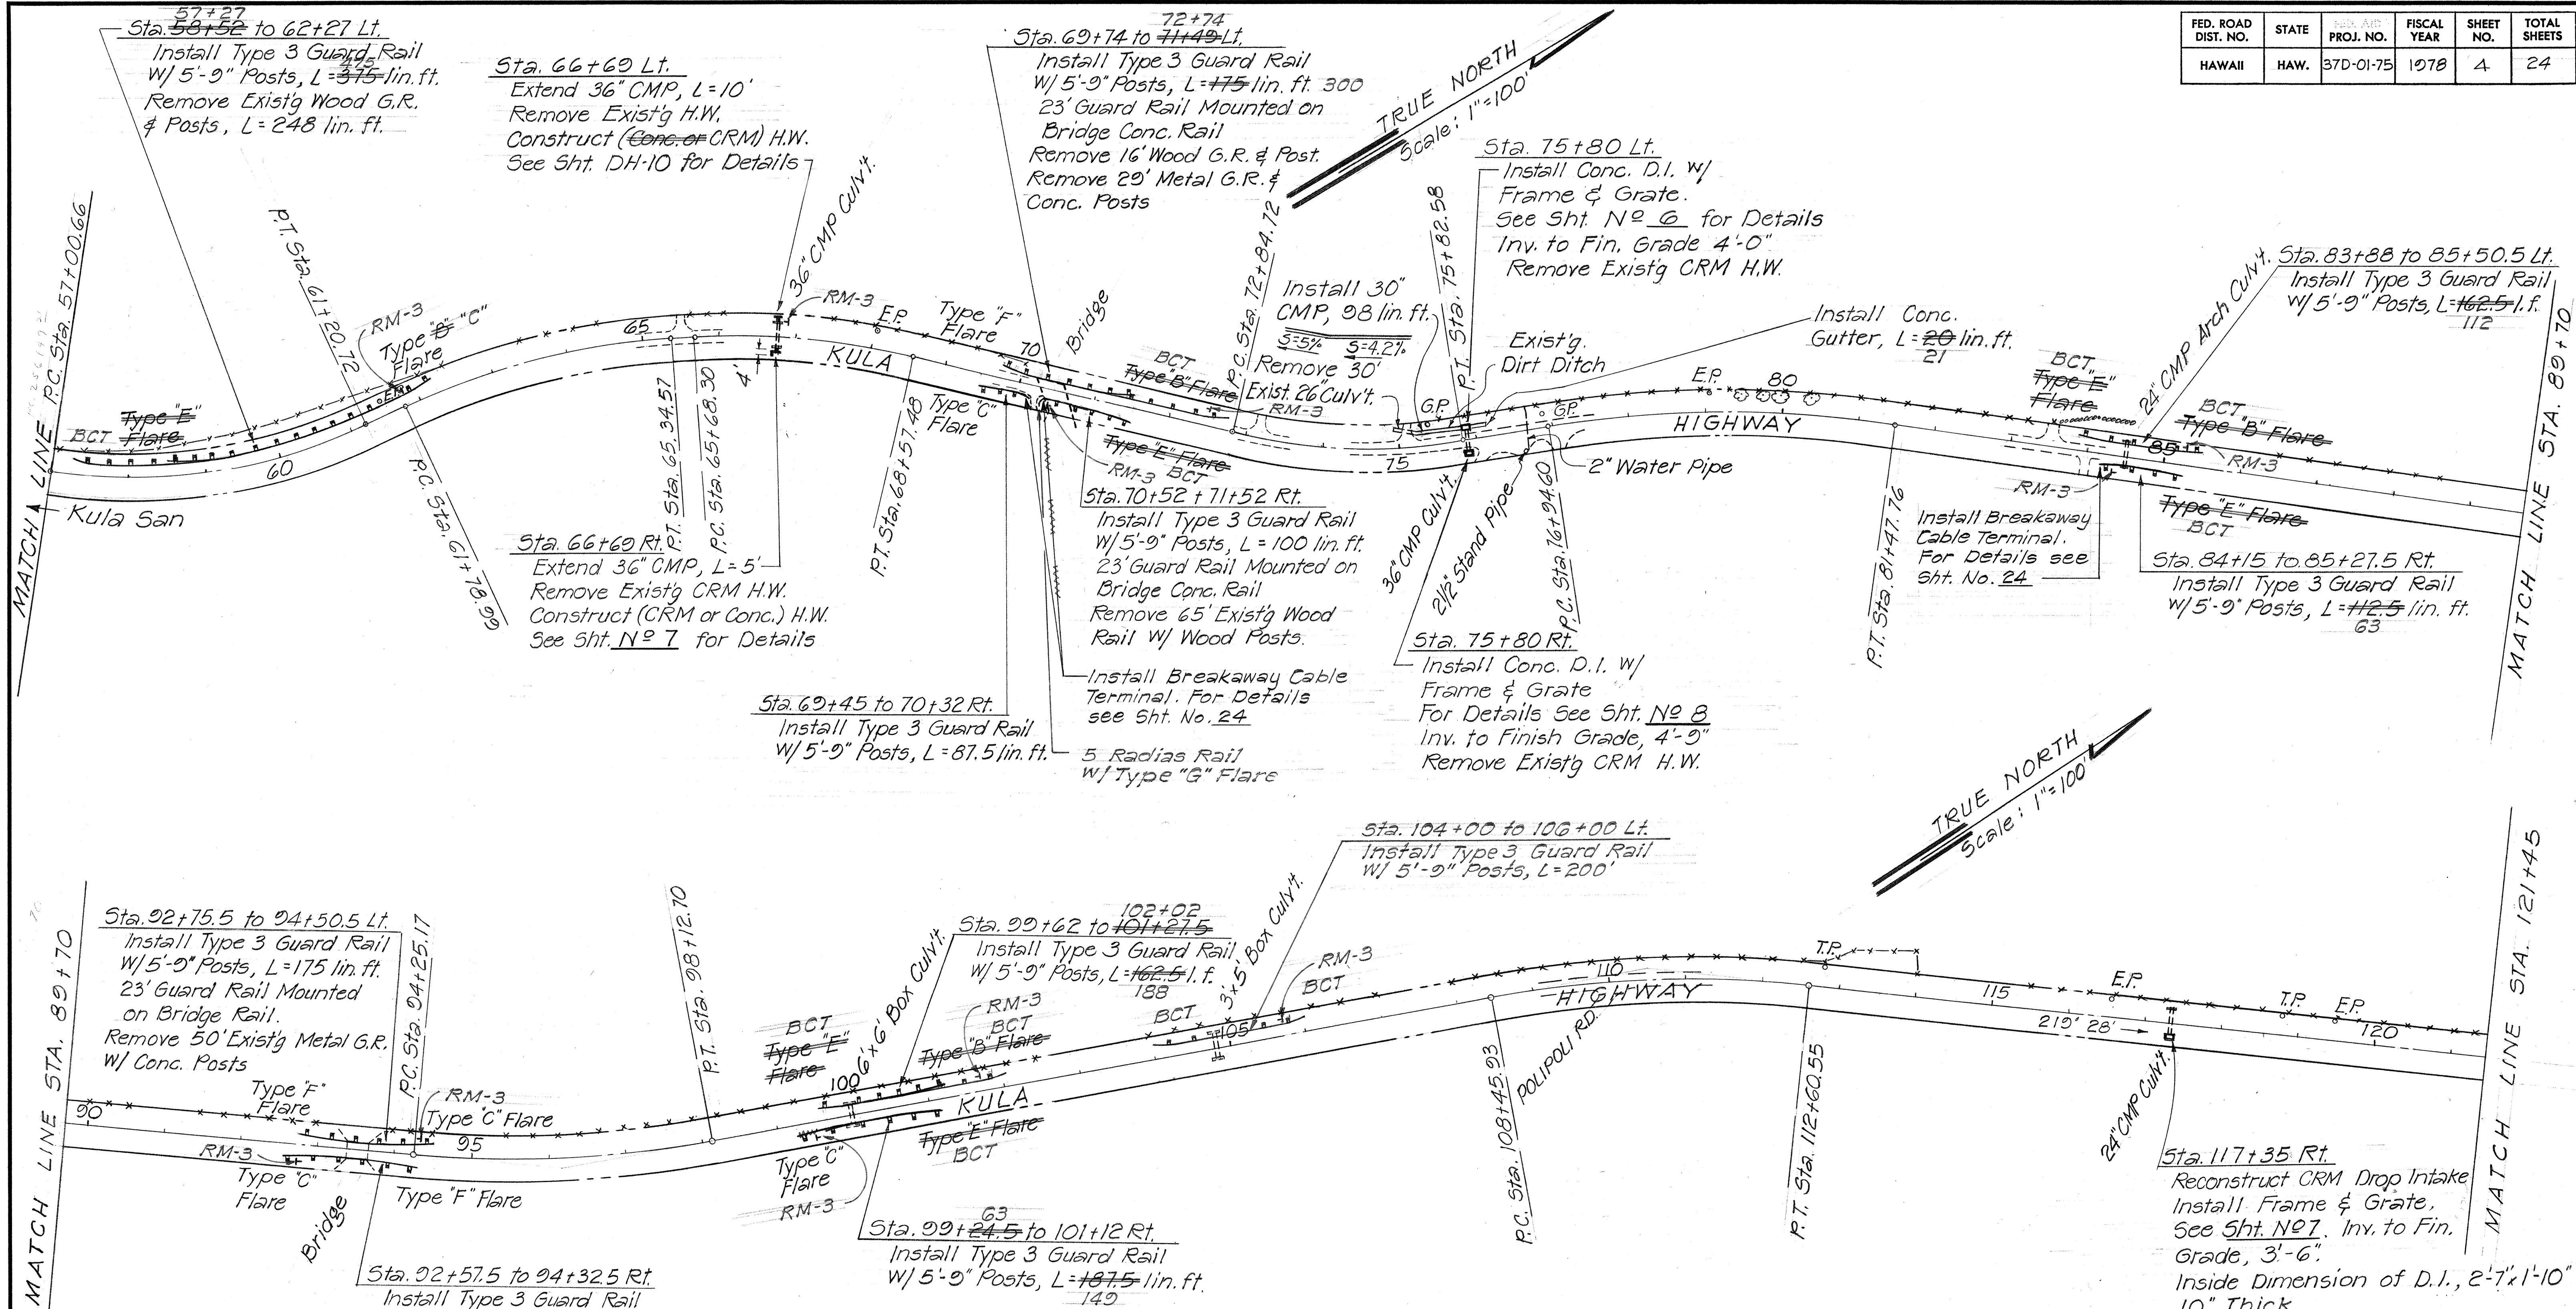

DATE	_____
DESIGNED BY	_____
CHECKED BY	_____
NOTE BOOK	_____
NO.	_____

STATE OF HAWAII
DEPARTMENT OF TRANSPORTATION
HIGHWAYS DIVISION

KULA HIGHWAY
WIDENING & RESURFACING
FROM KAIPOLOI BRIDGE TO KEOKEA
PROJ. NO 37D-01-75

SCALE: AS SHOWN MAY 1975
SHEET No. 2 OF 2 SHEETS