


FED. ROAD DIST. NO.	STATE	PROJ. NO.	FISCAL YEAR	SHEET NO.	TOTAL SHEETS
HAWAII	HAW.	37D-01-75	1978	2	24


GENERAL NOTES

- Single solid stripe, Kaipoi Bridge to Kekaulike Avenue, sand blast or grind as directed by Engineer, and prepare existing A.C. Surface for double yellow stripe. This work will be considered incidental to item 642.01, Pavement Striping.
- All work shall conform to the Standard Specifications for Road and Bridge Construction, dated 1976.
- Prior to filling or resurfacing, the existing surface shall be cleaned as described in Section 310 of the Standard Specifications and all pavement markers as described in Subsection 629.02(B) shall be removed. Payment shall be incidental to A.C. Pavement, Mix V.
- All holes, cracks and large depressions shall be filled and compacted with A.C. Mix V prior to resurfacing. Payment shall be incidental to A.C. Pavement Mix V.
- In general, the A.C. Pavement overlay thickness shall be 1 1/2 inches unless otherwise directed by the Engineer.
- Smooth riding connections shall be constructed at the beginning and at the end of the Project and at all connecting approaches and at extra widenings, as directed by the Engineer.
- The contractors attention is directed to Section 104.04 of the Standard Specifications concerning Maintenance of Traffic.
- Salvage existing signs, RM-3 and metal guard rail; deliver to State Baseyard, Kahului, Maui.
- School Bus turning sign to be removed as directed by Engineer and installed on new 2"x2" galv. sq. tube post. Payment incidental to item 621.51
- Sta. 131+00 Lt. and Sta. 142+25 Rt., signs to be removed and adjusted. Payment incidental to item 621.51.
- Dressing of shoulders incidental to Roadway Excavation item 203.02.
- Extension of existing culverts - Removal of existing Headwall, excavation, culvert cushion bedding material, backfilling, ditch and channel exc., grade to drain, and cleaning of existing culverts shall be considered incidental to each respective corr. metal pipe
- Reconstruction of CRM Drop Intakes- Backfilling, ditch and channel exc., grade to drain and cleaning of existing drop intake shall be considered incidental to item 648.04.
- Constructing new conc. Drop Intakes- Removal of existing Headwall, excavation, backfilling, ditch and channel exc., grade to drain and cleaning of existing culverts shall be considered incidental to item 503.101
- Removal of existing guard rails and guard rail posts shall be considered incidental to item 606.311 and 606.313.
- Connection of new to existing Corr. Metal Pipe Culverts shall receive galvanized standard band coupling. Payment incidental to each respective corr. metal pipe.
- Regulatory and Warning Sign (Construction) with post - After completion of work, these signs shall be dismantled and removed in a neat like manner and delivered to the State Baseyard in Kahului. Payment incidental to item 621.55.

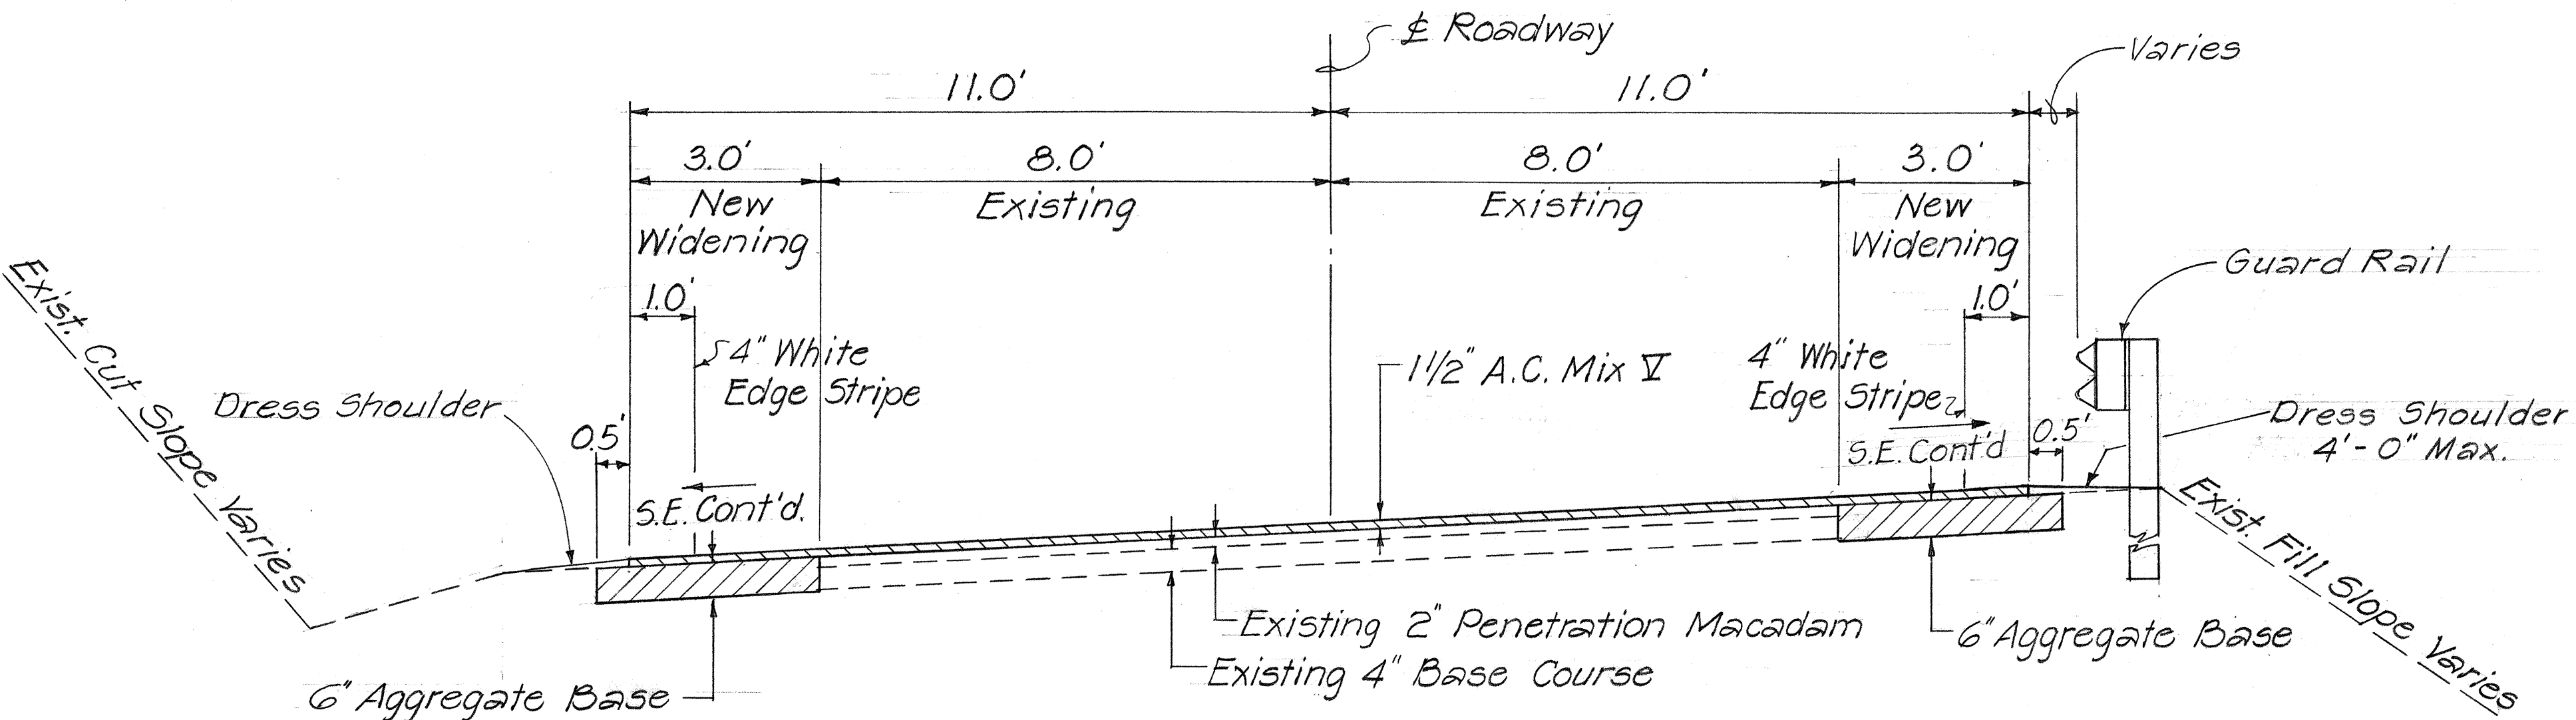

TYPICAL SECTION ON CURVES

Scale: 1/2" = 1'-0"

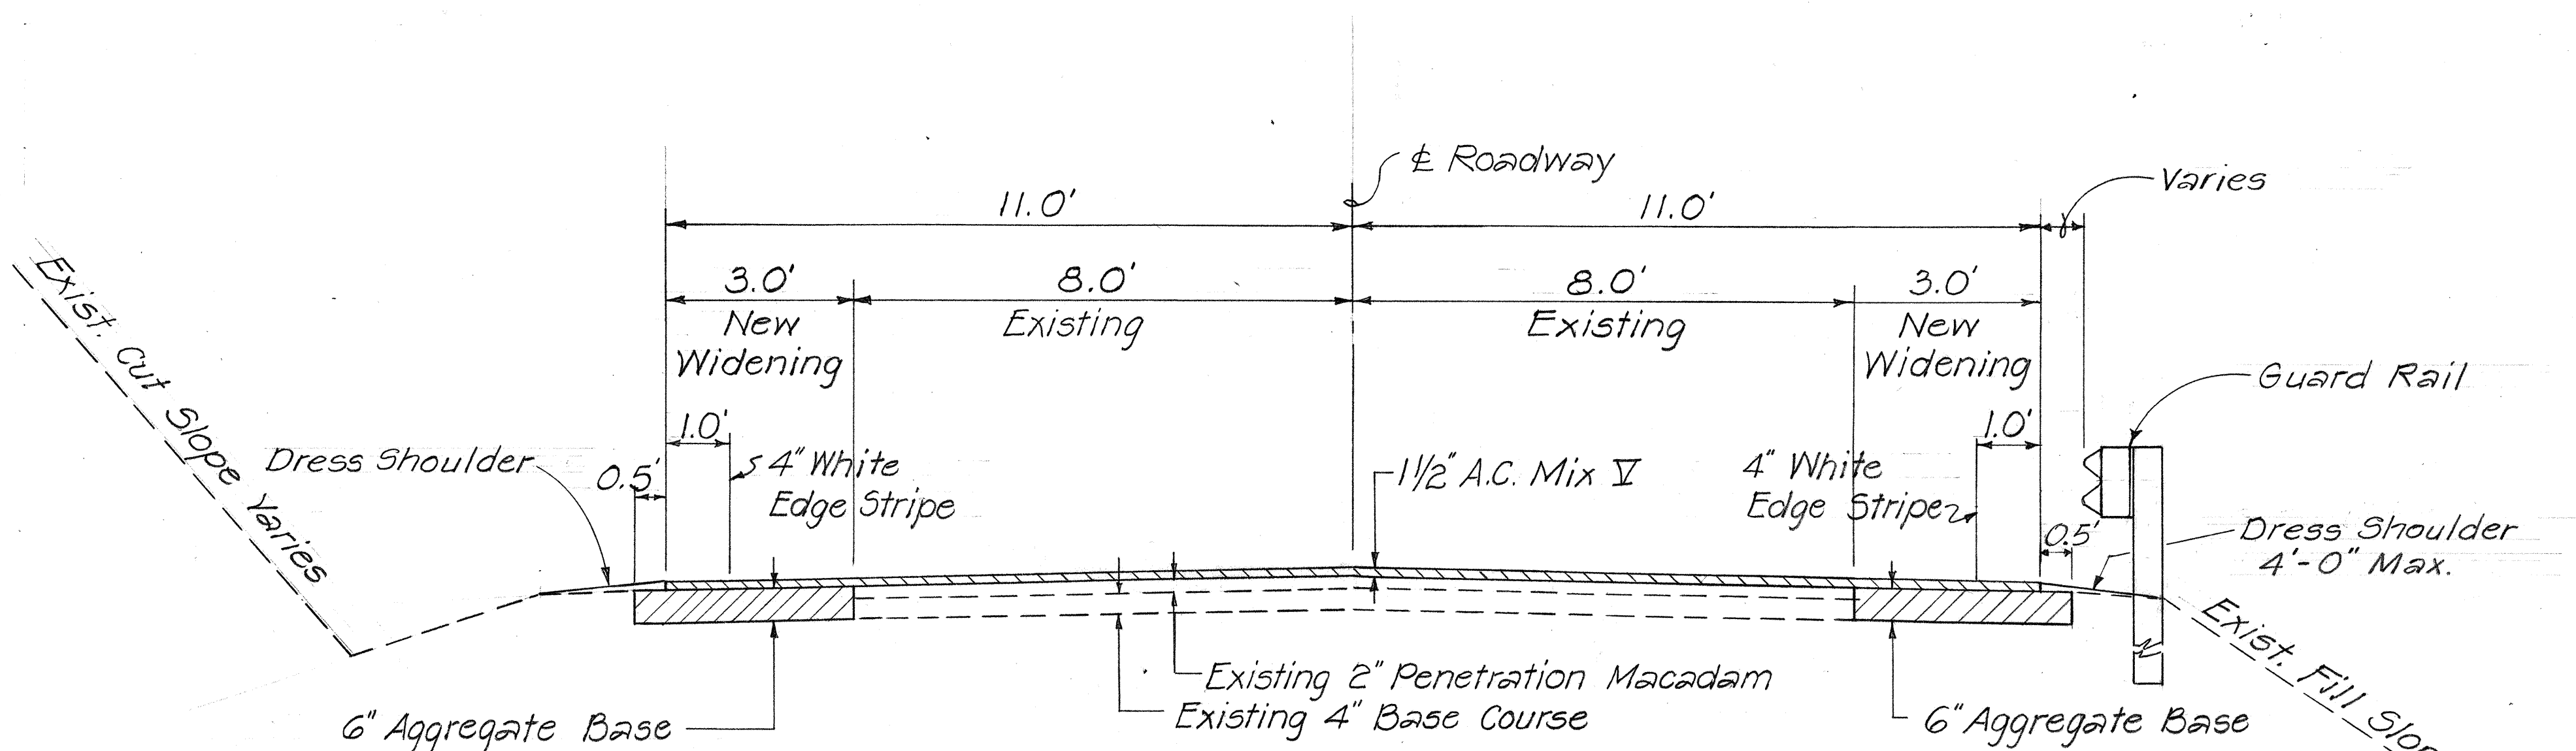

TYPICAL SECTION ON TANGENTS

Scale: 1/2" = 1'-0"

- All new sign posts shall be 2"x2" galv. square tube posts. This shall be considered incidental to item 621.51 or 621.55
- Guard Rail lengths for 5'-5" posts includes special sections. —
 $R=6', L=18'$
 $R=6', L=18'$
 $R=15', L=23.5'$
 Straight Section $L=6'$
- Guard Rail shall be uniformly installed for each spot installation.

STATE OF HAWAII DEPARTMENT OF TRANSPORTATION HIGHWAYS DIVISION	
TYPICAL SECTION & GENERAL NOTES	
KULA HIGHWAY	
PROJ. NO 37D-01-75	
SCALE: AS SHOWN	AUG. 1976
SHEET NO. 1 OF 1 SHEETS	

SURVEY PLOTTED BY	DATE
DESIGNED BY	
NOTED BY	
CHECKED BY	
ORIGINAL PLAN	
NOTE BOOK	
NO.	