


FED. ROAD DIST. NO.	STATE	PROJ. NO.	FISCAL YEAR	SHEET NO.	TOTAL SHEETS
HAWAII	HAW.	37CD-01-80M	1980	3	7

True North
Scale: 1"=100'

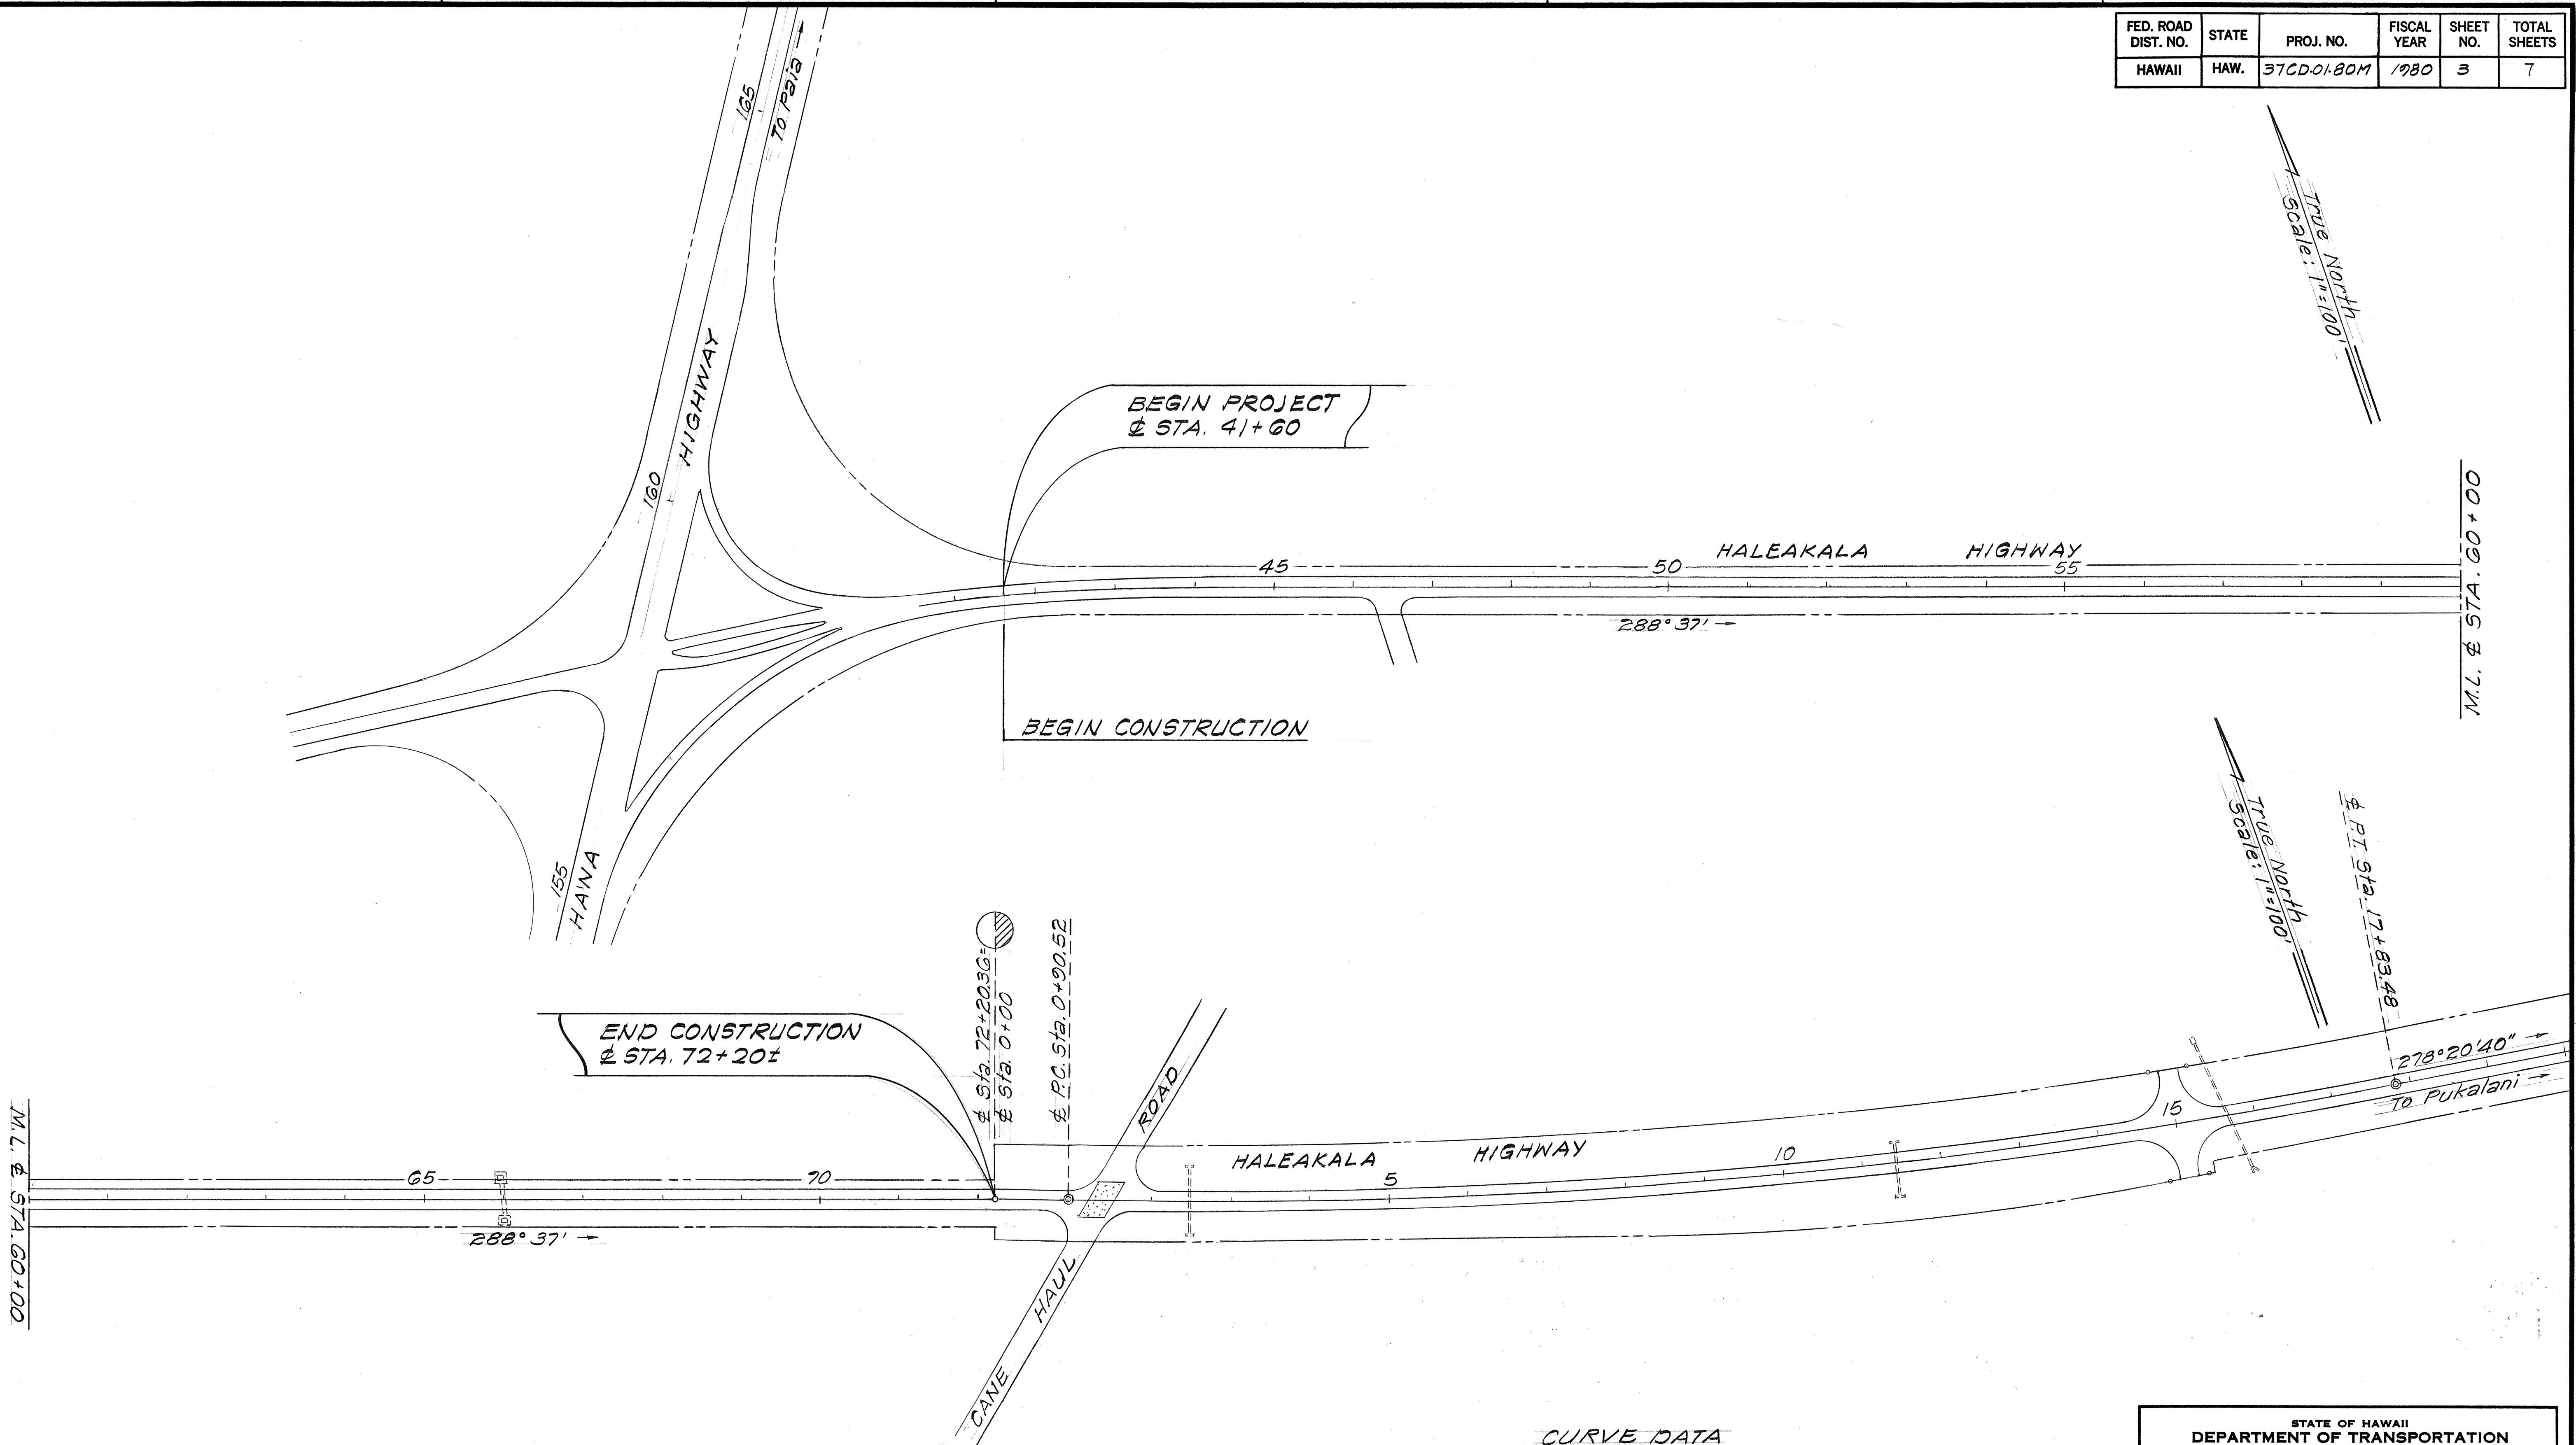

CURVE DATA
 Δ = 12° 41' 50"
 R = 2,639.44'
 T = 849.26'
 C = 1,689.50'
 Lc = 1,692.96'

STATE OF HAWAII
 DEPARTMENT OF TRANSPORTATION
 LAND TRANSPORTATION FACILITIES DIVISION

ROADWAY PLAN


**RESURFACING PORTIONS OF
 HALEAKALA HWY. & KULA HWY.**
 Proj. No. 37CD-01-80M

Scale: As Shown Date: May, 1980

SHEET NO. 1 OF 3 SHEETS

ORIGINAL PLAN	SURVEY PLOTTED BY	DATE
NOTE BOOK	DRAWN BY	"
DESIGNED BY	TRACED BY	"
CHECKED BY	DESIGNED BY	"
No.	CHECKED BY	"

FED. ROAD DIST. NO.	STATE	PROJ. NO.	FISCAL YEAR	SHEET NO.	TOTAL SHEET
HAWAII	HAW.	37CD-01-80M	1980	4	7

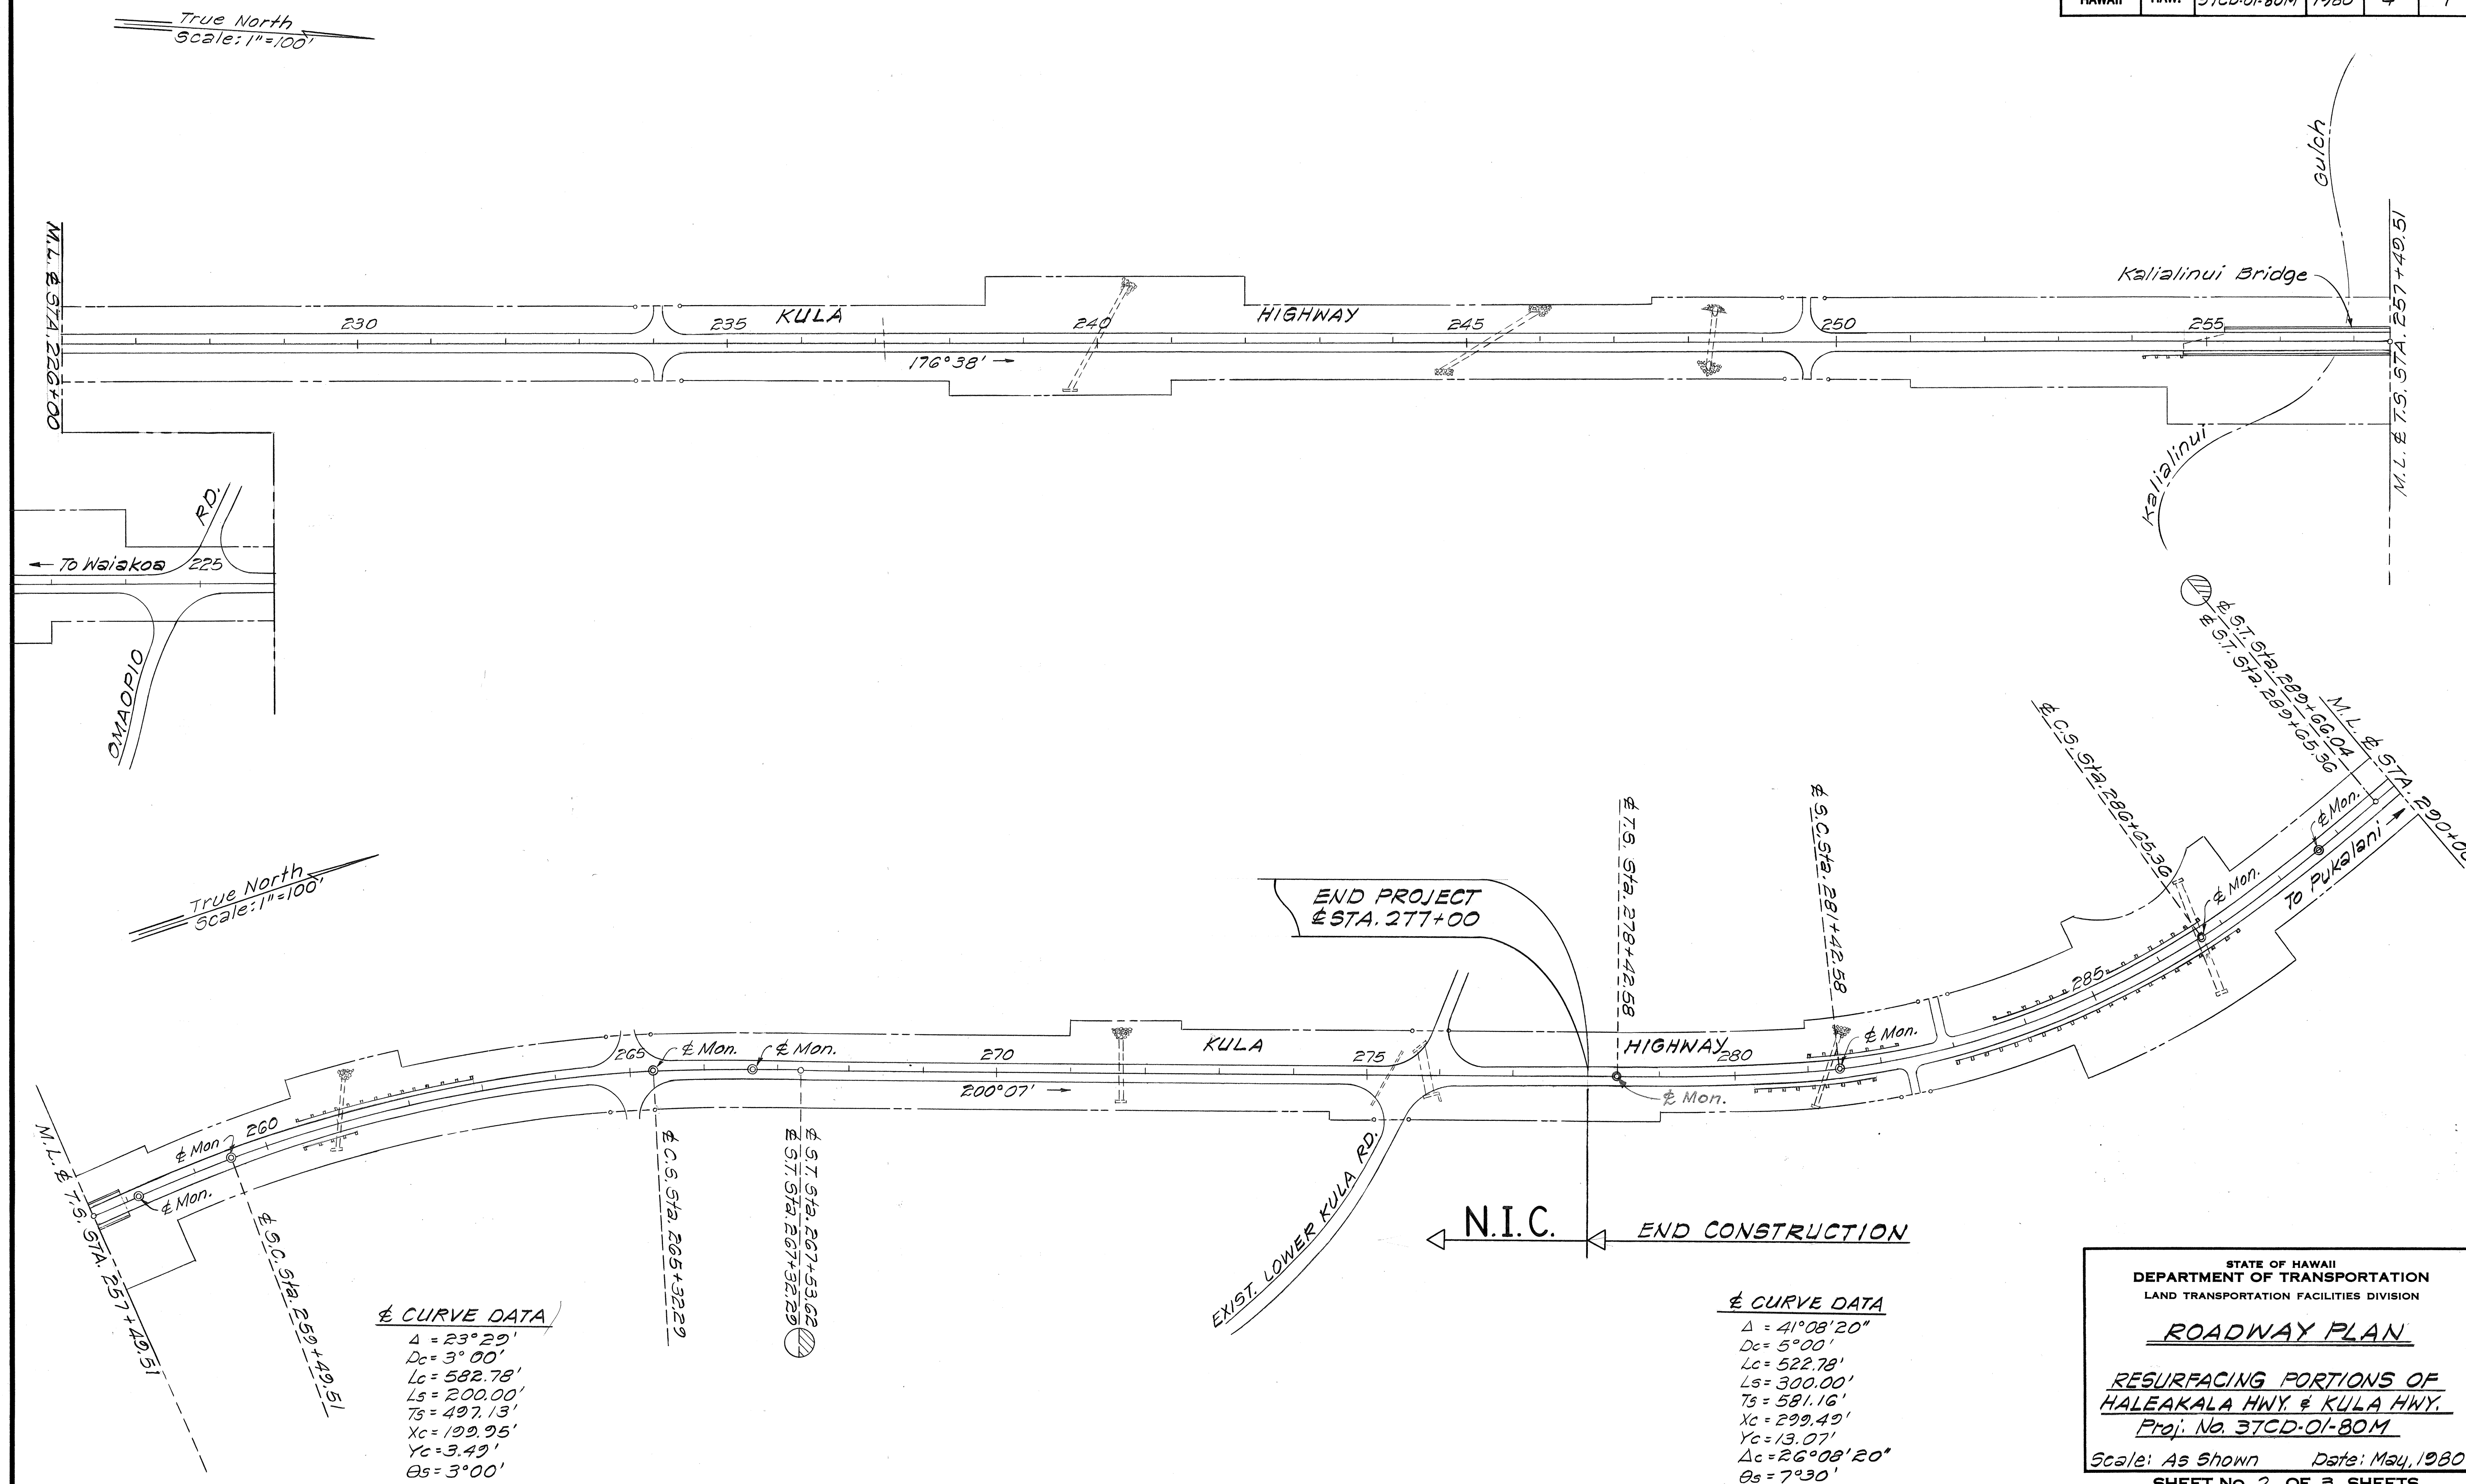

ORIGINAL	SURVEY PLOTTED BY	DATE
PLAN	DRAWN BY	"
	TRACED BY	"
NOTE BOOK	DESIGNED BY	"
	QUANTITIES BY	"
No.	CHECKED BY	"

STATE OF HAWAII
DEPARTMENT OF TRANSPORTATION
LAND TRANSPORTATION FACILITIES DIVISION



ROADWAY PLAN

RESURFACING PORTIONS OF
HALEAKALA HWY. & KULA HWY.
Proj. No. 37CD-01-80M

Scale: As Shown Date: May, 1980

SHEET No. 2 OF 3 SHEETS

FED. ROAD DIST. NO.	STATE	PROJ. NO.	FISCAL YEAR	SHEET NO.	TOTAL SHEETS
HAWAII	HAW.	37CD-01-80M	1980	5	7

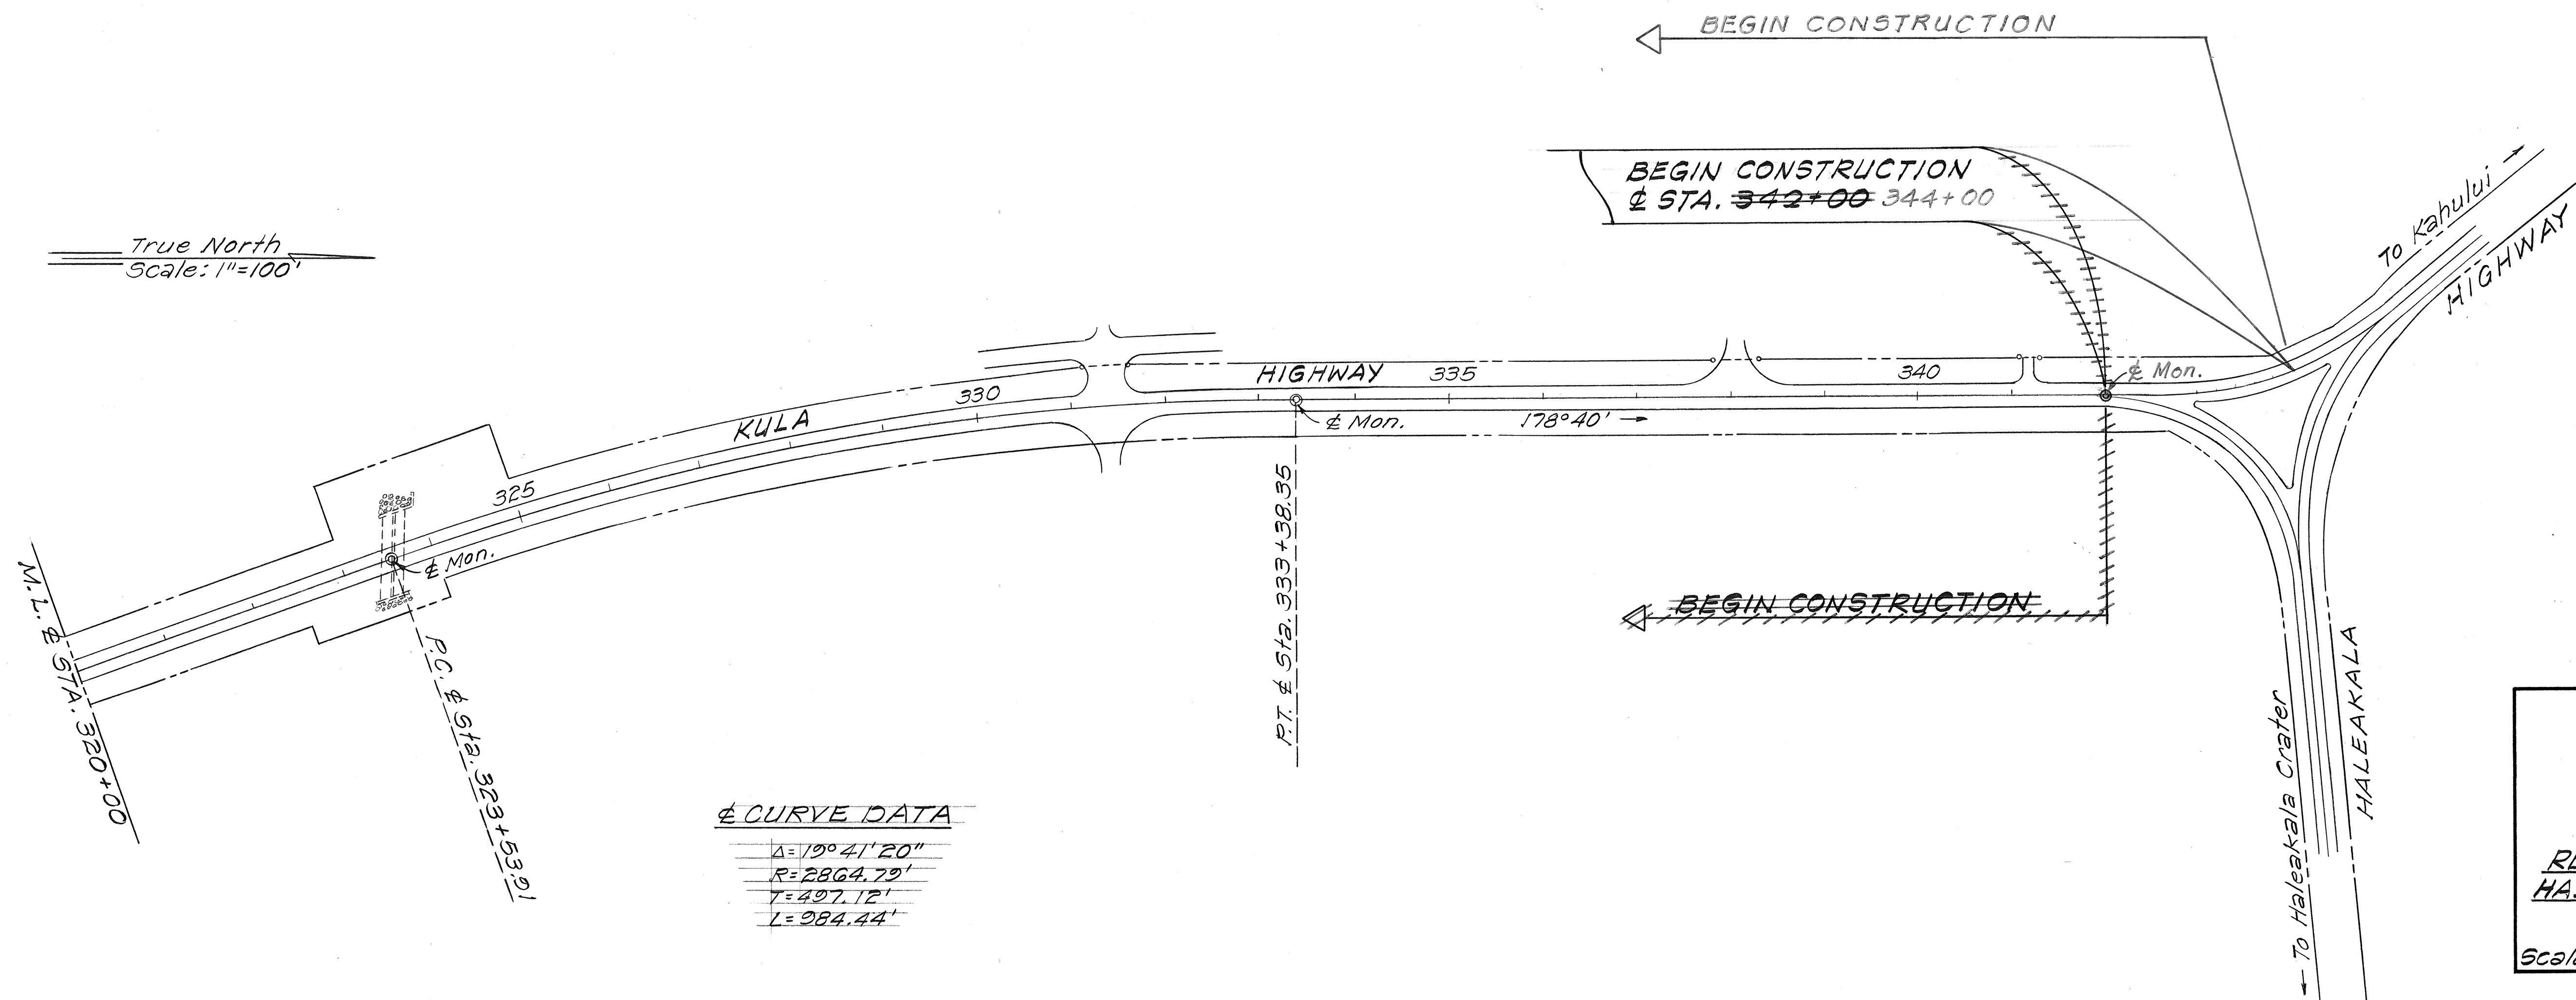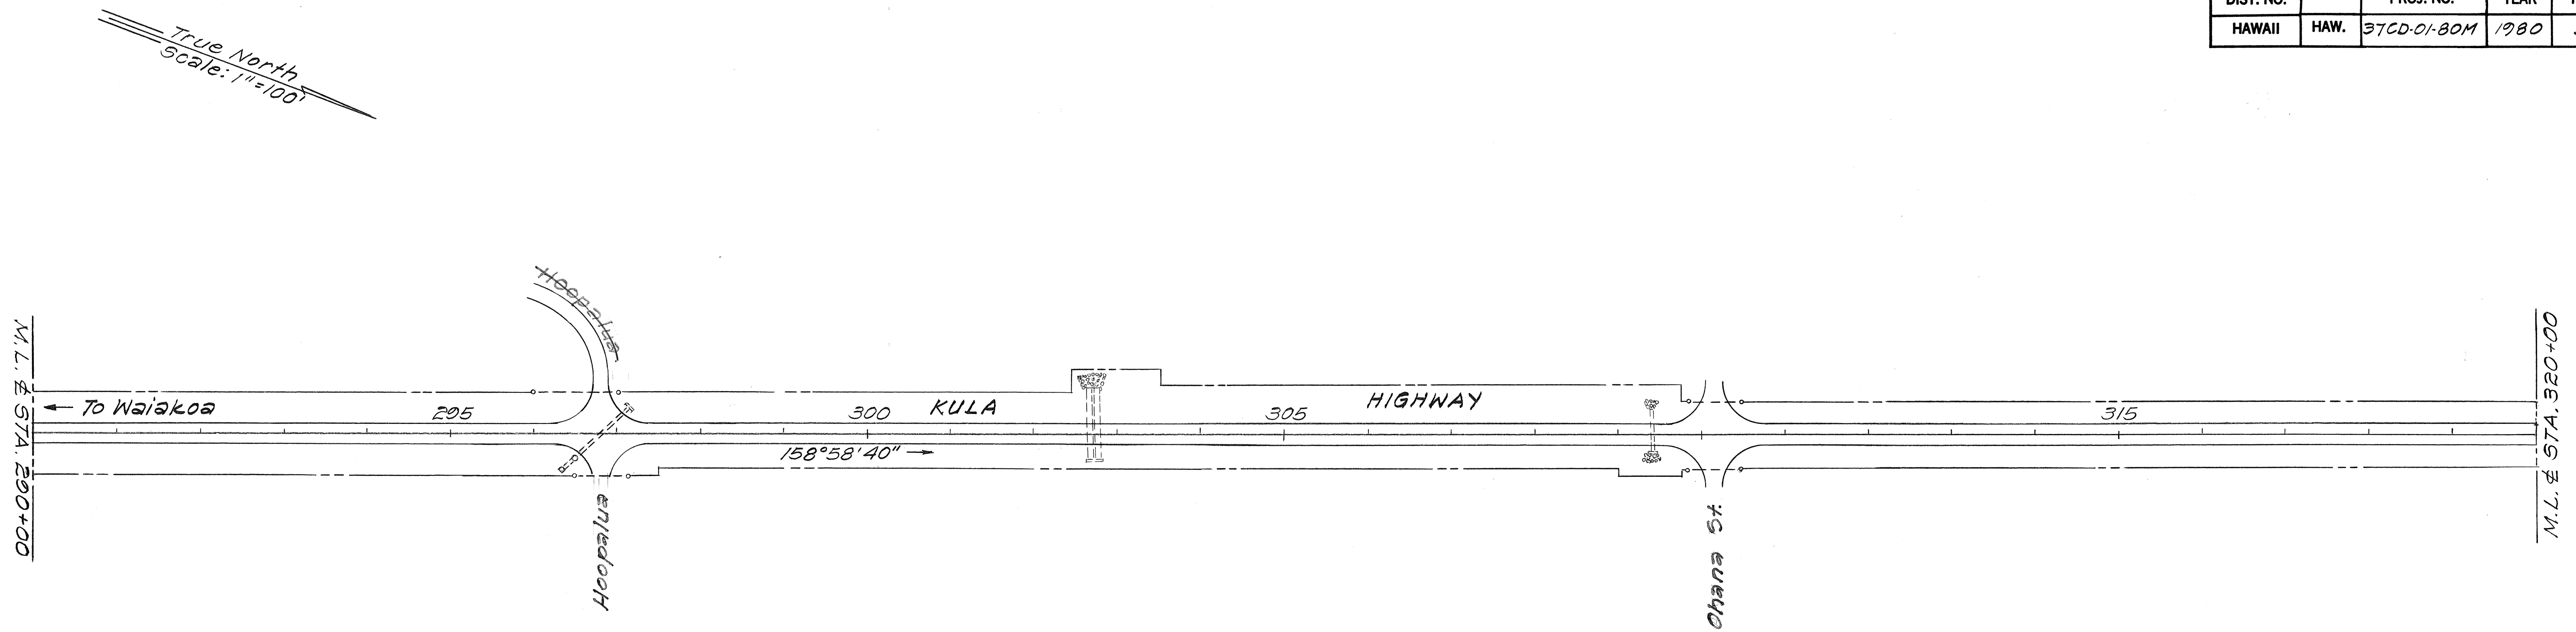

CURVE DATA	
Δ	$19^{\circ}41'20''$
R	$2864.79'$
T	$497.12'$
L	$984.44'$

STATE OF HAWAII
DEPARTMENT OF TRANSPORTATION
LAND TRANSPORTATION FACILITIES DIVISION

ROADWAY PLAN

**RESURFACING PORTIONS OF
HALEAKALA HWY. & KULA HWY.**
Proj. No. 37CD-01-80M

Scale: As Shown Date: May, 1980
SHEET NO. 3 OF 3 SHEETS

ORIGINAL PLAN	SURVEY PLOTTED BY	DATE
NOTE BOOK	DRAWN BY	"
No.	DESIGNED BY	"
	CHECKED BY	"