-	
	INDEX TO DRAWINGS
SHEET NO.	DESCRIPTION
	TITLE SHEET
2	TYPICAL SECTION & GEN. NOTES
3-4	RECONSTRUCTION OF WEAKENED AREAS, SUMMARY OF PAVEMENT MARKING & STRIPING
5-7	PLAN
8-9	STANDARD DETAILS
	• .
m <sub>k</sub> ,	•

548-7490 PHONE



STATE OF HAWAII



DEPARTMENT OF TRANSPORTATION HIGHWAYS DIVISION

"AS-BUILT"


PLANS FOR RESURFACING A PORTION OF


## HALEAKALA HIGHWAY

Kula Highway Junction towards Haliimaile Road

PROJECT NO. 37C-01-81M

DISTRICT OF MAKAWAO
ISLAND OF MAUI

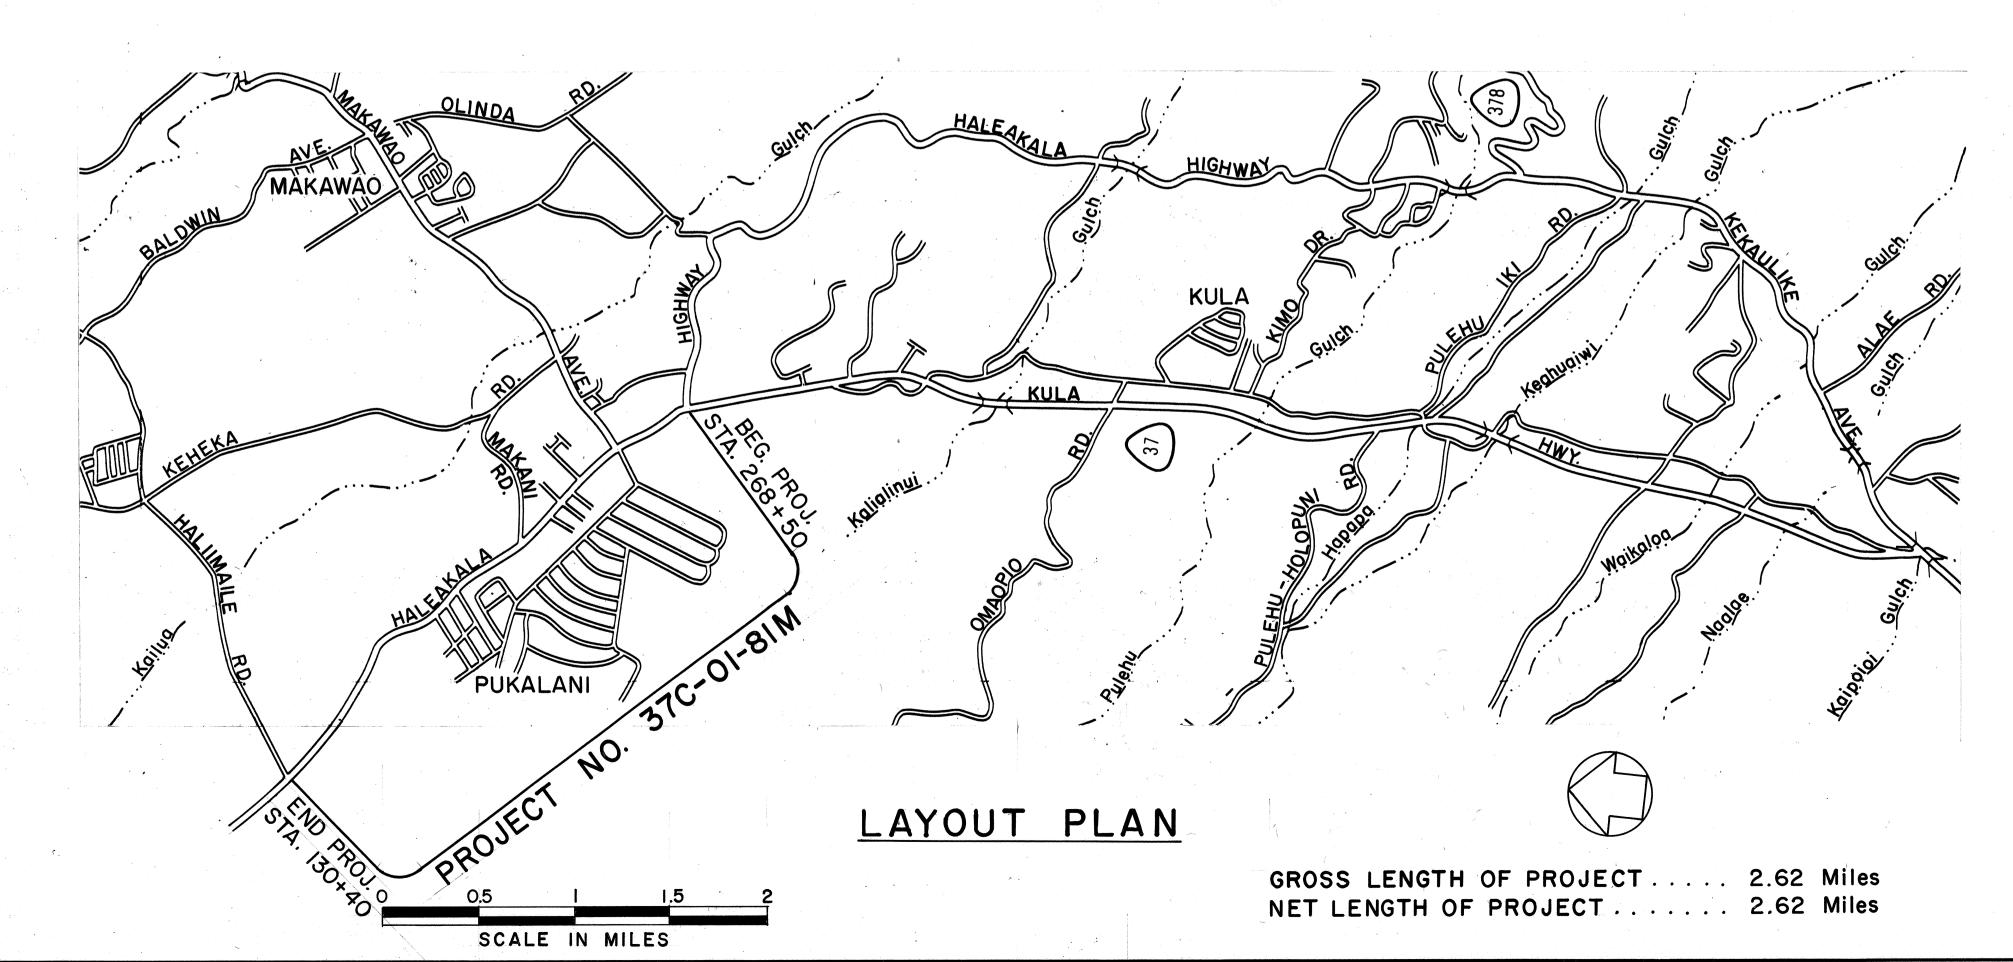

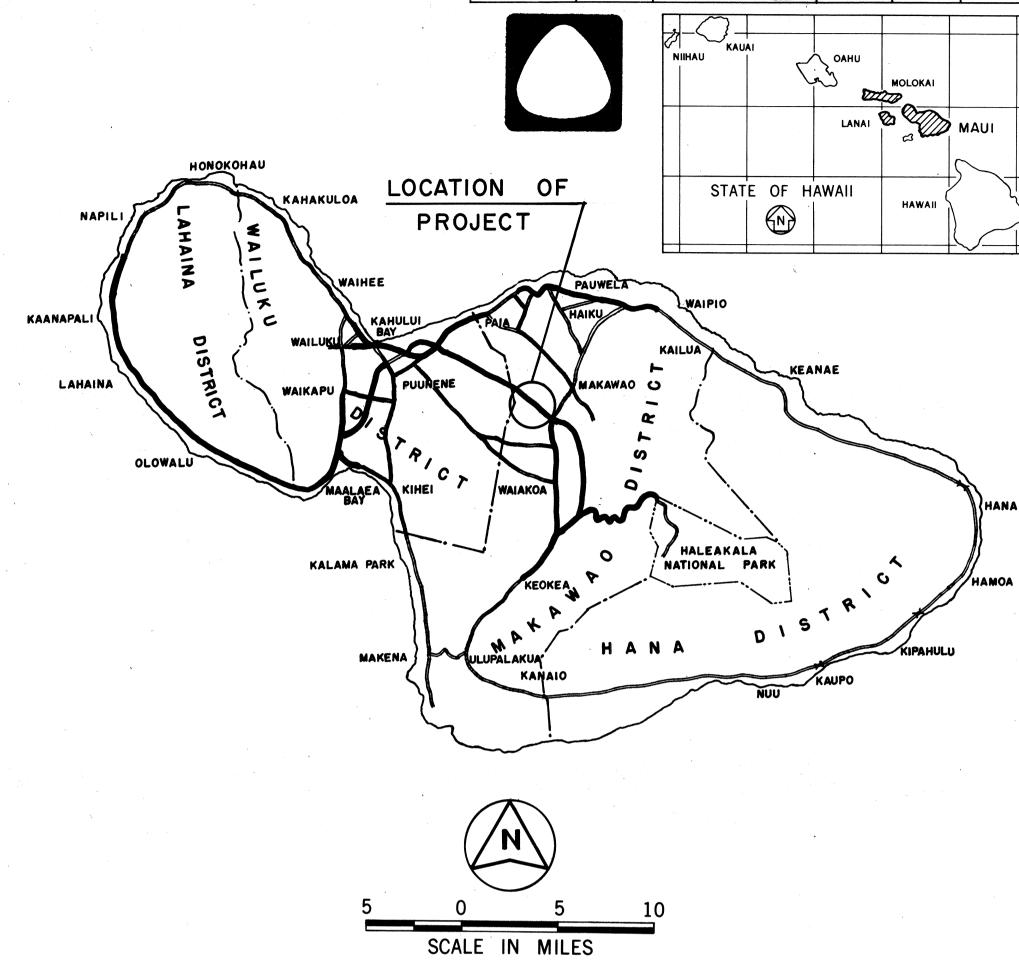

FED. ROAD DIST. NO.

37C-01-81M 1981

FEDERAL AID PROJECTS PREVIOUSLY CONSTRUCTED OR UNDER CONSTRUCTION

ALL CHANGES MADE DURING CONSTRUCTION HAVE BEEN INCORPORATED ON THESE PLANS IN RED EXCEPT CHANGES IN THE ORIGINAL THEORETICAL QUANTITIES. FOR ACTUAL QUANTITIES, REFER TO PROJECT LEDGER AND/OR COMPUTATION BOOK.

Pary & Baker
RESIDENT ENGINEER

4/6/82 DATE

DEPARTMENT OF TRANSPORTATION
STATE OF HAWAII

APPROVED:

Grant Higashianna 5-15-81

DIR. OF TRANSPORTATION DATE