


<u>CURVE DATA</u>		
①	②	③
$\Delta = 51^{\circ} 30' 00''$	$\Delta = 90^{\circ} 00' 00''$	$\Delta = 14^{\circ} 29' 56''$
$\Delta/2 = 25^{\circ} 45' 00''$	$\Delta/2 = 45^{\circ} 00' 00''$	$\Delta/2 = 7^{\circ} 14' 58''$
$R = 45'$	$R = 28'$	$R = 160'$
$T = 21.71'$	$T = 28.00'$	$T = 20.35'$
$Ch = 39.10'$	$Ch = 39.60'$	$Ch = 40.38'$
$Lc = 40.45'$	$Lc = 43.98'$	$Lc = 40.49'$



5

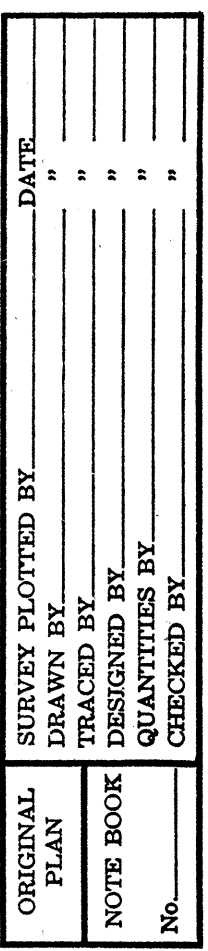