
	INDEX TO DRAWINGS	
SHEET NO.	DESCRIPTION	
I	TITLE SHEET	
2	TYPICAL ROADWAY SECTIONS	
3	LEGEND AND NOTES	
4	TRAFFIC CONTROL PLAN	
5-6	GEOMETRICS AND STRIPING PLAN	
7-8	GRADING AND DEMOLITION PLAN	
9-10	PROFILES	
11-12,12A	CROSS SECTIONS	
13	TRAFFIC SIGNAL PLAN	
14	DRAINAGE DETAILS	
15-16	TYPICAL DETAILS OF WHEELCHAIR RAMPS	
① 17-28	STANDARD DETAILS	
Ph. 1984 - 1984 - 1984 - 1984 - 1984 - 1984 - 1984 - 1984 - 1984 - 1984 - 1984 - 1984 - 1984 - 1984 - 1984 - 1		





STATE OF HAWAII

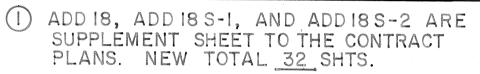

DEPARTMENT OF TRANSPORTATION HIGHWAYS DIVISION


HONOLULU, HAWAII


"AS BUILT"

PLANS FOR

HALEAKALA HIGHWAY
INTERSECTION IMPROVEMENTS
AT PUKALANI STREET
PROJECT NO. 37C-02-82

DISTRICT OF MAKAWAO
ISLAND OF MAUI

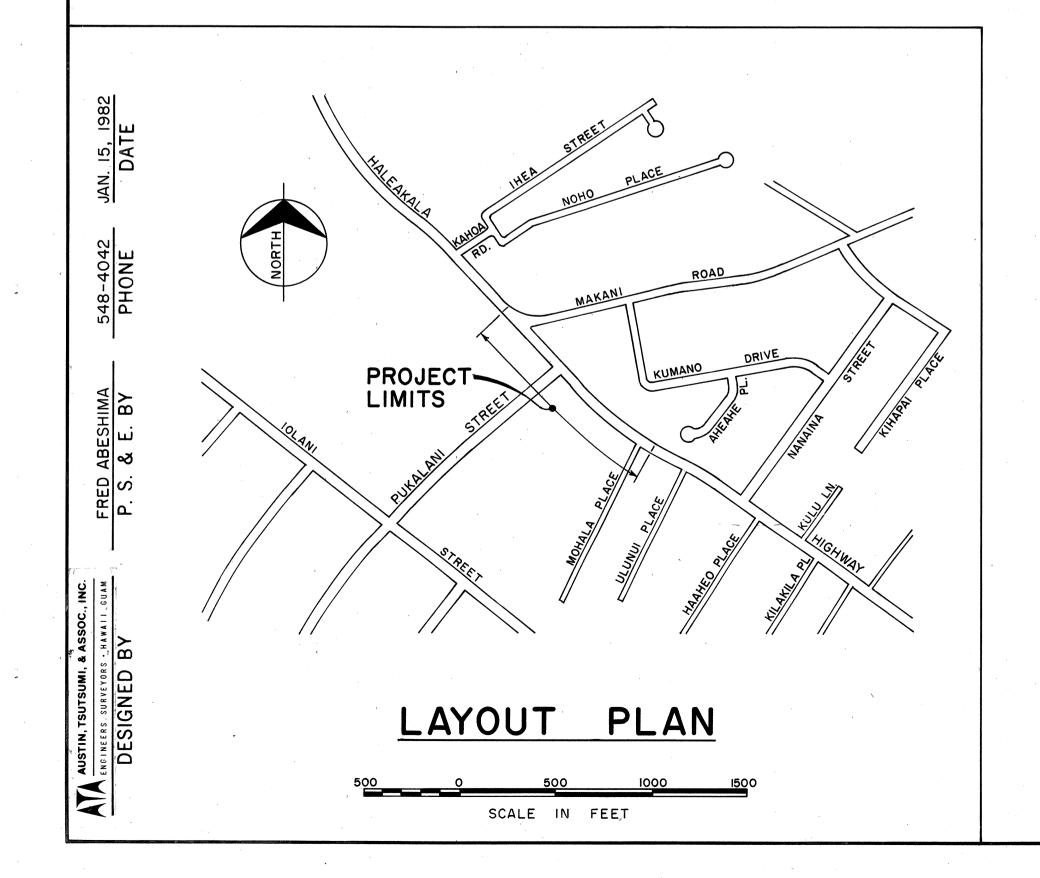

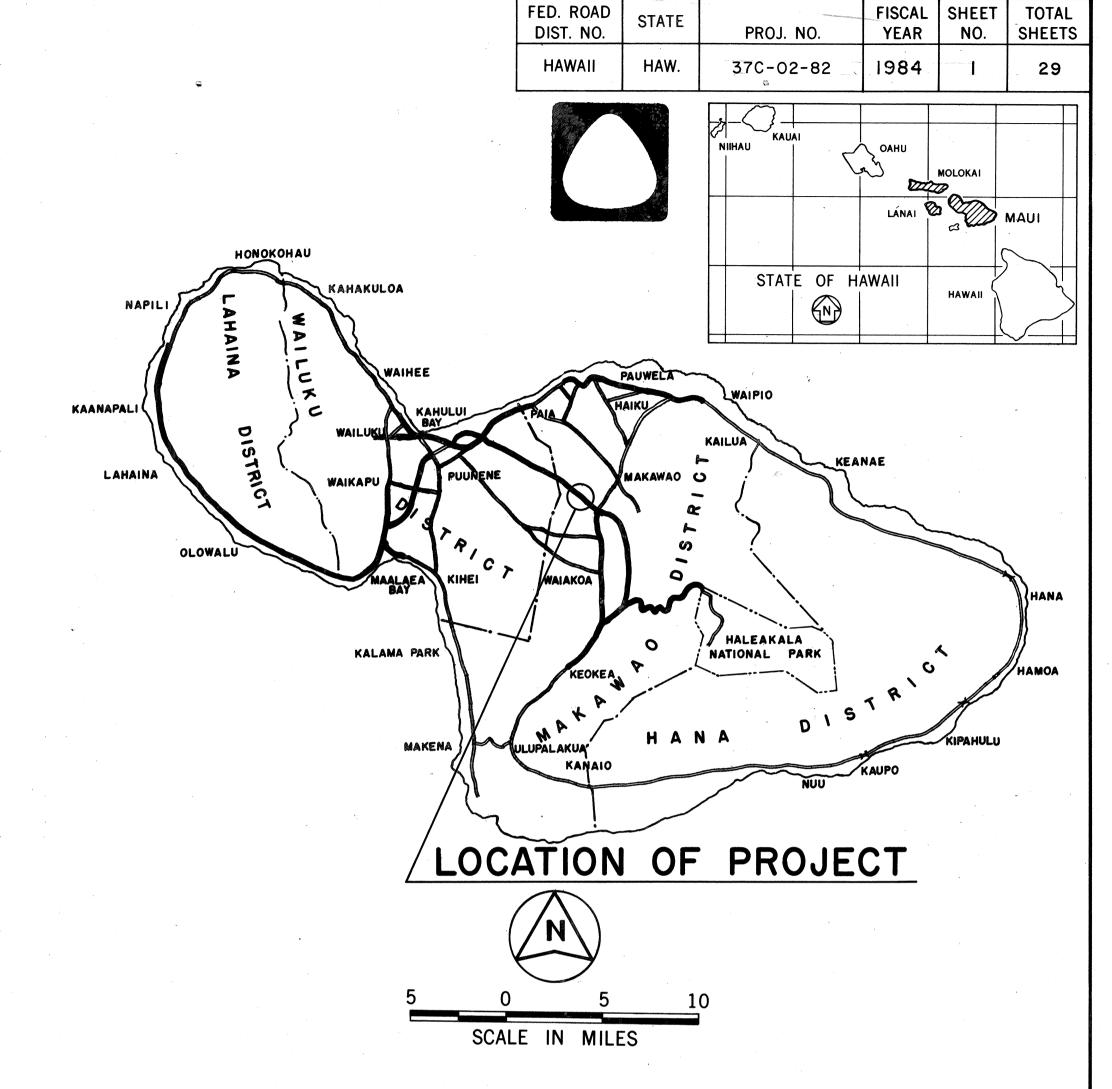

FEDERAL AID PROJECTS PREVIOUSLY CONSTRUCTED OR UNDER CONSTRUCTION

ALL CHANGES MADE DURING CONSTRUCTION HAVE BEEN INCORPORATED ON THESE PLANS IN RED EXCEPT CHANGES IN THE ORIGINAL THEORETICAL QUANTITIES, FOR ACTUAL QUANTITIES, REFER TO PROJECT LEDGER AND / OR COMPUTATION BOOK.

Manuel J. Silva RESIDENT ENGINEER

25 June 84 DATE

DEPARTMENT OF TRANSPOR	RTATION
APPROVED:	۸ ·
Mary D. Ason	2/2/53
DIR. OF TRANSPORTATION	DATE