

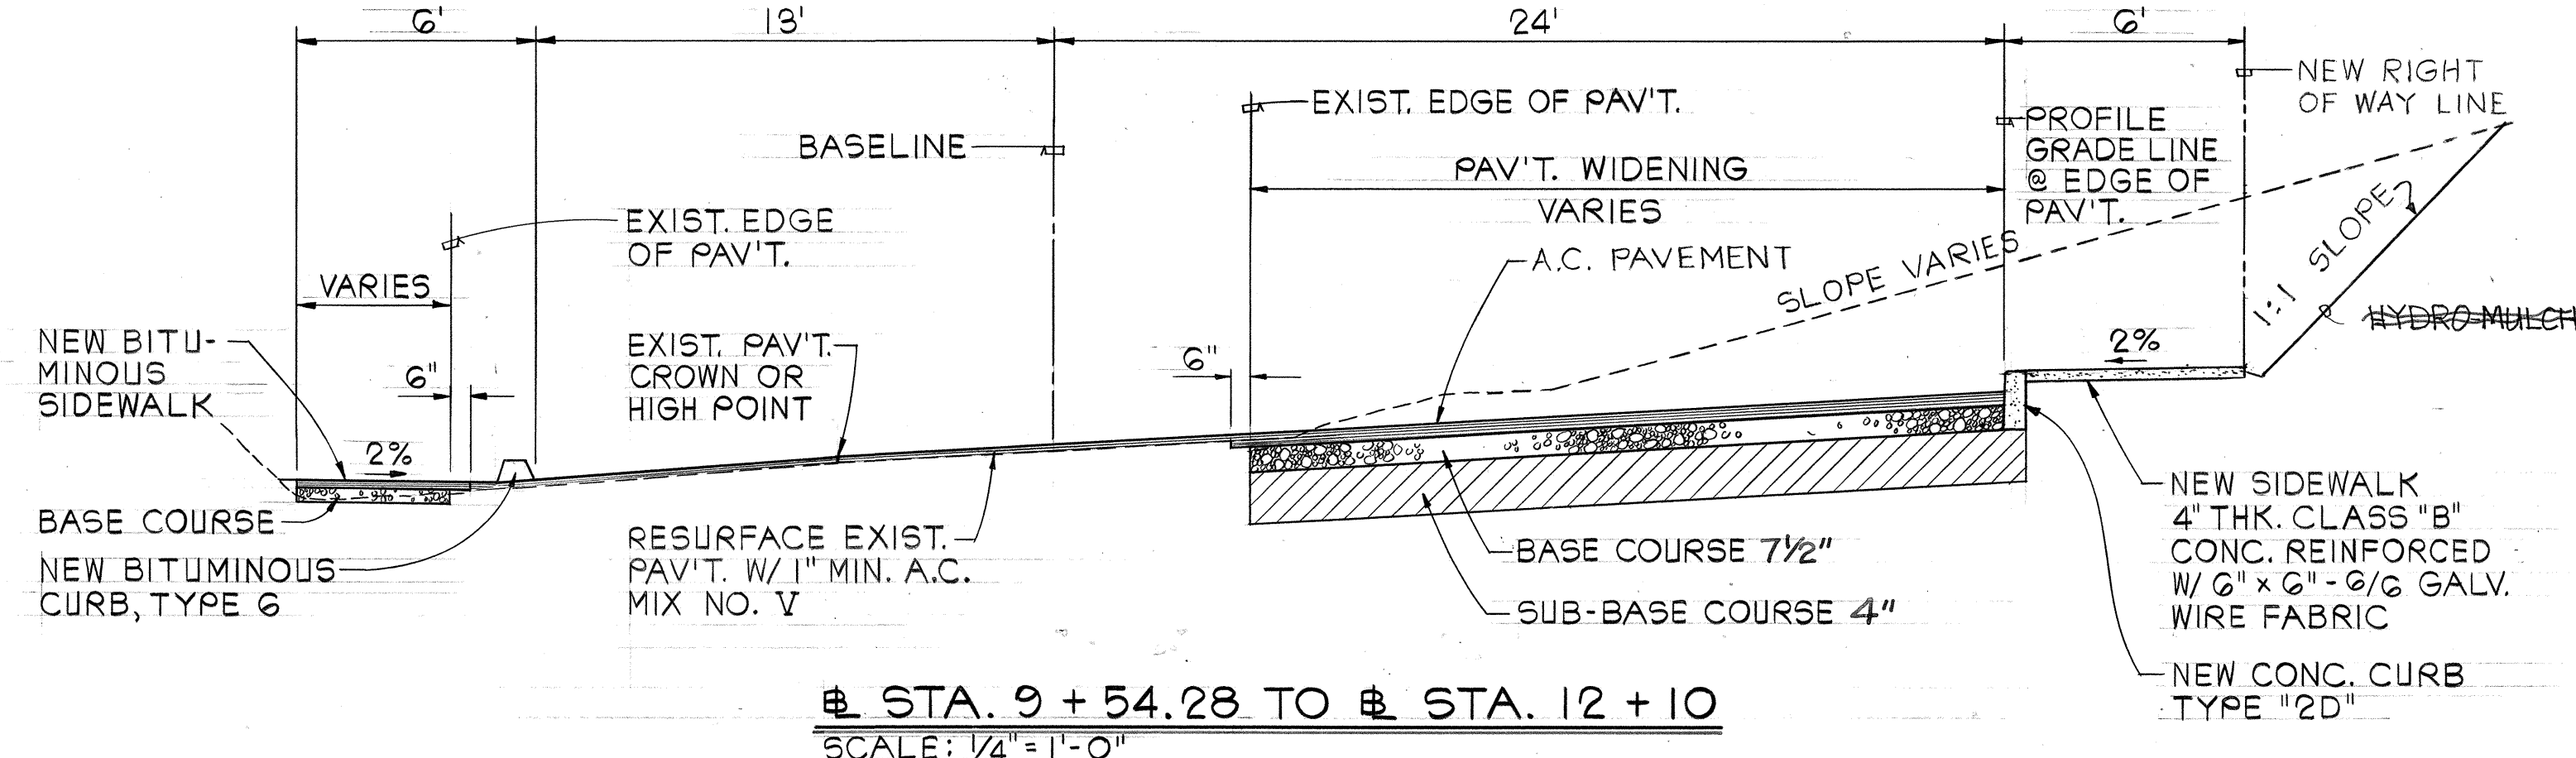
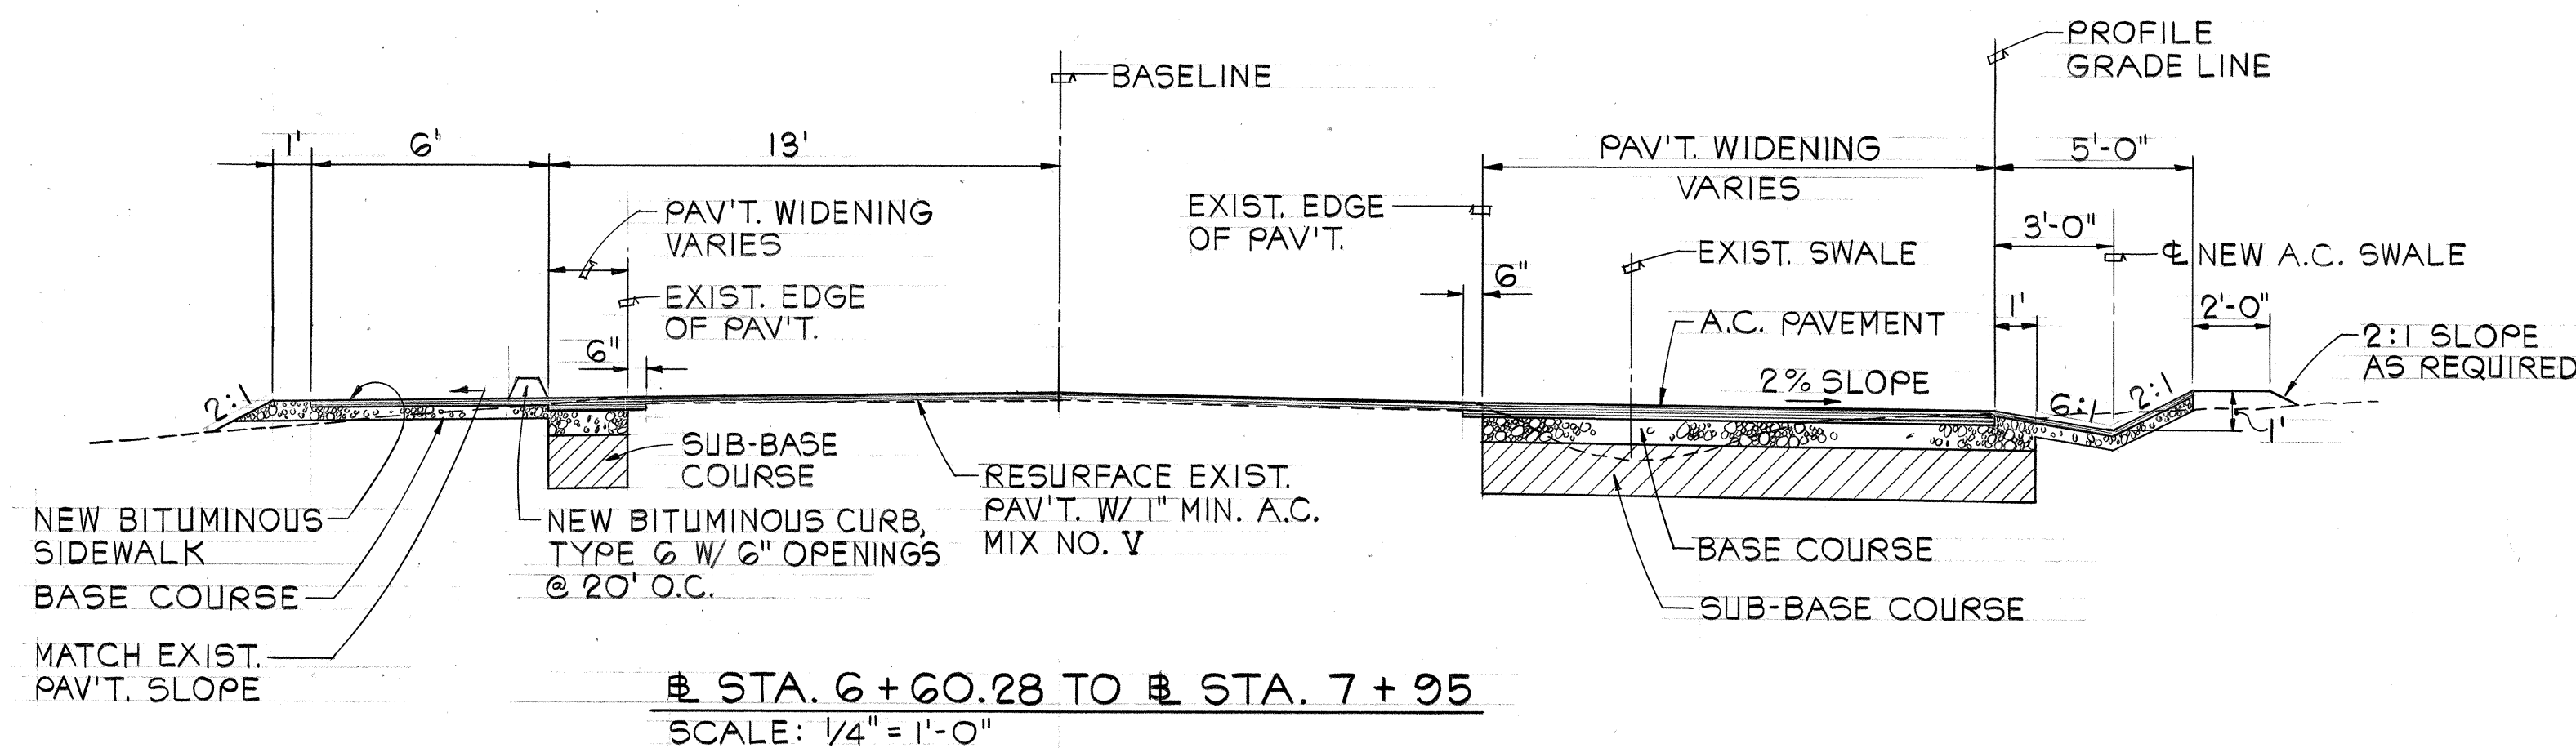
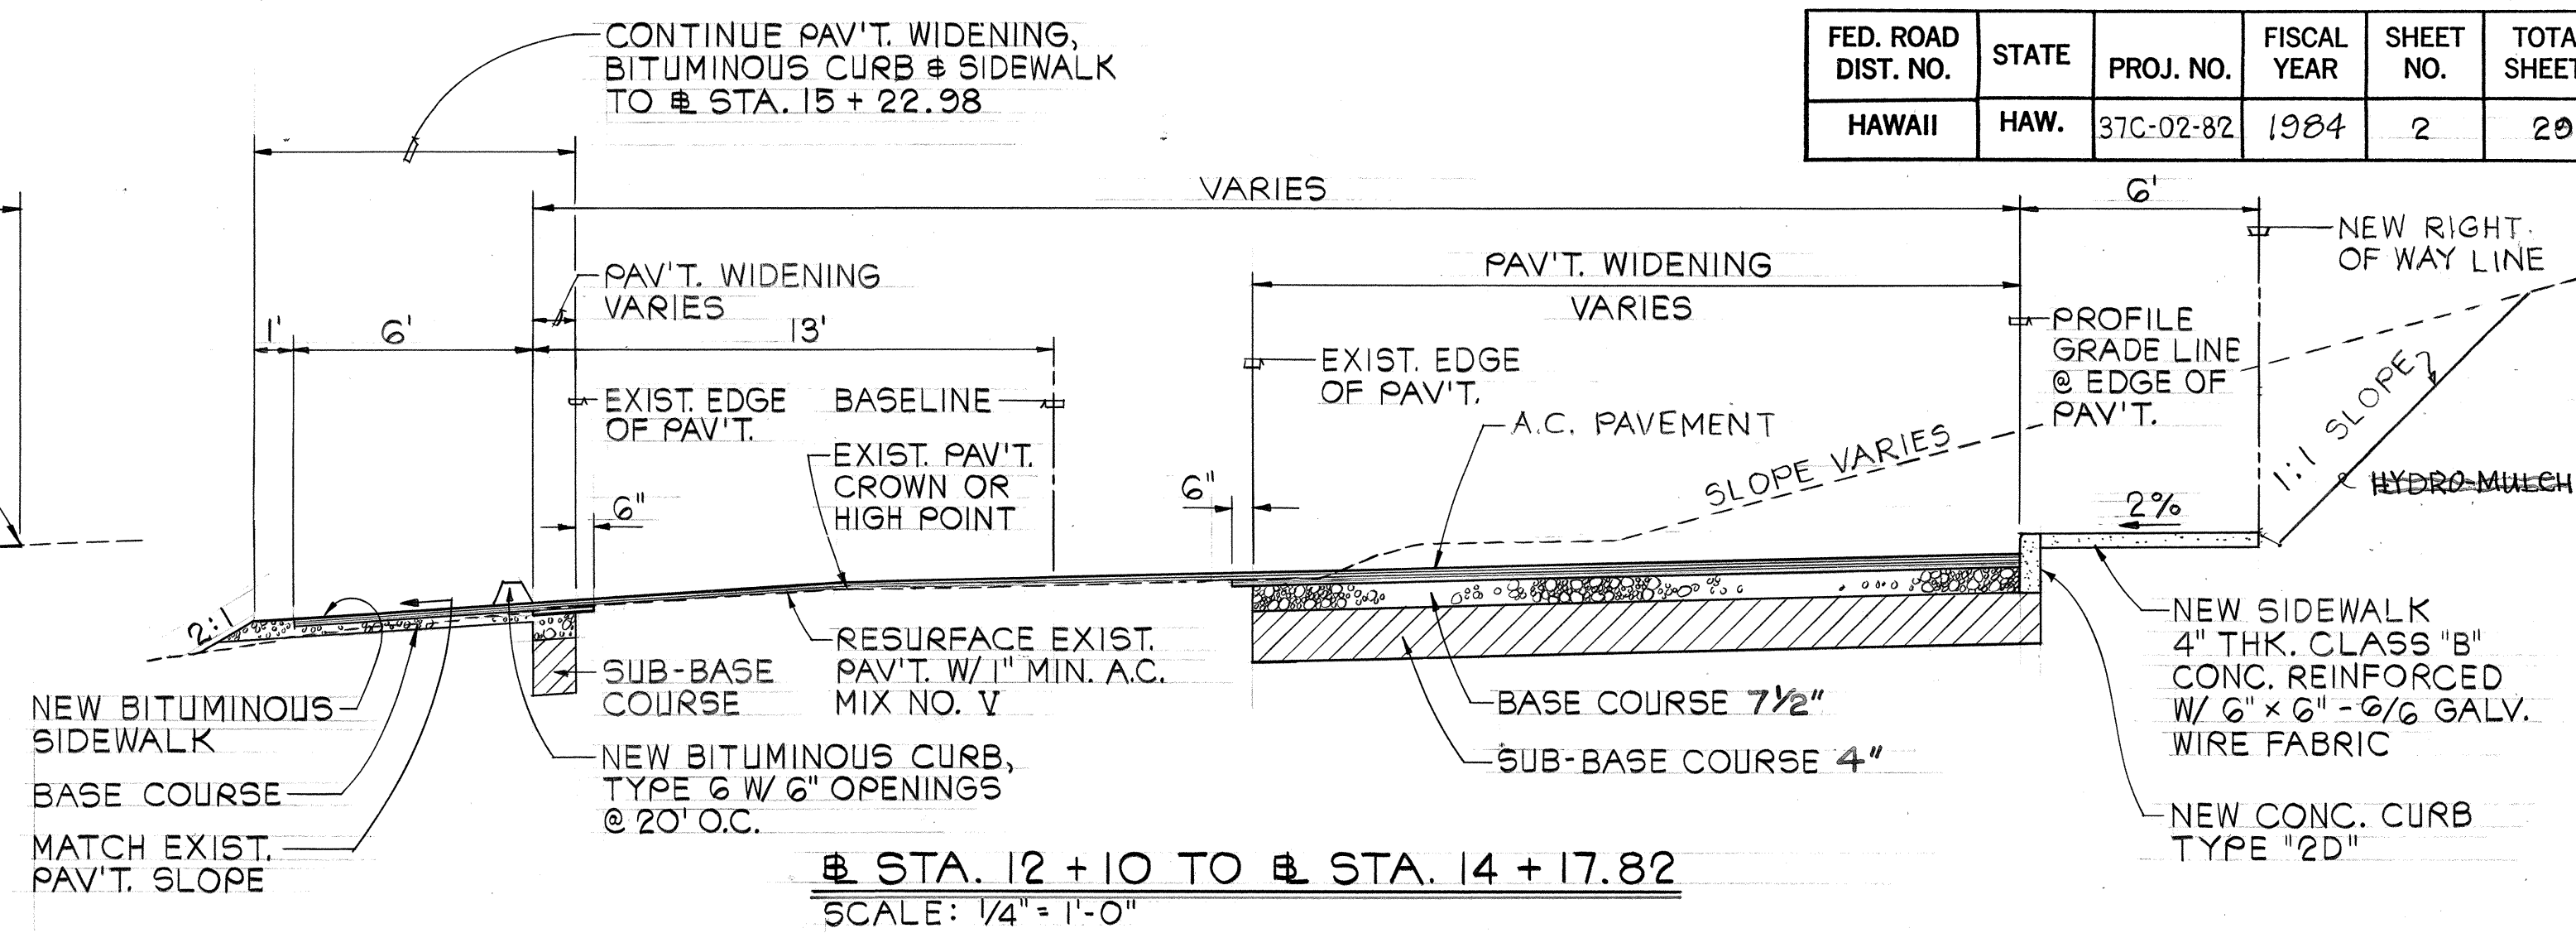


FED. ROAD DIST. NO.	STATE	PROJ. NO.	FISCAL YEAR	SHEET NO.	TOTAL SHEETS
HAWAII	HAW.	37C-02-82	1984	2	20

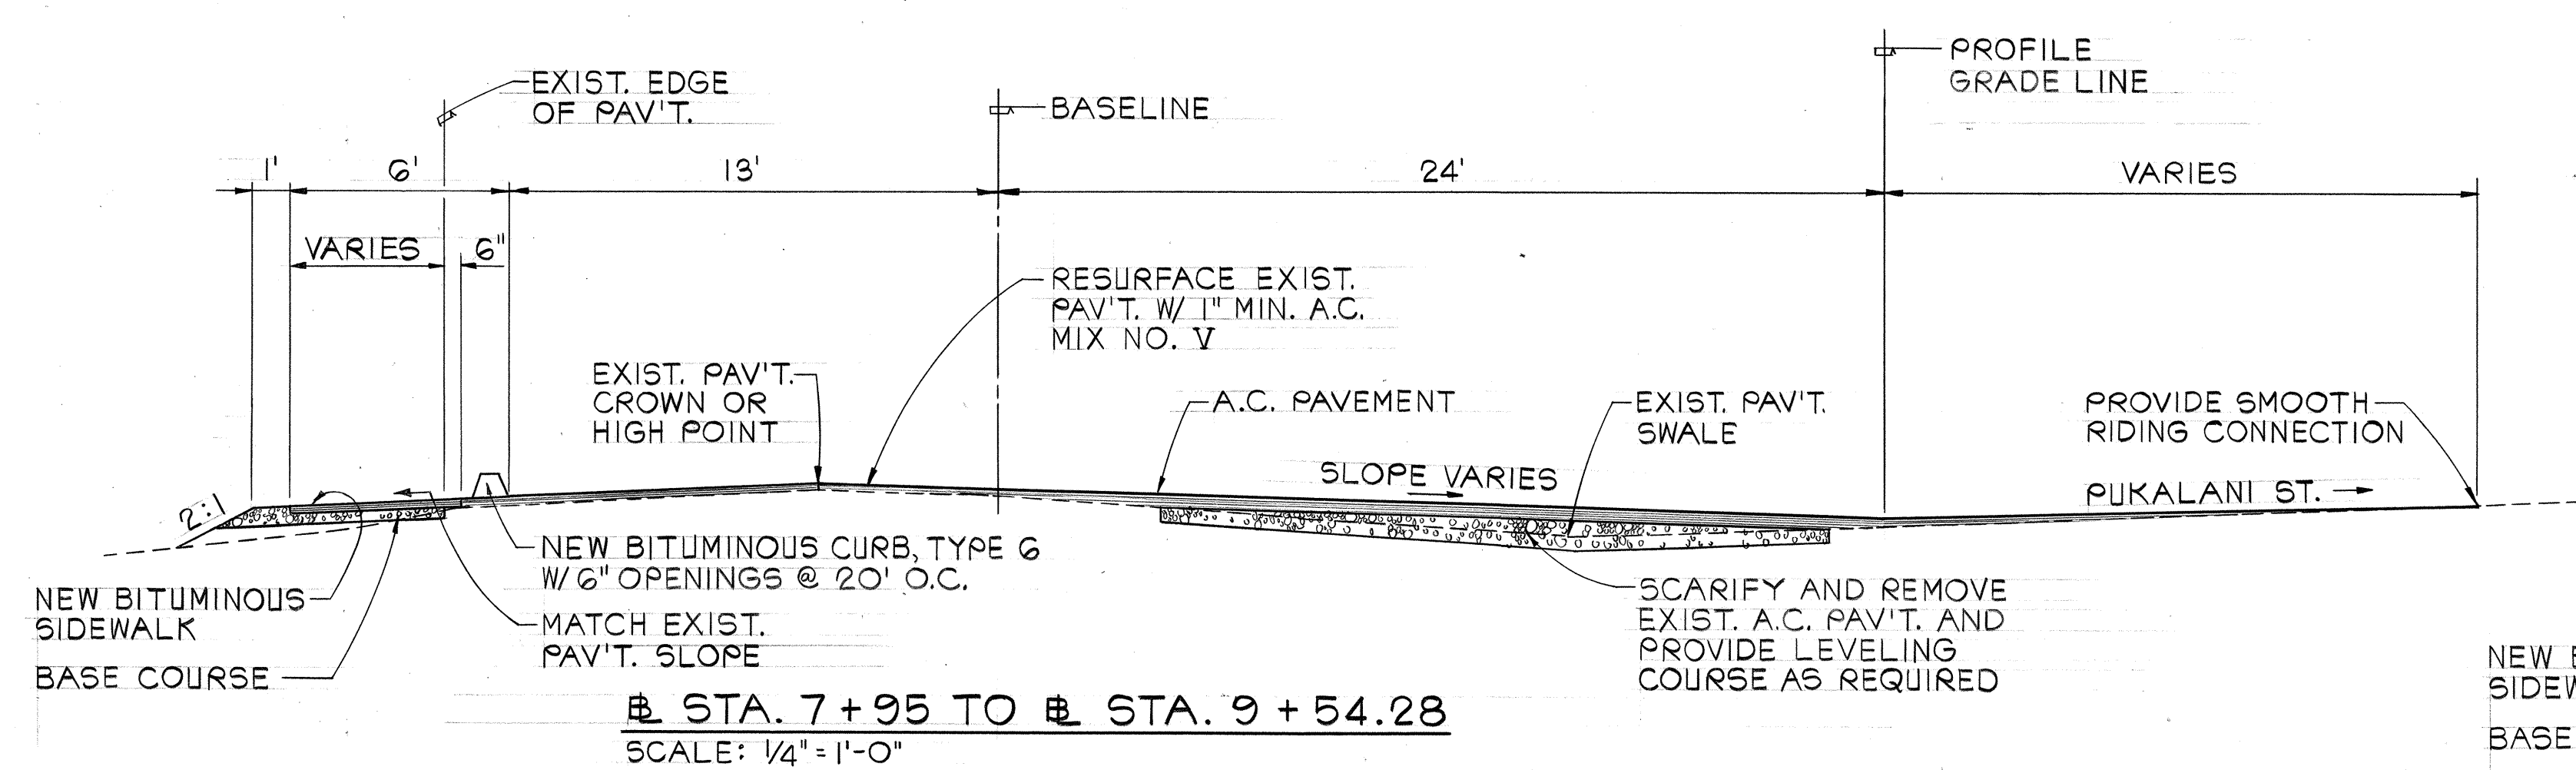


NOTES:


- WHERE NEW PAVEMENT FINISH GRADE IS LESS THAN 4" OVER EXISTING PAVEMENT SURFACE, APPLY TACK COAT AND RESURFACE. OTHERWISE SCARIFY AND REMOVE EXIST. A.C. PAVEMENT AND INSTALL NEW PAVEMENT SECTION AS REQUIRED TO BRING THE EXISTING SUBGRADE TO FINISH GRADE.
- LEVELING WITH A.C. MIX NO. V, BASE COURSE, AND SUB-BASE COURSE AS REQUIRED SHALL BE PAID FOR UNDER ITEM NOS. 401.0500, 304.1110, AND 305.1110 RESPECTIVELY. NO ADDITIONAL COMPENSATION SHALL BE MADE.
- ALL EXISTING PAVEMENT JOINTS SHALL BE SAW CUT PRIOR TO PAVING AS DIRECTED.
- HYDROMULCH ALL EXPOSED SURFACES. DELETED
- A.C. MIX NO. V AND BASE COURSE FOR BITUMINOUS SIDEWALK AND A.C. SWALE SHALL BE PAID FOR UNDER ITEM NOS. 401.0500 ASPHALT CONCRETE PAVEMENT, MIX NO. V AND 304.1110 AGGREGATE BASE, RESPECTIVELY.
- WHERE OPENINGS IN THE BITUMINOUS CURB ARE PROVIDED, THE BITUMINOUS SIDEWALK SHALL SLOPE AWAY FROM THE CURB. WHERE OPENINGS ARE NOT PROVIDED, THE BITUMINOUS SIDEWALK SHALL SLOPE TOWARD THE BITUMINOUS CURB.

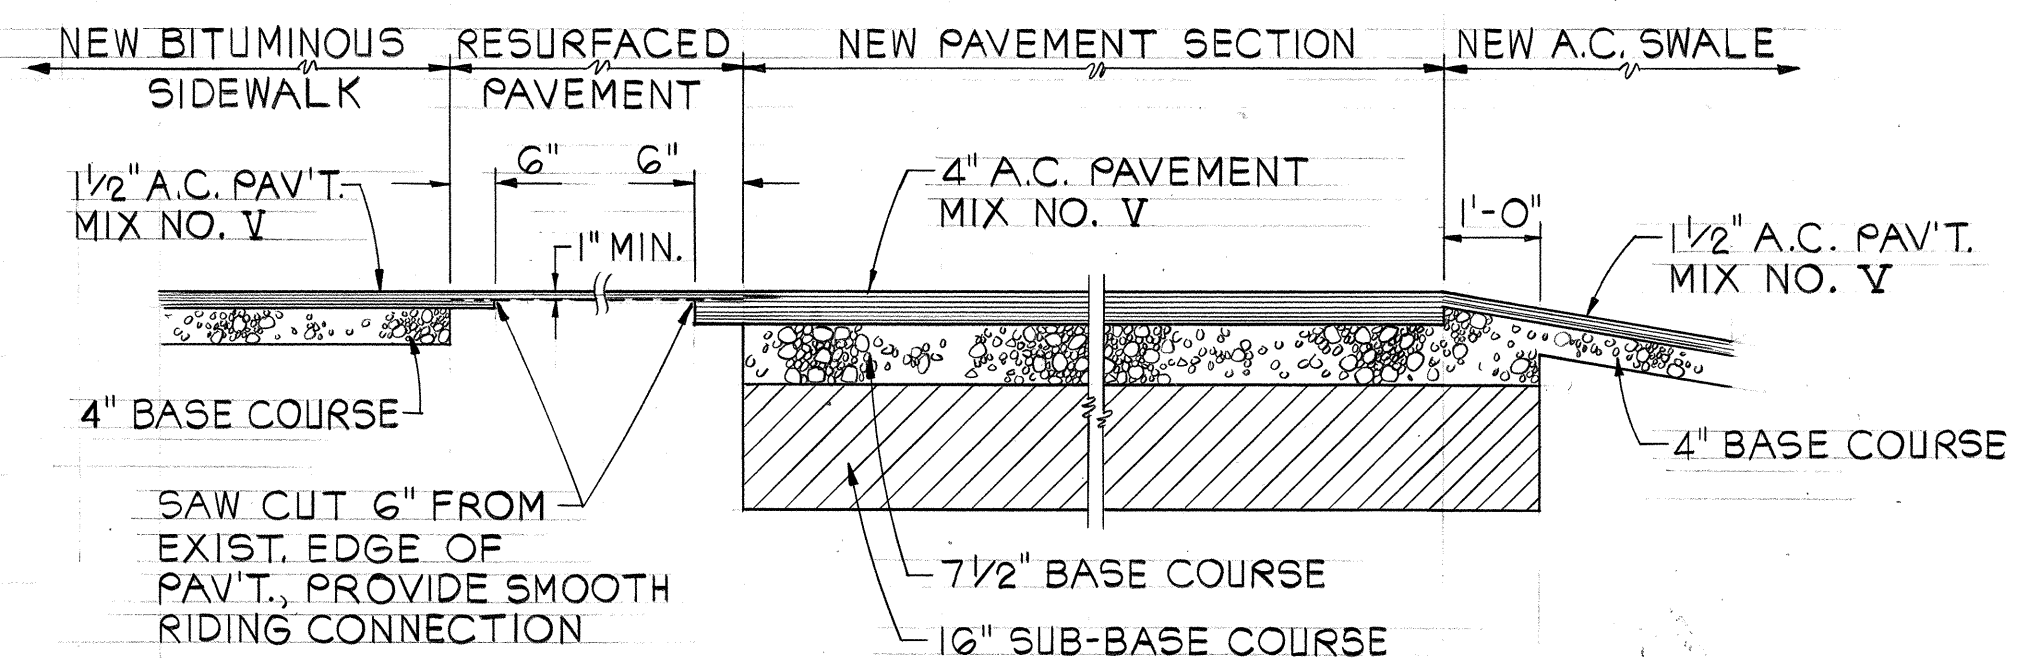

TYPICAL PAVEMENT SECTION
SCALE: 1/2" = 1'-0"

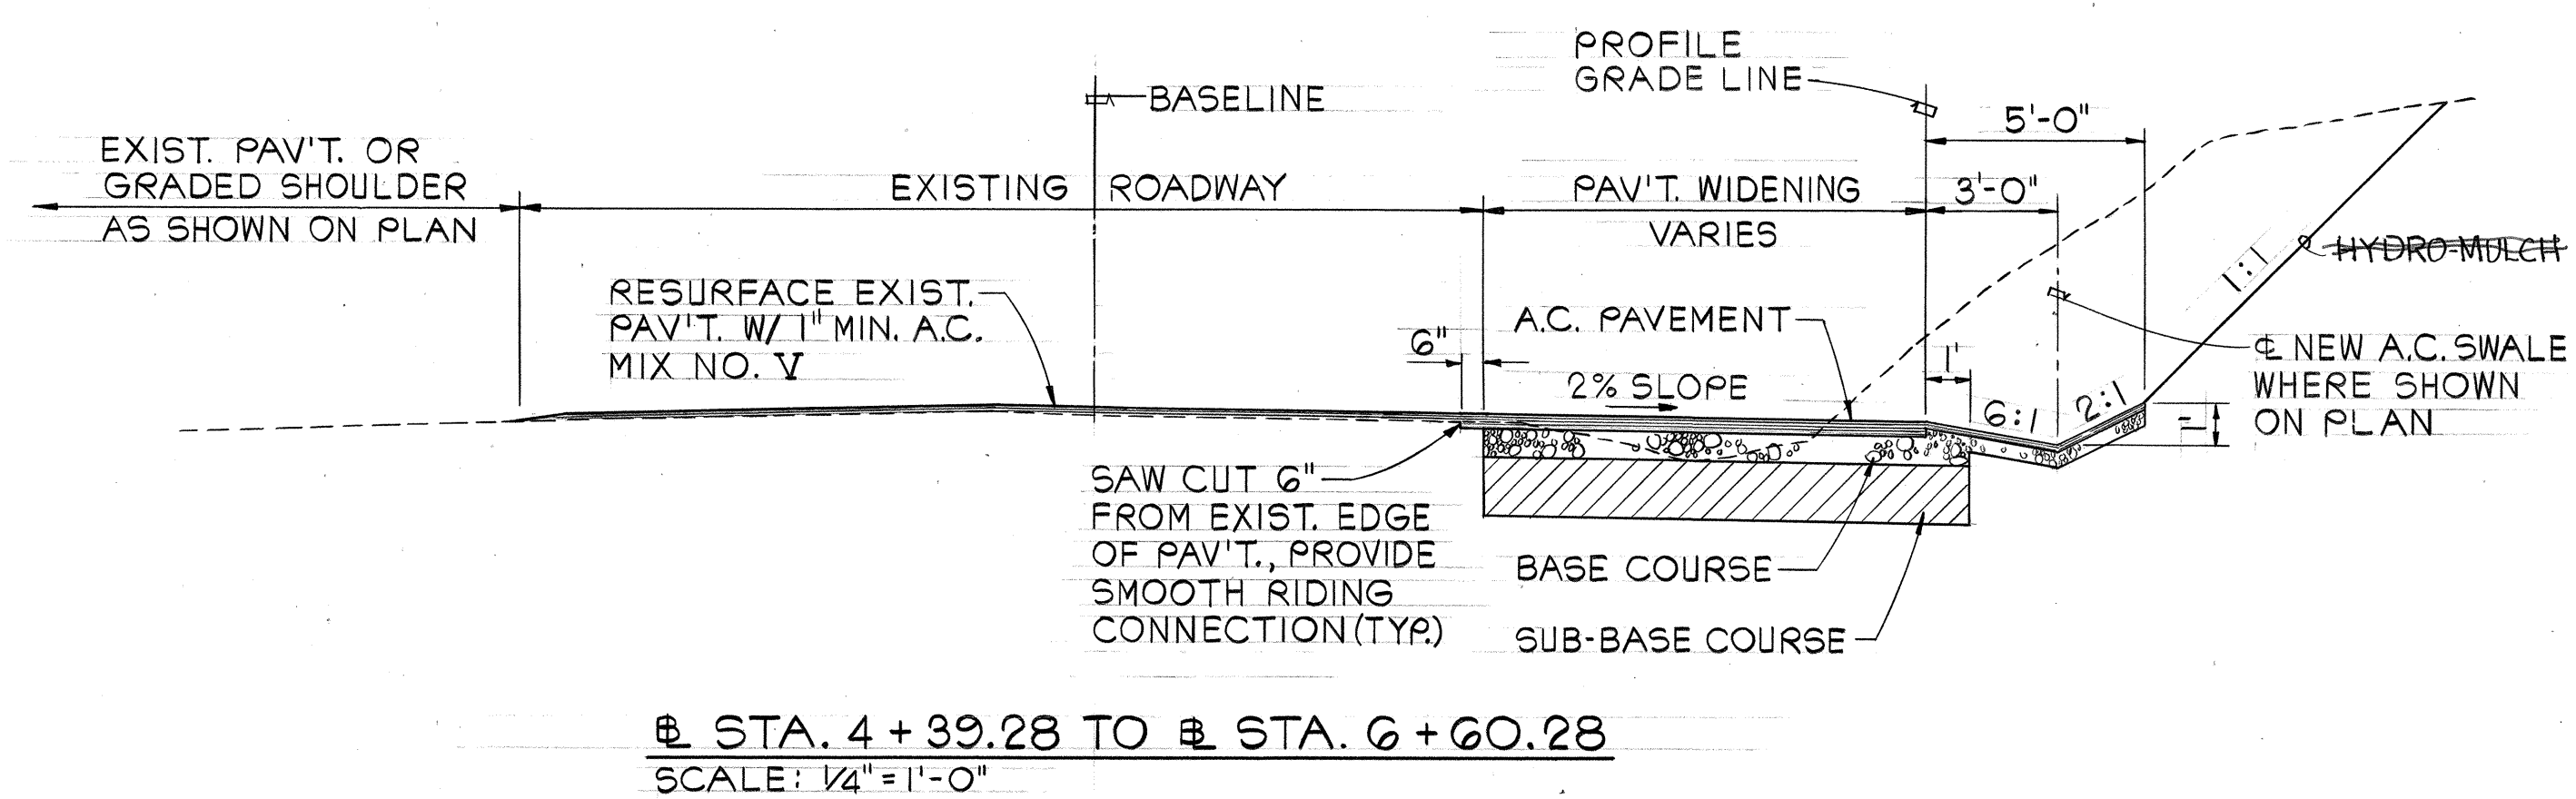

TYPICAL ROADWAY SECTIONS
SCALE: AS SHOWN

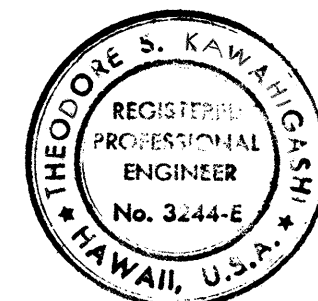

THIS WORK WAS PREPARED BY ME
OR UNDER MY SUPERVISION
Theodore S. Kawahiguchi
Signature

STATE OF HAWAII
DEPARTMENT OF TRANSPORTATION
HIGHWAYS DIVISION

TYPICAL ROADWAY SECTIONS

HALEAKALA HIGHWAY
Intersection Improvements at
Pukalani Street
Project No. 37C-02-82

SCALE: AS SHOWN DATE: 1-15-82
SHEET NO. 1 OF 1 SHEETS