
ų	INDEX TO DRAWINGS
SHEET NO.	DESCRIPTION
1	TITLE SHEET
2	STANDARD PLAN SUMMARY
3	TYPICAL SECTION, GENERAL NOTES & DETAILS
4	PAVEMENT MARKING LEGEND, NOTES & DETAILS
5	PAVEMENT MARKING SUMMARY
6-17	ROADWAY PLANS

STATE OF HAWAII

DEPARTMENT OF TRANSPORTATION
HIGHWAYS DIVISION
HONOLULU, HAWAII
"AS-BUILT"
PLANS OF

KULA HIGHWAY RESURFACING
LOWER KULA ROAD TO KEKAULIKE AVENUE
PROJECT No. 37C-01-88M

DISTRICT OF MAKAWAO
ISLAND OF MAUI

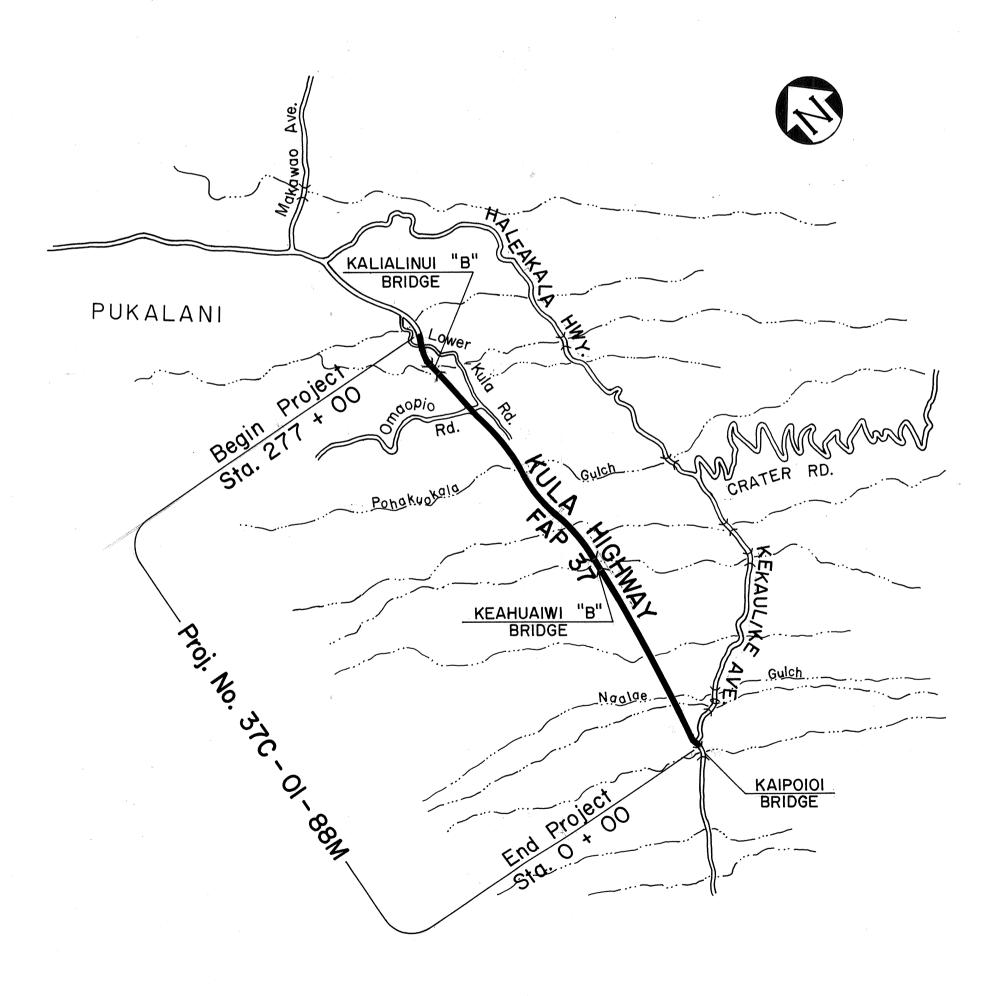


LAYOUT PLAN

SCALE IN MILES

PROJECT LENGTH

5.22 Miles

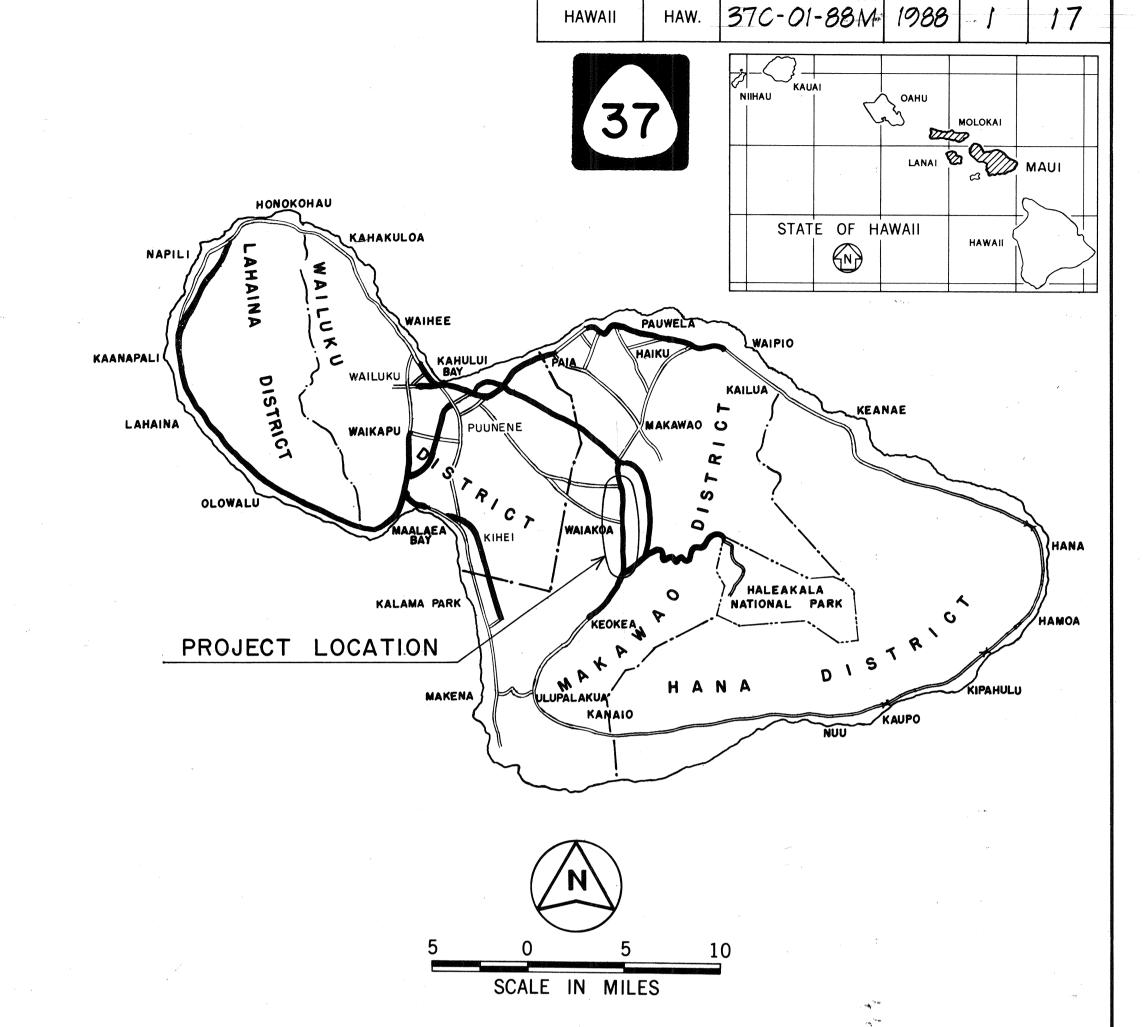

FED. ROAD DIST. NO. FISCAL YEAR

PROJ. NO.

FEDERAL AID PROJECTS PREVIOUSLY CONSTRUCTED OR UNDER CONSTRUCTION

CHANGES MADE DURING CONSTRUCTION HAVE BEEN INCORPORATED ON THESE PLANS EXCEPT CHANGES IN THE ORIGINAL THEORETICAL QUANTITIES. FOR ACTUAL QUANTITIES, REFER TO PROJECT LEDGER AND/OR COMPUTATION BOOK.

RESIDENT ENGINEER DATE

DEPARTMENT OF TRANSPORTATION
STATE OF HAWAII

APPROVED:

Lelward Late

DIR. OF TRANSPORTATION

DATE

5-4-0-00

548-4125 PHONE

MAUI DISTRIC DESIGNED BY