


ORIGINAL	SURVEYED	BY	DATE
NO.	NOTE BOOK	AREAS CHECKED	


FINAL	SURVEYED	BY	DATE
NO.	NOTE BOOK	AREAS CHECKED	

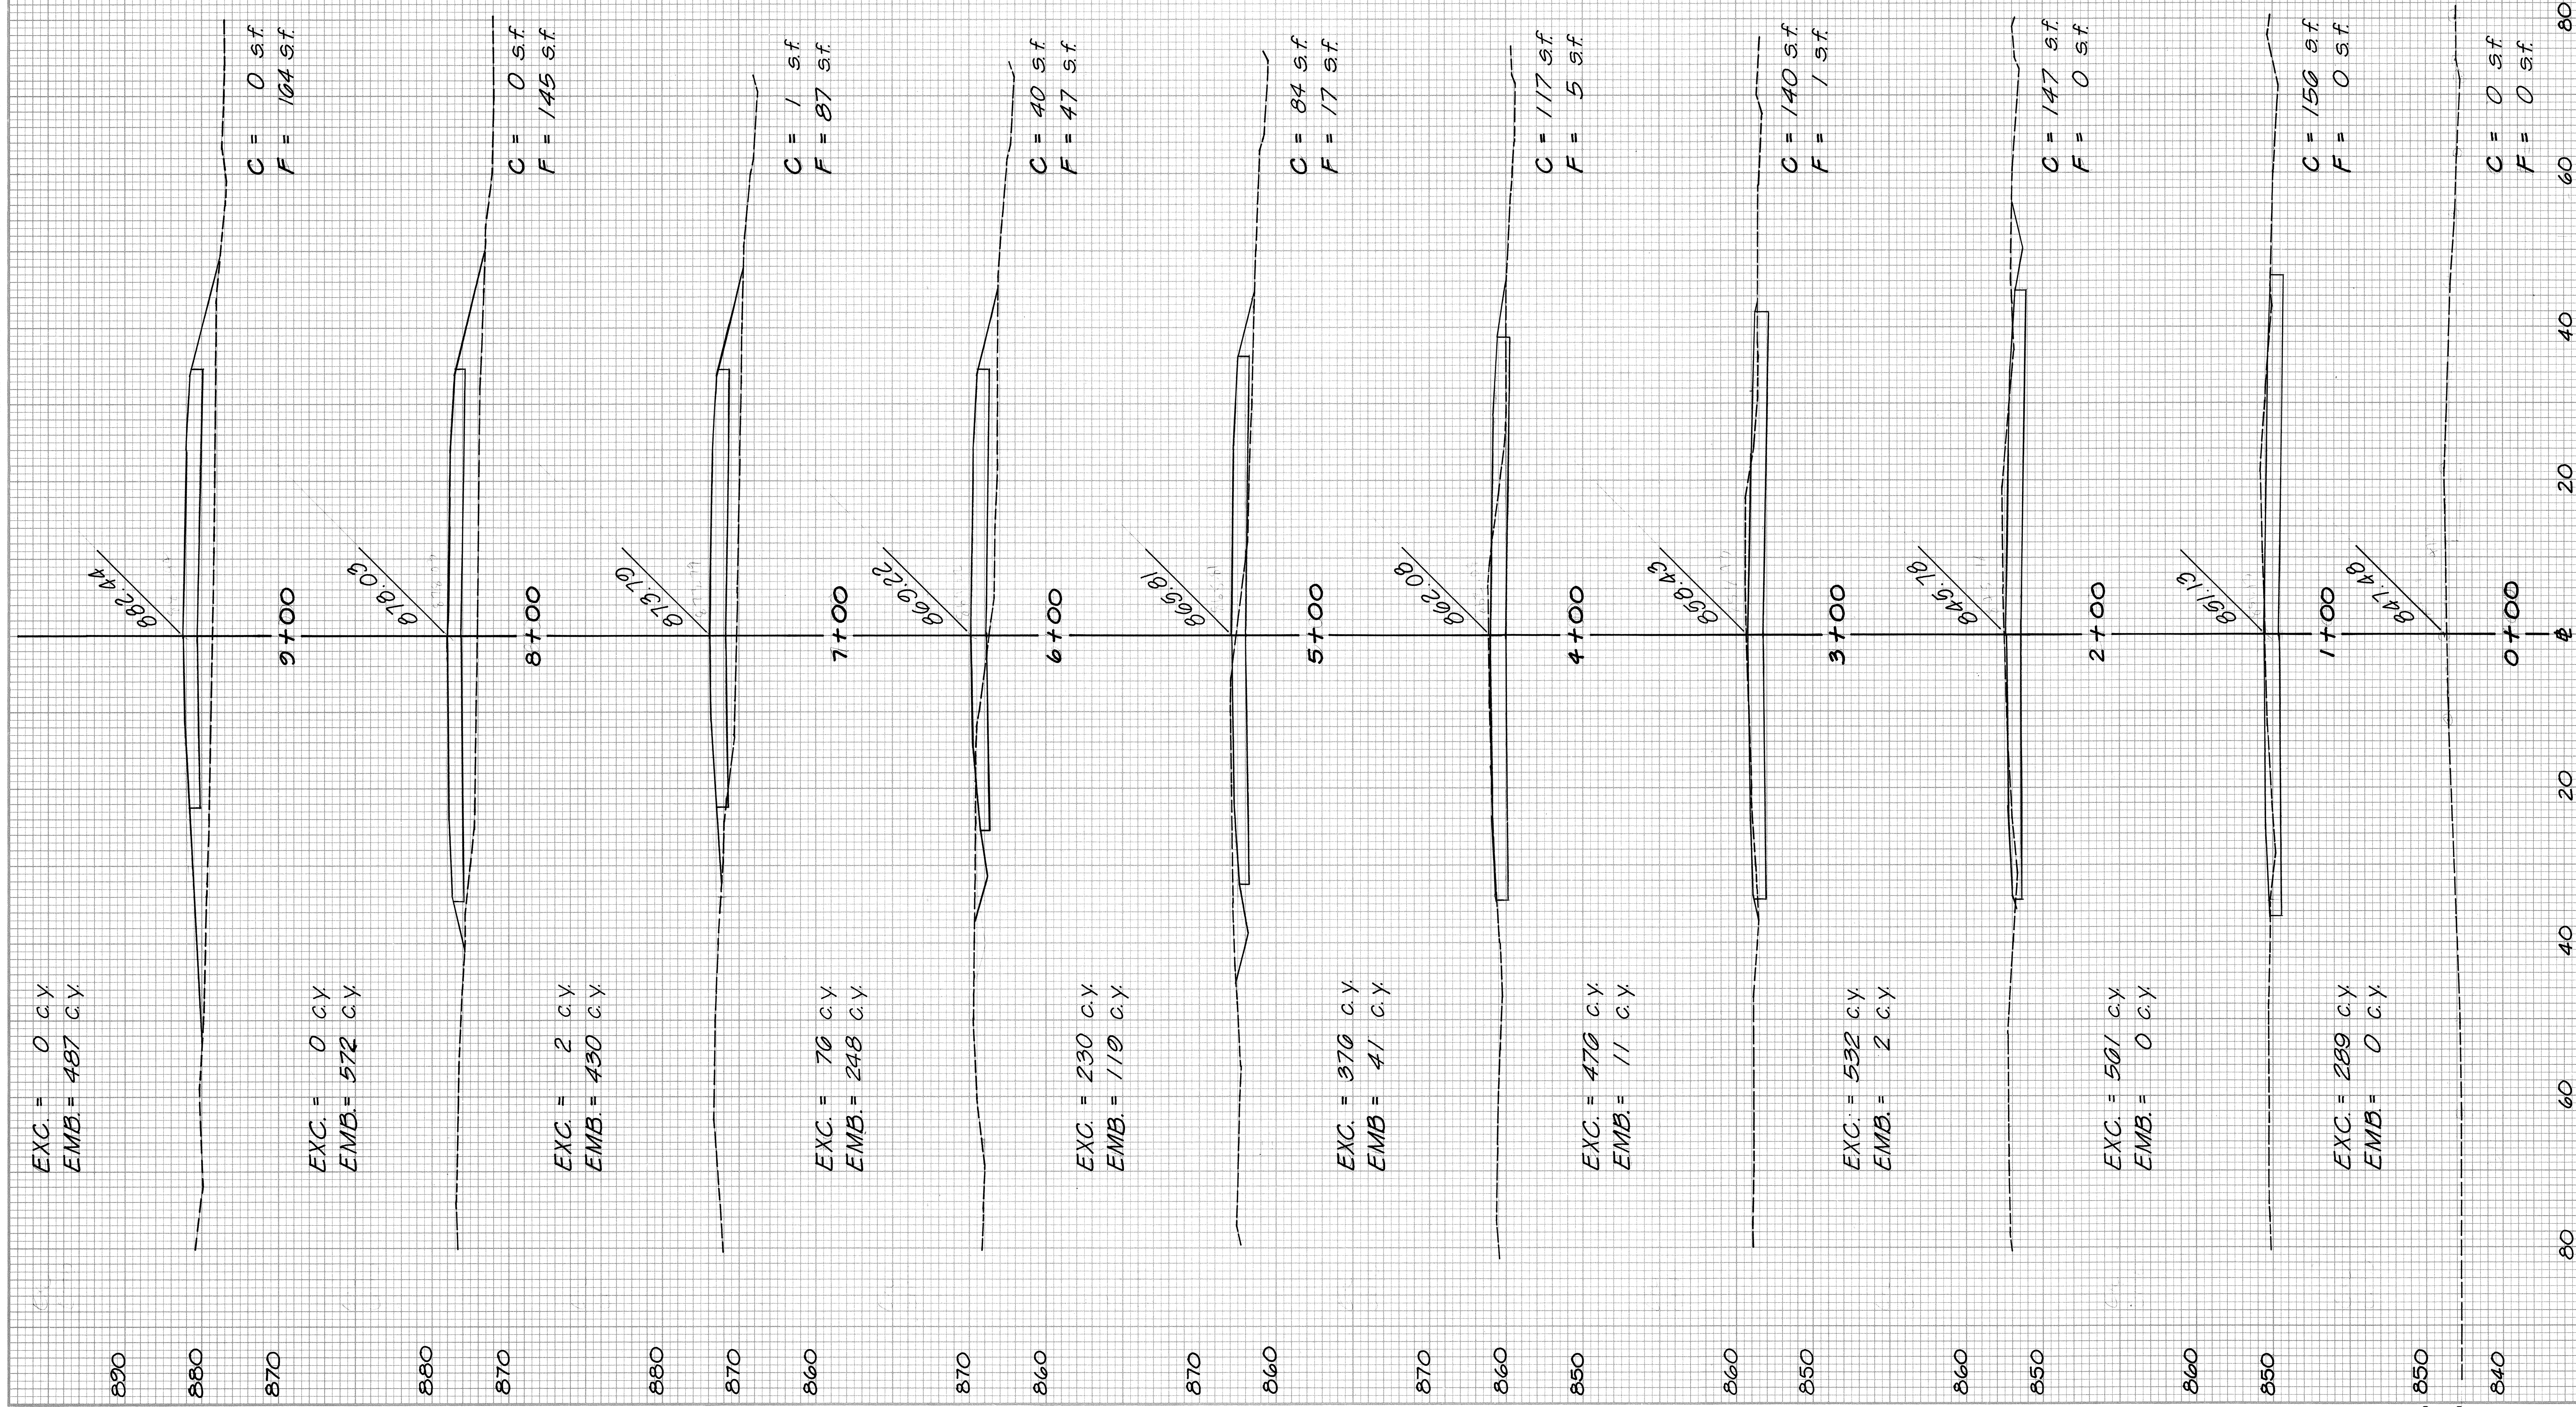

FED. ROAD DIST. NO.	STATE	FED. AID PROJ. NO.	FISCAL YEAR	SHEET NO.	TOTAL SHEETS
HAWAII	HAW.	37C-02-90	1991	44	61

ORIGINAL	SURVEY	BY	DATE
SURVEY	PLOTTED		
NOTE BOOK	TEMPLATE		
NO.	AREAS CHECKED		

FINAL	SURVEY	BY	DATE
SURVEY	PLOTTED		
NOTE BOOK	TEMPLATE		
NO.	AREAS CHECKED		

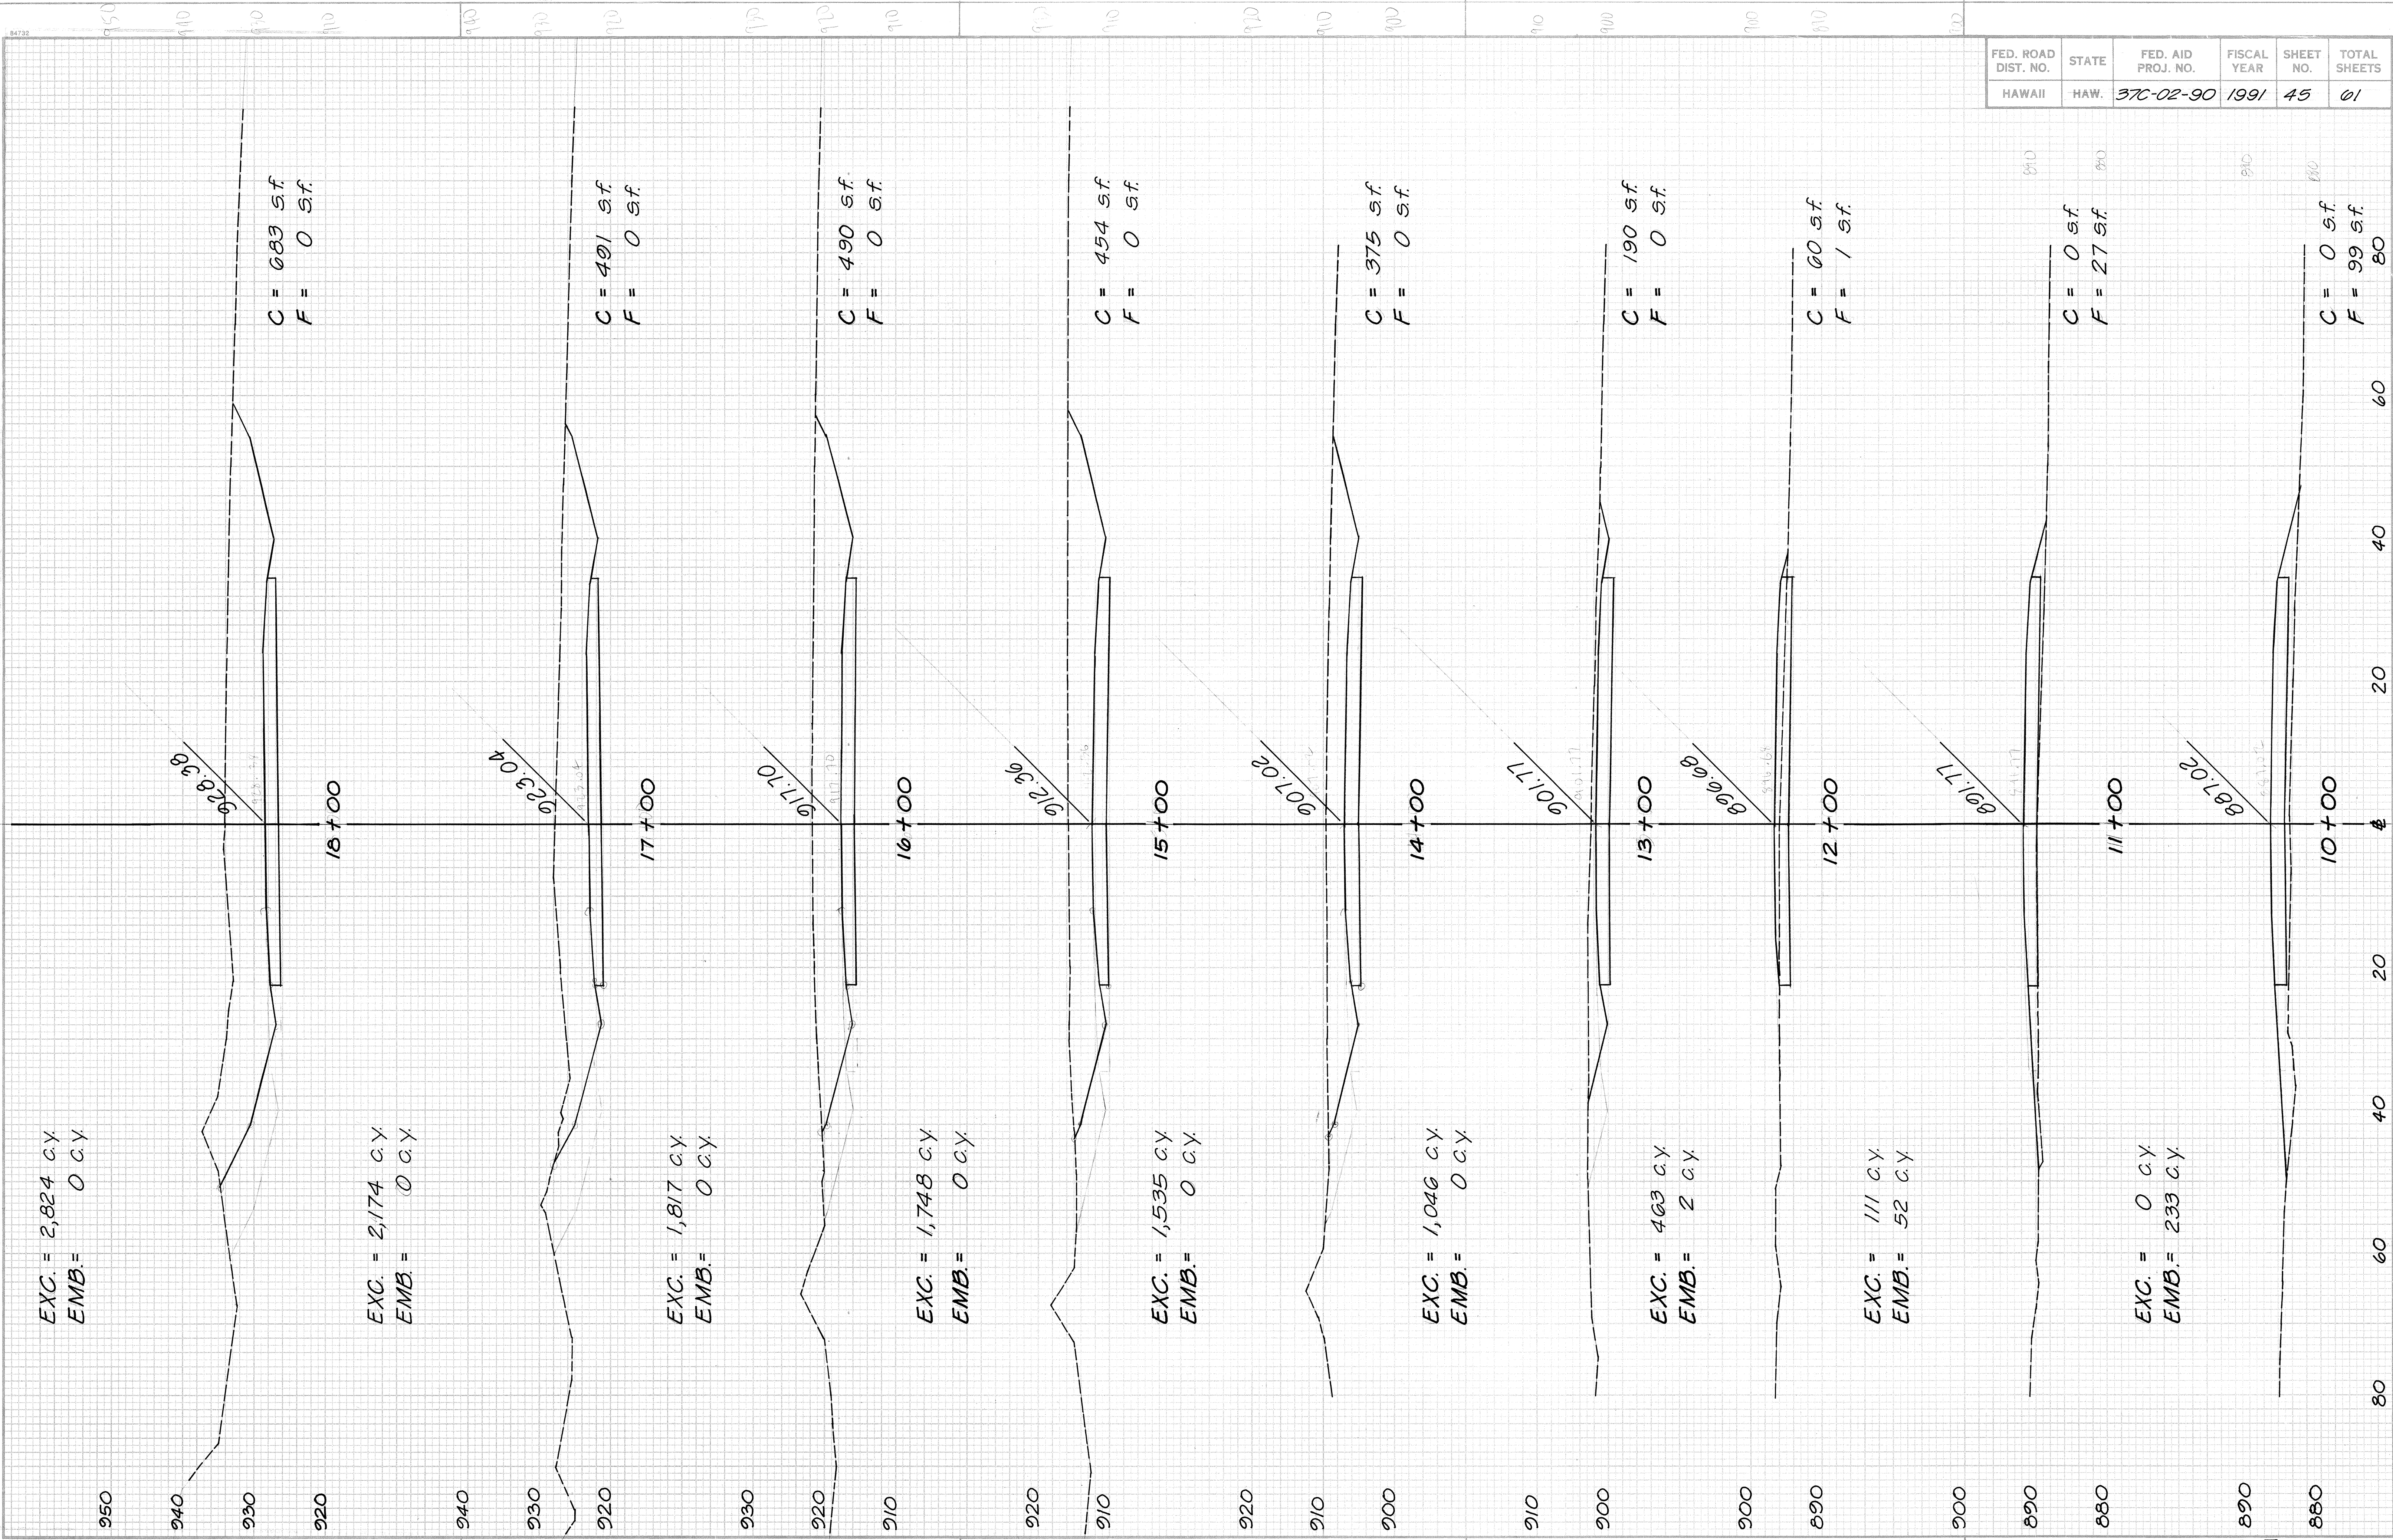

FED. ROAD DIST. NO.	STATE	FED. AID PROJ. NO.	FISCAL YEAR	SHEET NO.	TOTAL SHEETS
HAWAII	HAW.	370-02-90	1991	45	01

ORIGINAL	SURVEY	BY	DATE
SURVEY	NOTED		
NOTE BOOK	TEMPLATE		
NO.	AREAS CHECKED		

FINAL	SURVEY	BY	DATE
NOTE BOOK	TEMPLATE		
NO.	AREAS CHECKED		

EXC. = 1,507 c.y.
EMB. = 0 c.y.

EXC. = 1,619 c.y.
EMB. = 0 c.y.

EXC. = 1,950 c.y.
EMB. = 0 c.y.

EXC. = 2,420 c.y.
EMB. = 0 c.y.

EXC. = 3,009 c.y.
EMB. = 0 c.y.

EXC. = 3,326 c.y.
EMB. = 0 c.y.

EXC. = 3,359 c.y.
EMB. = 0 c.y.

EXC. = 3,272 c.y.
EMB. = 0 c.y.

C = 410 sf
F = 0 sf.

C = 404 sf
F = 0 sf.

C = 589 sf
F = 0 sf.

C = 718 sf
F = 0 sf.

C = 907 sf
F = 0 sf.


C = 889 sf
F = 0 sf.

C = 925 sf
F = 0 sf.

C = 842 sf
F = 0 sf.

ORIGINAL	SURVEY	BY	DATE
NO.	NOTE BOOK	PLOTTED	TEMPLATE
		AREAS	CHECKED


FINAL	SURVEY	BY	DATE
NO.	NOTE BOOK	PLOTTED	TEMPLATE
		AREAS	CHECKED

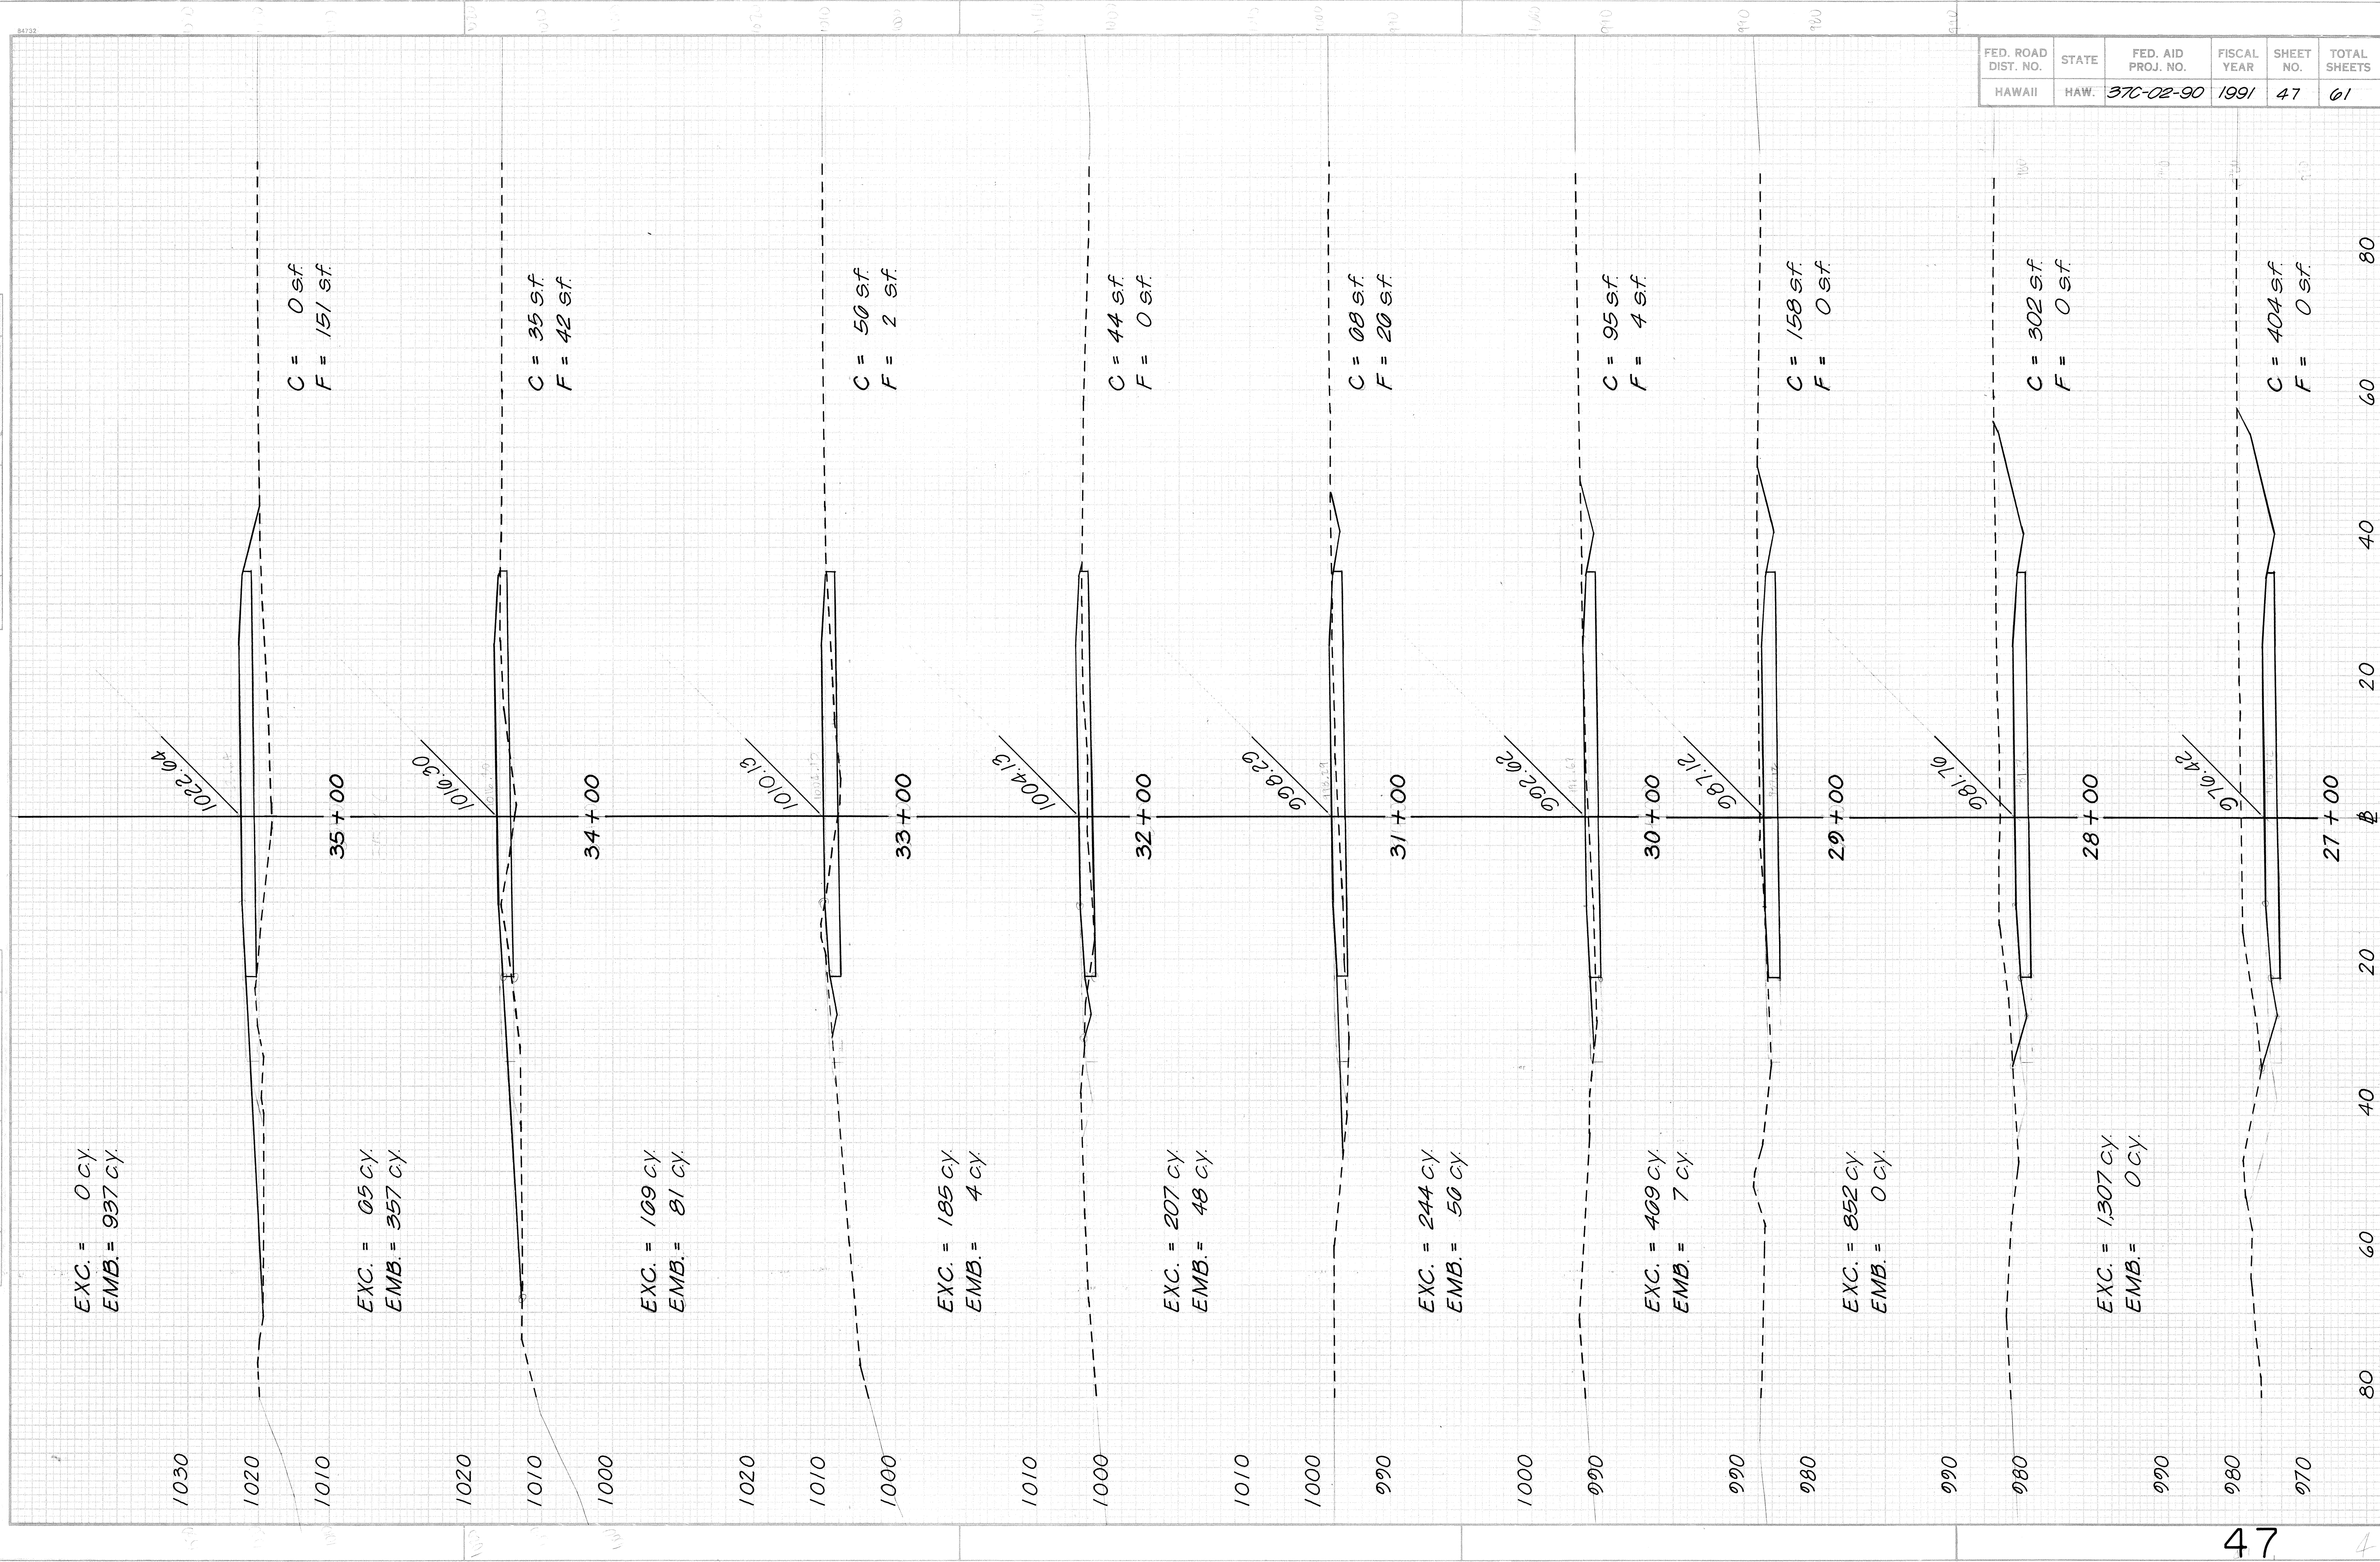

FED. ROAD DIST. NO.	STATE	FED. AID PROJ. NO.	FISCAL YEAR	SHEET NO.	TOTAL SHEETS
HAWAII	HAW.	370-02-90	1991	47	61

ORIGINAL	SURVEYED	BY	DATE
SURVEY	NOTE BOOK	NO.	
TEMPLATE	AREAS CHECKED		


FINAL	SURVEYED	BY	DATE
NOTE BOOK	TEMPLATE	NO.	
AREAS CHECKED			

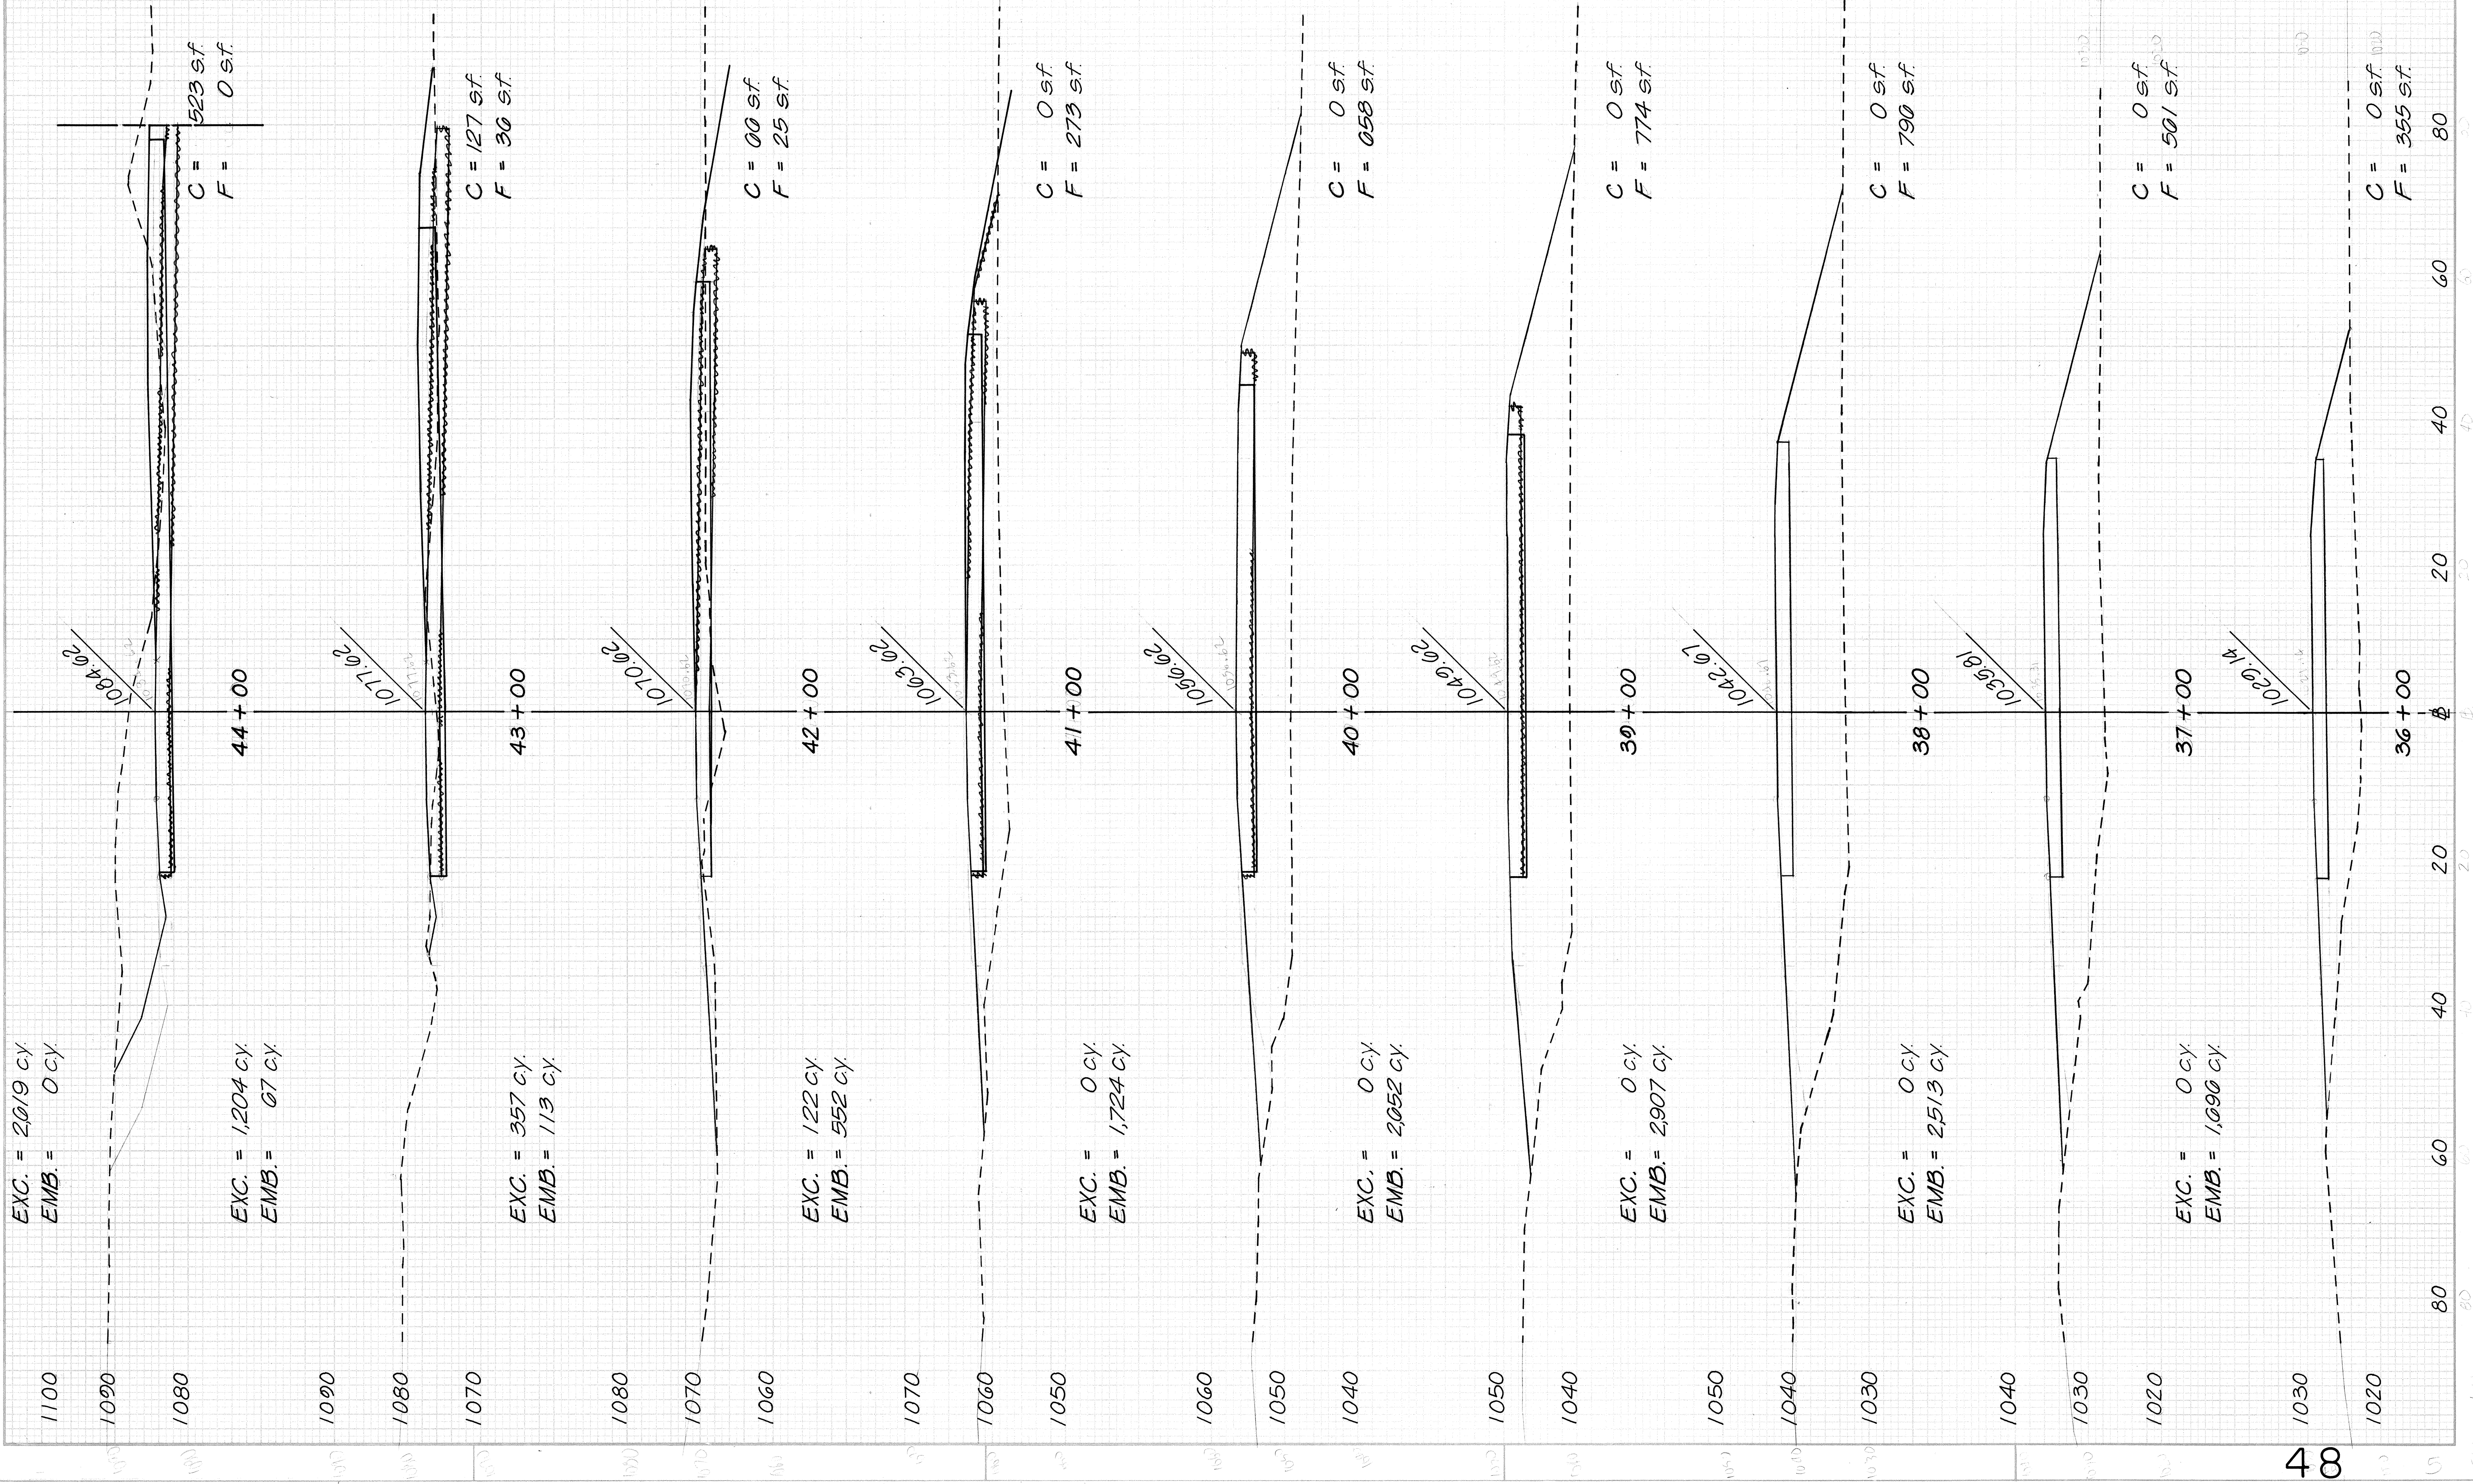

FED. ROAD DIST. NO.	STATE	FED. AID PROJ. NO.	FISCAL YEAR	SHEET NO.	TOTAL SHEETS
HAWAII	HAW.	370-02-90	1991	48	61

ORIGINAL SURVEY NOTE BOOK NO.	SURVEY PLOT TEMPLATE AREAS CHECKED	BY	DATE


FINAL SURVEY NOTE BOOK NO.	SURVEY PLOT TEMPLATE AREAS CHECKED	BY	DATE

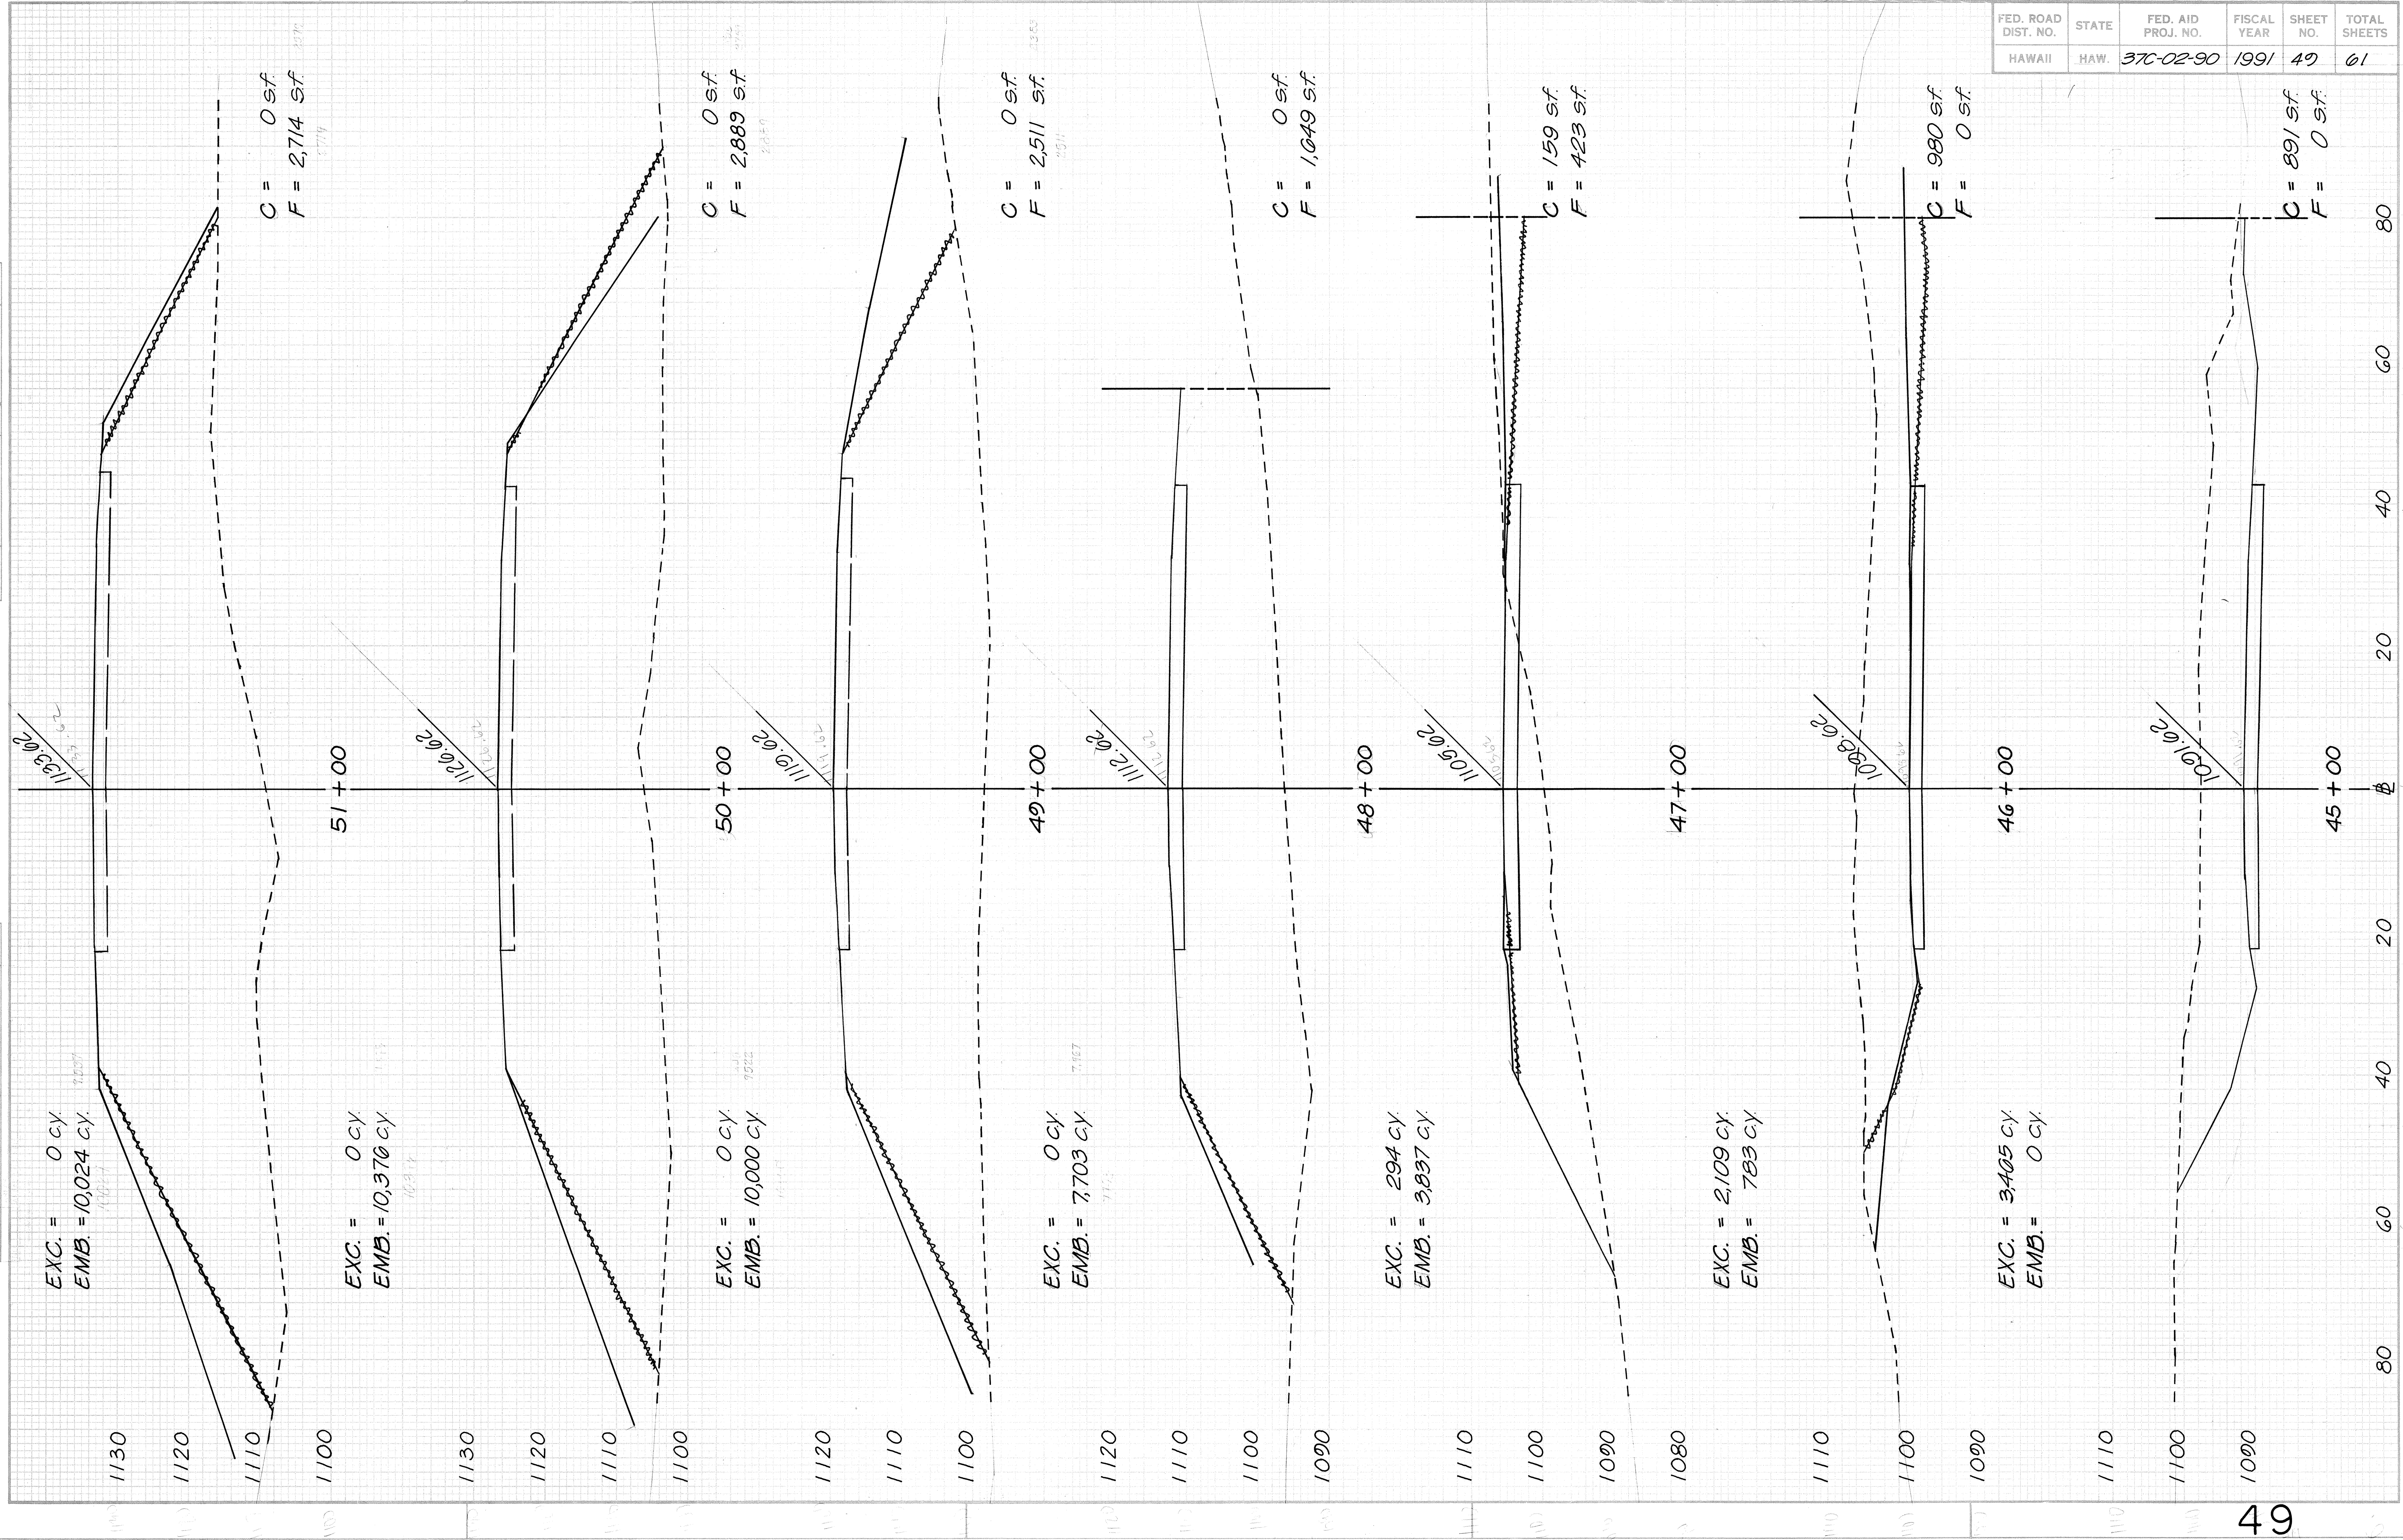

FED. ROAD DIST. NO.	STATE	FED. AID PROJ. NO.	FISCAL YEAR	SHEET NO.	TOTAL SHEETS
HAWAII	HAW.	37C-02-90	1991	49	61


FINAL SURVEY	SURVEYED	BY	DATE
NOTE BOOK	PLOTTED		
	TEMPLATE		
	AREAS		
NO	AREAS CHECKED		

ORIGINAL SURVEY	SURVEYED _____	BY _____	DATE _____
NOTE BOOK	PLOTTED _____		
	TEMPLATE _____		
	AREAS _____		
NO. _____	AREAS CHECKED _____		

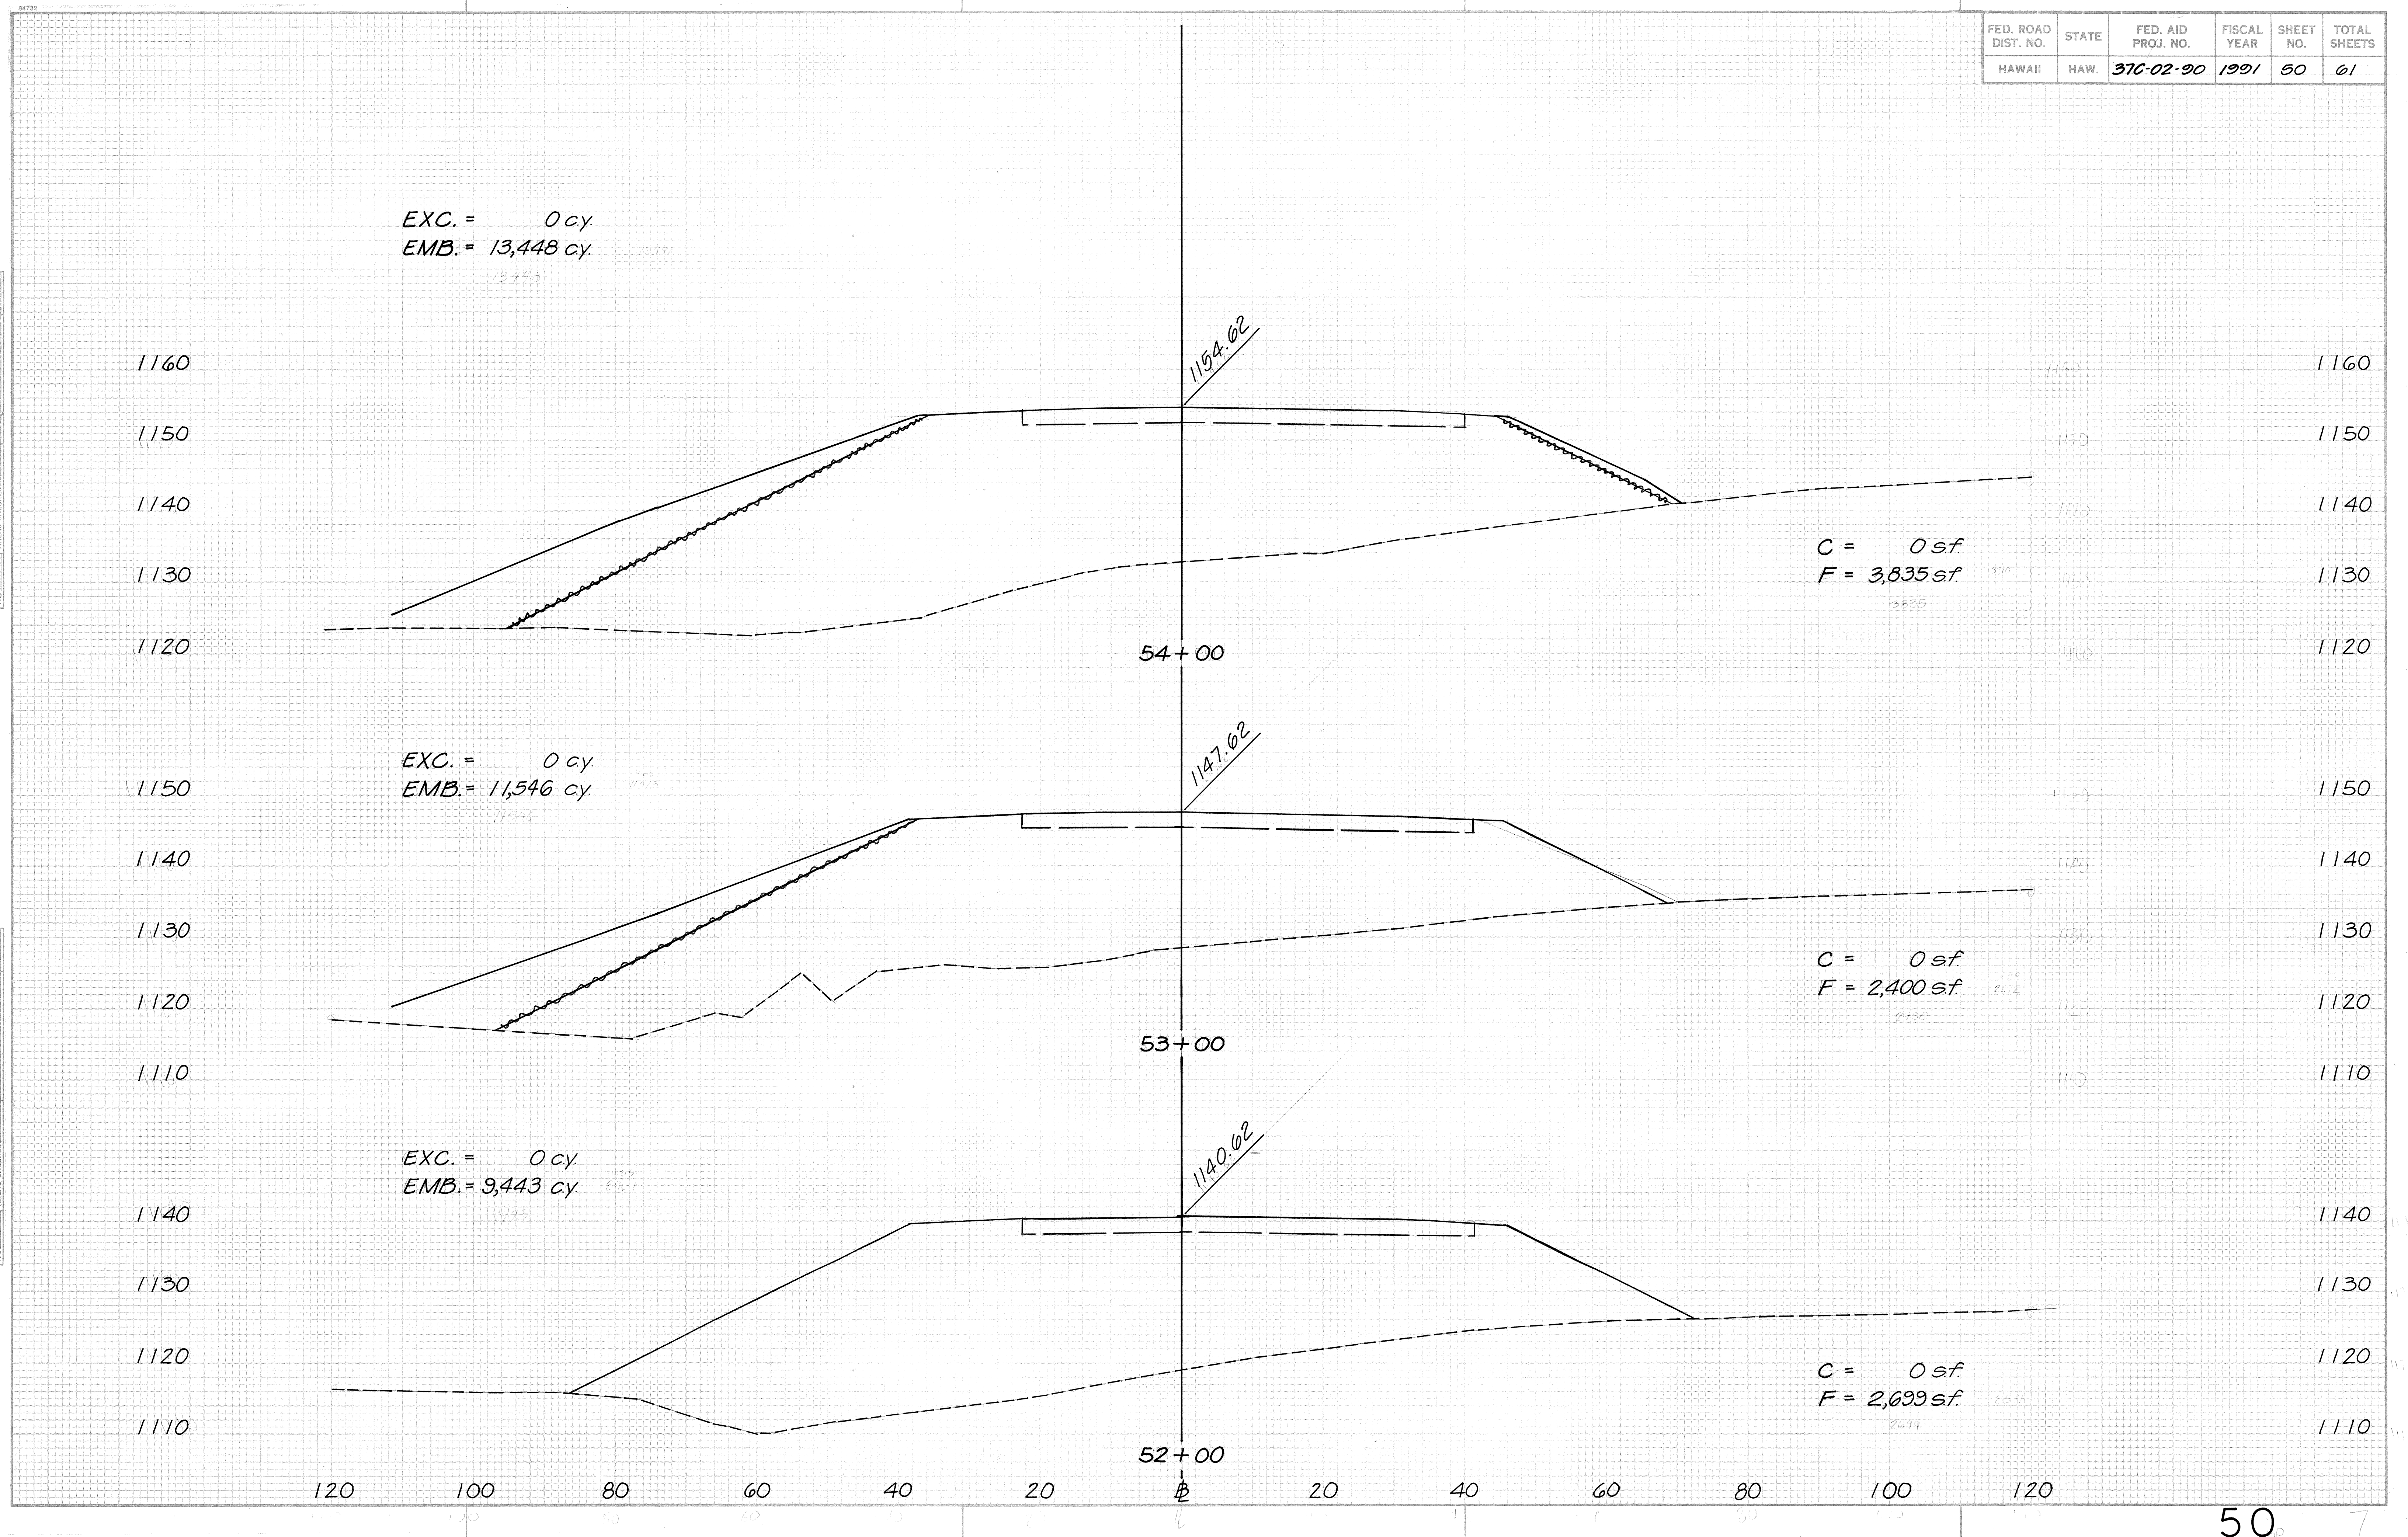

FED. ROAD DIST. NO.	STATE	FED. AID PROJ. NO.	FISCAL YEAR	SHEET NO.	TOTAL SHEETS
HAWAII	HAW.	370-02-90	1991	51	61

EXC. = 266 c.y.
 EMB. = 4263 c.y.

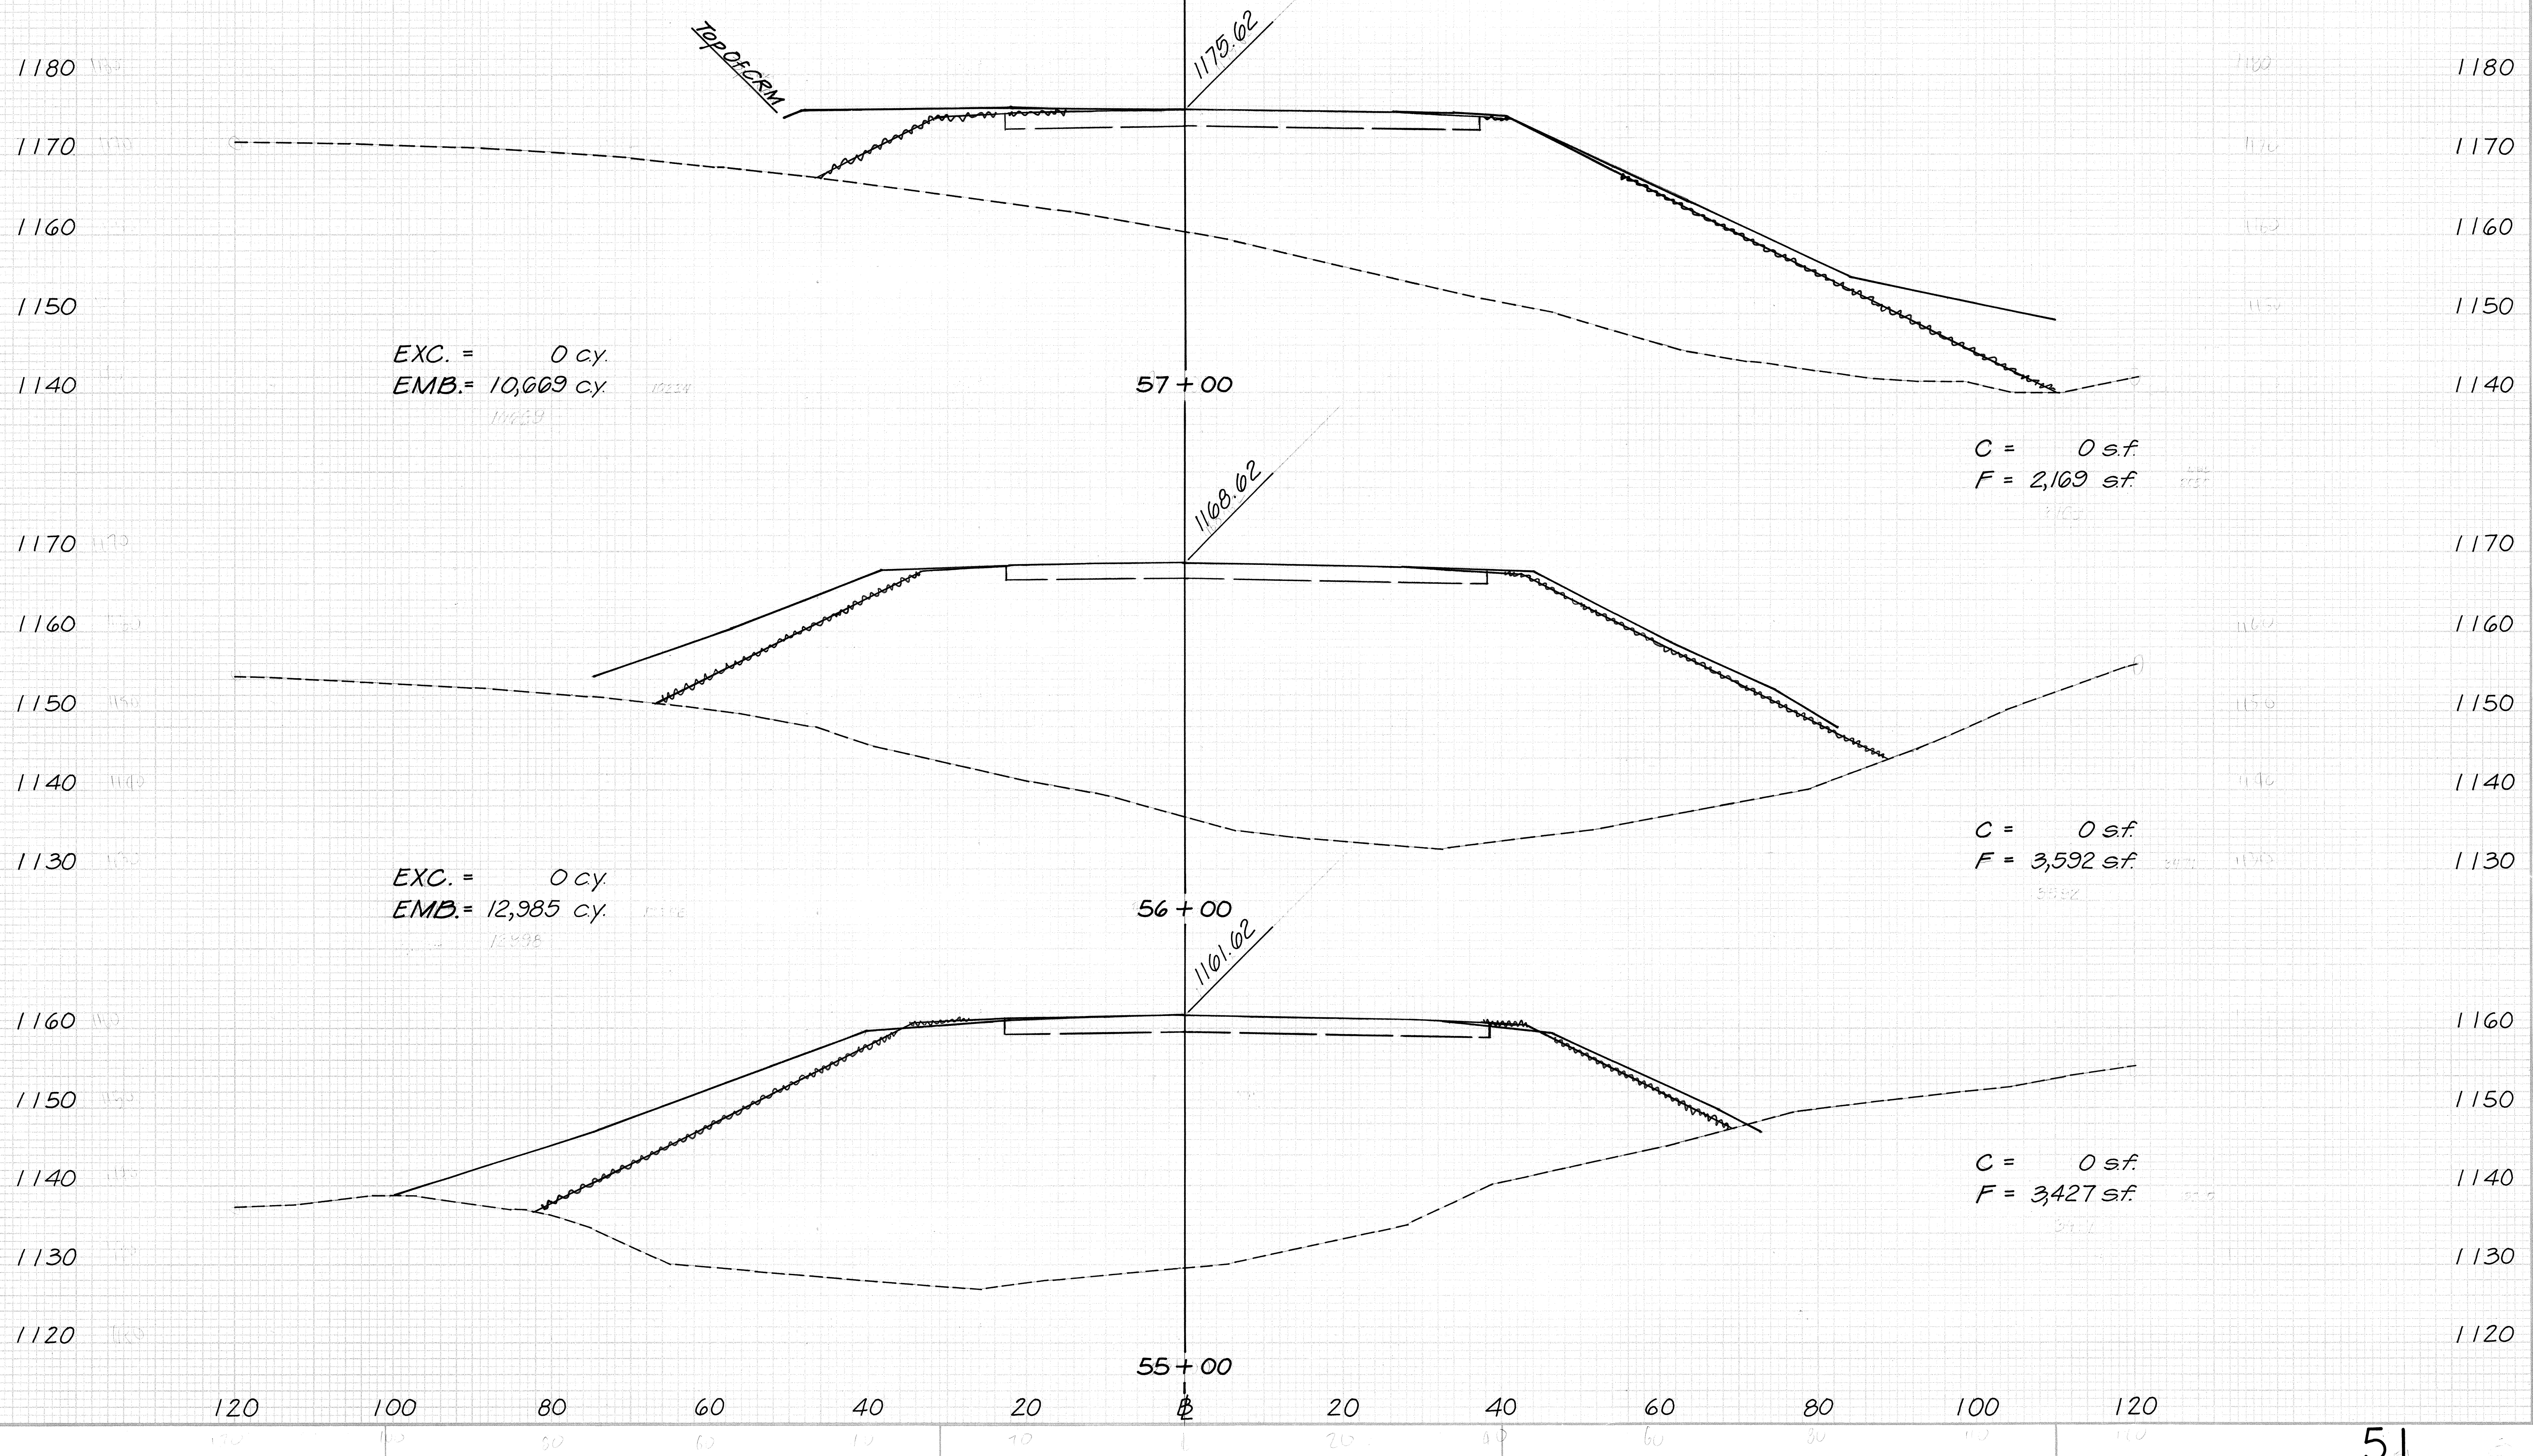

EXC. = 0 c.y.
 EMB. = 10,009 c.y.

C = 0 sf.
 F = 2,169 sf.

EXC. = 0 c.y.
 EMB. = 12,985 c.y.

C = 0 sf.
 F = 3,592 sf.

C = 0 sf.
 F = 3,427 sf.

FED. ROAD DIST. NO.	STATE	FED. AID PROJ. NO.	FISCAL YEAR	SHEET NO.	TOTAL SHEETS
HAWAII	HAW.	370-02-90	1991	52	61

EXC. = 11,057 cy.
 EMB. = 0 cy.

EXC. = 11,620 cy.
 EMB. = 0 cy.

EXC. = 8,878 cy.
 EMB. = 0 cy.

EXC. = 3,439 cy.
 EMB. = 246 cy.

C = 3,196 sf.
 F = 0 sf.


C = 3,079 sf.
 F = 0 sf.

C = 1,715 sf.
 F = 0 sf.

C = 144 sf.
 F = 133 sf.


FINAL SURVEY	DATE
SURVEYED	BY
PLOTTED	
NOTE BOOK	
NO	

ORIGINAL SURVEY	DATE
SURVEYED	BY
PLOTTED	
NOTE BOOK	
NO	

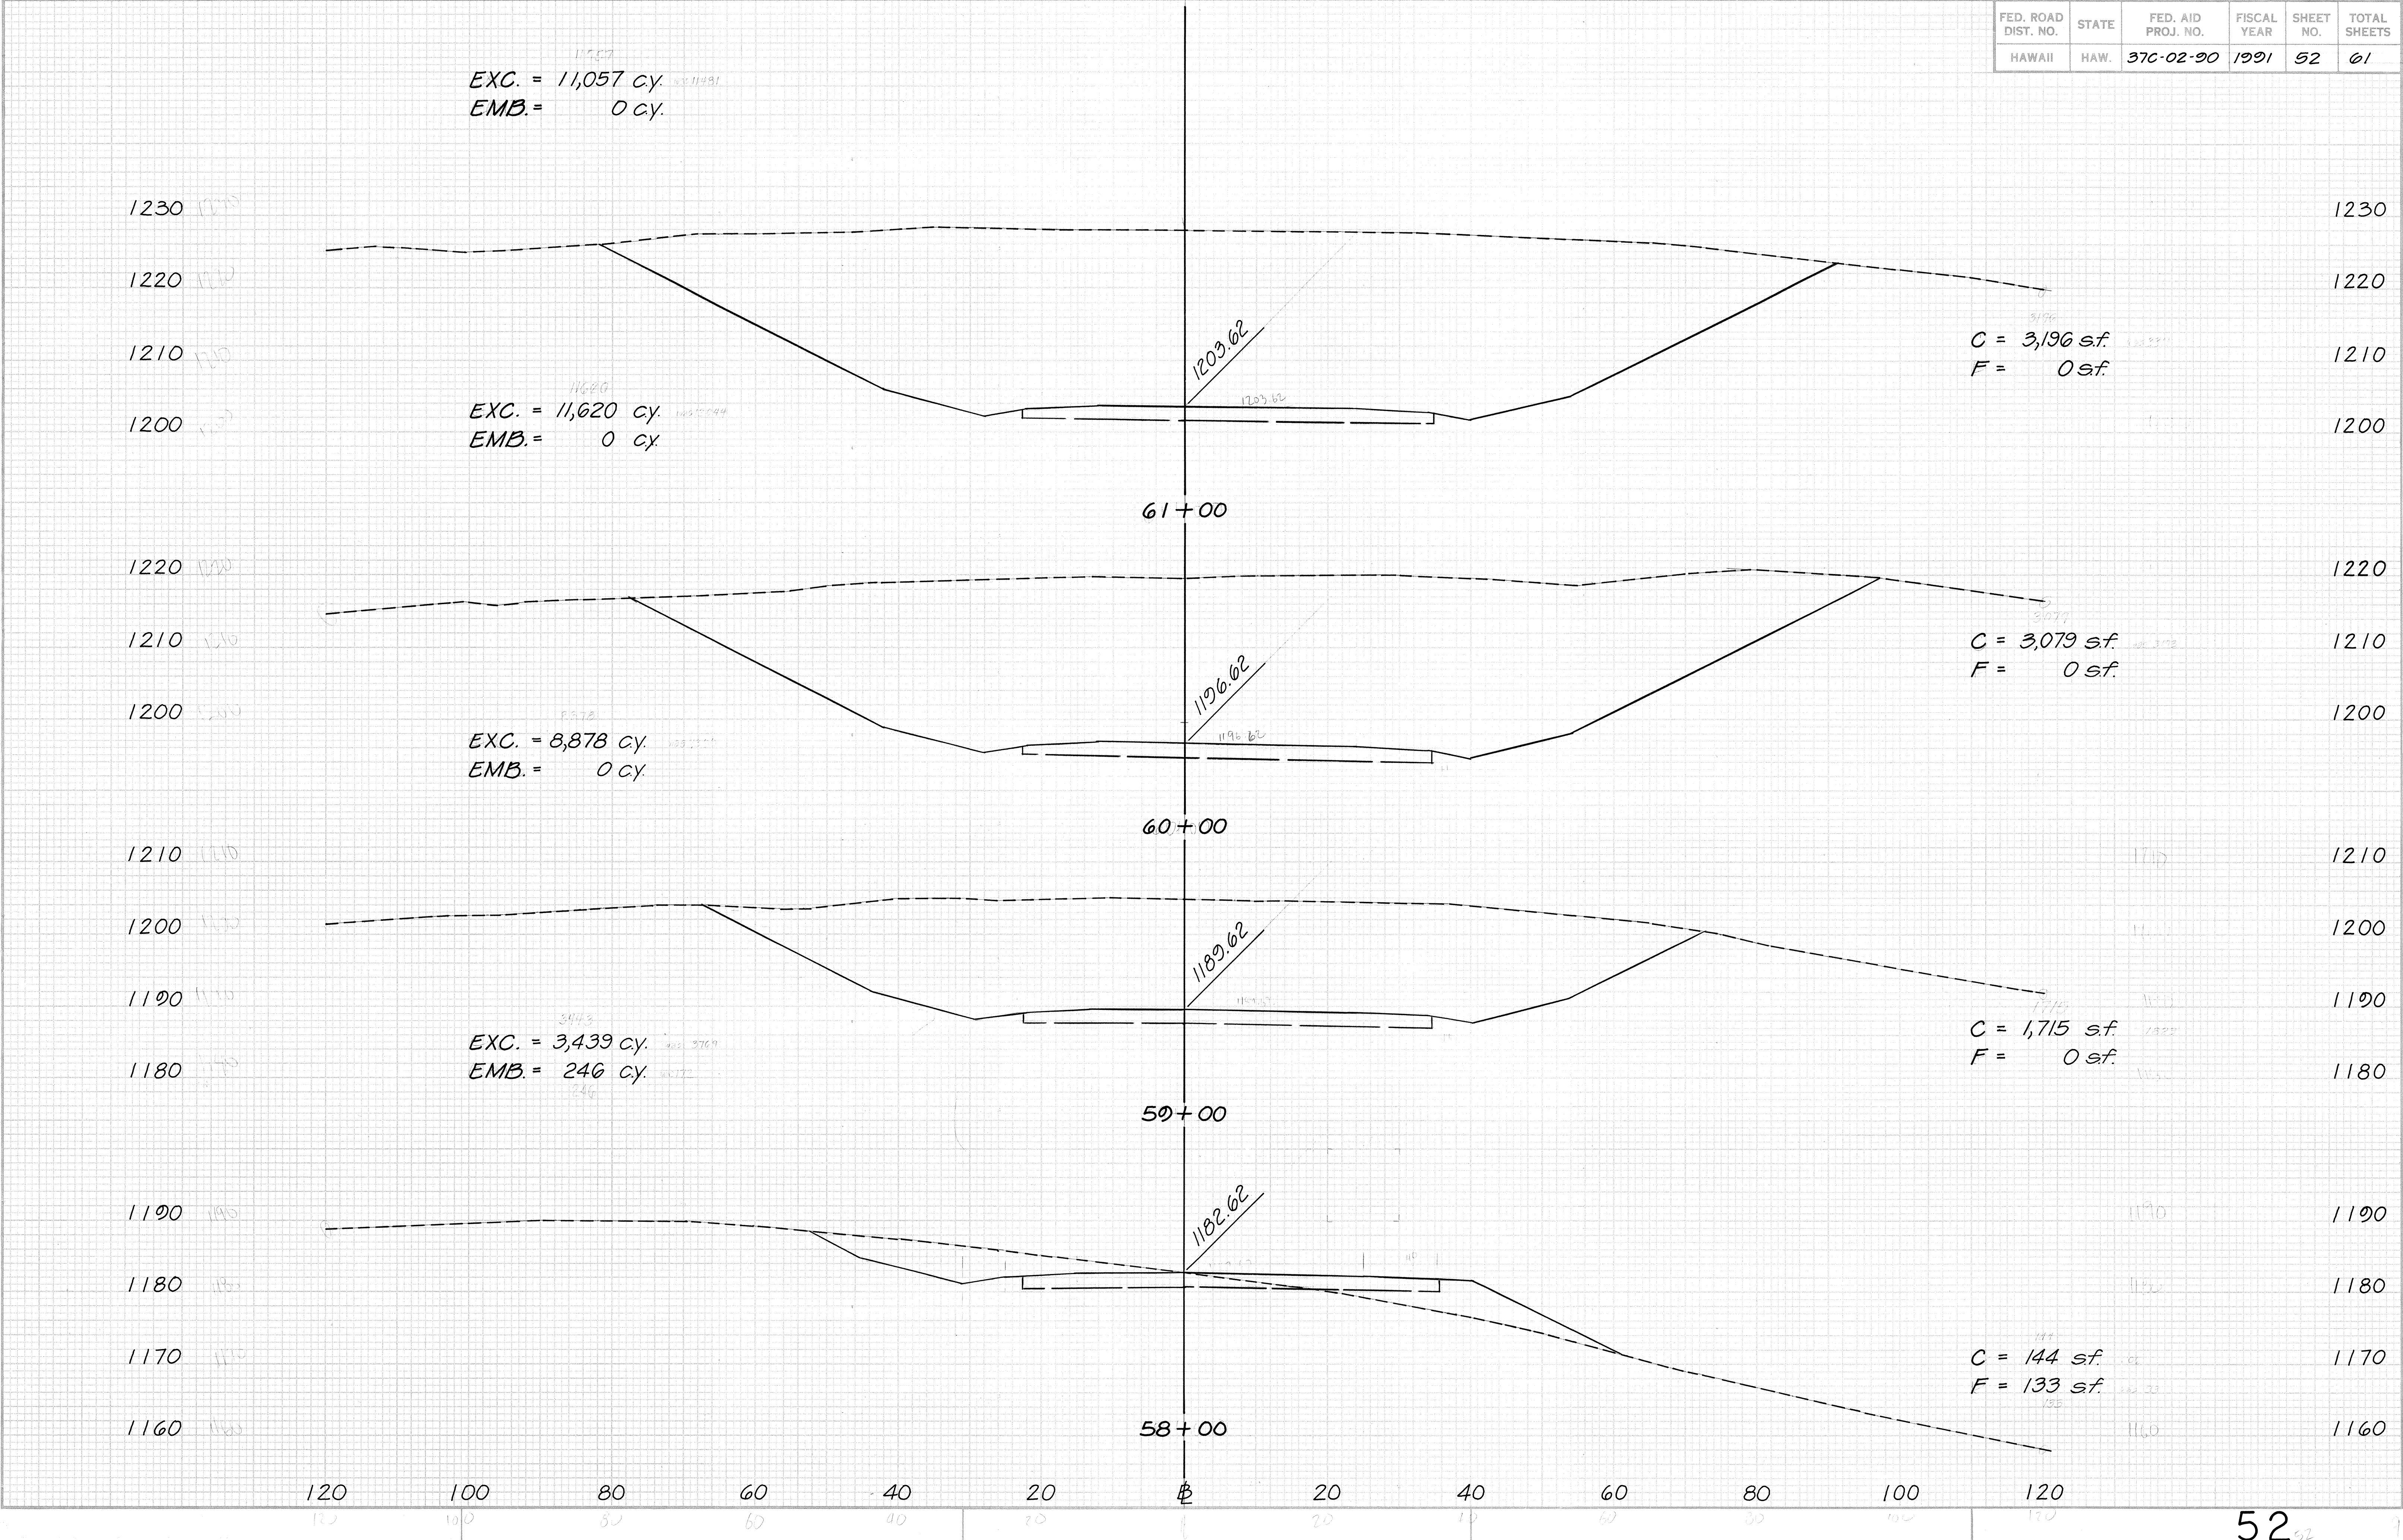

ORIGINAL	SURVEY	BY	DATE
NO.	NOTE BOOK	TEMP.	
	AREAS	CHECKED	


FINAL	SURVEY	BY	DATE
NO.	NOTE BOOK	TEMP.	
	AREAS	CHECKED	

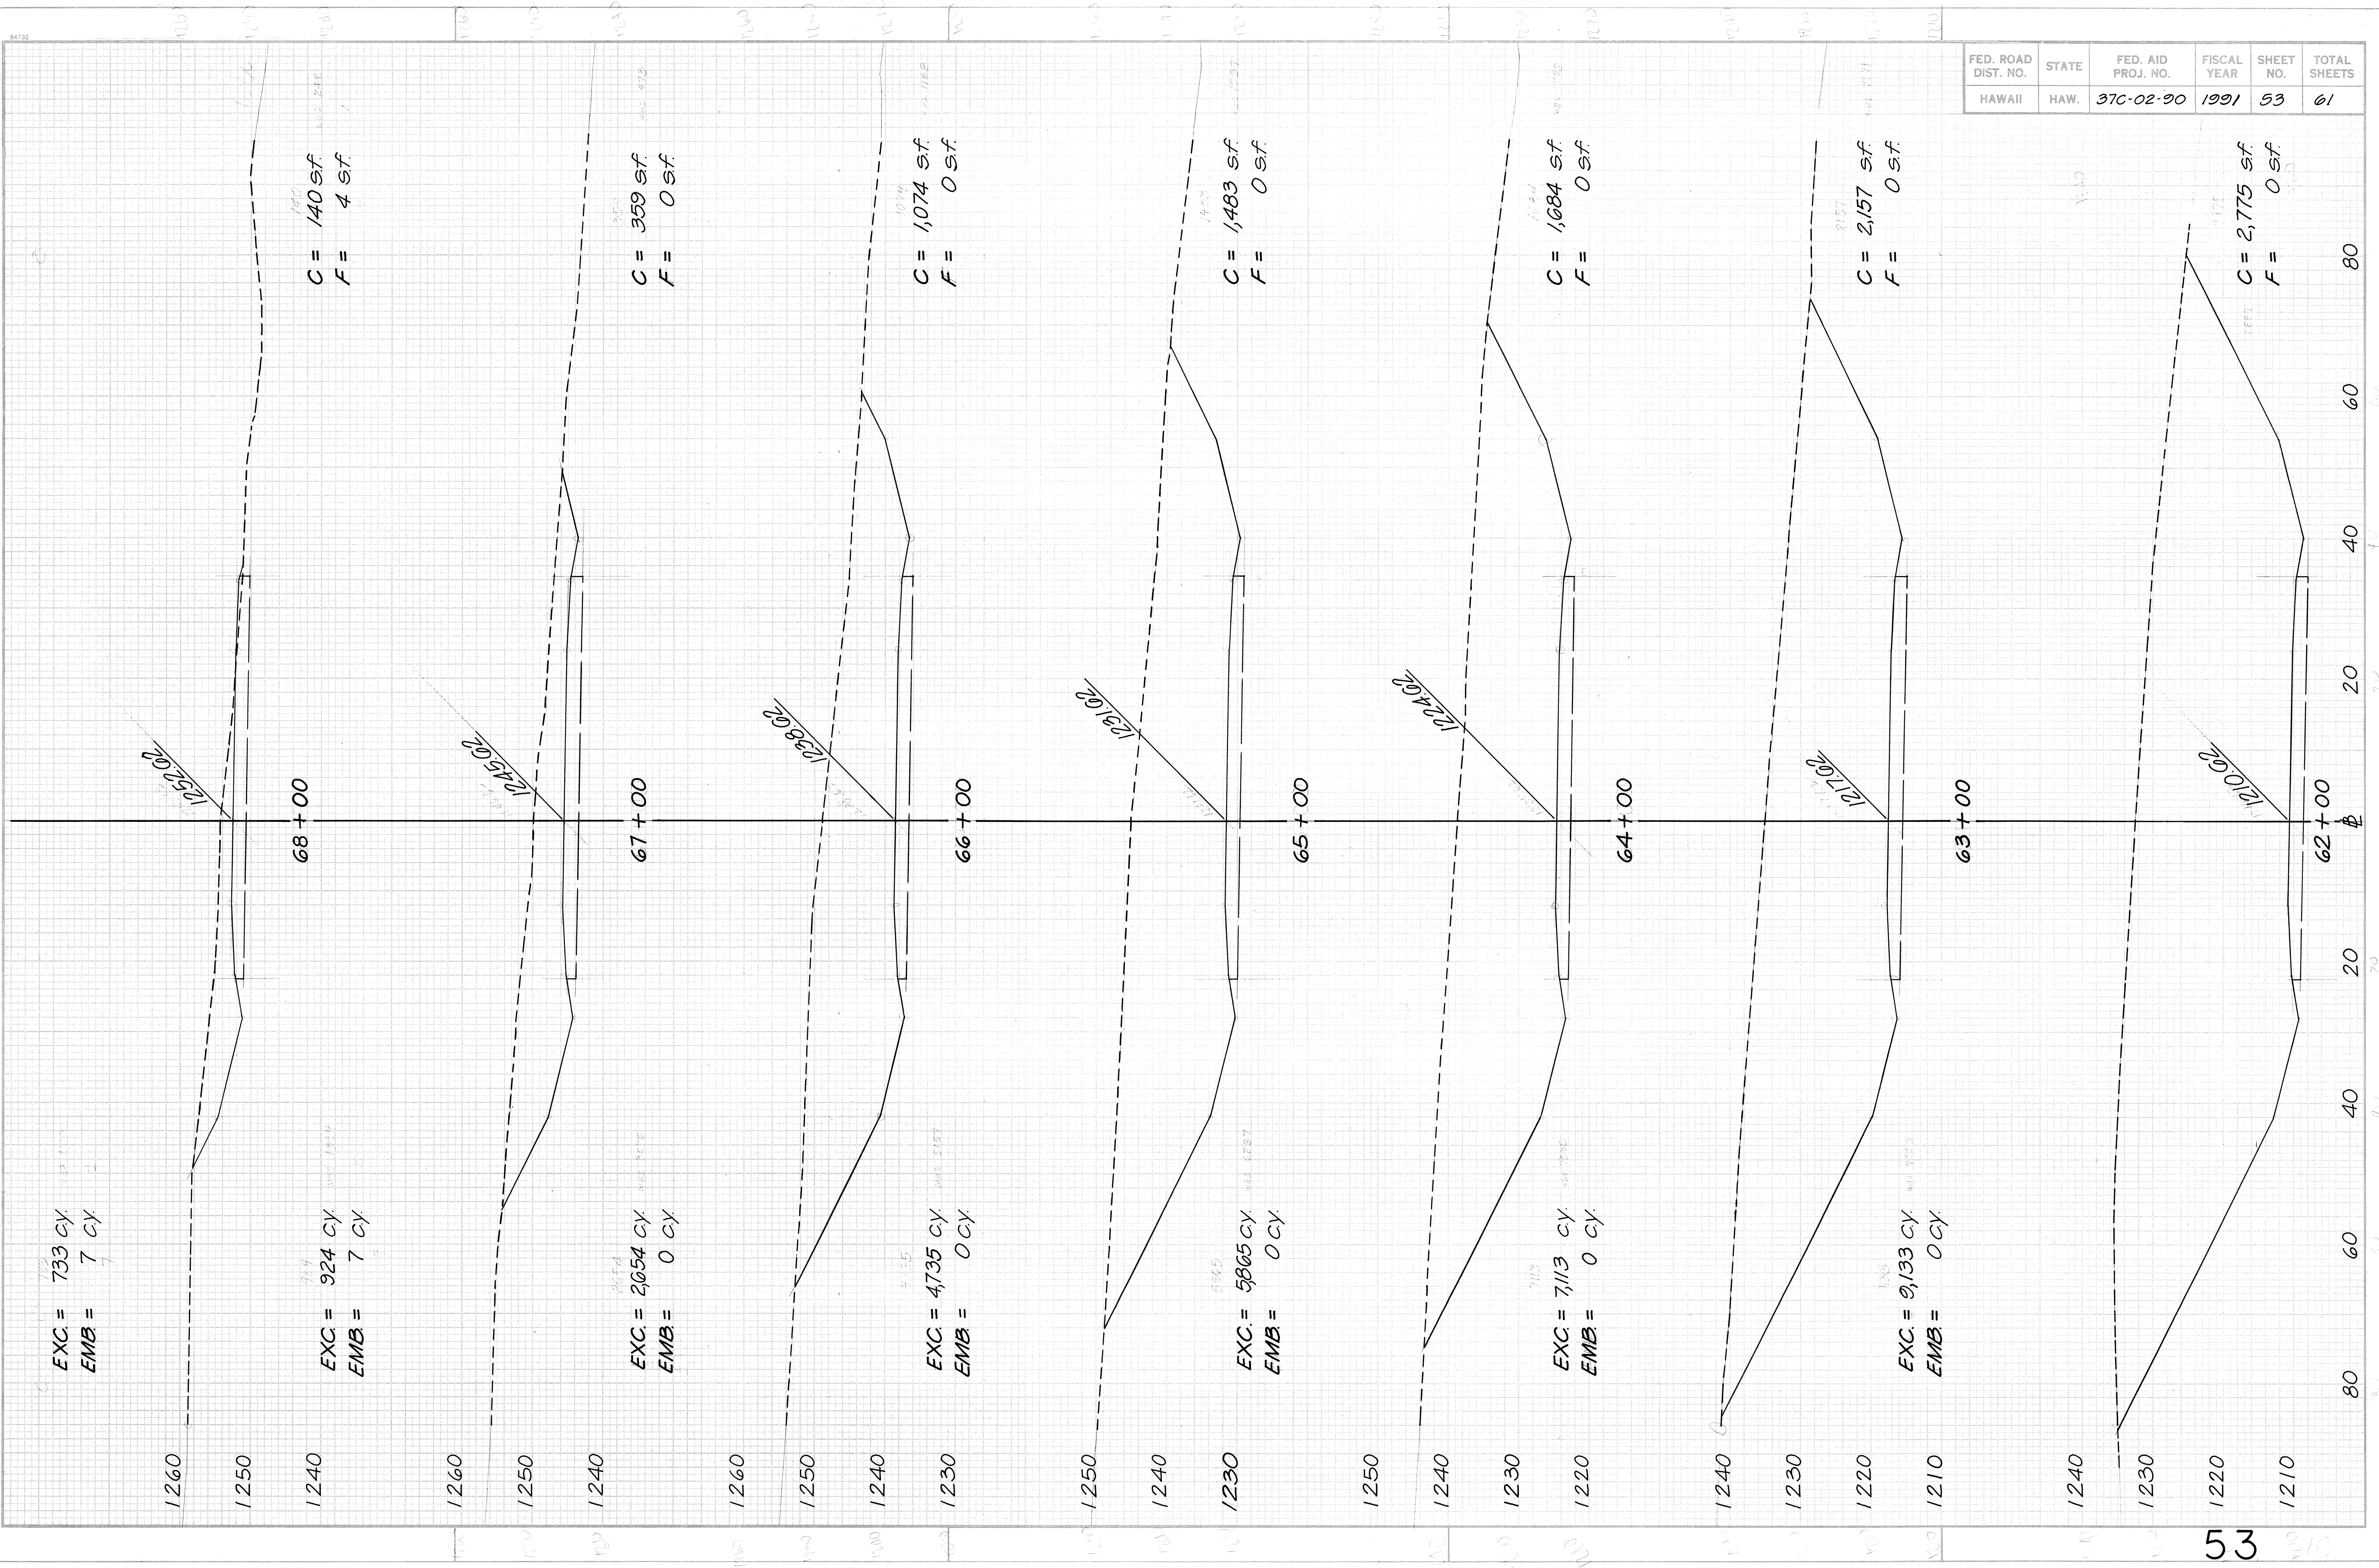

FED. ROAD DIST. NO.	STATE	FED. AID PROJ. NO.	FISCAL YEAR	SHEET NO.	TOTAL SHEETS
HAWAII	HAW.	37C-02-90	1991	53	61

ORIGINAL	SURVEY	BY	DATE
NO.	NOTE BOOK	PLOTTED	TEMPLATE
	AREAS CHECKED		


FINAL	SURVEY	BY	DATE
NO.	NOTE BOOK	PLOTTED	TEMPLATE
	AREAS CHECKED		

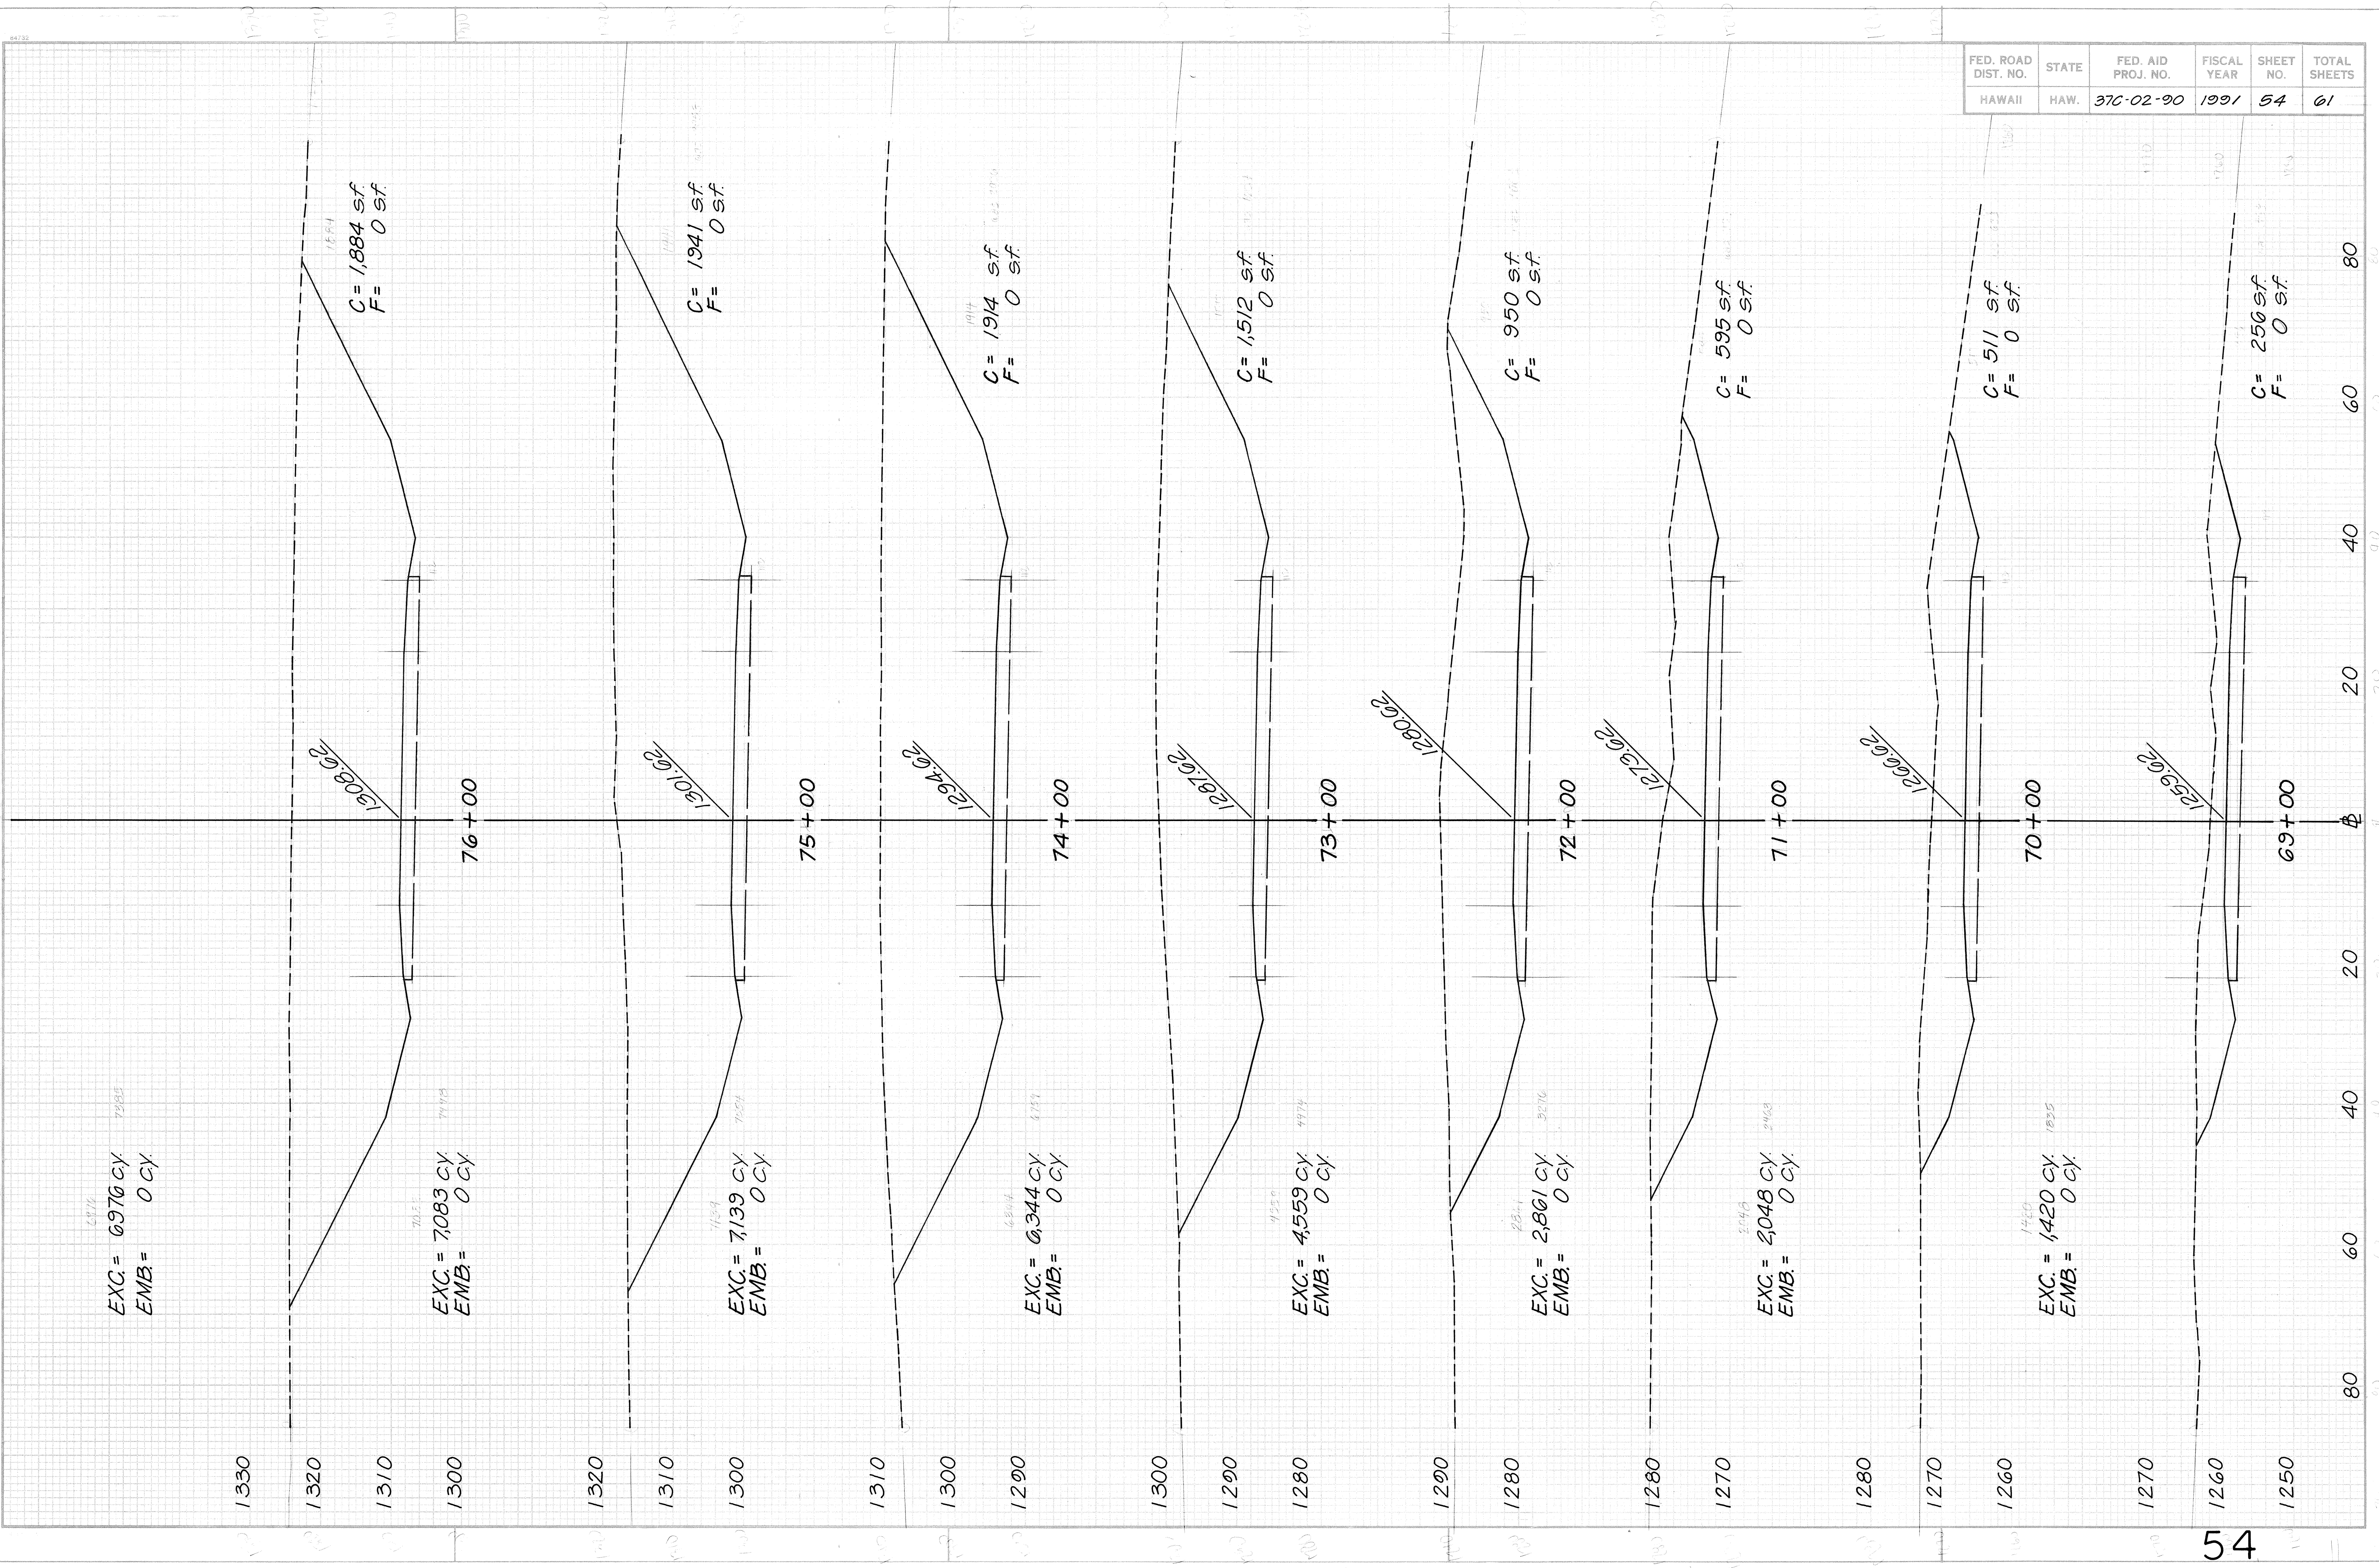

FED. ROAD DIST. NO.	STATE	FED. AID PROJ. NO.	FISCAL YEAR	SHEET NO.	TOTAL SHEETS
HAWAII	HAW.	370-02-90	1991	54	61

ORIGINAL	SURVEY	BY	DATE
NOTE BOOK	PLOTTED		
NO.	AREAS CHECKED		


FINAL	SURVEY	BY	DATE
NOTE BOOK	PLOTTED		
NO.	AREAS CHECKED		

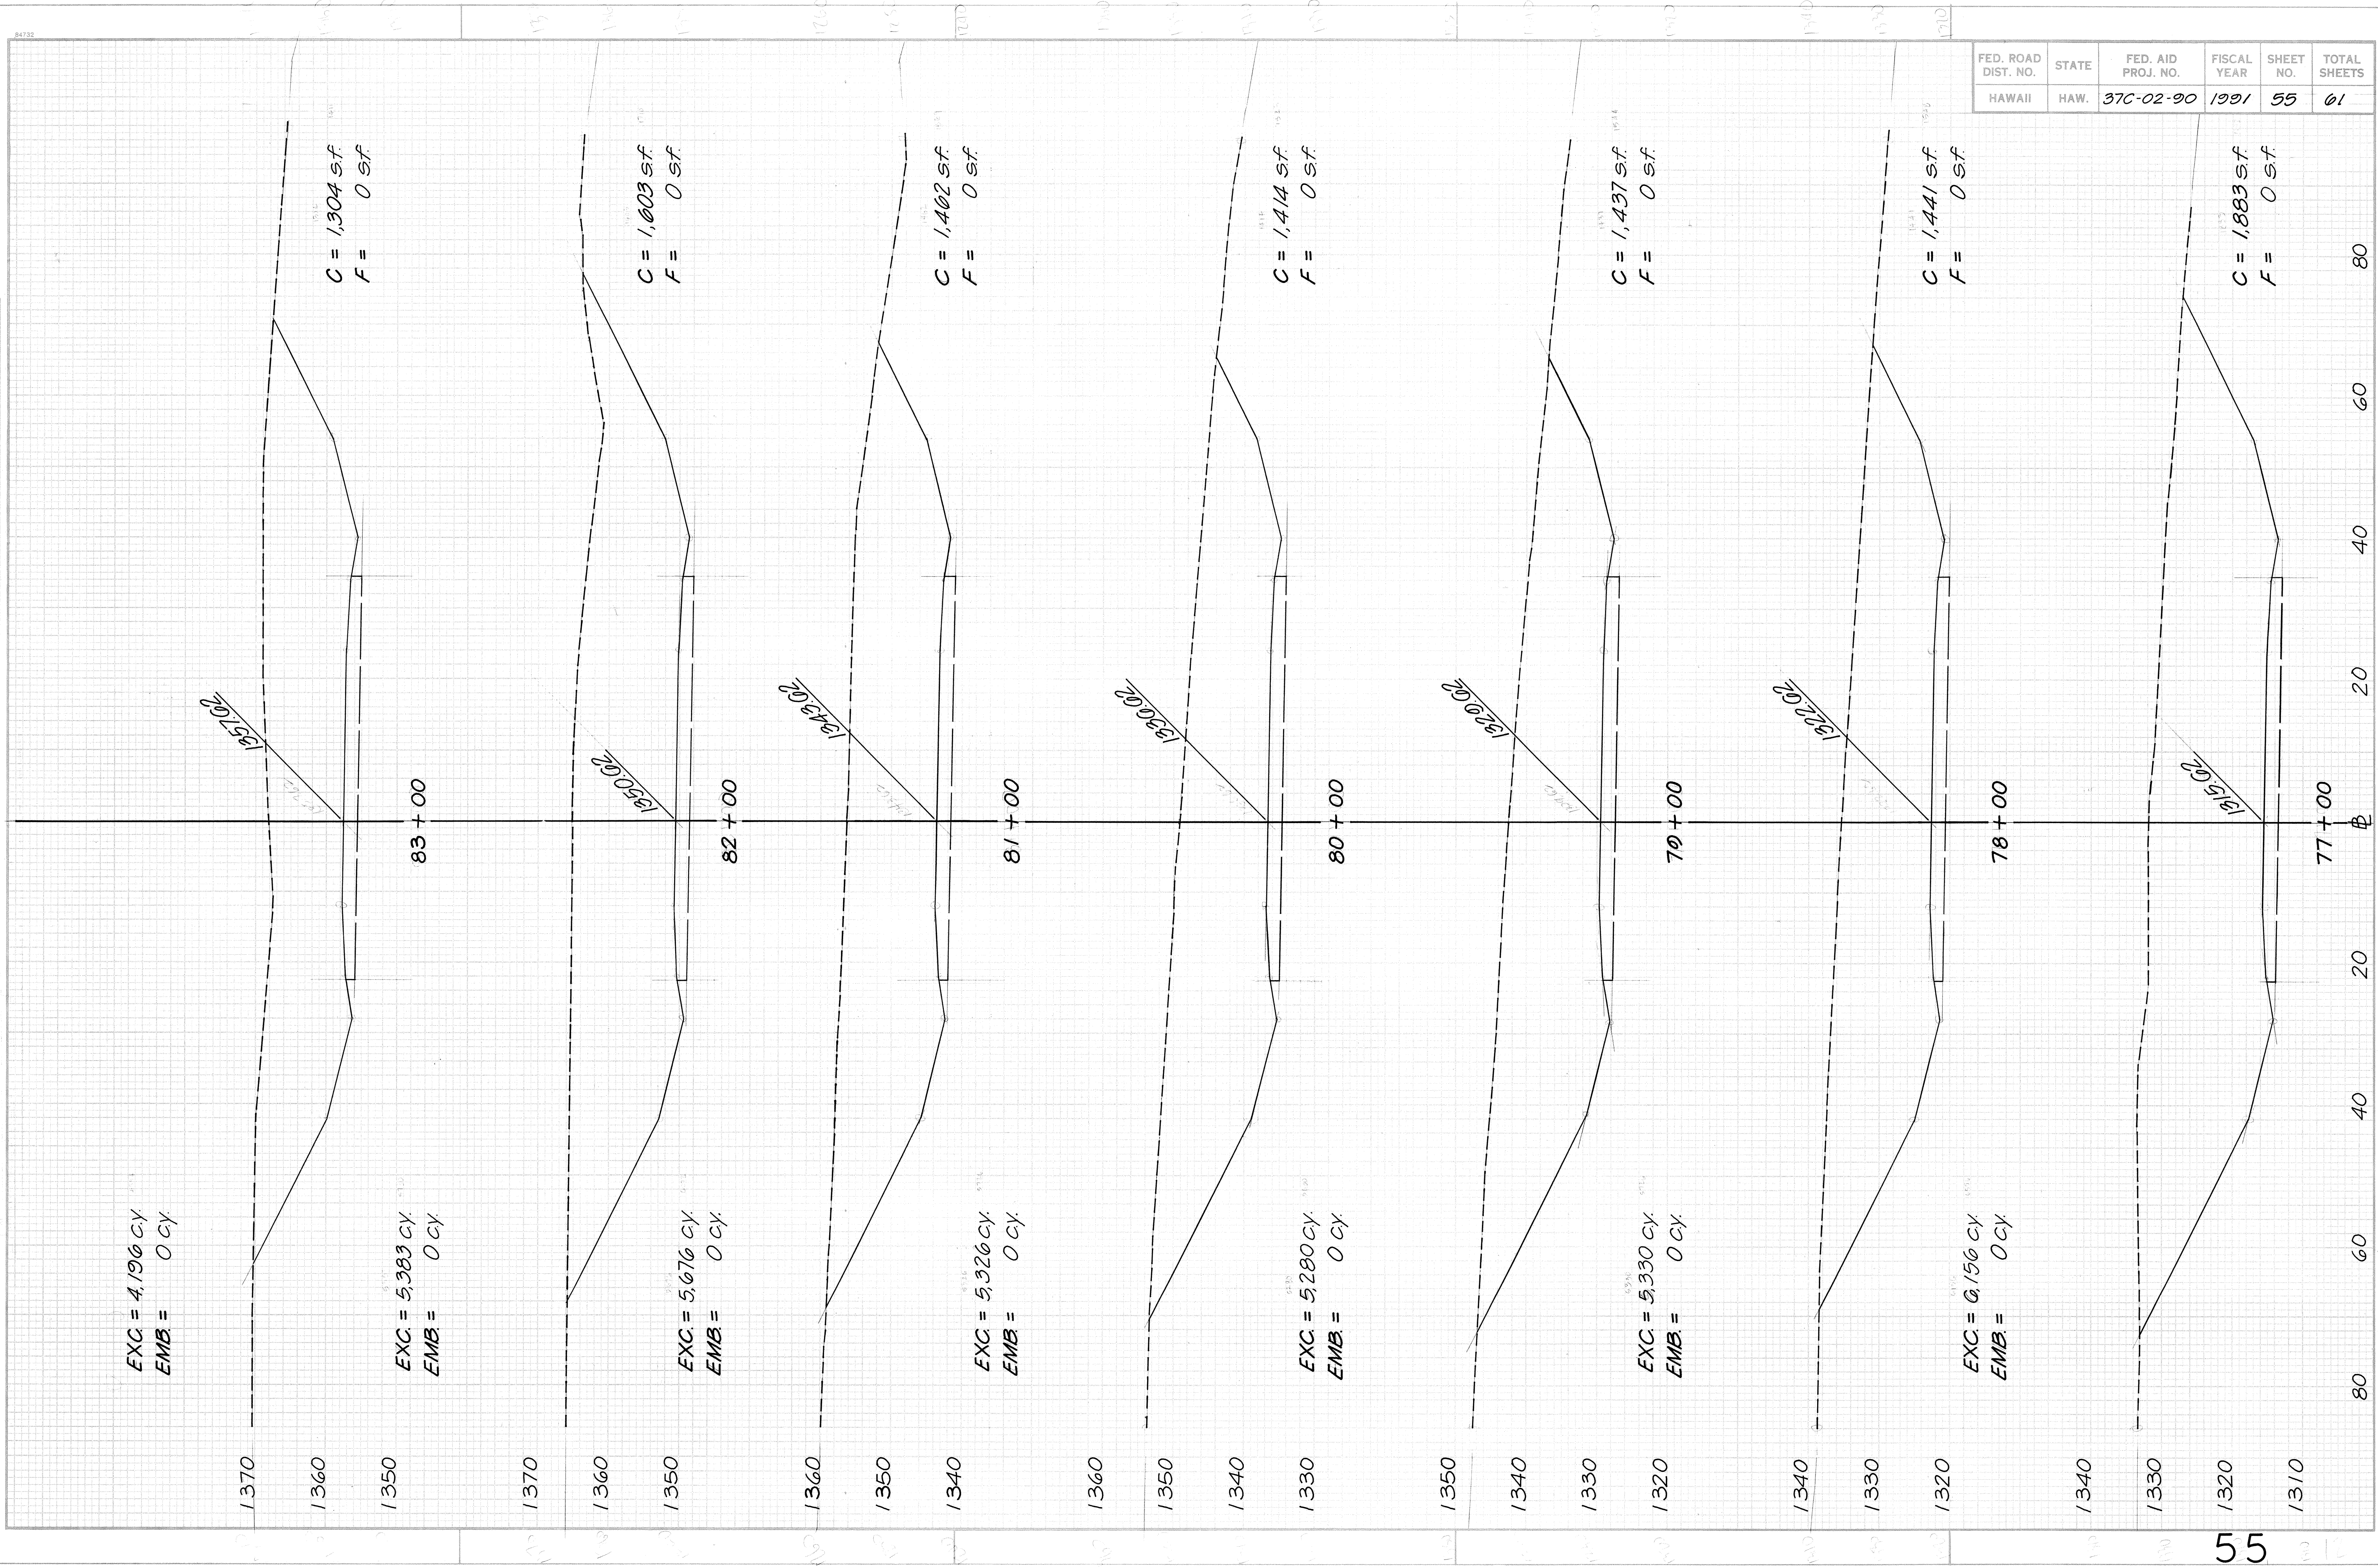

FED. ROAD DIST. NO.	STATE	FED. AID PROJ. NO.	FISCAL YEAR	SHEET NO.	TOTAL SHEETS
HAWAII	HAW.	37C-02-90	1991	55	61

ORIGINAL	SURVEY	DATE
NOTE BOOK	PLOTTED	BY
NO.	AREAS CHECKED	


FINAL	SURVEY	DATE
NOTE BOOK	PLOTTED	BY
NO.	AREAS CHECKED	

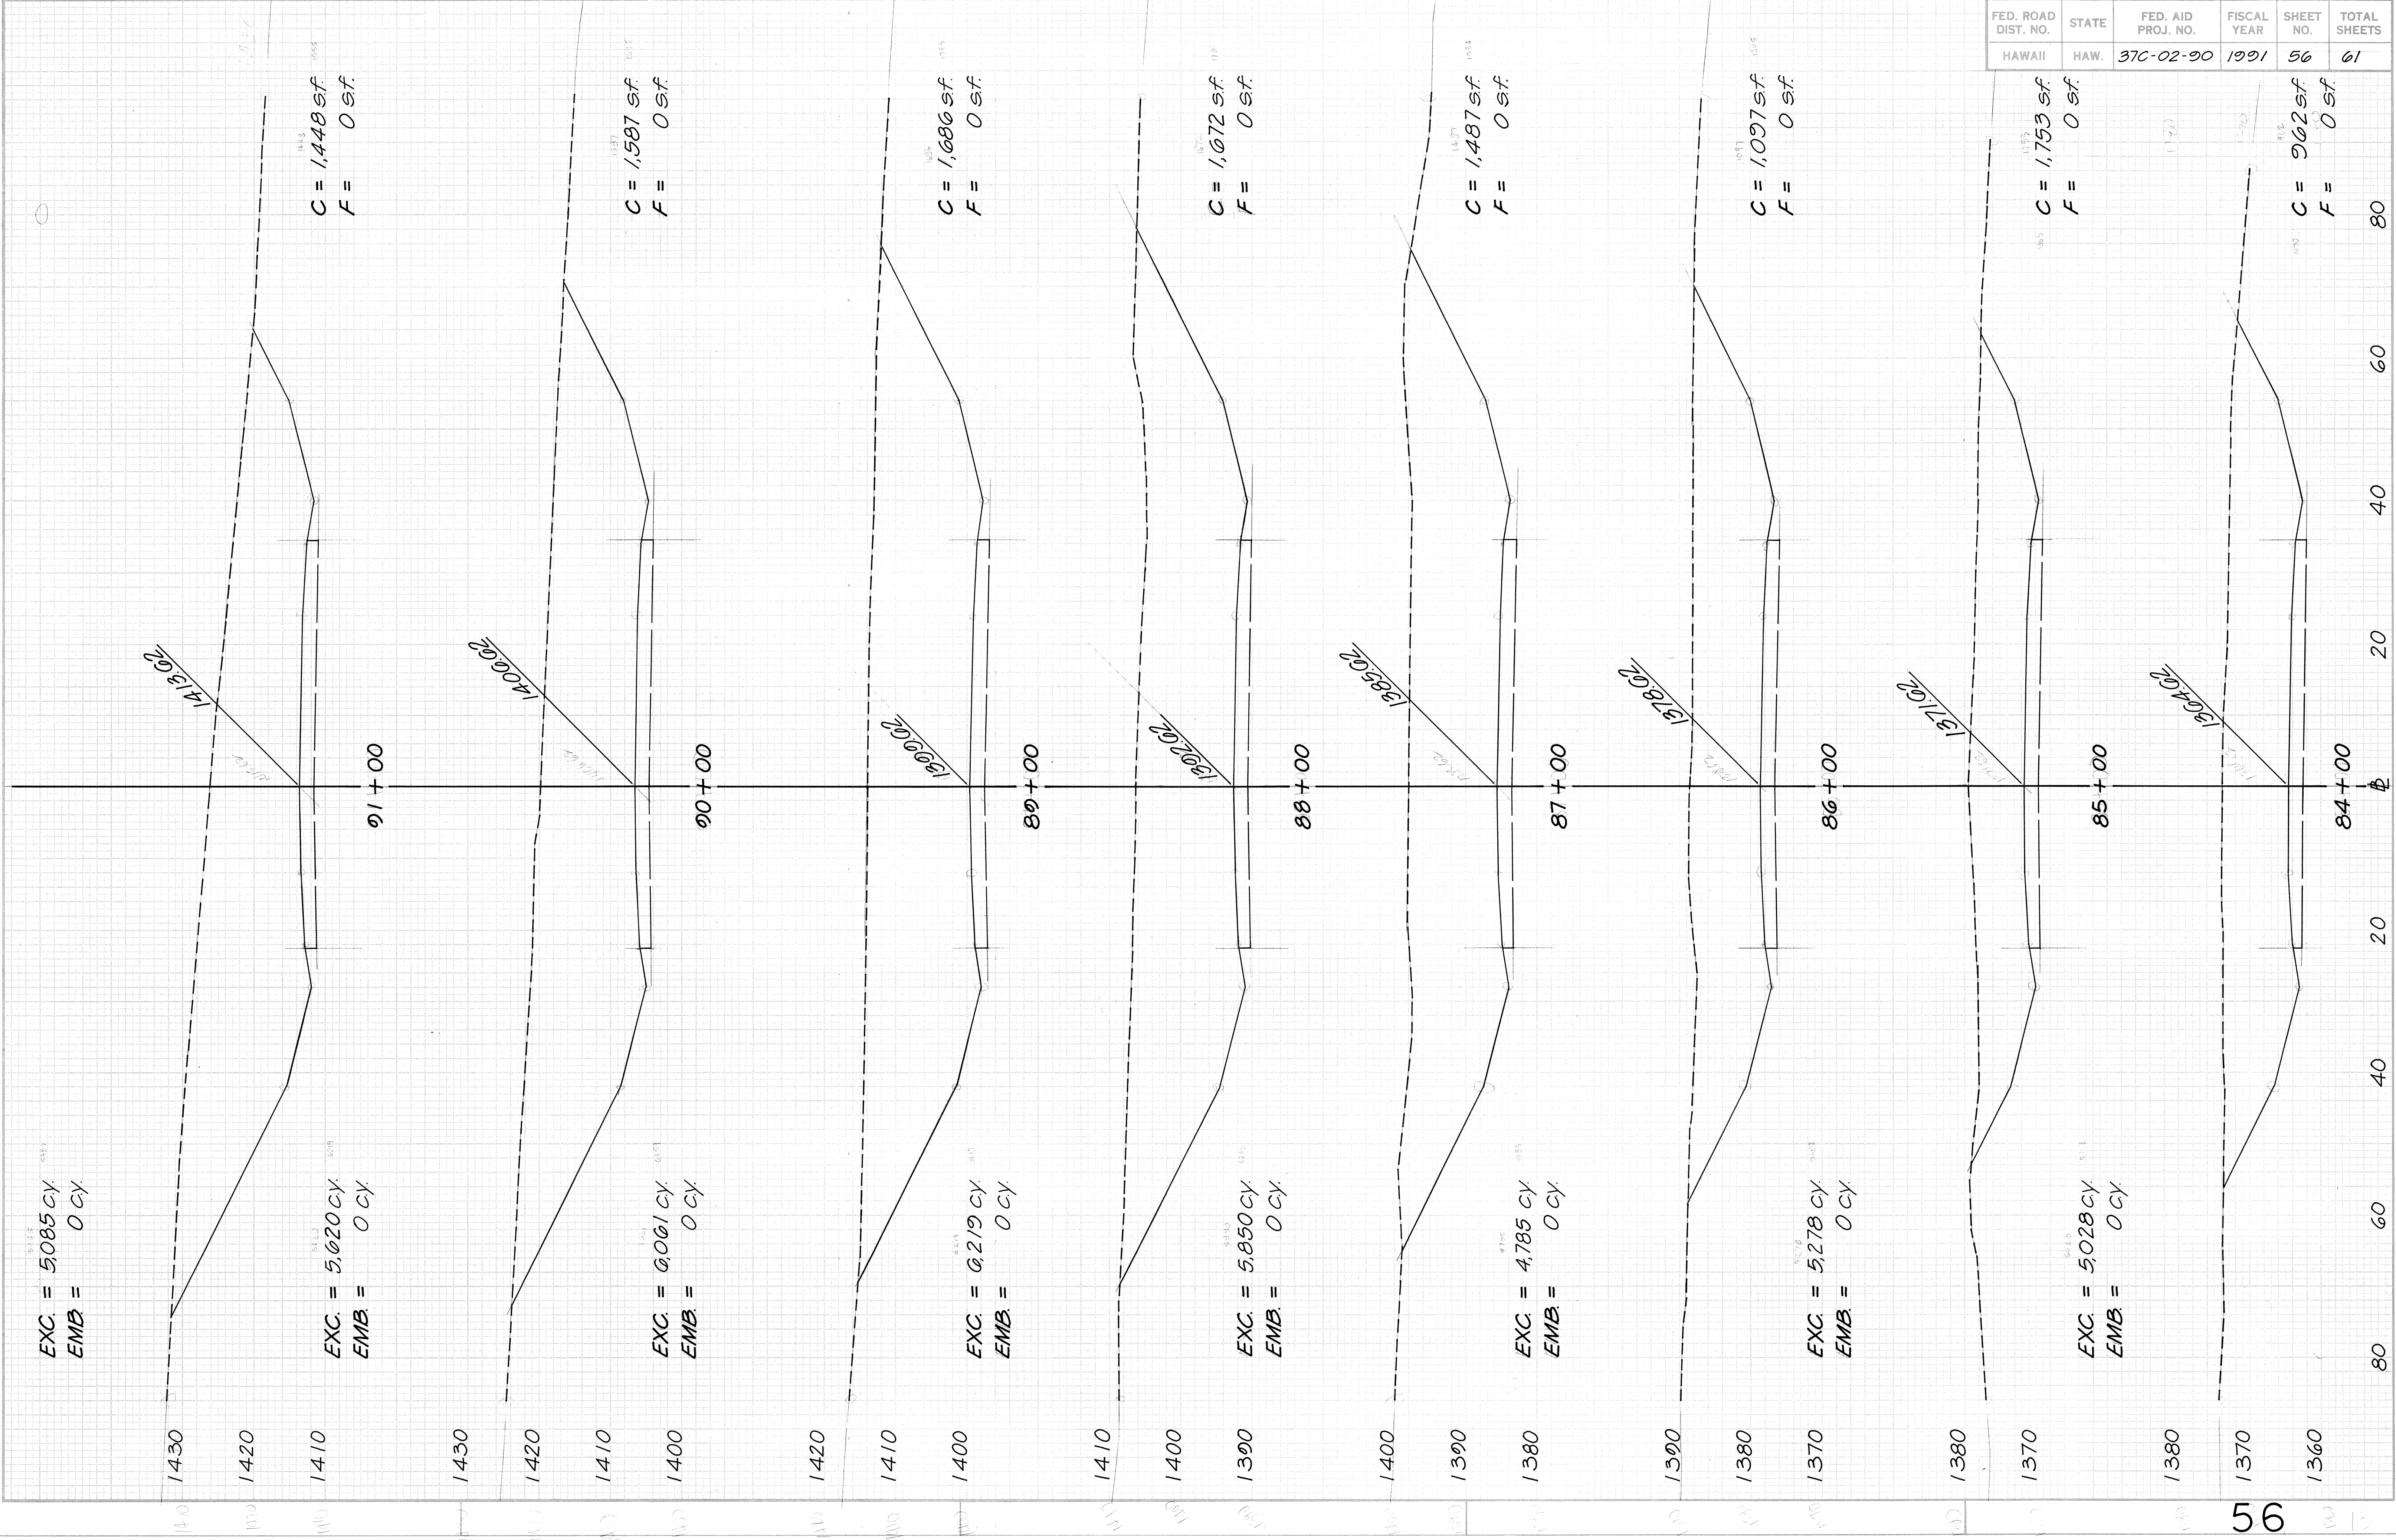

FED. ROAD DIST. NO.	STATE	FED. AID PROJ. NO.	FISCAL YEAR	SHEET NO.	TOTAL SHEETS
HAWAII	HAW.	37C-02-90	1991	56	61

ORIGINAL	SURVISED	BY	DATE
SURVEY	SURVEY		
NOTE BOOK	NOTE BOOK		
NO.	NO.		

FINAL	SURVISED	BY	DATE
SURVEY	SURVEY		
NOTE BOOK	NOTE BOOK		
NO.	NO.		

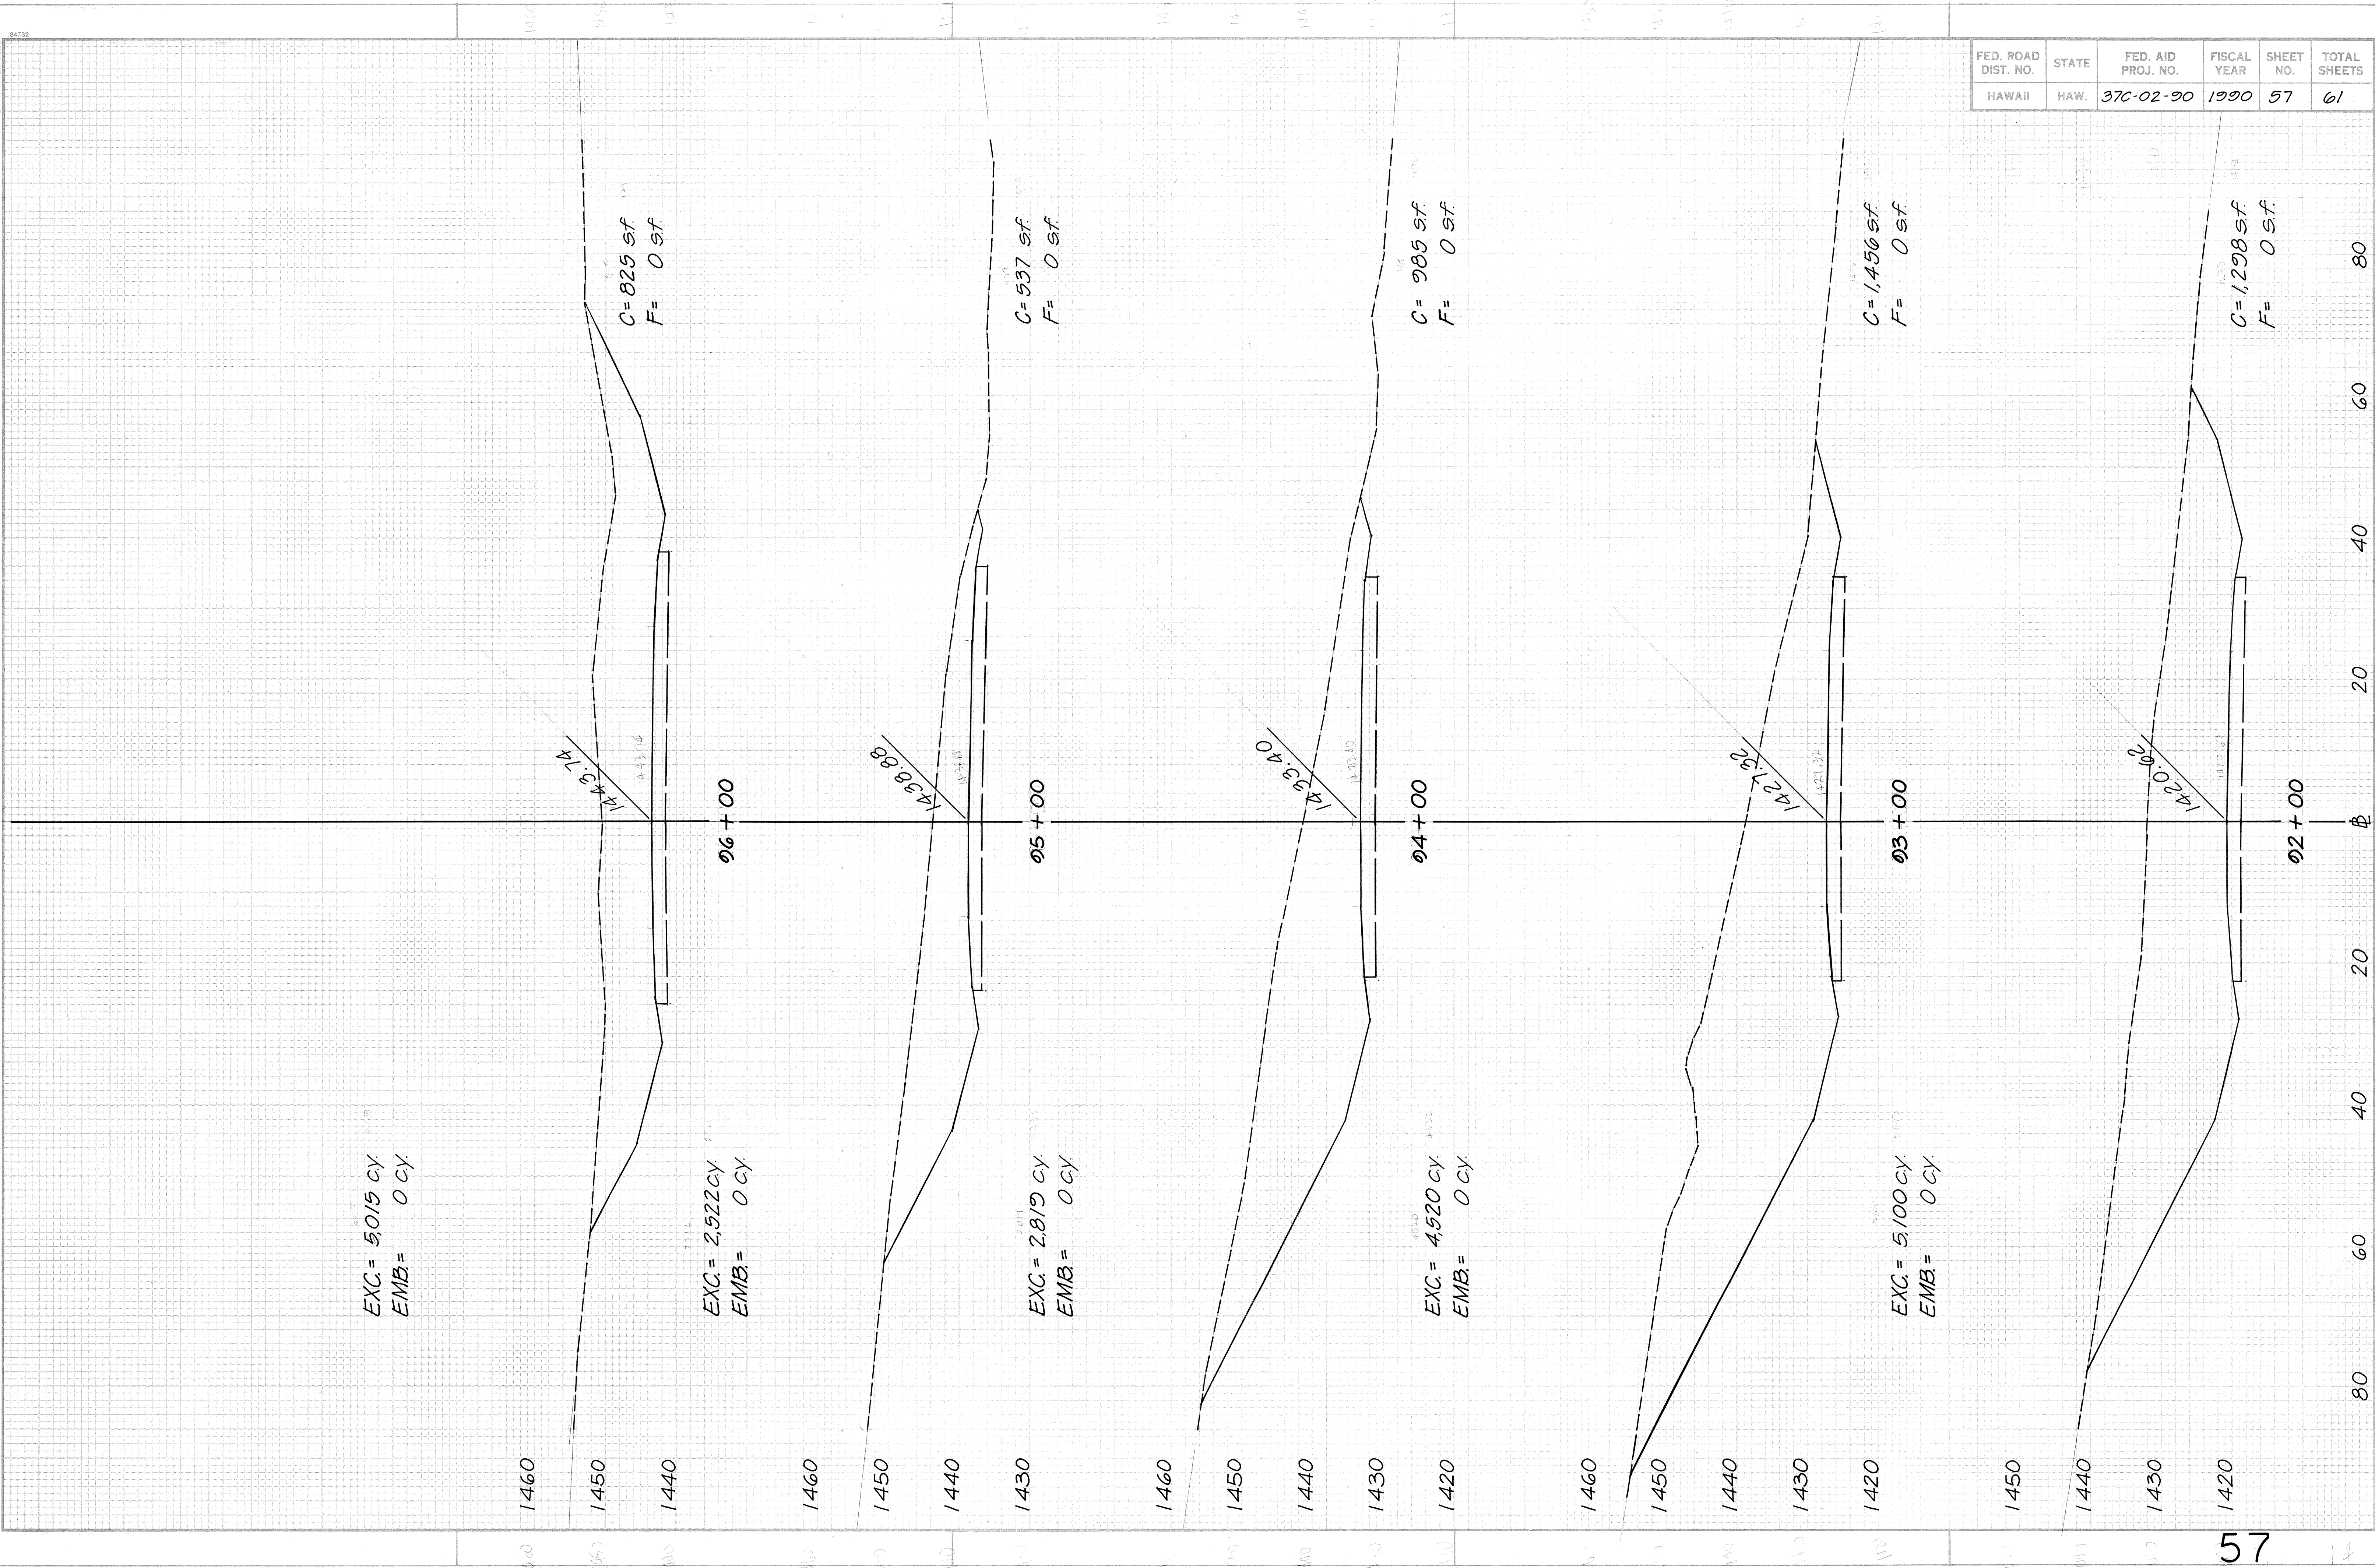


FED. ROAD DIST. NO.	STATE	FED. AID PROJ. NO.	FISCAL YEAR	SHEET NO.	TOTAL SHEETS
HAWAII	HAW.	370-02-90	1990	57	61

84732

FED. ROAD DIST. NO.	STATE	FED. AID PROJ. NO.	FISCAL YEAR	SHEET NO.	TOTAL SHEETS
HAWAII	HAW.	370-02-90	1991	58	61


FINAL SURVEY	DATE
SURVEY	BY
NOTED	
NO	

ORIGINAL SURVEY	DATE
SURVEY	BY
NOTED	
NO	

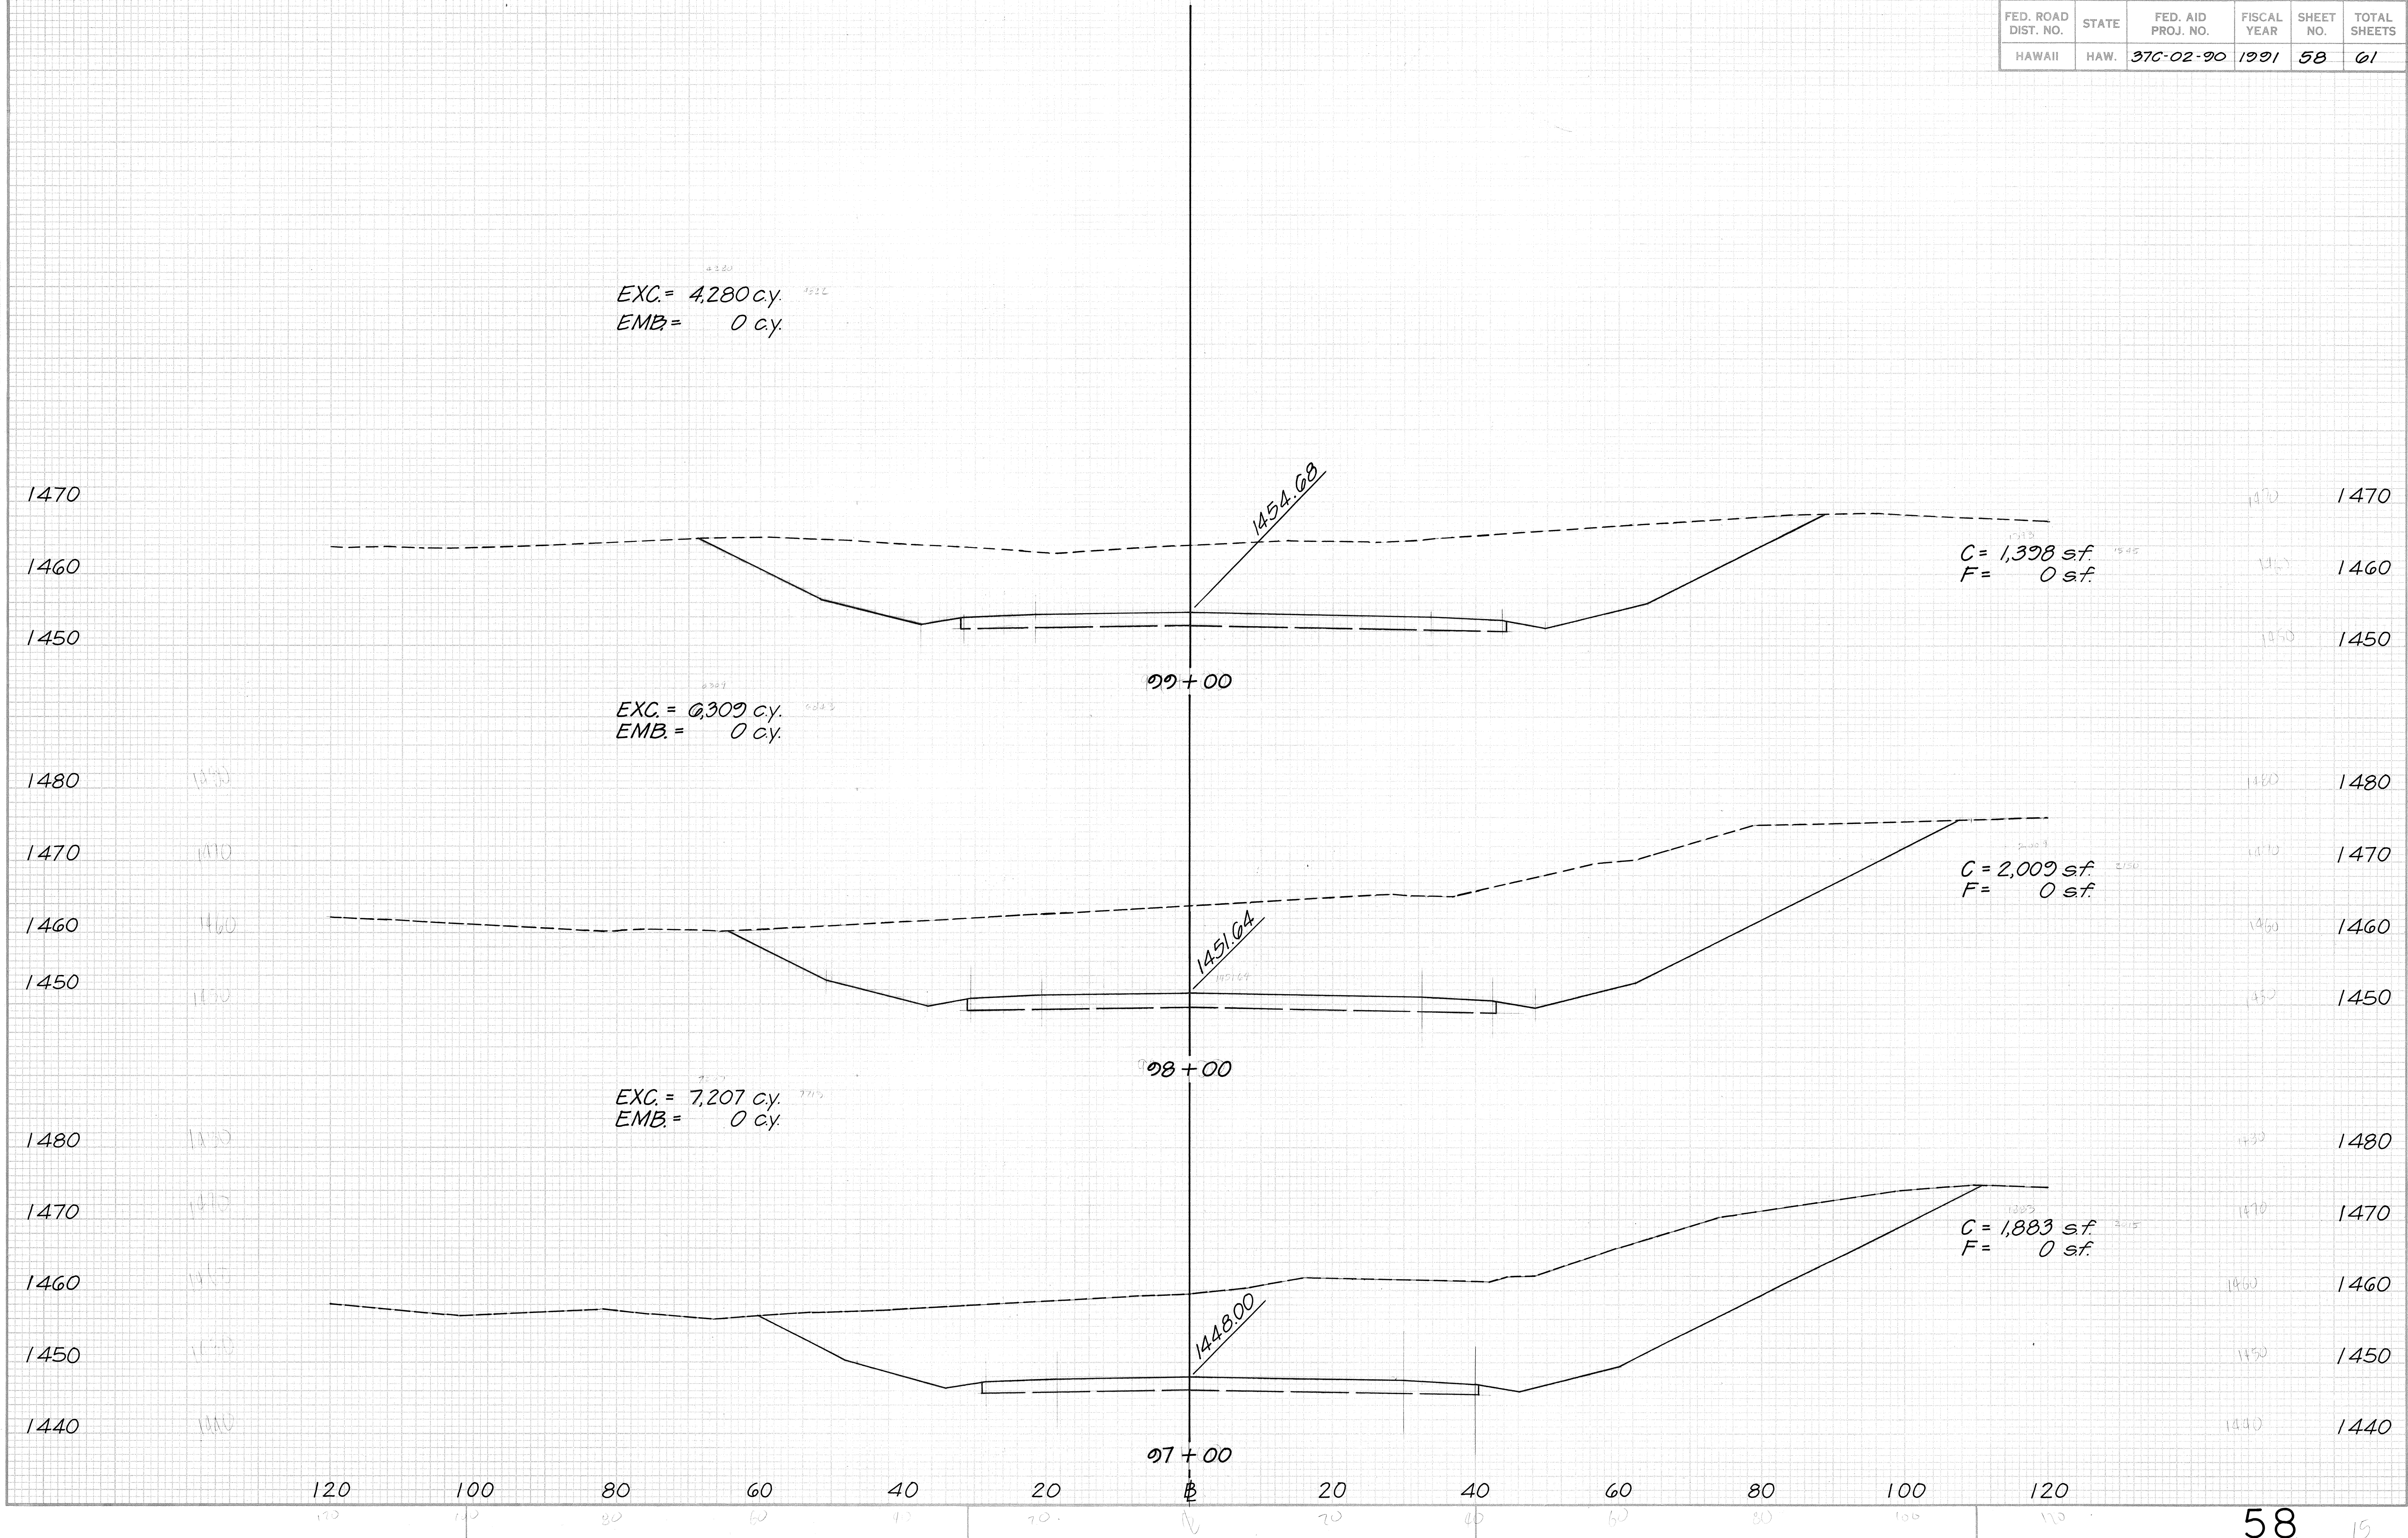


ORIGINAL	SURVEY	BY	DATE
NO.	NOTE BOOK	AREAS CHECKED	

FINAL	SURVEY	BY	DATE
NO.	NOTE BOOK	AREAS CHECKED	

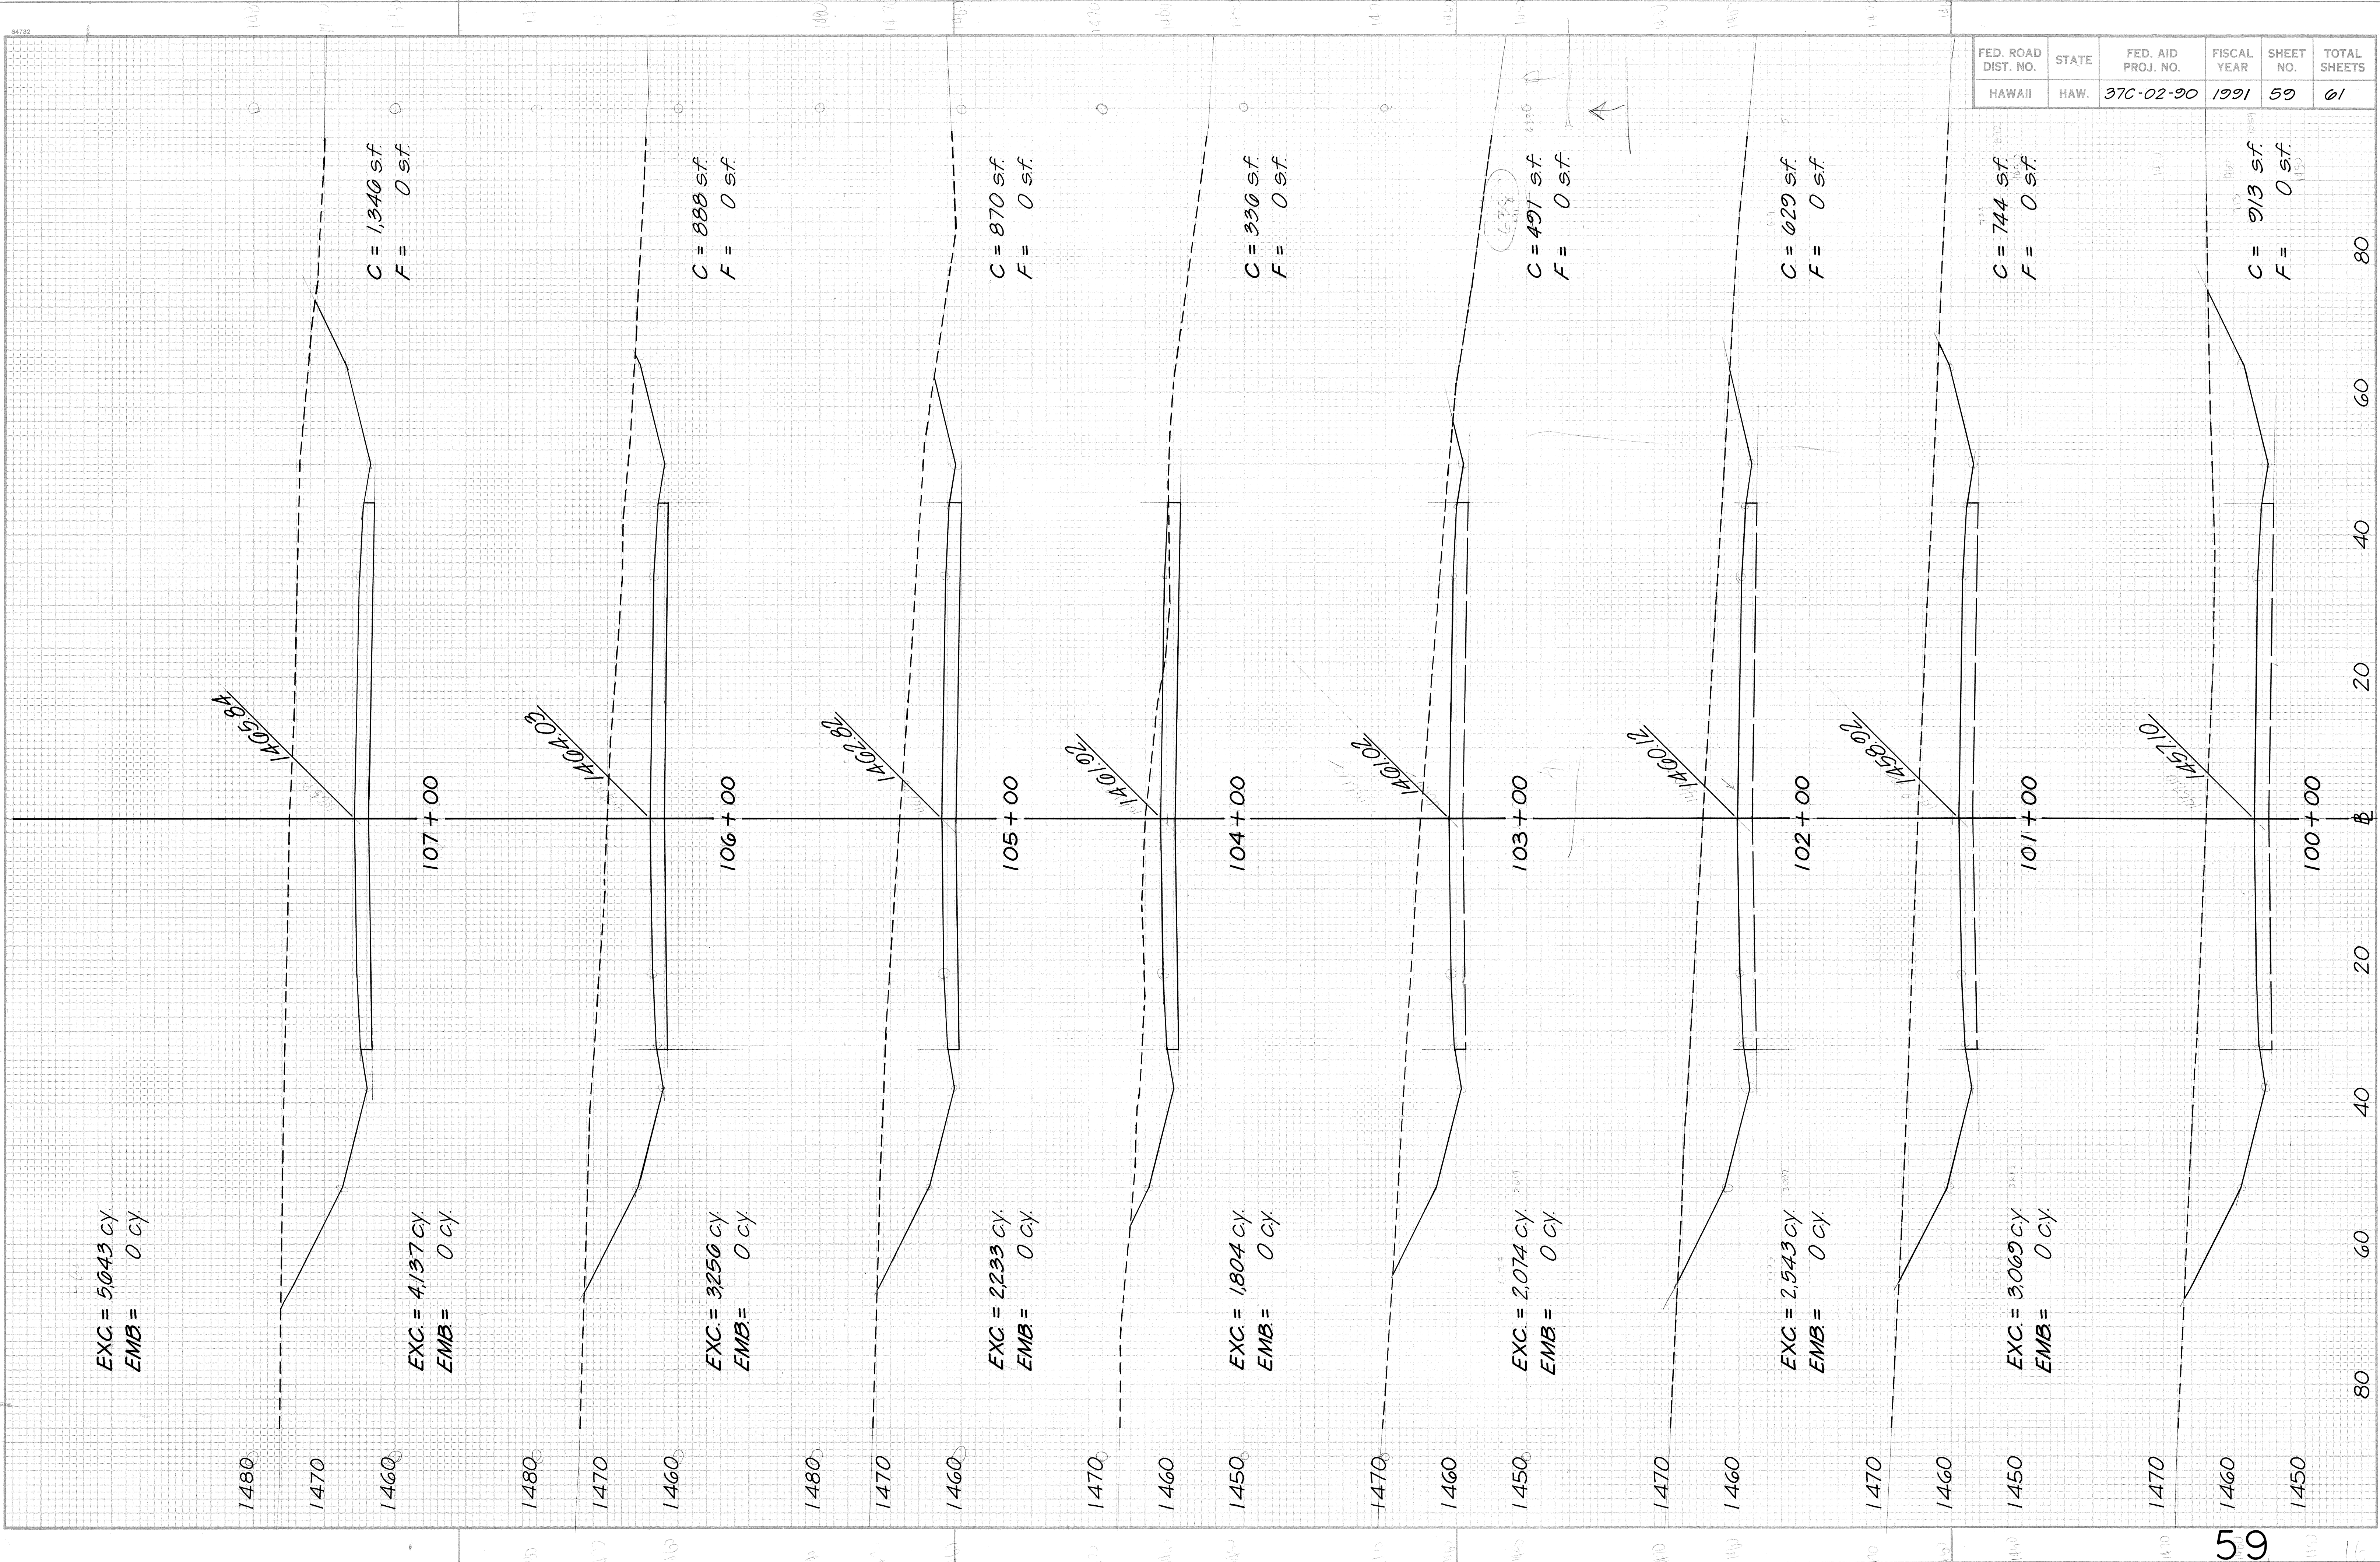



FED. ROAD DIST. NO.	STATE	FED. AID PROJ. NO.	FISCAL YEAR	SHEET NO.	TOTAL SHEETS
HAWAII	HAW.	370-02-90	1991	59	61

ORIGINAL PLAN	SURVEY PLOTTED BY	DATE
NOTE BOOK	DESIGNED BY	
QUANTITIES BY	CHECKED BY	
NO.		

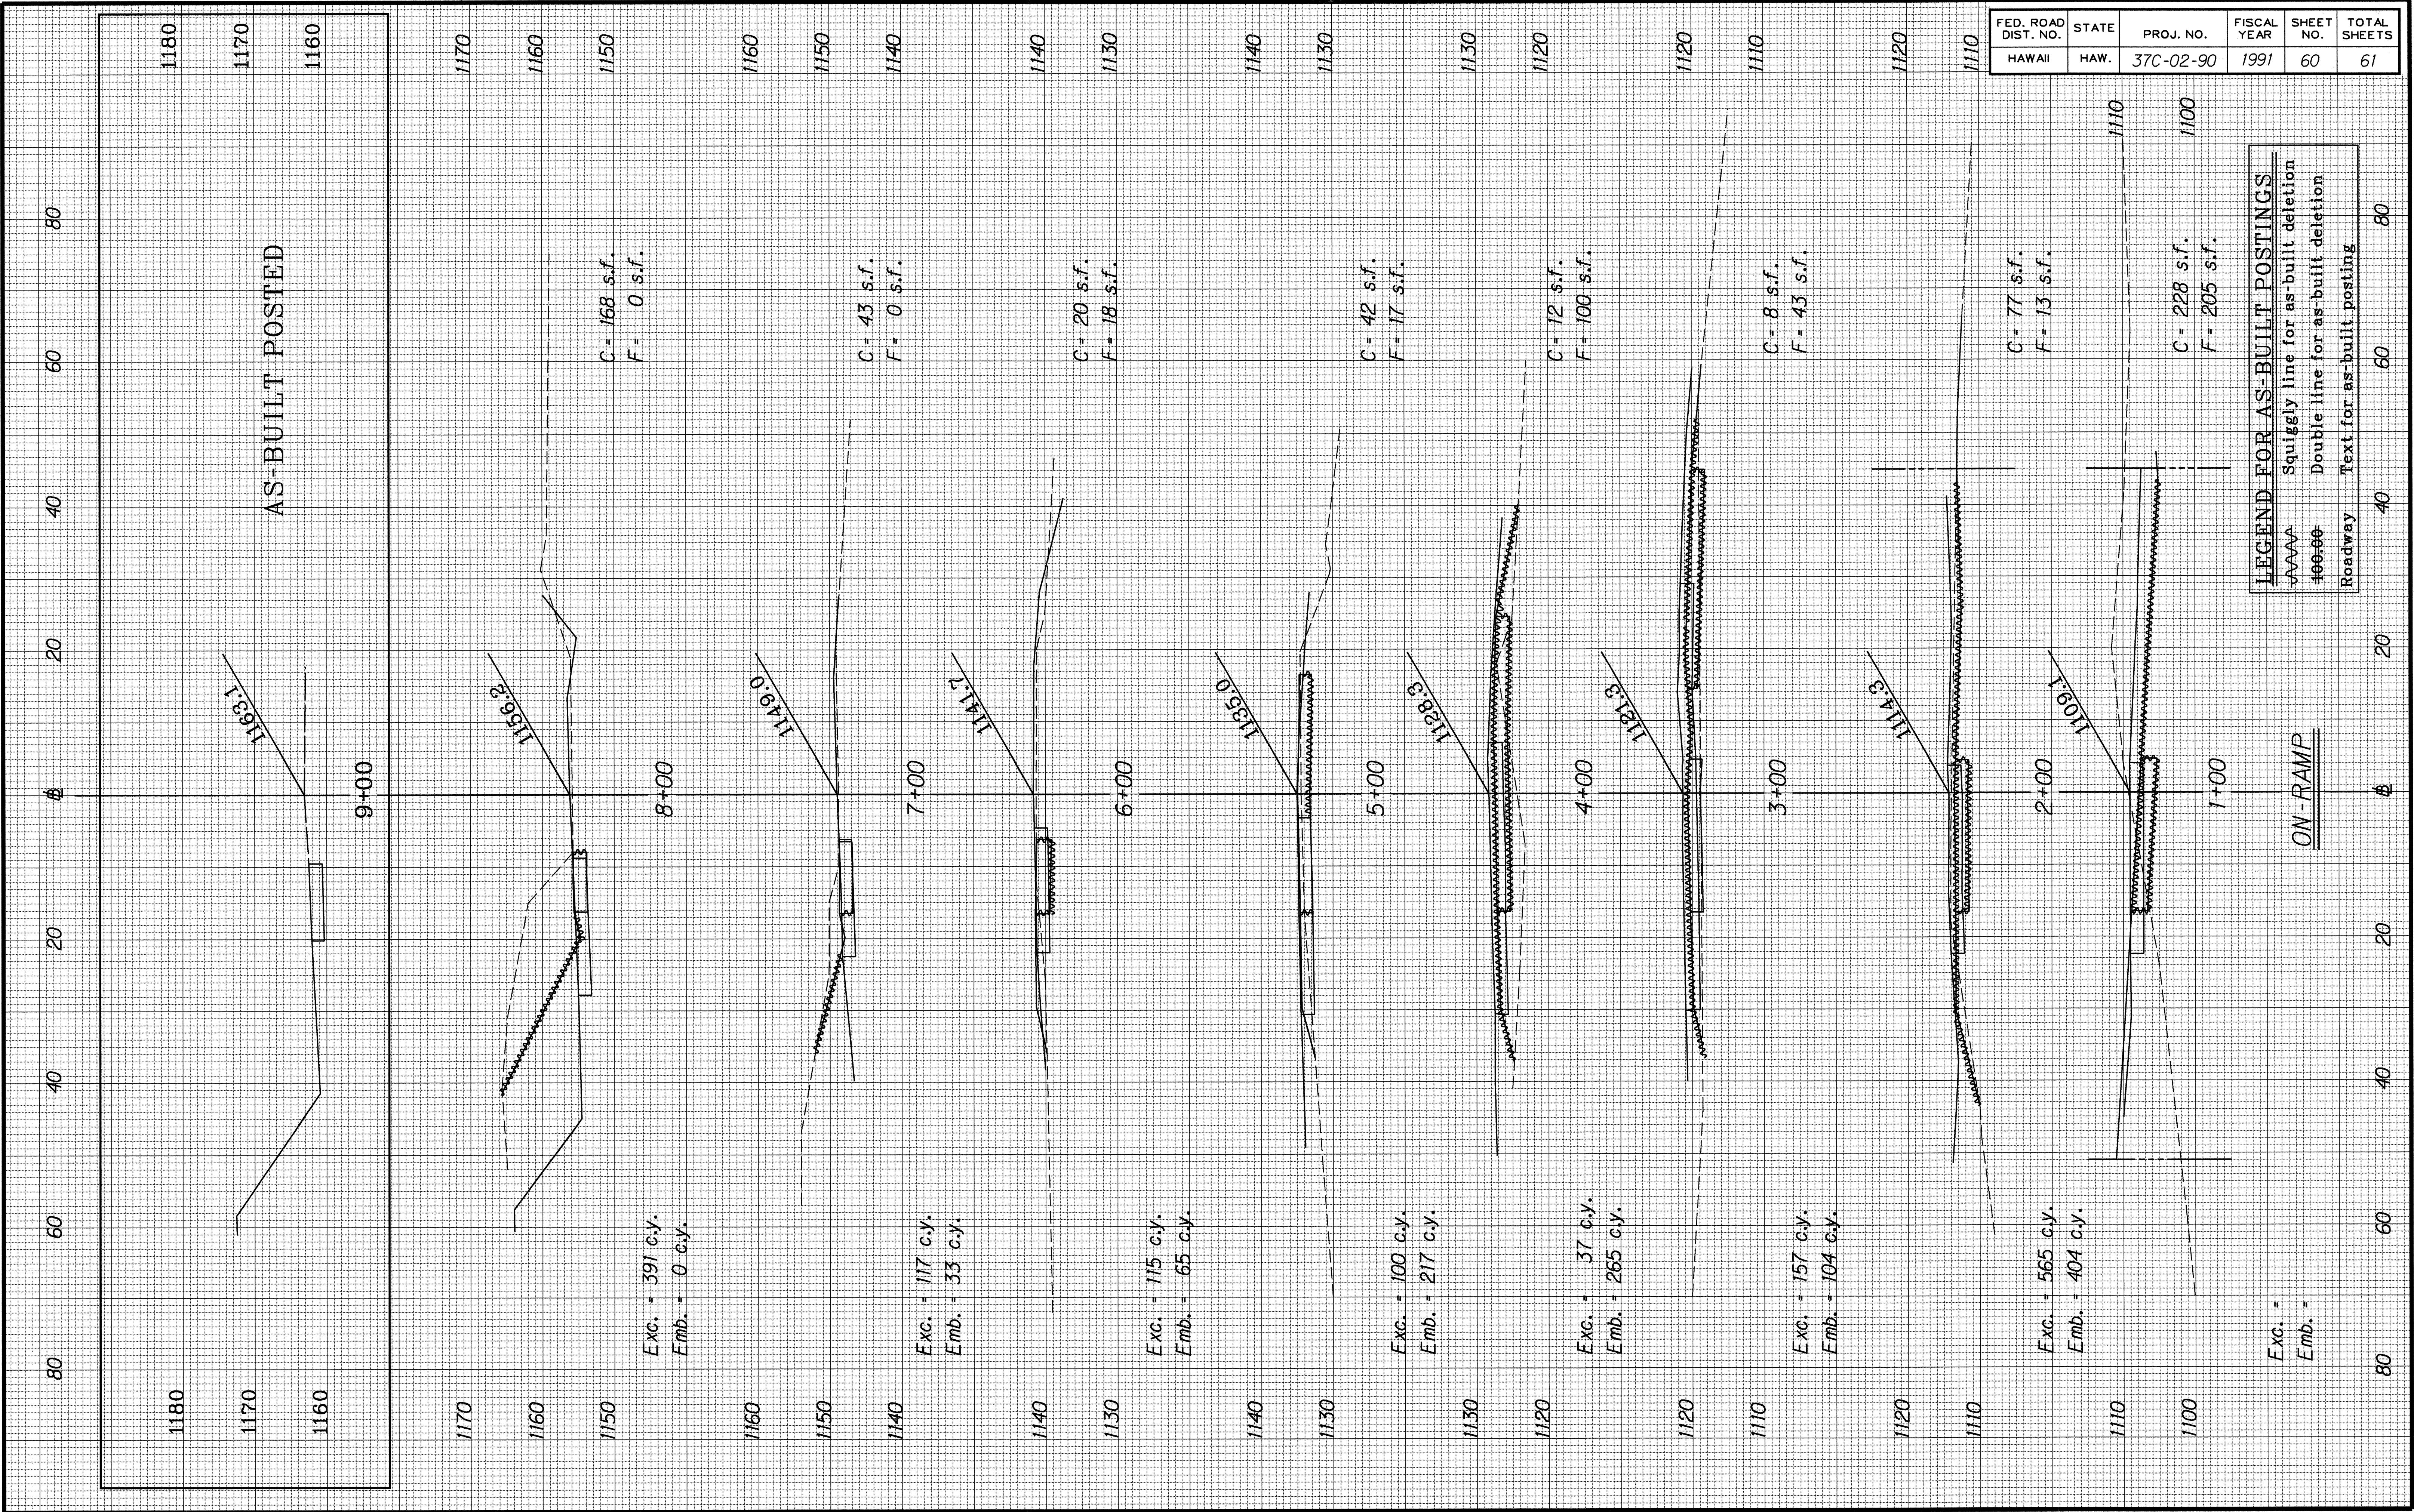

FED. ROAD DIST. NO.	STATE	PROJ. NO.	FISCAL YEAR	SHEET NO.	TOTAL SHEETS
HAWAII	HAW.	37C-02-90	1991	60	61

FED. ROAD DIST. NO.	STATE	PROJ. NO.	FISCAL YEAR	SHEET NO.	TOTAL SHEETS
HAWAII	HAW.	37C-02-90	1991	61	61

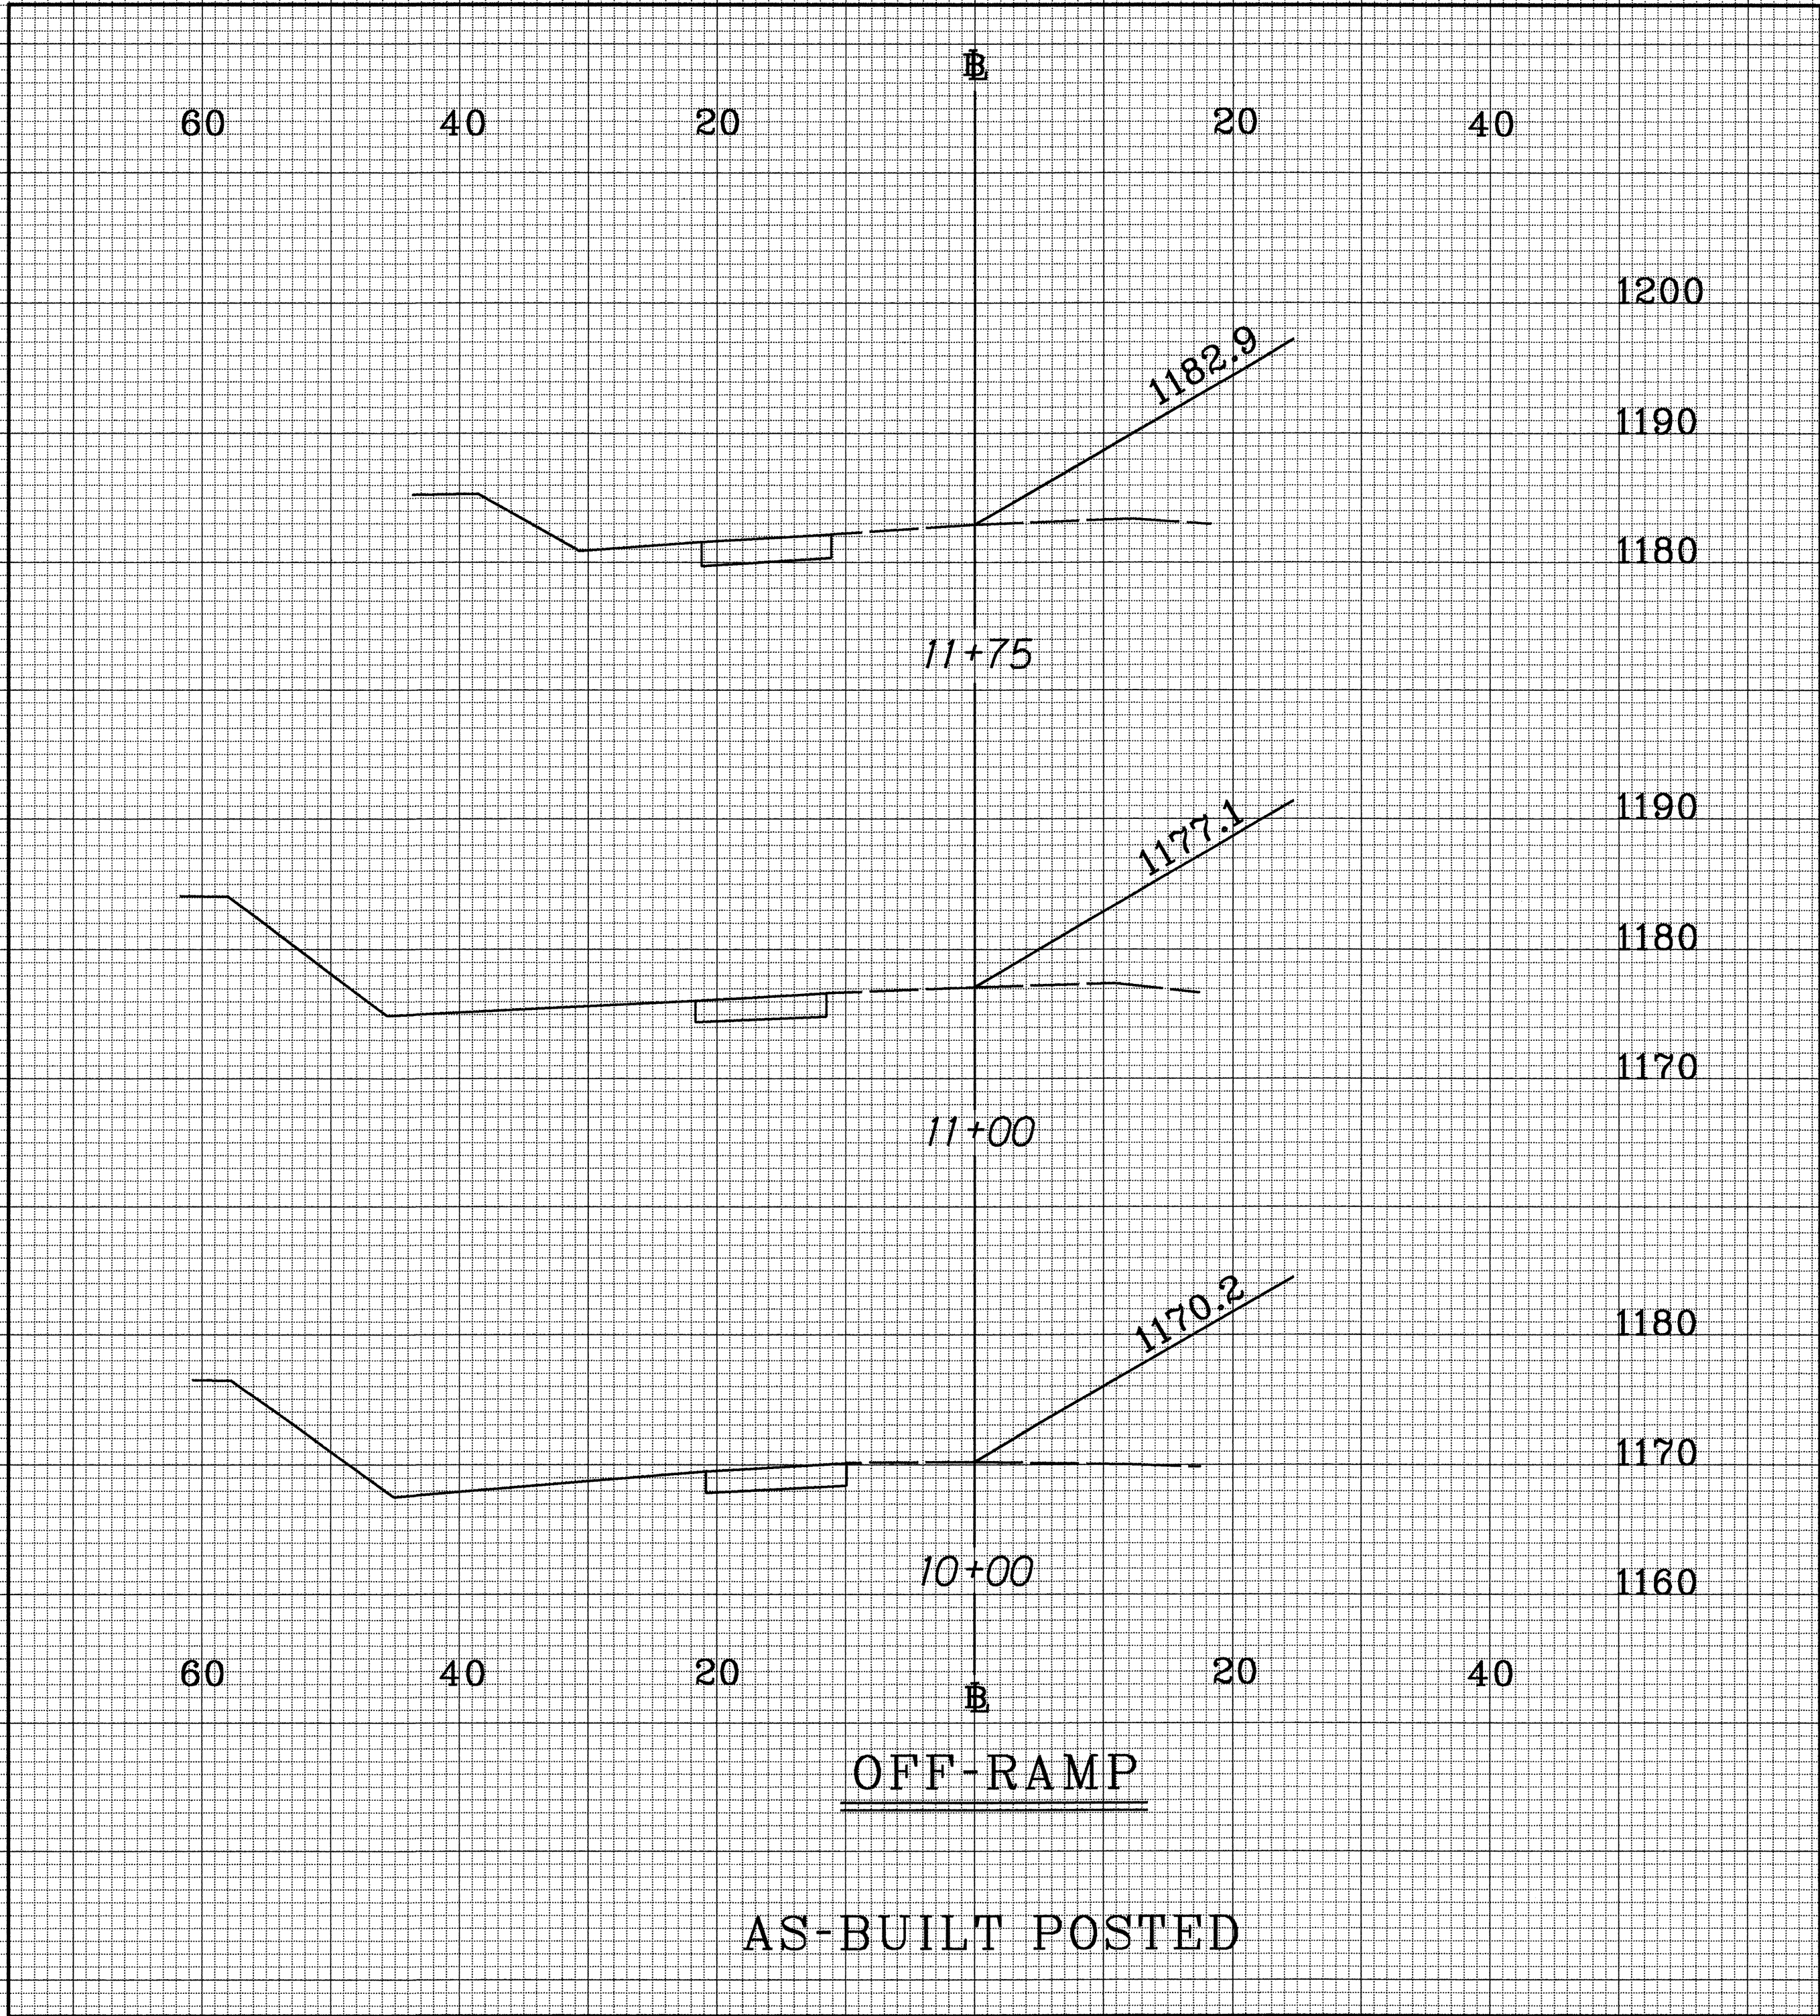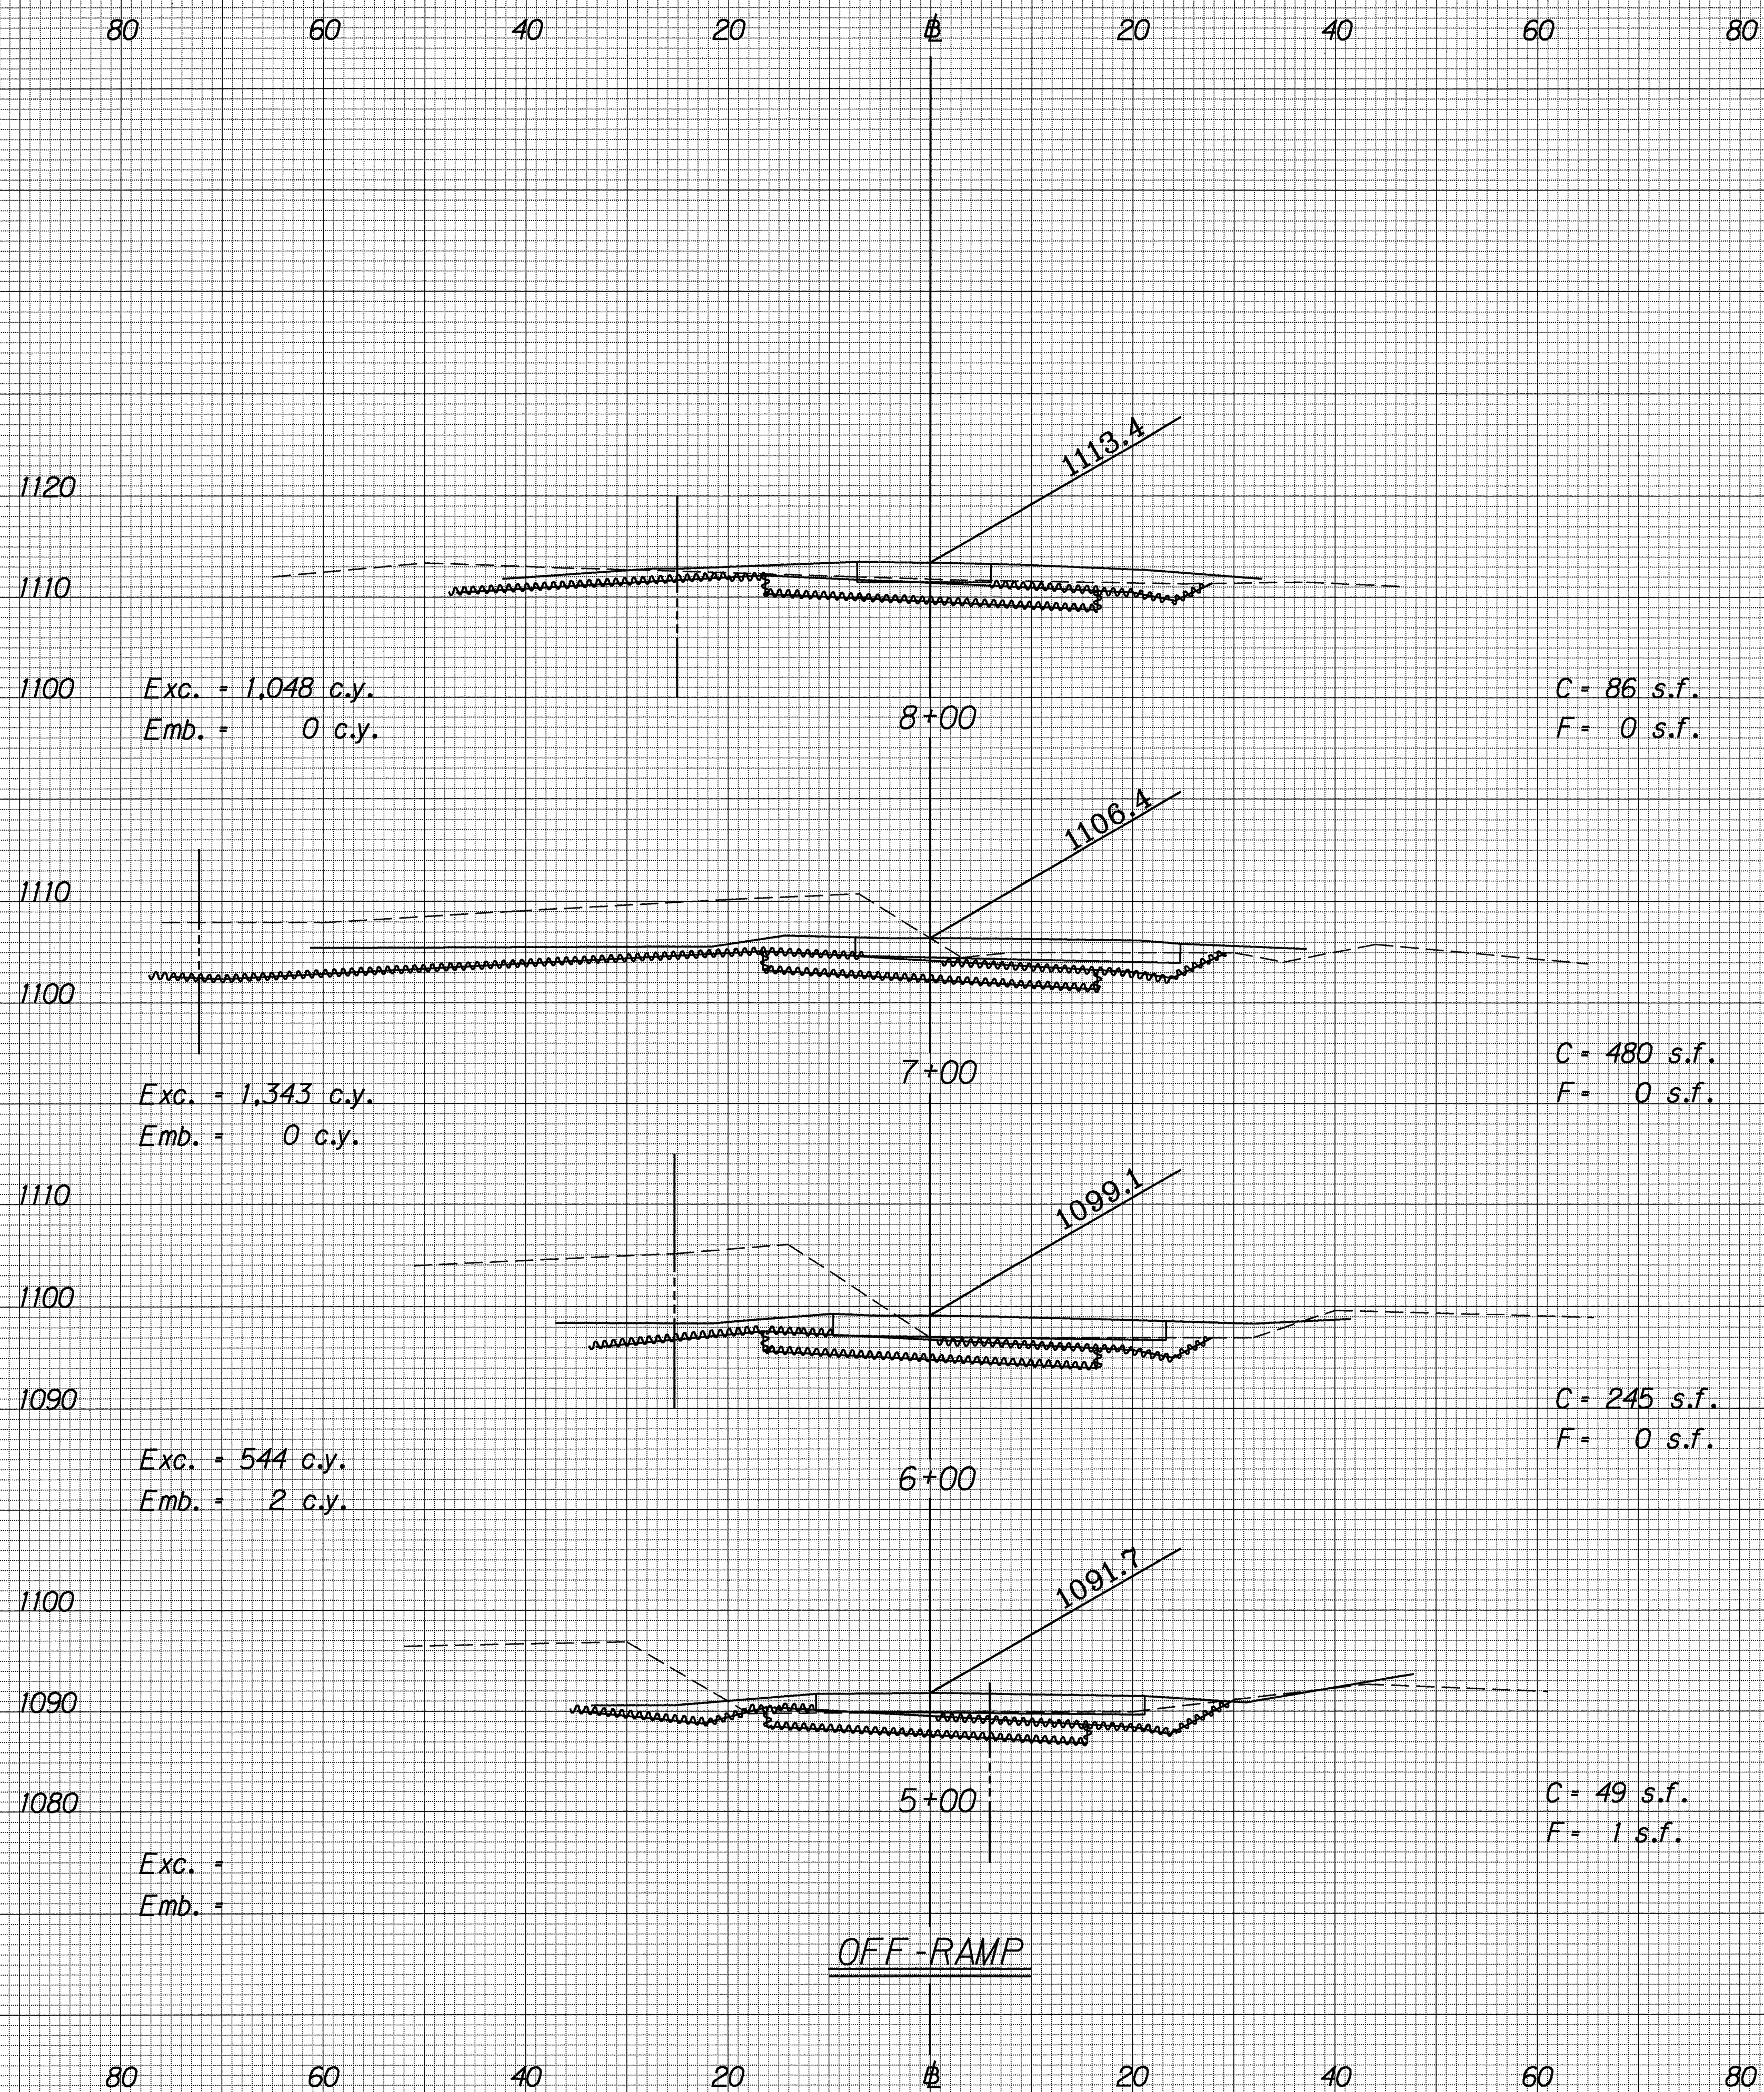

LEGEND FOR AS-BUILT POSTINGS

	Squiggly line for as-built deletion
	Double line for as-built deletion
Roadway	Text for as-built posting

"AS-BUILT"