


FED. ROAD DIST. NO.	STATE	PROJ. NO.	FISCAL YEAR	SHEET NO.	TOTAL SHEETS
HAWAII	HAW.	37C-01-91	1991	C.O.5	7

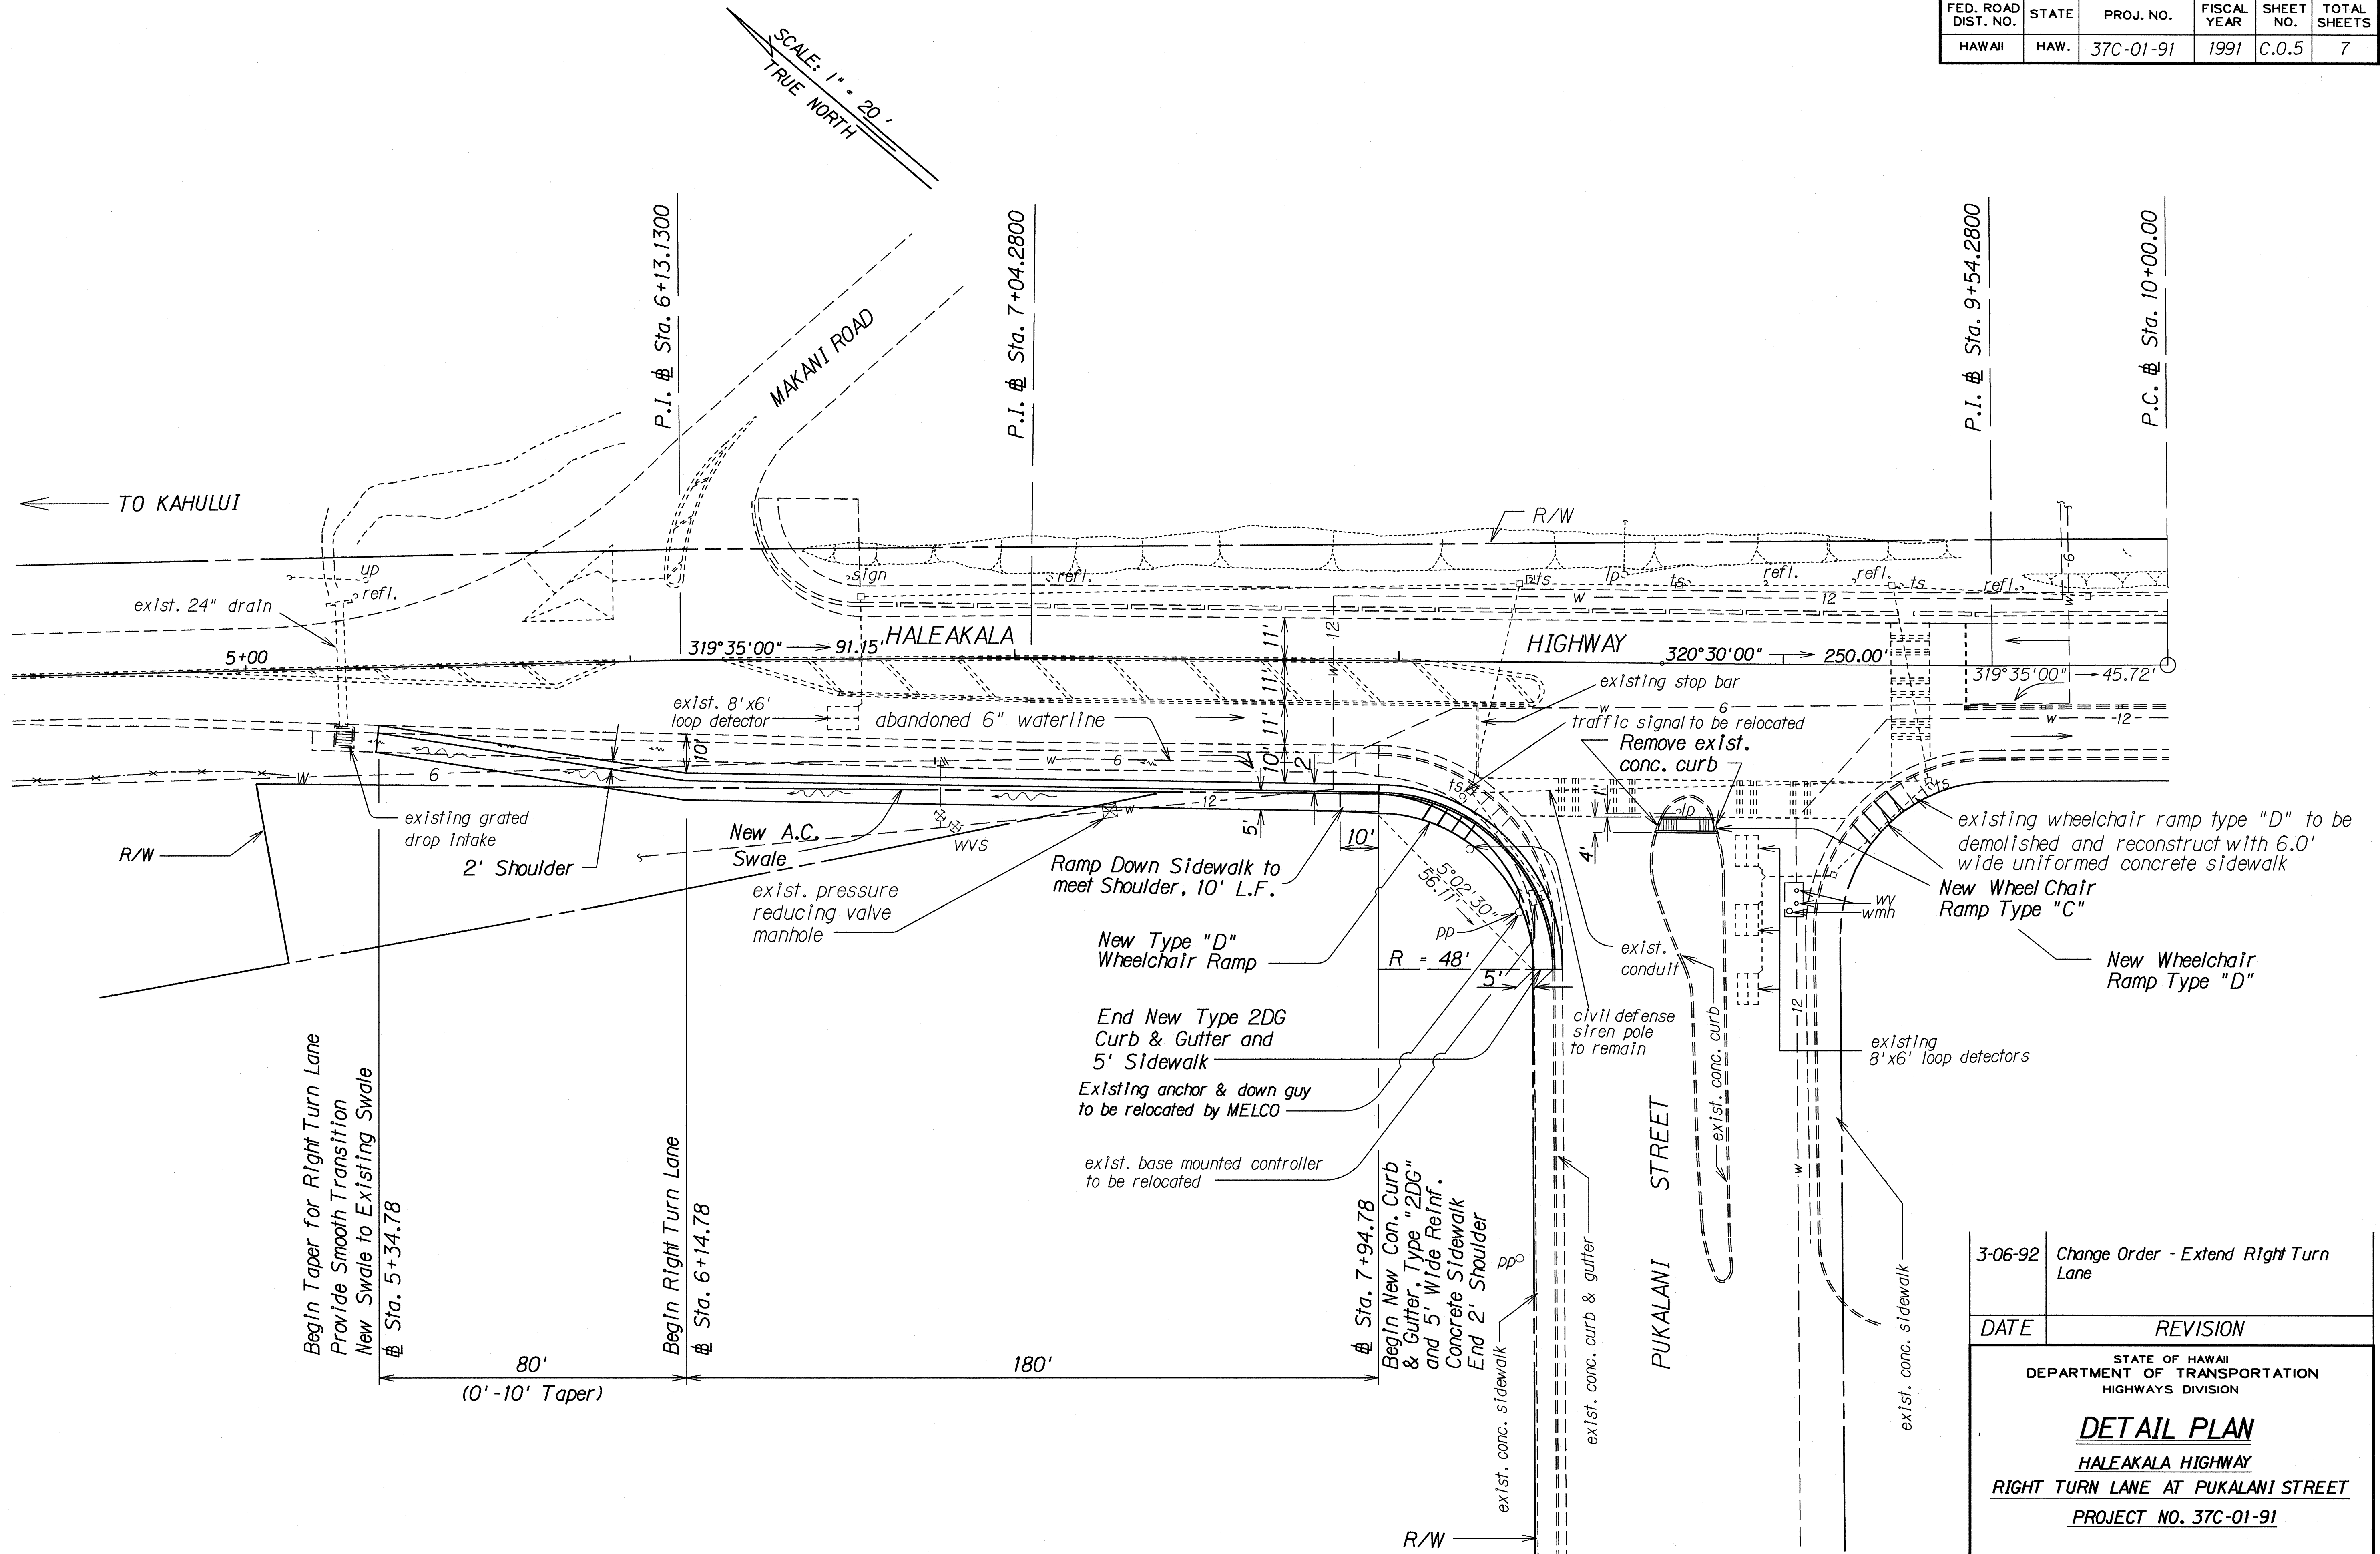

SURVEY PLOTTED BY	DATE
DRAWN BY	
TRACED BY	
NOTED BY	
CHECKED BY	

3-06-92	Change Order - Extend Right Turn Lane
DATE	REVISION
STATE OF HAWAII DEPARTMENT OF TRANSPORTATION HIGHWAYS DIVISION	
DETAIL PLAN	
HALEAKALA HIGHWAY	
RIGHT TURN LANE AT PUKALANI STREET	
PROJECT NO. 37C-01-91	
Scale: 1" = 20' Date: October, 1991	
SHEET No. 1 OF 1 SHEETS	

C.O. 5