


FED. ROAD DIST. NO.	STATE	PROJ. NO.	FISCAL YEAR	SHEET NO.	TOTAL SHEETS
HAWAII	HAW.	37C-01-91	1991	C.0.7	7

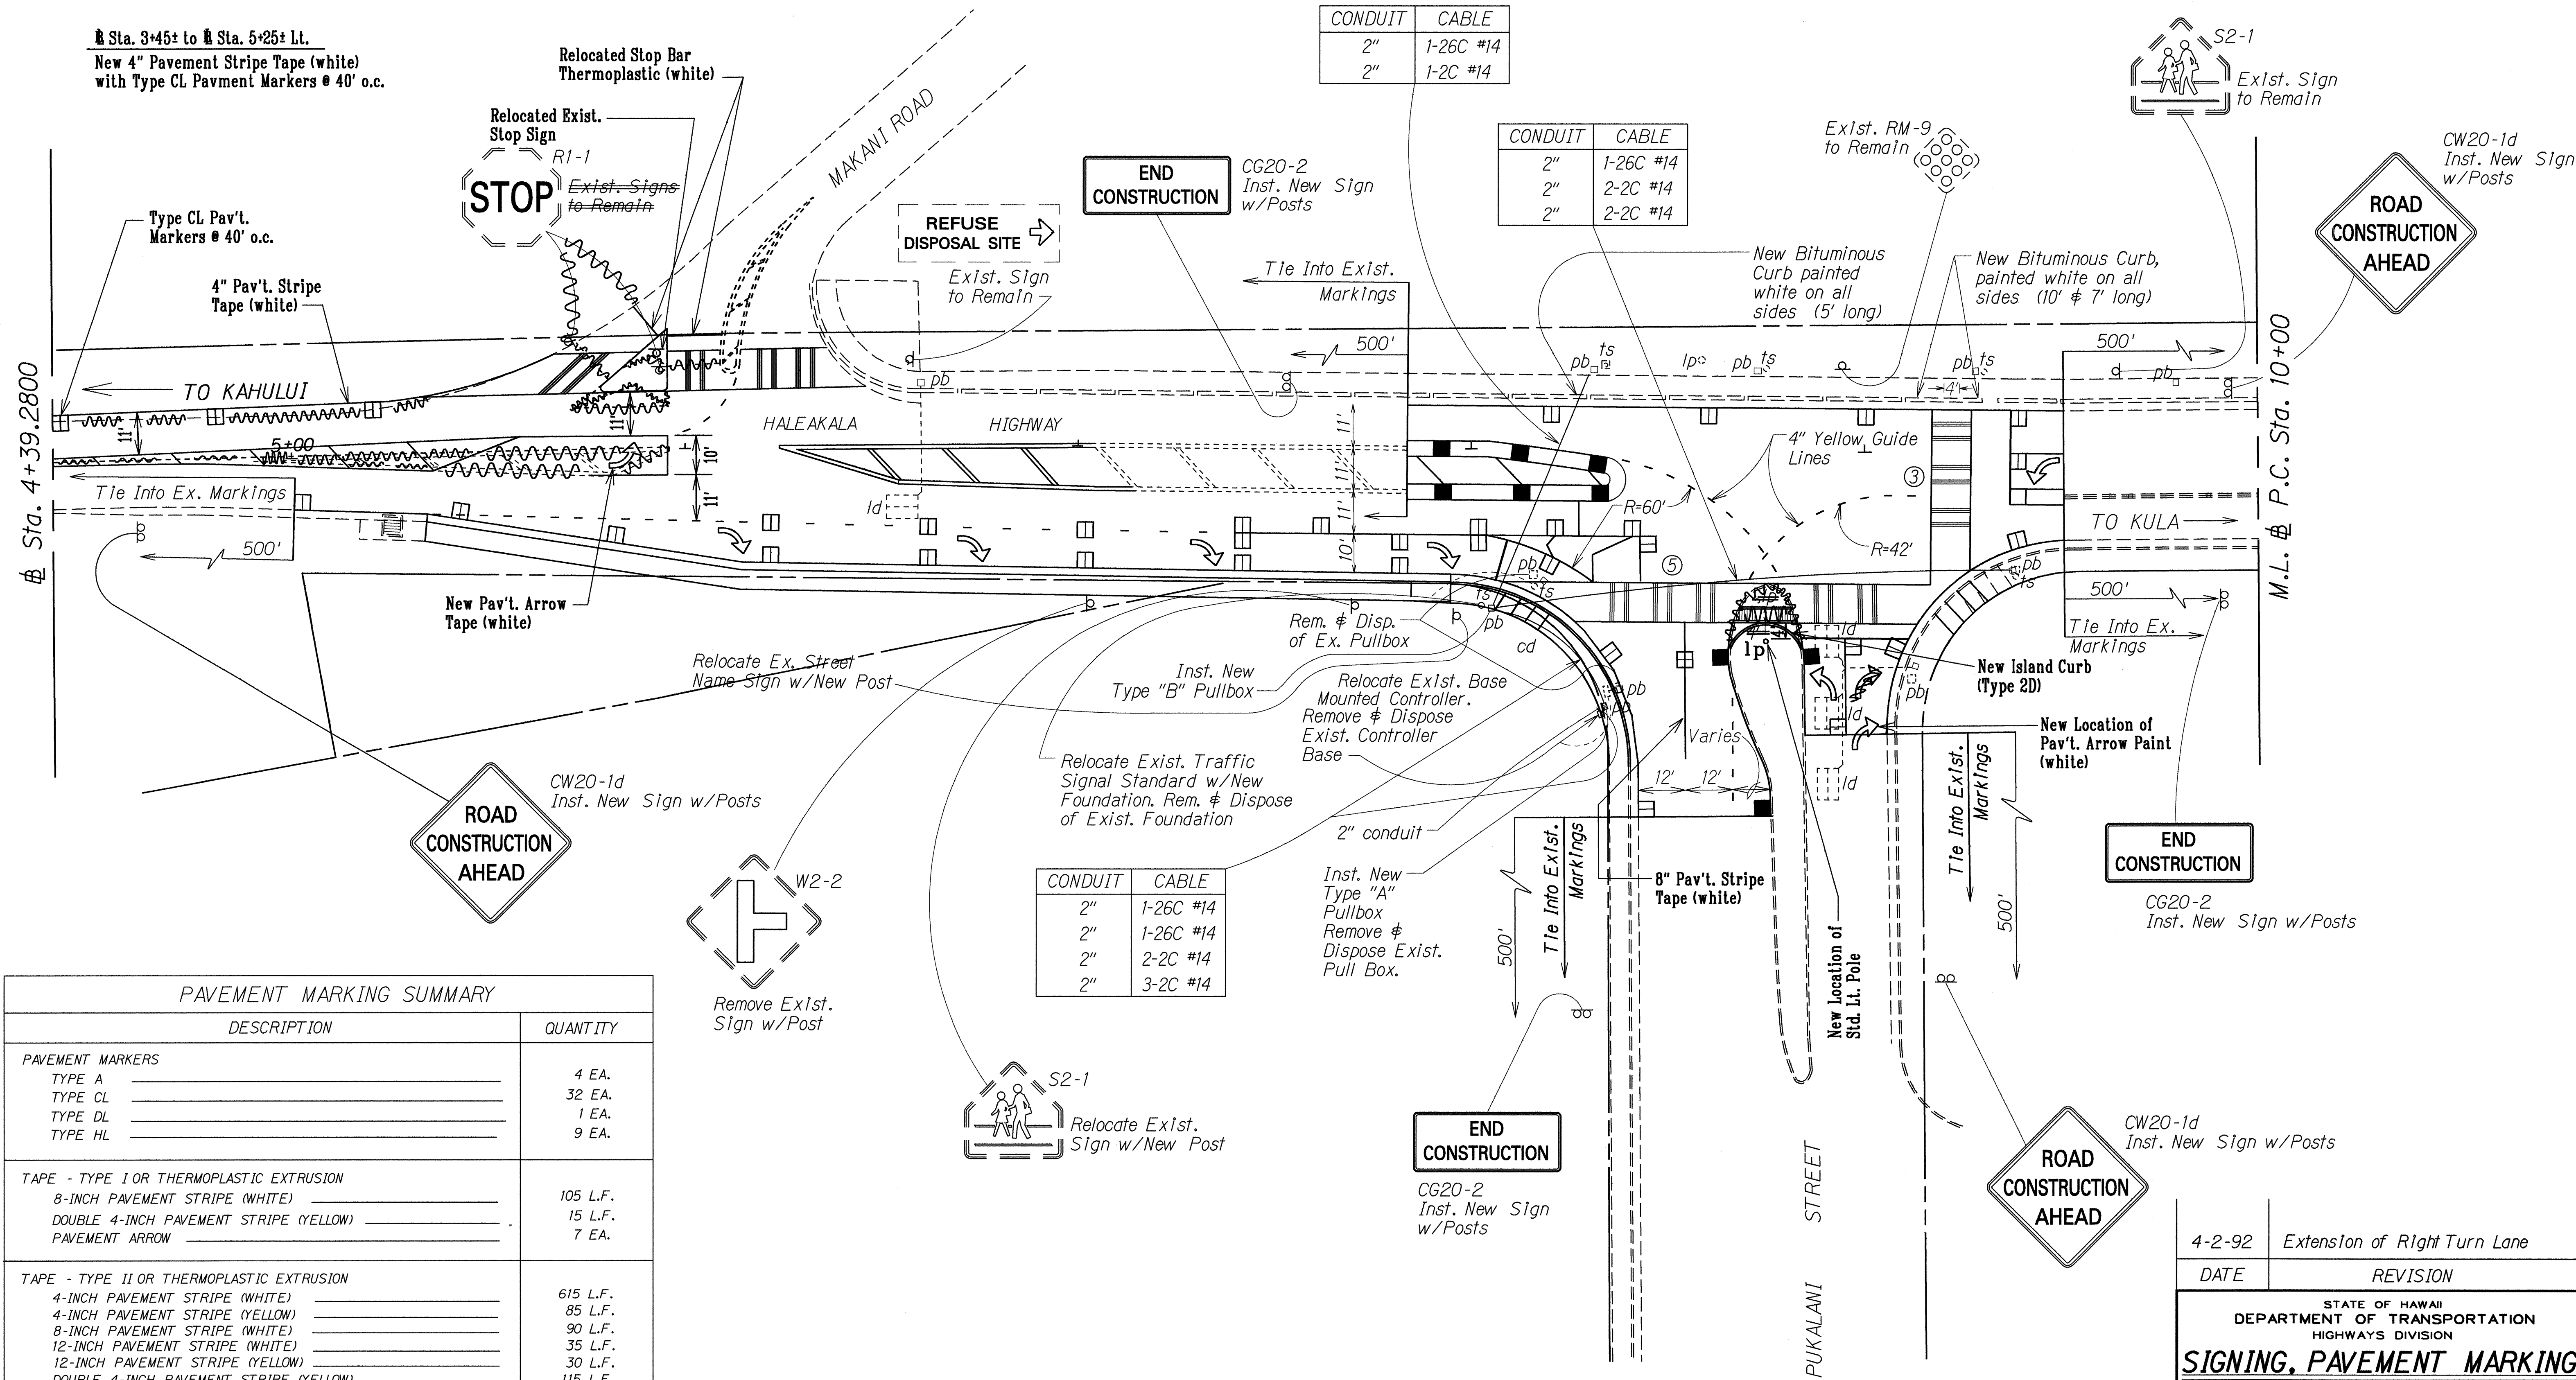

Sta. 3+45± to Sta. 5+25± L.L.
New 4" Pavement Stripe Tape (white)
with Type CL Pavement Markers @ 40' o.c.

CONDUIT	CABLE
2"	1-26C #14
2"	1-2C #14

CONDUIT	CABLE
2"	1-26C #14
2"	2-2C #14
2"	2-2C #14

CONDUIT	CABLE
2"	1-26C #14
2"	1-26C #14
2"	2-2C #14
2"	3-2C #14

Sta. 4+39.2800

M.L. @ P.C. Sta. 10+00

PAVEMENT MARKING SUMMARY	
DESCRIPTION	QUANTITY
PAVEMENT MARKERS	
TYPE A _____	4 EA.
TYPE CL _____	32 EA.
TYPE DL _____	1 EA.
TYPE HL _____	9 EA.
TAPE - TYPE I OR THERMOPLASTIC EXTRUSION	
8-INCH PAVEMENT STRIPE (WHITE) _____	105 L.F.
DOUBLE 4-INCH PAVEMENT STRIPE (YELLOW) _____	15 L.F.
PAVEMENT ARROW _____	7 EA.
TAPE - TYPE II OR THERMOPLASTIC EXTRUSION	
4-INCH PAVEMENT STRIPE (WHITE) _____	615 L.F.
4-INCH PAVEMENT STRIPE (YELLOW) _____	85 L.F.
8-INCH PAVEMENT STRIPE (WHITE) _____	90 L.F.
12-INCH PAVEMENT STRIPE (WHITE) _____	35 L.F.
12-INCH PAVEMENT STRIPE (YELLOW) _____	30 L.F.
DOUBLE 4-INCH PAVEMENT STRIPE (YELLOW) _____	115 L.F.
THERMOPLASTIC EXTRUSION	
4-INCH PAVEMENT STRIPE (WHITE) _____	210 L.F.
4-INCH PAVEMENT STRIPE (YELLOW) _____	110 L.F.
12-INCH PAVEMENT STRIPE (WHITE) _____	85 L.F.
CROSSWALK MARKINGS _____	8 LANES

SURVEY PLOTTED BY: _____ DATE: _____
 DRAWN BY: _____
 NOTE BOOK DESIGNED BY: _____
 QUANTITIES BY: _____
 CHECKED BY: _____
 ORIGINAL PLAN: _____
 NOTE: 1" = 20'

LEGEND FOR AS-BUILT POSTINGS	
	Squiggly line for as-built deletion
	Double line for as-built deletion
Roadway	Text for as-built posting

4-2-92	Extension of Right Turn Lane
DATE	REVISION
STATE OF HAWAII DEPARTMENT OF TRANSPORTATION HIGHWAYS DIVISION	
SIGNING, PAVEMENT MARKING, & TRAFFIC SIGNAL PLAN	
HALEAKALA HIGHWAY RIGHT TURN LANE AT PUKALANI STREET Project No. 37C-01-91	
Scale: 1" = 20'	Date: October 1991
SHEET No. T2 OF 2 SHEETS	